



Jones Gillam Renz Architects

Address

730 N 9th St.
Salina, KS 67401

1881 Main St., Suite 301
Kansas City, MO 64108

Contact

jgr@jgrarchitects.com
(785) 827-0386

Web

jgrarchitects.com

ARCHITECT'S SUPPLEMENTAL INSTRUCTIONS

JONES GILLAM RENZ DOCUMENT JGR 710

PROJECT:	The Reserves at Cobalt Circle New Development Brownsville, TN	Report No.	Two (2)
OWNER:	OPG Cobalt Circle Partners, LLC Dan Maximuk 250 N. Santa Fe Ave, Suite A Salina, KS 67401	Date	October 15, 2025
CONTRACTOR:	MCP Group 3501 SW Fairlawn Rd. Topeka, KS 66614	Architect's Proj No.	24-3446
		Contract For:	General Construction Mechanical, Electrical

The work shall be carried out in accordance with the following supplemental instructions issued in accordance with the Contract Documents without change in Contract Sum or Contract Time. Prior to proceeding in accordance with these instructions, indicate your acceptance of these instructions for minor change to the Work as consistent with the Contract Documents and return a copy to the Architect.

DESCRIPTION:

Contractor to make adjustments as needed and required per the modifications as indicated on attached drawings and in the below descriptions:

1. Civil Revisions – reference attached Narrative & revised Sheets: Grading Plan, Grading Plan-Spot Grading Sheet 01 of 02, and Grading Plan-Spot Grading Sheet 02 of 02
2. Revised Sheet E6.3 – dwelling unit panel scheduled have been revised.

Attachments:

1. Civil ASI #2 Narrative
2. Revised Civil Sheets:
 - a. Grading Plan
 - b. Grading Plan-Spot Grading Sheet 01 of 02
 - c. Grading Plan-Spot Grading Sheet 02 of 02
3. Revised Electrical Sheet E6.3

Issued by: Jones Gillam Renz Architects PO Box 2928, Salina, KS 67402
Maggie Gillam, Project Manager 785-827-0386 mgillam@jgrarchitects.com

Copies to:

MCP Group – Mike Maas, Cliff Holland, Tim Johnson, Kelli Meiers
OPG - Dan Maximuk, Amanda Klaus, Austin Kack
JGR Team - Maggie Gillam (JGR), Ryan Lies (LST), Cindy Senecal (McClure), Wesley Wooldridge (Renaissance), Michael Boerst (Heartland Energy)



**Renaissance
Group**

Architect's Supplemental Instructions (ASI)

ASI No. 2

Date of Issuance: 10/15/2025

Project: The Reserves at Cobalt Circle

To: (Contractor) MCP Build, Mike Maas

**Engineer: : Renaissance Group
9700 Village Circle, Suite 100
Lakeland, TN 38002**

The Work shall be carried out in accordance with the following supplemental instructions issued in accordance with the Contract Documents without change in the Contract Sum or Contract Time. Prior to proceeding in accordance with these instructions, indicate your acceptance of these instructions for minor change to the Work as consistent with the Contract Documents and return a copy to the Architect

Description: Contractor had questions about spot grades shown and matching contours.

RGI added and modified numerous spot grades in the areas in question as well as modified some of the contouring in the parking lot.

RGI added three (3) sidewalk drains to help facilitate water away from the buildings.

RGI added drainage structure 13B back to the drainage system between Bldg. B and Bldg. C

RGI clarified spot grades around the playground.

**Attachments:
Grading Plan, Spot Grading Plan 1 of 2, Spot Grading Plan 2 of 2**

Authorized:

Renaissance Group
Site Civil Engineer
9700 Village Circle, Suite 100
Lakeland, TN 38002


CONTRACTOR

By _____ By _____

Date 10/15/2025 Date _____


LEGEND	
PROPOSED MINOR CONTOUR	
EXISTING MINOR CONTOUR	
PROPOSED MAJOR CONTOUR	
EXISTING MAJOR CONTOUR	
EX. EDGE OF PAVEMENT	
PROPERTY LINE	
RIDGE LINE	
FLOW LINE	
TP	TOP OF PAVEMENT
TC	TOP OF CURB/CONC.
TC/TP	TOP OF CONCRETE/ TOP OF PAVEMENT
B/SW	BACK OF SIDEWALK
FL	FLOW LINE
D.A.	DRAINAGE AREA
Q10	DISCHARGE OF 10 YR. DESIGN STORM
HP	HIGH POINT
FG	FINISH GRADE
FFE	FINISHED FLOOR ELEV.

—GROUND DRAINAGE DIRECTION

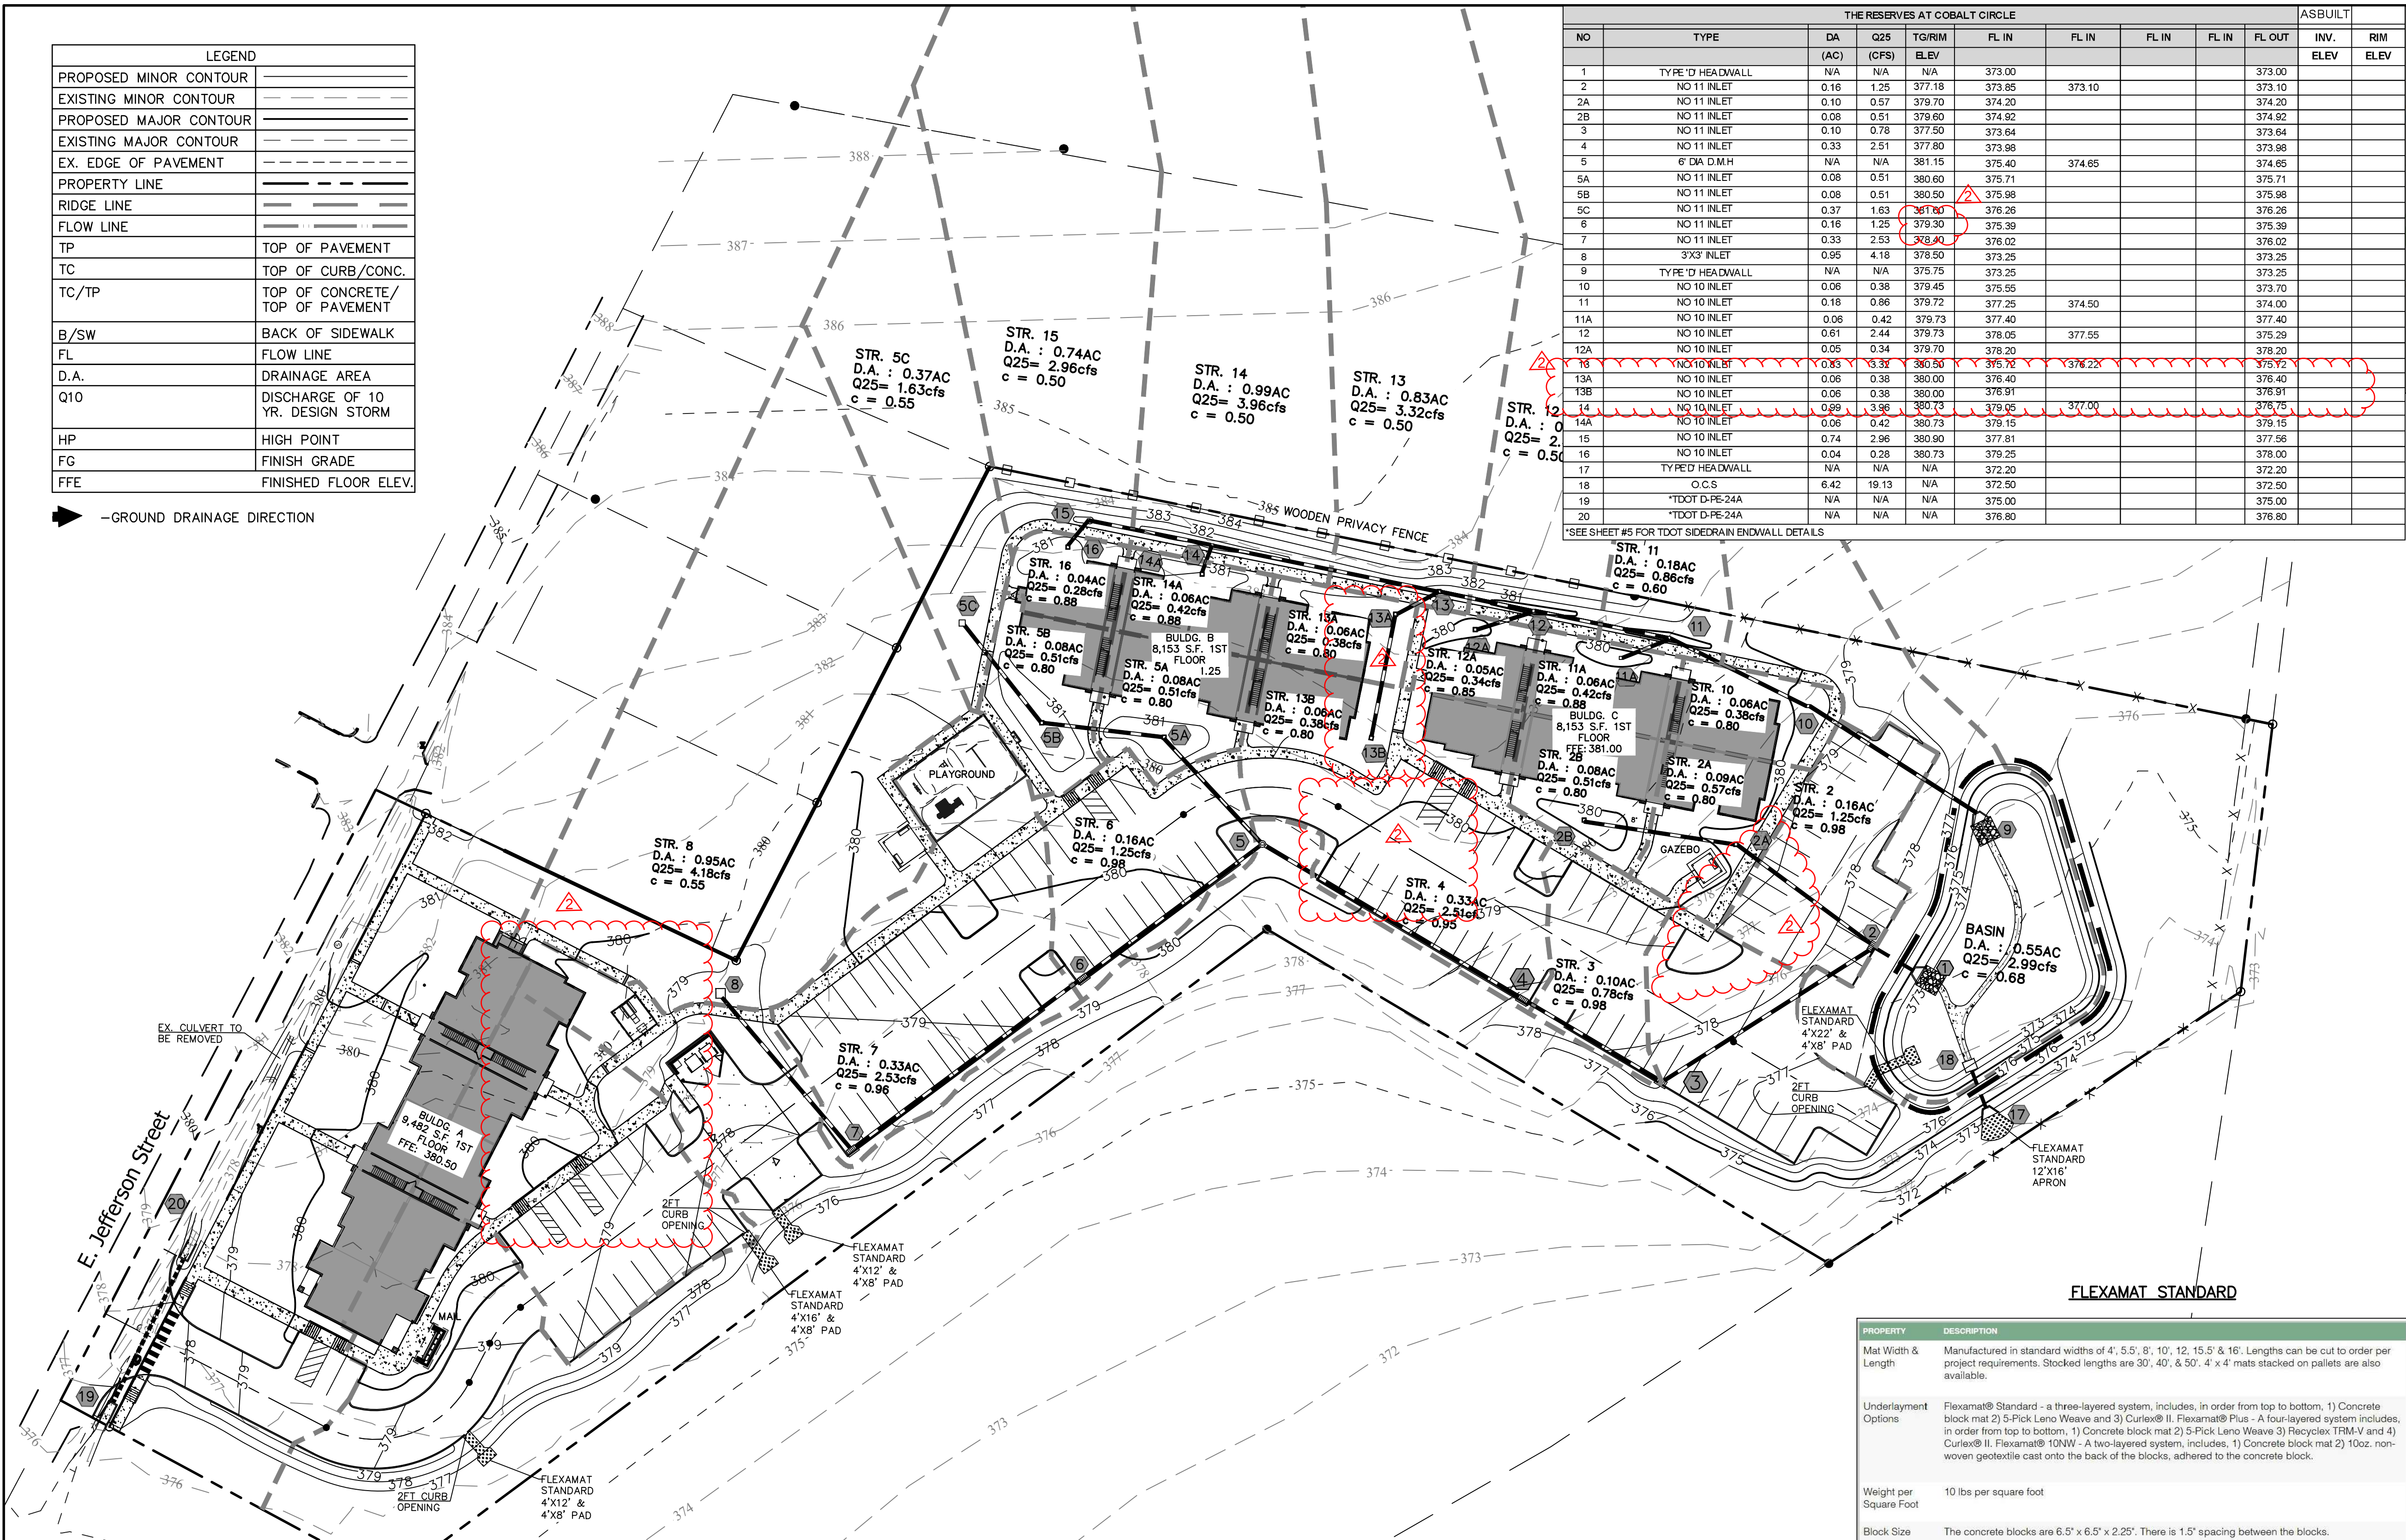

THE RESERVES AT COBALT CIRCLE										ASBUILT	
NO	TYPE	DA (AC)	Q25 (CFS)	TG/RIM ELEV	FL IN	FL IN	FL IN	FL OUT	INV. ELEV	RIM ELEV	
1	TYPE 10 HEADWALL	N/A	N/A	N/A	373.00				373.00		
2	NO 11 INLET	0.16	1.25	377.18	373.85	373.10			373.10		
2A	NO 11 INLET	0.10	0.57	379.70	374.20				374.20		
2B	NO 11 INLET	0.08	0.51	379.60	374.82				374.82		
3	NO 11 INLET	0.10	0.78	377.50	373.64				373.64		
4	NO 11 INLET	0.33	2.51	377.80	373.98				373.98		
5	6" DIA D.M.H	N/A	N/A	381.15	375.40	374.65			374.65		
5A	NO 11 INLET	0.08	0.51	380.60	375.71				375.71		
5B	NO 11 INLET	0.08	0.51	380.50	375.98				375.98		
5C	NO 11 INLET	0.37	1.63	377.60	376.26				376.26		
6	NO 11 INLET	0.16	1.25	379.30	375.39				375.39		
7	NO 11 INLET	0.33	2.53	378.40	376.02				376.02		
8	3'X3' INLET	0.95	4.18	378.50	373.25				373.25		
9	TYPE 10 HEADWALL	N/A	N/A	375.75	373.25				373.25		
10	NO 10 INLET	0.06	0.38	379.45	375.65				375.65		
11	NO 10 INLET	0.18	0.66	378.72	377.25	374.50			374.00		
11A	NO 10 INLET	0.06	0.42	379.73	377.40				377.40		
12	NO 10 INLET	0.61	2.44	379.73	378.05	377.55			375.29		
12A	NO 10 INLET	0.05	0.34	379.70	378.20				378.20		
12B	NO 10 INLET	0.03	0.32	380.50	375.72	376.22			375.72		
13A	NO 10 INLET	0.06	0.38	380.00	376.40				376.40		
13B	NO 10 INLET	0.06	0.38	380.00	376.81				376.81		
14	NO 10 INLET	0.95	3.96	380.73	379.05	377.00			375.75		
14A	NO 10 INLET	0.05	0.42	380.73	379.15				379.15		
15	NO 10 INLET	0.74	2.96	380.90	377.81				377.56		
16	NO 10 INLET	0.04	0.28	380.73	378.25				378.00		
17	TYPE 10 HEADWALL	N/A	N/A	N/A	372.20				372.20		
18	O.C.S.	6.42	19.13	N/A	372.50				372.50		
19	*DOT D-PE-24A	N/A	N/A	N/A	375.00				375.00		
20	*DOT D-PE-24A	N/A	N/A	N/A	376.80				376.80		

*SEE SHEET #5 FOR TDOT SIDERAIN ENDWALL DETAILS

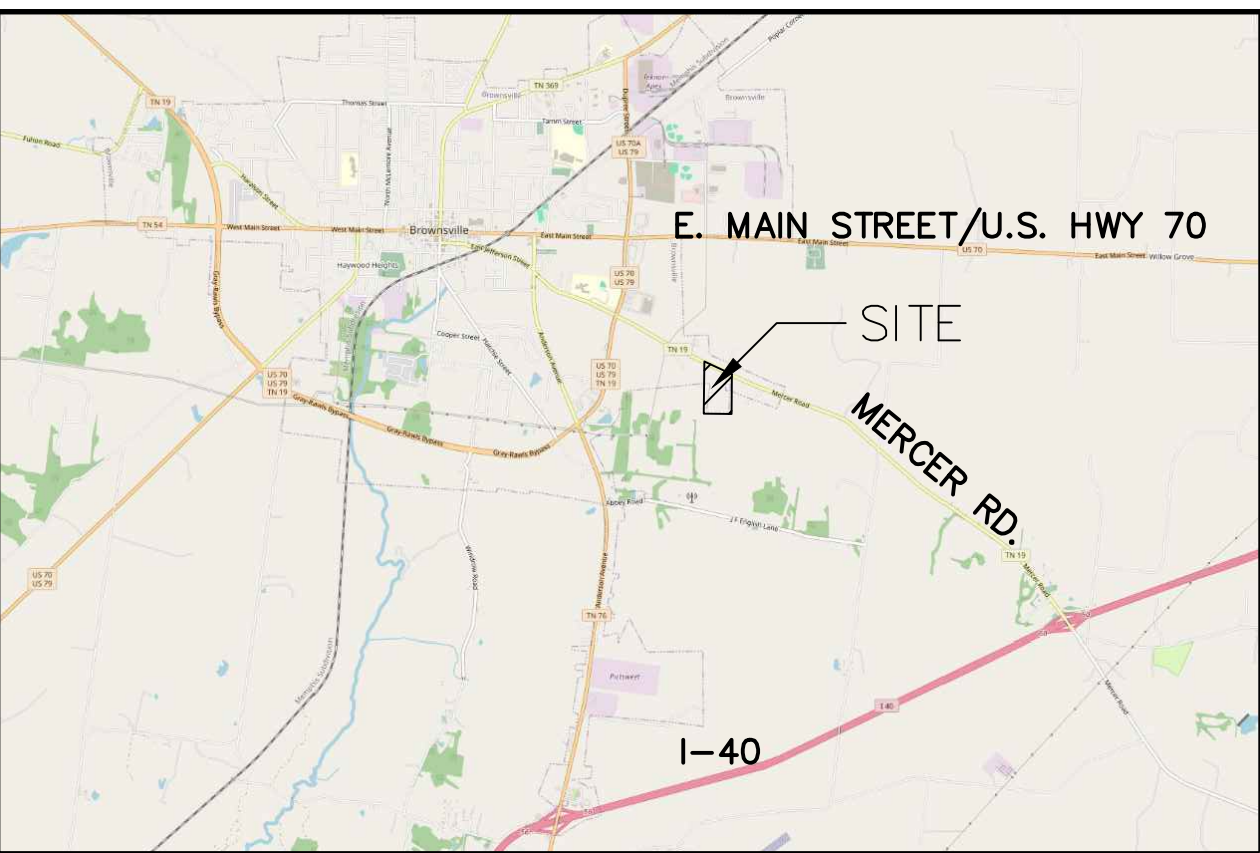

GENERAL NOTES (CITY OF BROWNSVILLE)

- A MINIMUM OF 24-HOURS PRIOR TO BEGINNING CONSTRUCTION, THE CONTRACTOR SHALL NOTIFY THE CITY OF BROWNSVILLE PUBLIC WORKS OFFICE AT (731) 772-9978.
- ALL NEWLY CUT OR FILLED AREAS, LACKING ADEQUATE VEGETATION, SHALL BE SEEDED, MULCHED, FERTILIZED AND/OR SODED AS REQUIRED TO EFFECTIVELY CONTROL SOIL EROSION.
- THE LOCATION OF EXISTING UNDERGROUND UTILITIES ARE APPROXIMATE AND NOT NECESSARILY ALL OF THE SAME. THE CONTRACTOR SHALL BE RESPONSIBLE FOR NOTIFYING THE UTILITY COMPANIES WHICH MAINTAIN A UTILITY LINE WITHIN THE BOUNDARIES OF THE PROJECT PRIOR TO THE INITIATION OF ANY CONSTRUCTION ON THE PROJECT OR IN THE STREETS BORDERING THE PROJECT. THE CONTRACTOR SHALL ALSO ASSUME FULL RESPONSIBILITY FOR DAMAGE TO ANY UTILITIES ENCOUNTERED WITHIN CONSTRUCTION PERIMETERS, WHETHER SHOWN ON THE CONSTRUCTION PLANS OR NOT, DURING THE WORK ON THE PROJECT. CONTRACTOR SHALL MAINTAIN ACCESS TO ALL PROPERTIES.
- ALL FILL SOILS SHALL BE COMPACTED TO A MINIMUM OF 95% OF STANDARD PROCTOR DENSITY (ASTM D-698) WITHIN 3% OF OPTIMUM MOISTURE CONTENT IN LIFTS NOT TO EXCEED SIX (6) INCHES OF COMPACTED THICKNESS.
- ALL CONSTRUCTION MATERIALS AND PROCEDURES SHALL MEET OR EXCEED THE REQUIREMENTS OF THE CITY OF BROWNSVILLE STANDARD CONSTRUCTION SPECIFICATIONS.
- PROPERTY LINES SHALL BE FIELD VERIFIED PRIOR TO CONSTRUCTION. GRADING, CLEARING AND THE ERECTION OR REMOVAL OF FENCES ALONG PROPERTY LINES SHALL BE FULLY COORDINATED WITH ADJACENT PROPERTY OWNERS.
- VERIFY SITE CONDITIONS PRIOR TO CONSTRUCTION. NOTIFY THE CITY OF BROWNSVILLE PUBLIC WORKS OF ANY VARIATIONS PRIOR TO COMMENCEMENT OF WORK.
- ALL GRADING WORK SHALL BE PERFORMED IN SUCH A MANNER THAT ADJACENT PROPERTIES ARE NOT DAMAGED OR ADVERSELY AFFECTED.
- LOT DRAINAGE: FINISH GRADE SHALL BE SLOPED AWAY FROM THE FOUNDATION FOR DRAINAGE. THE FINISH GRADE MUST BEGIN AT LEAST 12-INCHES BELOW THE TOP OF THE FOUNDATION WALL OR THE GRADE OF THE CONCRETE SLAB AT THE INTERIOR IN THE CASE OF AN INTEGRAL SLAB AND FOUNDATION. THE MINIMUM GRADE AWAY FROM THE FOUNDATION SHALL BE TWO PERCENT (2%) IN ALL DIRECTIONS. THE DRIVEWAY SHALL BE SLOPED DOWN AT TWO PERCENT (2%) FOR AT LEAST EIGHT FEET FROM THE STRUCTURE.


FLEXAMAT STANDARD

PROPERTY	DESCRIPTION
Mat Width & Length	Manufactured in standard widths of 4', 5.5', 8', 10', 12', 15.5' & 16'. Lengths can be cut to order per project requirements. Stocked lengths are 30', 40', & 50'. 4' x 4' mats stacked on pallets are also available.
Underlayment Options	Flexamat® Standard - a three-layered system, includes, in order from top to bottom, 1) Concrete block mat 2) 5-Pick Leno Weave and 3) Curlex® II. Flexamat® Plus - A four-layered system includes, in order from top to bottom, 1) Concrete block mat 2) 5-Pick Leno Weave 3) Flexicrete® TFM/V and 4) Curlex® II. Flexamat® 10NW - A two-layered system, includes, 1) Concrete block mat 2) 10oz. non-woven geotextile cast onto the back of the blocks, adhered to the concrete block.
Weight per Square Foot	10 lbs per square foot
Block Size	The concrete blocks are 6.5" x 6.5" x 2.25". There is 1.5" spacing between the blocks.
Limiting Shear	24+ PSF (non vegetated)
Limiting Velocity	30+ft/second (non vegetated)

ACREAGE SUMMARY

EX. IMPERVIOUS SURFACE	0.12 ACRES
EX. PEROVIOUS SURFACE	5.00 ACRES
IMPERVIOUS SURFACE AT COMPLETION	2.13 ACRES
PERVIOUS/SEEDED AREA AT COMPLETION	2.99 ACRES
TOTAL AREA	5.12 ACRES

GRAPHIC SCALE

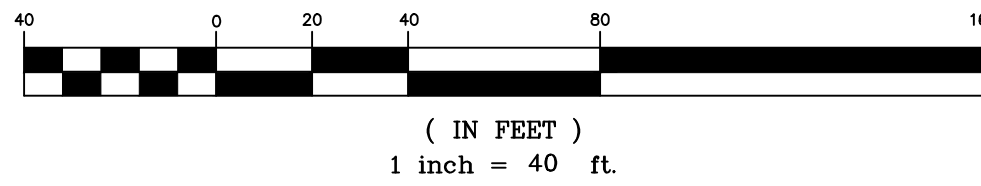

SHEET 01 OF 06

SITE BENCHMARK

RIM OF EXISTING S.M.H. LOCATED IN THE CENTER OF EAST JEFFERSON STREET
ELEVATION: 381.76

FEMA FLOOD NOTE:

THE PROPERTY SHOWN HEREON DOES NOT GRAPHICALLY FALL WITHIN A SPECIAL DESIGNATED FLOODZONE PER FEMA FIRM MAP PANEL 47157C0185F, DATED 09/27/2007
ELEVATION: 381.76

THE RESERVES AT COBALT CIRCLE
BROWNSVILLE, TN.

DEVELOPER:
ENGINEER: RENAISSANCE GROUP, INC.




DIVISION OF ENGINEERING
GRADING & DRAINAGE PLAN
LOCATION: 1616 EAST JEFFERSON STREET
BROWNSVILLE, TN.

SURVEY: SEAS DATE: 10/24/2010 BOOK: _____





DESIGN: _____ DATE: 01/25/2011 DATE: 01/25/2011 SCALE: 1" = 40'

DEPUTY CITY ENGINEER _____ DATE _____ CITY ENGINEER _____ DATE _____

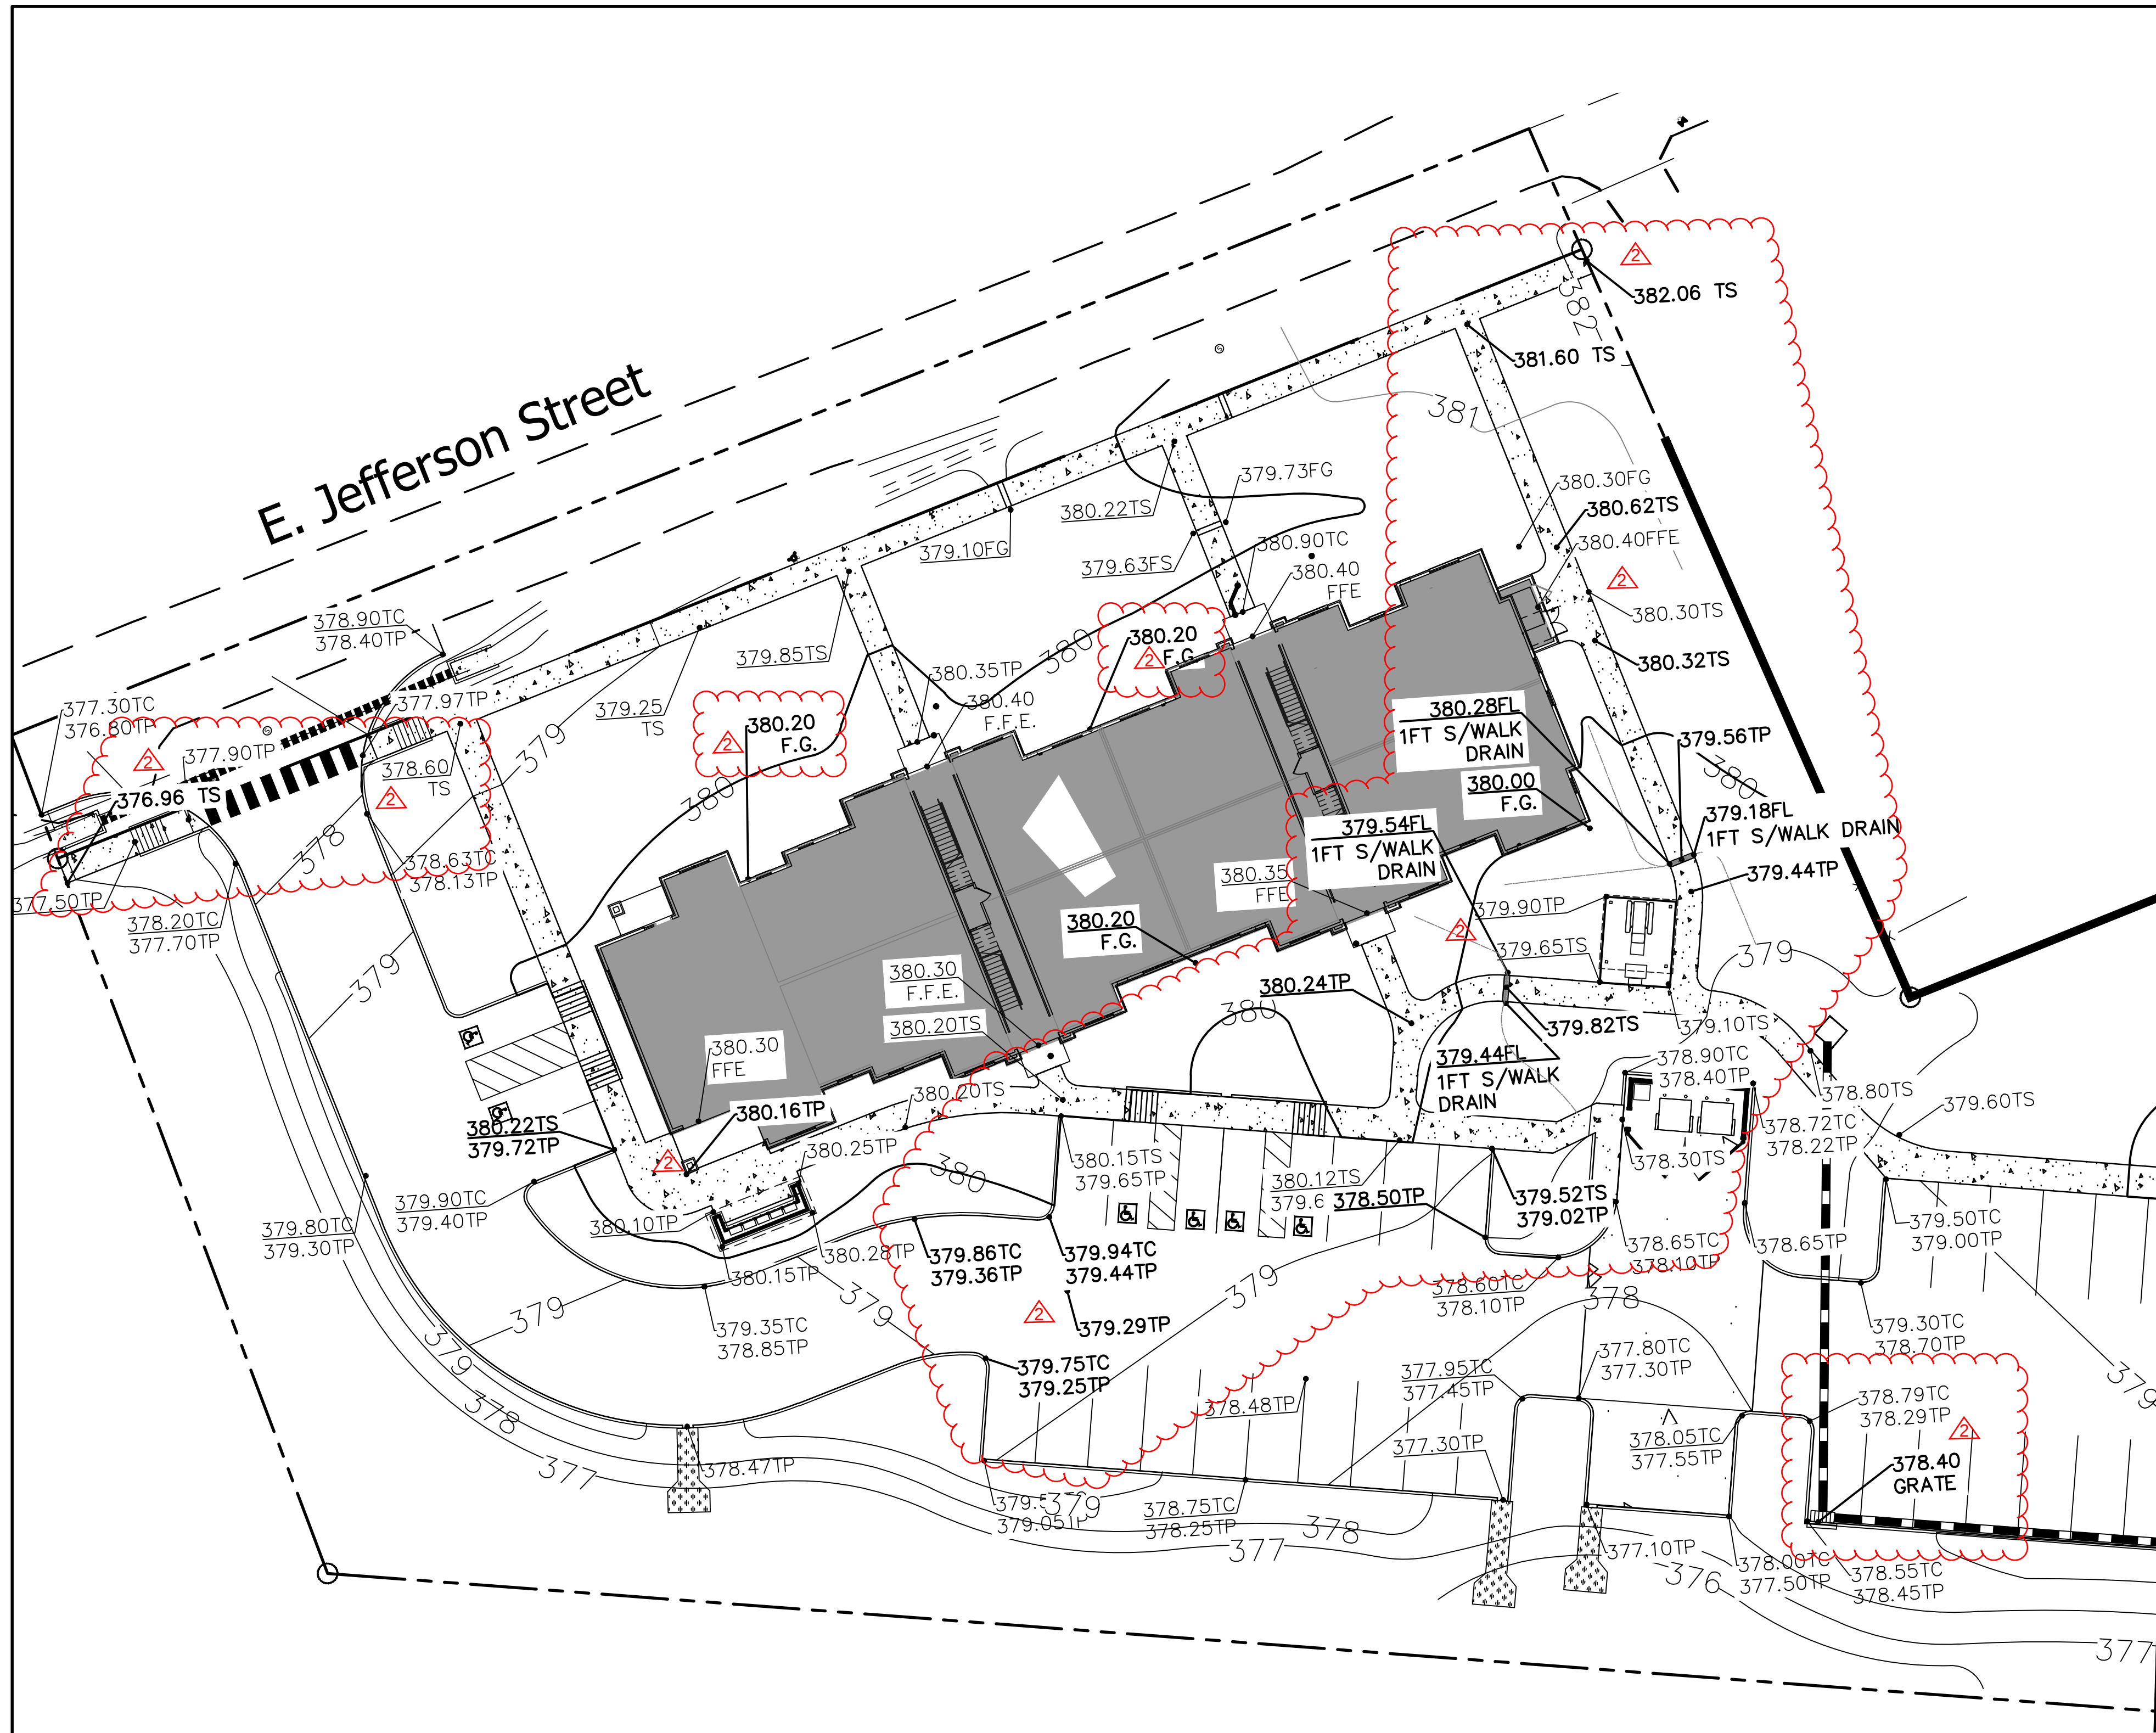

LEGEND	
PROPOSED MINOR CONTOUR	---
EXISTING MINOR CONTOUR	----
PROPOSED MAJOR CONTOUR	=====
EXISTING MAJOR CONTOUR	-----
EX. EDGE OF PAVEMENT	- - - - -
PROPERTY LINE	=====
RIDGE LINE	=====
TP	TOP OF PAVEMENT
TC	TOP OF CURB/CONC.
TC/TP	TOP OF CONCRETE/ TOP OF PAVEMENT
TS	TOP OF SIDEWALK
FL	FLOW LINE
D.A.	DRAINAGE AREA
Q10	DISCHARGE OF 10 YR. DESIGN STORM
HP	HIGH POINT
FG	FINISH GRADE
FFE	FINISHED FLOOR ELEV.

▲ -GROUND DRAINAGE DIRECTION

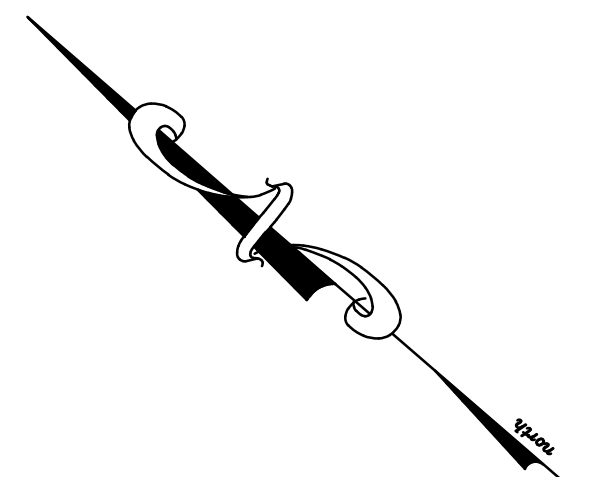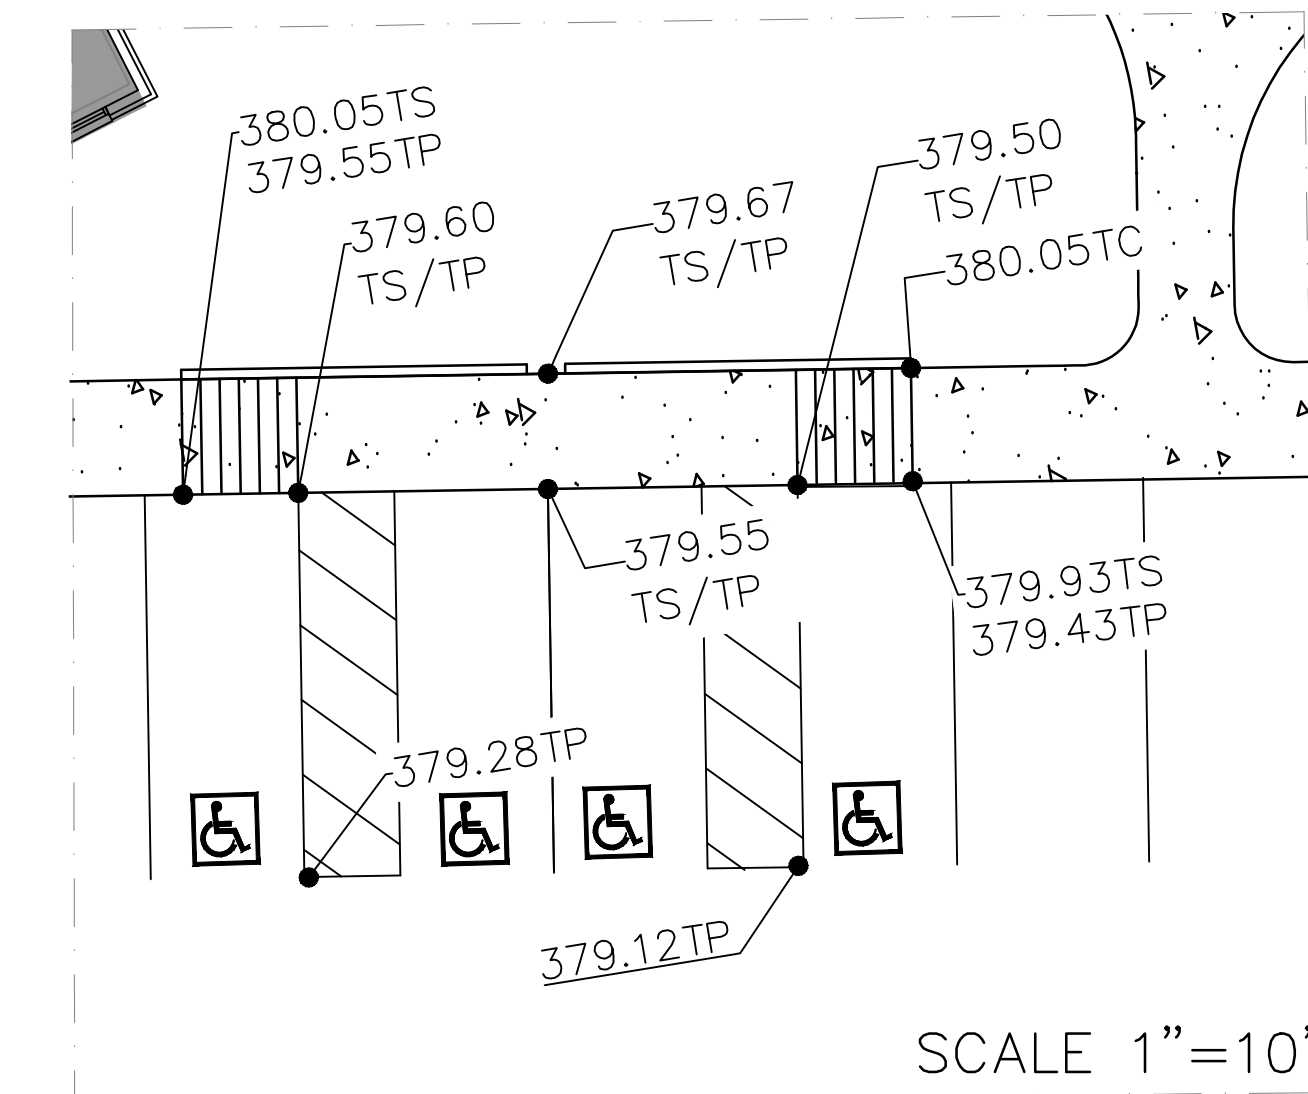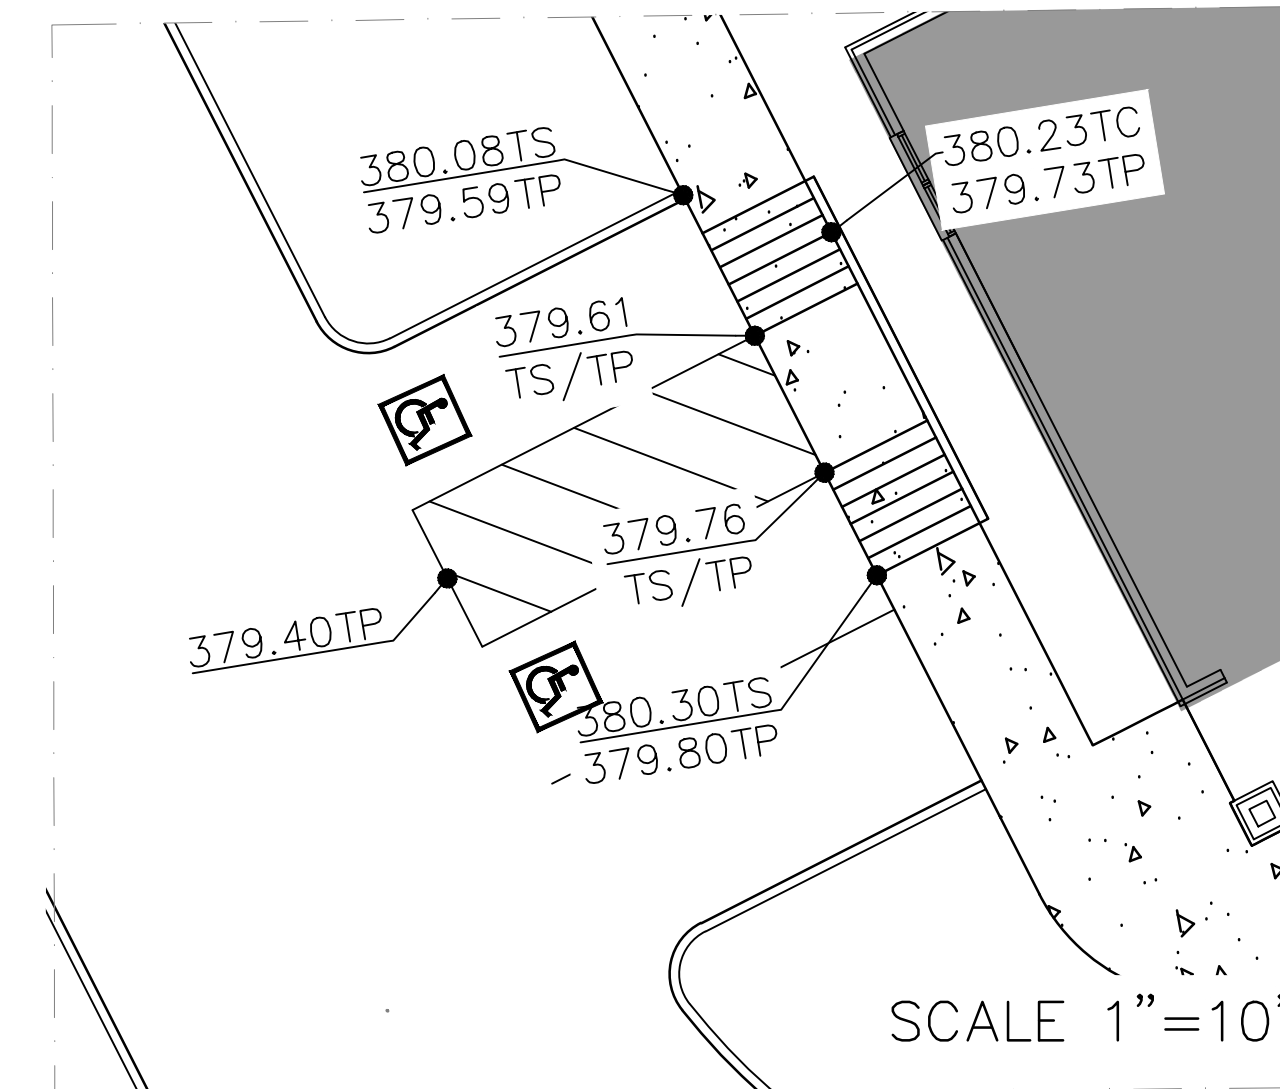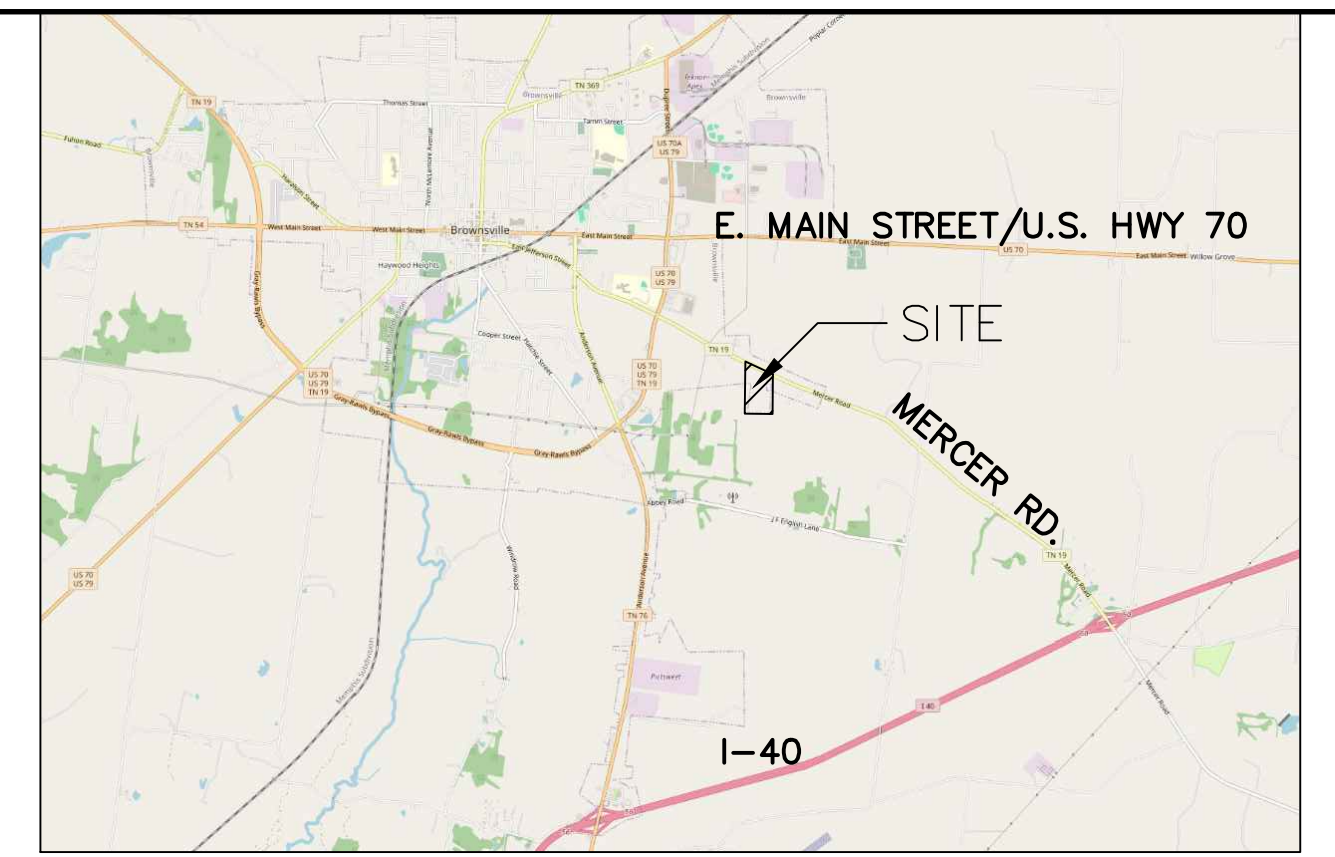

SITE BENCHMARK

MAG-NAIL AT SOUTHEAST CORNER OF CENTRAL AVE AND MEDA ST INTERSECTION. ELEVATION: 304.38


CITY BENCHMARK

CITY BM #102 - CITY MONUMENT IS LOCATED AT CENTRAL AVE & EAST PKWY S ON THE NORTHWEST CORNER AT BACK OF SIDEWALK AT NORTHEAST CORNER OF CONCRETE BASE OF TRAFFIC SIGNAL POLE. ELEV.: 292.36 (NAVD '88 DATUM)

FLOOD NOTE:


THIS PROPERTY IS NOT LOCATED IN A SPECIAL FLOOD HAZARD AREA PER FLOOD INSURANCE RATE MAP, MAP No. 47157C 0290 F. COMMUNITY PANEL No. 470177 0290 F. EFFECTIVE DATE: SEPTEMBER 28, 2007. NEAREST BFE: 233.0

REVISION		
ITEM NO.	DESCRIPTION OF CHANGE	APPROVAL DATE
1	ASI #2	10/25

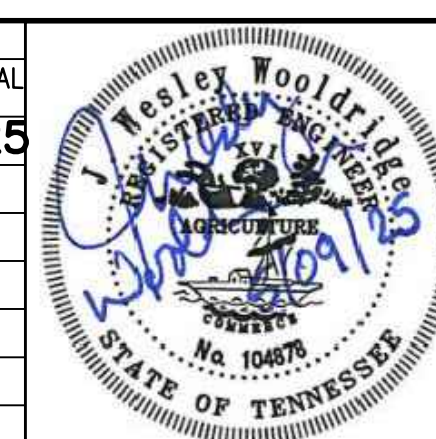

THE RESERVES AT COBALT CIRCLE
BROWNSVILLE, TN.

DEVELOPER:
ENGINEER: RENAISSANCE GROUP, INC.

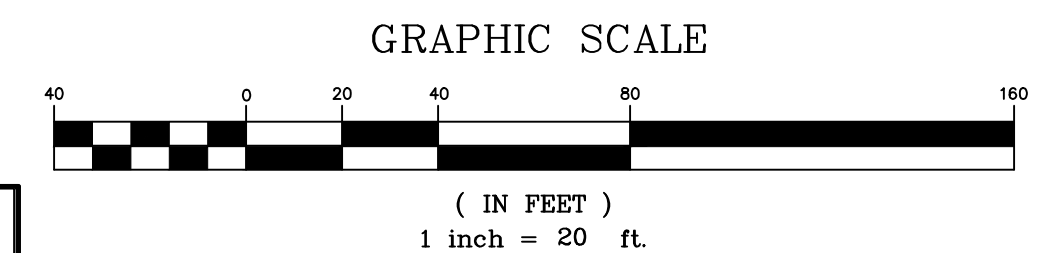


SHEET 03 OF 06

DIVISION OF ENGINEERING
SPOT GRADING PLAN 1 OF 2
LOCATION: 1616 EAST JEFFERSON STREET
BROWNSVILLE, TN.

SURVEY: SEAS DATE: 10/24/13 BOOK:

DESIGN: DATE: 01/25/CKD: DATE: 01/25/14 SCALE: 1" = 40'

DEPUTY CITY ENGINEER DATE CITY ENGINEER DATE

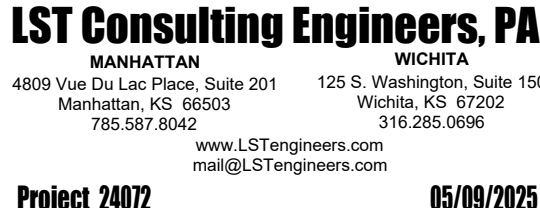

05/09/2025

E6.3

COPYRIGHT ©

Designation: C

Installed Location: A117 MECH

Voltage: 120/208 1PH 3W-1Ph-3W

Mounting: Surface

Enclosure: NEMA 1

Bus Amps: 200

MCB Amps: MLO

Features & Modifications: Provide Integral Surge Protection

SCCR/AIC: 10.0 KA

Mains FN/Note: -

Ckt	Description	Circuitry	Trip (A)	FN	A	B	FN	Trip (A)	Circuitry	Description	Ckt
C-1	Lighting - Office,Community, Kitchenette , Mech	1/2"C,1#12,#12N,#12G	20	460	900..	--	--	20	1/2"C,1#12,#12N,#12G	Receptacle - Office A114	C-2
C-3	Lighting - Rest Rooms, Fitness, Storage	1/2"C,1#12,#12N,#12G	20	--	--	413.. 720..	--	20	1/2"C,1#12,#12N,#12G	Receptacle - Community Room A115	C-4
C-5	Receptacle - Hall A120	1/2"C,1#12,#12N,#12G	20	720.. 720..	--	--	--	20	1/2"C,1#12,#12N,#12G	Receptacle - Kitchenette A116	C-6
C-7	Receptacle - Fitness A121	1/2"C,1#12,#12N,#12G	20	--	--	720.. 839..	--	20	1/2"C,1#12,#12N,#12G	Receptacle - Mech A117	C-8
C-9	Receptacle - Fitness A121	1/2"C,1#12,#12N,#12G	20	720.. 360..	--	--	--	20	1/2"C,1#12,#12N,#12G	Receptacle - Storage A122	C-10
C-11	Receptacle - Fitness A121	1/2"C,1#12,#12N,#12G	20	--	--	720.. 360..	--	20	1/2"C,1#12,#12N,#12G	Receptacle - Storage A122	C-12
C-13	Receptacle - Dishwasher	1/2"C,1#12,#12N,#12G	20	500.. 234..	--	--	--	--	--	--	C-14
C-15	Receptacle - Disposal	1/2"C,1#12,#12N,#12G	20	--	--	680.. 234..	--	--	1/2"C,2#10,#10G	Hot Water Heater 'HWH-B'	C-16
C-17	Receptacle - Refrigerator	1/2"C,1#12,#12N,#12G	20	180.. 221..	--	--	--	30	1/2"C,2#10,#10G	Blower Coil 'BC'-1	C-18
C-19	Heater 'EH'-1	1/2"C,#10,#10G	30	--	--	183.. 221..	--	--	--	--	C-20
C-21			30	183.. 156..	--	183.. 221..	--	--	--	--	C-22
C-23	Receptacle - Office A114 (Controlled)	1/2"C,1#12,#12N,#12G	20	720.. 156..	--	--	--	20	1/2"C,2#12,#12G	Heat Pump 'HP'-1	C-24
C-25	Other	1/2"C,1#12,#12N,#12G	20	360.. --	--	--	--	--	--	Space	C-26
C-27	Spare	--	20	--	0 VA	--	--	--	--	Space	C-28
C-29	Spare	--	20	--	0 VA	--	--	--	--	Space	C-30
C-31	Spare	--	20	--	--	0 VA	--	--	--	Space	C-32
C-33	Space	--	--	--	--	--	--	--	--	Space	C-34
C-35	Space	--	--	--	--	--	--	--	--	Space	C-36
C-37	Space	--	--	--	--	--	--	--	--	Space	C-38
C-39	Space	--	--	--	--	--	--	--	--	Space	C-40
C-41	Space	--	--	--	--	--	--	--	--	Space	C-42
Connected Load:				12865 VA	13117 VA						
Connected Amps:				124 A	126 A						