THE RESIDENCE at HERITAGE WEST

NEW APARTMENT COMPLEX

ANDOVER **24-3379** **KANSAS**

Wichita-Sedgwick County
Metropolitan Area Building
and Construction Department

REVIEWED FOR CODE COMPLIANCE

CORRECTIONS OR COMMENTS MADE ON THESE DRAWINGS AND THIS DOCUMENT DURING THIS REVIEW DO NOT RELIEVE CONTRACTOR FROM COMPLIANCE WITH ALL REQUIREMENTS OF THE CODE OF THE MABCD, THE CITY OF WICHITA OR SEDGWICK COUNTY. THIS REVIEW IS ONLY FOR GENERAL CONFORMANCE OF THE CODE. THE CONTRACTOR IS RESPONSIBLE FOR CONFORMING AND CORRELATING ALL TECHNIQUES OF CONSTRUCTION. THIS APPROVAL IS SUBJECT TO PROVISIONS OF SECTION 107.4 OF THE 2012 INTERNATIONAL BUILDING CODE.

DATE: 02/19/25 BY: William Jerauld Jr

REFERENCE LEGEND

- DETAIL REFERENCE REF # – SHT. #
- DETAIL REFERENCE REF # – SHT #
- INTERIOR ELEVATION REFERENCE
- ELEVATION DESIGNATION (100'-0" FIN. FLR.)
- DOOR MARK
- WINDOW MARK
- CUT LINE
- PARTITION MARK
- REVISIONS
- ROOM NAME & NUMBER (WAITING 101)
- PROJECTED VIEW OF PHOTOGRAPH REF # – SHT. #
- CEILING ELEVATION & MATERIAL (SB 10'-0" (BTM))
- PROJECT NORTH
- TRUE NORTH
- DRAWING NAME (DETAIL A)
- DRAWING SCALE (SCALE)
- DRAWING REF #

MATERIAL LEGEND

- BATT INSULATION
- BRICK MASONRY
- COMPACTED EARTH
- RIGID INSULATION
- POURED CONCRETE
- WALL W/ BRICK VENEER
- METAL STUD WALL
- CONCRETE WALL
- WOOD STUD WALL
- C.M.U. WALL
- PLYWOOD
- ROUGH WOOD (2" x 6")
- FINISH WOOD
- METAL STUD
- GLASS LARGE SCALE
- STRUCTURAL STEEL
- CONC. MASONRY UNIT SECTION
- MTL JOIST
- MTL FURRING
- PRECAST CONC. SLAB



JonesGillamRenz

730 N. Ninth St.
Salina, KS 67401
785.827.0386

1881 Main Street, Suite 301
Kansas City, MO 64108
jgr@jgrarchitects.com

CONSULTANTS

Civil Engineer ;

MKEC ENGINEERING SUCCESS

411 N. Webb Rd.
Wichita, KS. 67206
ph. (316) 684-9600
www.mkec.com

Mechanical & Electrical Engineer ;

LST Consulting Engineers, PA
4809 Vue Du Lac Place, Suite 301
MANHATTAN, KS. 66503
ph. (785) 587-8042
fax (785) 587-8039
mail@LSTengineers.com

Structural Engineer ;

Bob D. Campbell & Co., Inc.
4338 Belleview
Kansas City, MO 64111
816.531.4144; FAX 816.531.8572
info@bdc-engrs.com

ABBREVIATIONS

&	AND	Cntr.	Counter	Exp.	Expansion	Hr.	Hour	N.	North	Reinf.	Reinforced	Temp.	Tempered
∠	Angle	Col.	Column	Ext.	Exterior	Hgt.	Height	N.I.C.	Not In Contract	Req'd	Required	T.&G.	Tongue & Groove
@	At	Conc.	Conc. Concrete					No. or #	Number	Resil.	Resilient	Thk.	Thick
℄	Centerline	C.T.	Ceramic Tile	F.A.	Fire Alarm	I.D.	Inside Diameter	Nom.	Nominal	Rm.	Room	T.O.M.	Top Of Masonry
ø	Diameter or Round	CMU	Concrete Masonry Unit	F.D.	Floor Drain	Insul.	Insulation	N.T.S.	Not To Scale	R.O.	Rough Opening	T.O.S.	Top Of Steel
#	Pound or Number	Ctr.	Center	Fdn.	Foundation	Int.	Interior					T.P.	Top Of Pavement
				F.E.	Fire Extinguisher			O/	On or Over	S.	South	T.P.D.	Toilet Paper Dispenser
Acous.	Acoustical	Dbl.	Double	F.E.C.	F.E. Cabinet	Jan	Janitor	Obs.	Obscure	S.B.	Splash Block	T.V.	Television
Adj.	Adjustable	Det.	Detail	Fin.	Finish	Jt.	Joint	O.C.	On Center	S.C.	Solid Core	T.W.	Tackwall
A.F.F.	Above Finished Floor	D.F.	Drinking Fountain	Fl.	Floor			O.D.	Diameter	Sched.	Schedule	Typ.	Typical
Aggr.	Aggregate	Dia.	Diameter	Flash.	Flashing	Kit.	Kitchen	Off.	Office	S.D.	Soap Dispenser	Trd.	Tread
Al.	Aluminum	Dim.	Dimension	℄	Flow line			Opng.	Opening	Sect.	Section		
Approx.	Approximate	Dn.	Down	Ft.	Foot or feet	Lab.	Laboratory	Opp.	Opposite	Shr.	Shower	U.O.N.	Unless Otherwise Noted
Arch.	Architect or Architectural	Dr.	Door	Ftg.	Footing	Lam.	Laminate			Sht.	Sheet	Ur.	Urinal
Asb.	Asbestos	Ds.	Downspout	Furr.	Furring	Lav.	Lavatory	P.	Paint	Sim.	Similar		
Asph.	Asphalt	Dwg.	Drawing	Fut.	Future	Lkr.	Locker	Pl.	Plate	S.N.D.	Sanitary Napkin Disp.	V.C.T.	Vinyl Composition Tile
A.V.	Audio Visual	Dwr.	Drawer			Lt.	Light	P.Lam.	Plastic Laminate	S.N.R.	Sanitary Napkin Recep.	V.T.	Vinyl Tile
				Ga.	Gauge			Plas.	Plaster	Spec.	Specification	V.B.	Vapor Barrier
Bd.	Board	(E)	Existing	Galv.	Galvanized	Mas.	Masonry	Plywd.	Plywood	Sq.	Square	Vert.	Vertical
Bitum.	Bituminous	E.	East or Existing	G.B.	Grab Bar	Max.	Maximum	Pr.	Pair	SST.	Stainless Steel	Vest.	Vestibule
Bldg.	Building	Ea.	Each	Gl.	Glass	M.C.	Medicine Cabinet	Pt.	Point	Std.	Standard	Vyl.	Vinyl
Blk.	Block	E.J.	Expansion Joint	Gnd.	Ground	Mech.	Mechanical	P.T.D.	Paper Towel Dispenser	Stl.	Steel		
Blk'g.	Blocking	El.	Elevation	Gr.	Grade	Memb.	Membrane	Ptn.	Partition	Stor.	Storage	W.	West
Bm.	Beam	Elec.	Electrical	Gyp.	Gypsum	Met.	Metal	P.T.R.	Paper Towel Receptacle	Strl.	Structural	w/	With
Bot.	Bottom	Elev.	Elevator			Mfr.	Manufacturer			Susp.	Suspended	w/o	Without
BO	BY OWNER	Eq.	Equal	H.B.	Hose Bibb	Mh.	Manhole	Q.T.	Quarry Tile	S.V.	Sheet Vinyl	W.C.	Wall Covering
Brg.	Bearing	Equip.	Equipment	H.C.	Hollow Core	Min.	Minimum			Sym.	Symmetrical	Wd.	Wood
Brk.	Brick	E.W.	Each Way	Hdwd.	Hardwood	Mir.	Mirror	R.	Riser			Wp.	Waterproof
		E.W.C.	Elec. Water Cooler	Hdwr.	Hardware	Misc.	Miscellaneous	Rad.	Radius	Tex.	Texture	Wdw.	Window
Cab.	Cabinet	Exist.	Existing	H.M.	Hollow Metal	M.O.	Masonry Opening	R.D.	Roof Drain	T.B.	Towel Bar	Wsct.	Wainscot
Clg.	Ceiling	Expo.	Exposed	Horiz.	Horizontal	Mtd.	Mounted	Ref.	Reference	T.Bd.	Tack Board	Wt.	Weight

SHEET INDEX

GENERAL

COVER SHEET
CFP1 CODE FOOTPRINT
UFAS 1 UNIFORM FEDERAL ACCESSIBILITY STANDARDS
UFAS 2 UNIFORM FEDERAL ACCESSIBILITY STANDARDS
UFAS 3 UNIFORM FEDERAL ACCESSIBILITY STANDARDS
FH1 FAIR HOUSING DIAGRAMS
FH2 FAIR HOUSING DIAGRAMS
FH3 FAIR HOUSING DIAGRAMS
ADA 2010 ADA STANDARD FOR ACCESSIBILITY DESIGN

CIVIL & LANDSCAPING

C1.01 SURVEY/EXISTING
C2.01 SITE PLAN
C2.02 SITE PAVING PLAN
C2.51 SITE PAVING DETAILS
C2.52 SITE PAVING DETAILS
C2.53 SITE DETAILS
C2.54 RAMP/DRIVEWAY DETAIL PLANS
C3.01 SITE AND GRADING PLAN
C4.01 UTILITY PLAN
C5.01 UTILITY PLAN
C5.51 DETAILS
L1.00 LANDSCAPE PLAN
L1.01 LANDSCAPE DETAILS

ARCHITECTURAL

A1.1 SITE PLAN
A1.2 DETAILS
A2.0 GENERAL NOTES & PARTITION SCHEDULES
A2.1 FIRST AND SECOND FLOOR PLANS
A2.2 THIRD AND FOURTH FLOOR PLANS
A2.3 ENLARGED PUBLIC AREA PLANS
A2.4 ADAPTABLE UNIT PLANS
A2.5 ACCESSIBLE UNIT PLANS
A2.6 ADAPTABLE ENLARGED BATH PLANS AND INTERIOR ELEVATIONS
A2.7 ACCESSIBLE PLANS AND INTERIOR ELEVATIONS
A2.8 KITCHEN ELEVATIONS
A2.9 BATH & KITCHEND DETAILS
A3.1 EAST & WEST EXTERIOR ELEVATIONS
A3.2 NORTH & SOUTH EXTERIOR ELEVATIONS
A3.3 BUILDING SECTIONS
A4.1 WALL SECTIONS
A4.2 WALL SECTIONS
A4.3 WALL SECTIONS
A4.4 WALL SECTIONS
A4.5 WALL SECTIONS
A4.6 WALL SECTIONS
A4.7 DETAILS
A4.8 FIRE PENTRATIONS
A4.9 AIR INFILTRATION DETAILS
A5.1 ROOF PLAN
A5.2 ROOF DETAILS
A6.1 ENLARGED STAIR PLANS
A6.2 STAIR SECTIONS
A6.3 STAIR SECTIONS
A6.4 ELEVATOR SECTION
A6.5 LAP SIDING DETAILS
A6.6 LAP SIDING DETAILS
A7.1 FIRST AND SECOND FLOOR REFLECTED CEILING PLANS
A7.2 THIRD AND FOURTH FLOOR REFLECTED CEILING PLANS
A8.1 INTERIOR ELEVATIONS
A8.2 INTERIOR ELEVATIONS
A8.3 INTERIOR ELEVATIONS
A8.4 INTERIOR ELEVATIONS
A8.5 INTERIOR ELEVATIONS
A9.1 FIRST AND SECOND FINISH FLOOR PLANS
A9.2 THIRD AND FOURTH FINISH FLOOR PLANS
A10.1 SCHEDULES
A10.2 DETAILS

STRUCTURAL

S1.0 GENERAL NOTES & SPECIFICATIONS
S1.1 GENERAL NOTES & SCHEDULES
S1.2 GENERAL NOTES & SCHEDULES
S2.1 FOUNDATION PLAN
S2.2 SECOND FLOOR FRAMING PLAN
S2.3 THIRD FLOOR FRAMING PLAN
S2.4 FOURTH FLOOR & LOW ROOF FRAMING PLAN
S2.5 ROOF FRAMING PLAN
S2.6 SHEARWALL PLAN
S3.1 DETAILS
S3.2 DETAILS
S3.3 DETAILS
S3.4 DETAILS
S3.5 DETAILS
S3.6 DETAILS

MECH, ELECT, PLUMBING

E0.1 GENERAL NOTES
E1.1 FIRST AND SECOND FLOOR ELECTRICAL PLANS
E1.2 THIRD AND FOURTH FLOOR ELECTRICAL PLANS
E1.3 FIRST AND SECOND SPECIAL SYSTEMS PLANS
E1.4 THIRD AND FOURTH SPECIAL SYSTEMS PLANS
E4.1 ADAPTABLE UNIT AND COMMONS ELECTRICAL PLAN
E4.2 ACCESSIBLE UNIT ELECTRICAL PLANS
E6.1 FIXTURE SCHEDULE
E6.2 METER DIAGRAMS & CALCULATIONS
E6.3 UNIT DESIGNATION SCHEDULES

M0.1 GENERAL NOTES
M1.1 FIRST AND SECOND FLOOR HVAC PLANS
M1.2 THIRD AND FOURTH FLOOR HVAC PLANS
M4.1 ADAPTABLE UNITS AND COMMONS HVAC PLANS
M4.2 ACCESSIBLE UNIT HVAC PLANS
M6.1 SCHEDULES

ME1.1 ELECTRICAL SITE PLAN
ME1.2 ROOF HVAC PLAN

P0.1 GENERAL NOTES
P1.1 UNDERFLOOR WASTE AND VENT PLAN
P1.2 FIRST AND SECOND FLOOR WASTE AND VENT PLAN
P1.3 THIRD AND FOURTH FLOOR WASTE AND VENT PLAN
P1.4 FIRST AND SECOND FLOOR DOMESTIC WATER PLAN
P1.5 THIRD AND FOURTH FLOOR DOMESTIC WATER PLAN
P4.1 UNIT AND COMMONS DOMESTIC WATER PLAN
P6.1 PLUMBING FIXTURE SCHEDULE
P9.1 PLUMBING RISER DETAILS

ADOPTED CODES

2006 INTERNATIONAL RESIDENTIAL CODE
2012 INTERNATIONAL BUILDING CODE
2015 INTERNATIONAL MECHANICAL CODE
2015 UNIFORM PLUMBING CODE
2014 NATIONAL ELECTRICAL CODE
2012 INTERNATIONAL FIRE CODE
CITY OF ANDOVER PROPERTY MAINTENANCE CODE
ADA: 2010 ADA STANDARDS

1-3-2025

PERMIT SET 1

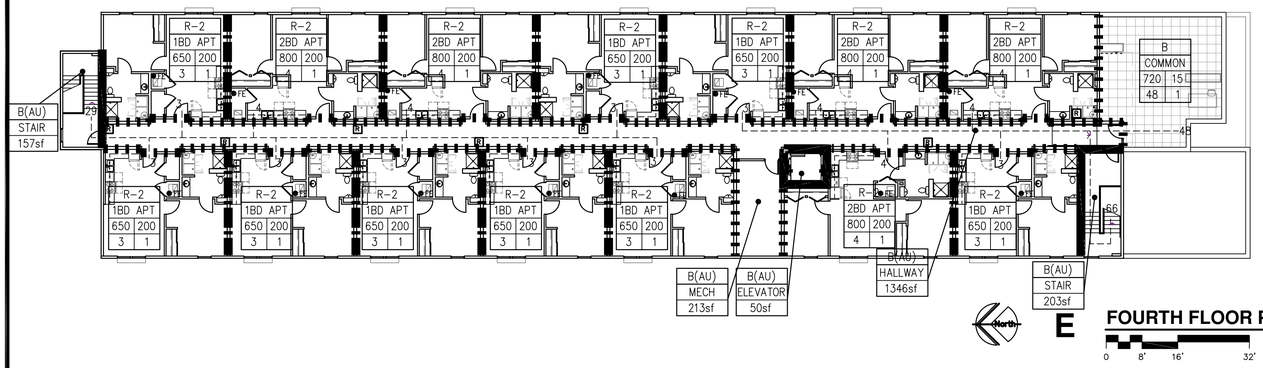

E **FOURTH FLOOR PLAN**

0 8' 16' 32'

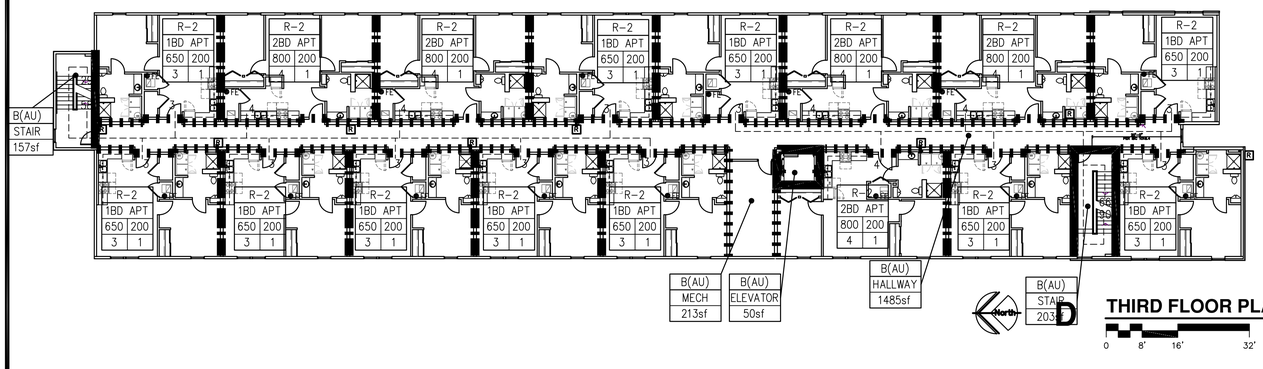

D **THIRD FLOOR PLAN**

0 8' 16' 32'

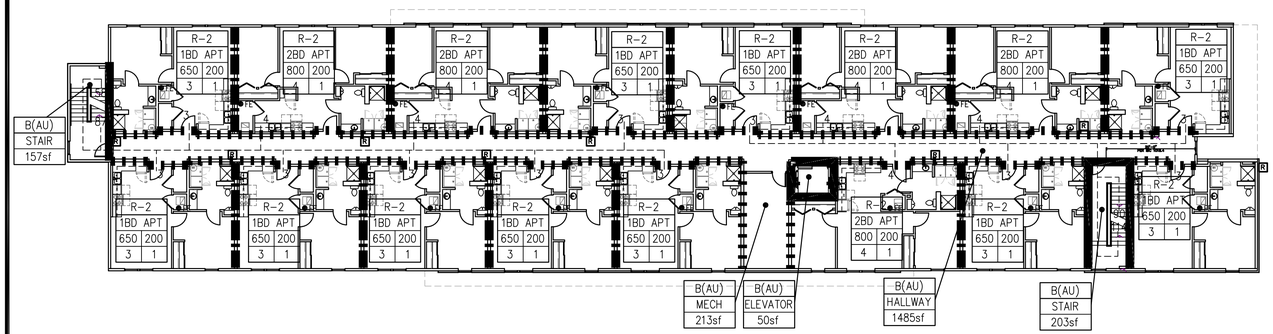

C **SECOND FLOOR PLAN**

0 8' 16' 32'

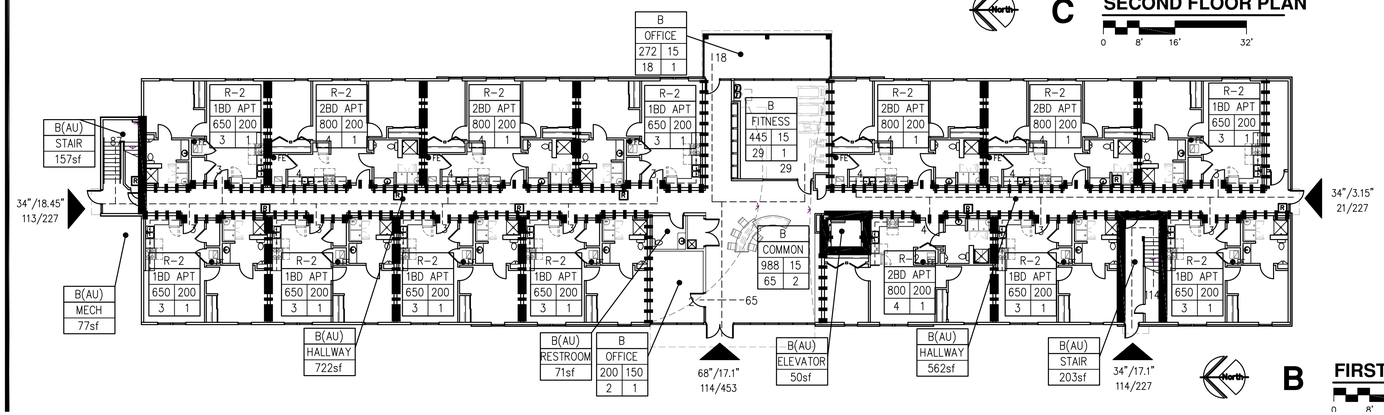

B **FIRST FLOOR PLAN**

0 8' 16' 32'

CODE INFORMATION

OCCUPANCY OVERALL: MIXED OCCUPANCY

OCCUPANCY GROUPS: B OFFICE
R-2 APARTMENTS

CONSTRUCTION TYPE: V-A

BASIC ALLOWABLE AREA: B 18,000 SF
R-2 12,000 SF

ALLOWABLE AREA INCREASE: *(NON-SEPARATED USES PER IBC SEC. 508.3)*

	R-2
BASE ALLOWABLE	12,000 SF
AREA INCREASE (33.75%)	4,050 SF
FIRE SPRINKLER INCREASE (NONE)	
SUB-TOTAL ALLOWABLE (PER FLOOR)	16,050 SF
4 FLOORS	x4
TOTAL BUILDING ALLOWABLE AREA	64,200 SF

ACTUAL BUILDING AREA:

FIRST FLOOR	12,869 SF
SECOND FLOOR	13,162 SF
THIRD FLOOR	13,162 SF
FOURTH FLOOR	12,502 SF
TOTAL BLDG AREA	51,695 SF

BASIC ALLOWABLE STORIES:	3
STORIES INCREASE *(PER IBC SEC. 504.2)*	1
TOTAL ALLOWABLE STORIES	4
BASIC ALLOWABLE HEIGHT:	50'
HEIGHT INCREASE *(PER IBC SEC. 504.2)*	20'
TOTAL ALLOWABLE HEIGHT	60'

ACTUAL STORIES: 4

ACTUAL HEIGHT: 48'

FIRE RESISTANCE RATING FOR BUILDING ELEMENTS: V-A

EXTERIOR BEARING WALLS:	1 HOUR	*(INTERIOR RATING ONLY, PER IBC SEC. 705.5, FS>10')*
STRUCTURAL FRAME:	1 HOUR	
INTERIOR BEARING WALLS:	1 HOUR	
INTERIOR NON-BEARING WALLS:	0 HOUR	
SHAFT ENCLOSURES:	2 HOUR	
FLOOR/CEILING ASSEMBLY:	1 HOUR	
CEILING/ROOF ASSEMBLY:	1 HOUR	
CORRIDOR/DWELLING UNITS:	1/2 HOUR	*(Table 1018.1)*

OCCUPANCY SEPARATIONS:
(NON-SEPARATED USES. PER IBC SEC. 508.3)
ALLOWABLE AREA & HEIGHT CALCULATIONS ARE BASED ON THE MOST RESTRICTIVE USE. DIFFERENT USES ARE NOT SEPARATED BY FIRE BARRIERS.
R2 TO R2 SEPARATION OF DWELLING UNITS = 1HR, 45 MIN. OPNGS

ROOF COVERINGS *CLASS B OR BETTER*

INCIDENTAL SEPARATIONS: *(PER IBC TABLE 509)*
STORAGE ROOMS OVER 100 SF – SPRINKLER SYSTEM (SMOKE BARRIER)
DWELLING UNITS –1 HR FIRE PARTITIONS

SPECIAL CONDITIONS:
EXIT & EMERGENCY LIGHTING, MANUAL FIRE ALARM
PORTABLE FIRE EXTINGUISHERS IN EACH DWELLING UNIT *(PER IBC 906.1 EXCEPTION 1)*

FIRE ALARM REQUIREMENTS:
REQUIRED, PROVIDED – MANUAL & AUTOMATIC FIRE ALARM SYSTEM PER NFPA 72
SIGNALING SYSTEM IS AUDIBLE/VISUAL PER NFPA 72 & ADA INSTALLED THROUGHOUT
INITIATING DEVICES: PULL STATIONS; SMOKE DETECTION @ SLEEPING & COMMON AREAS, SPRINKLER SYSTEM FLOW AND TAMPER SWITCHES MONITORED.

SMOKE ALARM REQUIREMENTS:
REQUIRED, PROVIDED – SLEEPING ROOMS & AT EACH FLOOR

AUTOMATIC FIRE SUPPRESSION SYSTEM:
REQUIRED, PROVIDED PER NFPA 13R (IBC 903.3.1.2)

EMERGENCY POWER SOURCE:
EXIT SIGNS, EXIT ILLUMINATION & EMERGENCY LIGHTING IS BY BATTERY BACK-UP

HAZARDOUS MATERIALS: *(PER IBC TABLE 307.1(1))*
NO HAZARDOUS MATERIALS ARE TO BE STORED

SMOKE CONTROL: NOT REQUIRED
SMOKE PARTITIONS: NOT REQUIRED
STANDPIPES: *(PER IBC 905.3.1 EXCEPTION 1)* CLASS 1 REQUIRED

ASSEMBLY
SIGNS TO BE MOUNTED IN ASSEMBLY AREAS OF MAXIMUM OCCUPANT LOAD

TOTAL OCCUPANT LOAD: 362

EXITING: REFERENCE PLAN

OCCUPANT LOAD FACTORS:

OCCUPANCY	USE	LOAD FACTOR	MAX. OCC LD=1 EXIT
B	LOBBY	15 sf/OCCUPANT	49
B	OFFICE	150 sf/OCCUPANT	49
B	MECH/ELEC	300 sf/OCCUPANT	49
R-2	APARTMENT	200 sf/OCCUPANT	10

PROJECT INFORMATION

TYPE OF CONSTRUCTION	NEW SENIOR LIVING UNITS
FACILITY NAME	THE RESIDENCE at HERITAGE WEST
FACILITY ADDRESS	xxx E. WILLOWBROOK ST. ANDOVER, KS
OWNER NAME OWNER ADDRESS	OPG HERITAGE WEST PARTNERS, LLC 227 N SANTA FE, STE 310 SALINA, KS 67401 ph: 913-396-6310 fax: 913-396-6312
REASON FOR SUBMITTAL	NEW CONSTRUCTION
COUNTY	BUTLER
FIRE DEPARTMENT	ANDOVER
WATER SUPPLY	ANDOVER
BUILDING INSPECTION DEPT	ANDOVER
AUTHORITY HAVING JURISDICTION	ANDOVER
ARCHITECT	JONES GILLAM RENZ ARCHITECTS, INC. 730 N. NINTH ST. SALINA, KS 67401 ph: 785-827-0386 fax: 785-827-0392
CODES/REGULATIONS	2012 INTERNATIONAL BUILDING CODE 2015 INTERNATIONAL MECHANICAL CODE 2015 UNIFORM PLUMBING CODE 2014 NATIONAL ELECTRICAL CODE 2012 INTERNATIONAL FIRE CODE 2018 INTERNATIONAL ENERGY CONSERVATION CODE FAIR HOUSING ACT DESIGN MANUAL 2010 ADA STANDARDS for ACCESSIBLE DESIGN 2009 ICC A117.1 ACCESSIBLE & USABLE BUILDINGS and FACILITIES

Wichita-Sedgwick County Metropolitan Area Building and Construction Department

REVIEWED FOR CODE COMPLIANCE

CORRECTIONS OR COMMENTS MADE ON THESE DRAWINGS AND THIS DOCUMENT DURING THIS REVIEW DO NOT RELIEVE CONTRACTOR FROM COMPLIANCE WITH ALL REQUIREMENTS OF THE CODE OF THE MABCD, THE CITY OF WICHITA OR SEDGWICK COUNTY. THIS REVIEW IS ONLY FOR GENERAL CONFORMANCE OF THE CODE. THE CONTRACTOR IS RESPONSIBLE FOR CONFORMING AND CORRELATING ALL TECHNIQUES OF CONSTRUCTION. THIS APPROVAL IS SUBJECT TO PROVISIONS OF SECTION 107.4 OF THE 2012 INTERNATIONAL BUILDING CODE.

DATE: 02/19/25 BY: William Jerauld Jr

LEGEND

DESIGNATED EMERGENCY EXIT — 68"/24.4" ⟵ EXIT WIDTH (ACTUAL/REQUIRED); 122/340 ⟵ OCCUPANT LOAD (ACTUAL/ALLOWED)

1 HOUR CONSTRUCTION (LD BRG WALLS)

1/2 HOUR FIRE PARTITION; CORRIDOR *(PER IBC TABLE 1018.1)* W/ 20 MIN OPENINGS *(PER IBC TABLE 716.5)*

1 HOUR FIRE PARTITION; BETWEEN DWELLING, SLEEPING UNITS W/ 45 MIN OPENINGS *(PER IBC 709.3 & 713.4)*

2 HOUR CONSTRUCTION; EXIT ENCLOSURE, SHAFT WALLS, W/ 90 MIN OPENINGS *(PER IBC TABLE 716.5)*

EXIT LIGHT
EMERGENCY LIGHT
EXIT/EMERGENCY LIGHT
FIRE EXTINGUISHER — FE
FIRE HYDRANT — FH
FIRE ALARM REMOTE ANNUNCIATOR PANEL — FAAP
FIRE ALARM CONTROL PANEL — FACP

	EXAMPLE:
OCCUPANCY GROUP (AU – ACCESSORY USE)	A-1
OCCUPANCY USE	ASSEMBLY HALL
ROOM SQUARE FOOTAGE/OCCUPANT LOAD FACTOR	5,550 15
OCCUPANT LOAD/REQUIRED NUMBER OF EXITS	370 2

(EXIST WIDTH/LOAD FACTOR 0.15 PER 1005.3.2 EXCEPTION)

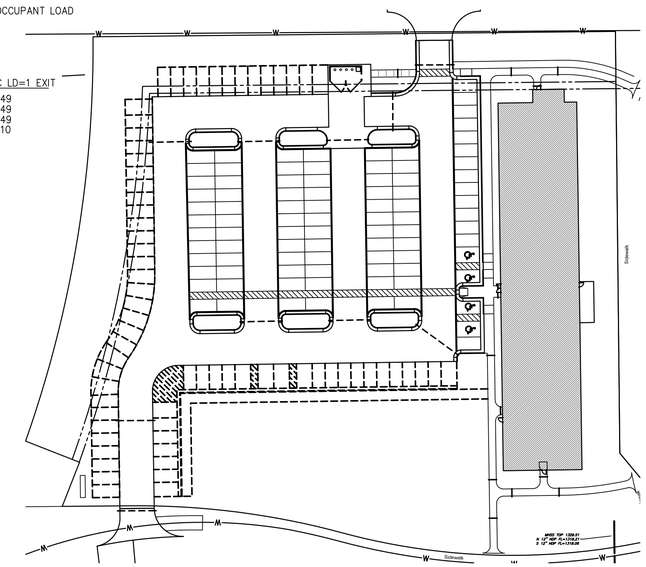

A **SITE PLAN**

0 25' 50' 100'
1"=50'-0"

CODE FOOT PRINT & INFORMATION

THE RESIDENCE AT HERITAGE WEST

NEW SENIOR-LIVING FACILITY

ANDOVER, KANSAS

JonesGillamRenz
730 N. Ninth 1881 Main Street, Suite 301
Salina, KS 67401 Kansas City, MO 64108
785.827.0386 jgr@jgrarchitects.com

CHRISTOPHER R. GILLAM REGISTERED 6979 1/3/2025 KANSAS ARCHITECT

REVISION:

DATE: 1-3-2025
JOB: 24-3379
SHEET NO.:

CFP

COPYRIGHTED ©

Wichita-Sedgwick County
Metropolitan Area Building
and Construction Department

REVIEWED FOR CODE COMPLIANCE

CORRECTIONS OR COMMENTS MADE ON THESE DRAWINGS AND THIS DOCUMENT DURING THIS REVIEW DO NOT RELIEVE CONTRACTOR FROM COMPLIANCE WITH ALL REQUIREMENTS OF THE CODE OF THE MARCH, THE CITY OF WICHITA OR SEDGWICK COUNTY. THIS REVIEW IS ONLY FOR GENERAL CONFORMANCE OF THE CODE. THE CONTRACTOR IS RESPONSIBLE FOR CONFORMING AND CORRELATING ALL TECHNIQUES OF CONSTRUCTION. THIS APPROVAL IS SUBJECT TO PROVISIONS OF SECTION 107.4 OF THE 2012 INTERNATIONAL BUILDING CODE.

DATE: 02/19/25 BY: William Jerauld Jr

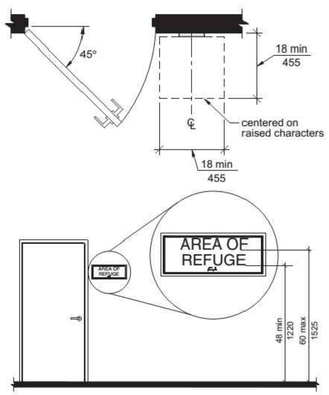

Note: For braille character mounting height see Section 703.4.5

U SIGNAGE (Section 703)
NO SCALE

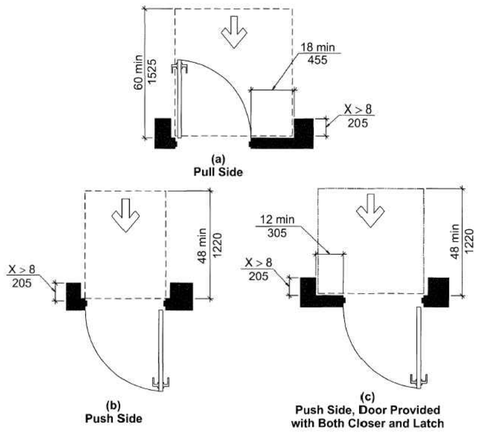

Q MANEUVERING CLEARANCES AT RECESSED DOORS (Section 404)
NO SCALE

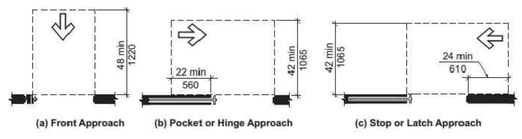

P MANEUVERING CLEARANCES AT SLIDING & FOLDING DOORS (Section 404)
NO SCALE

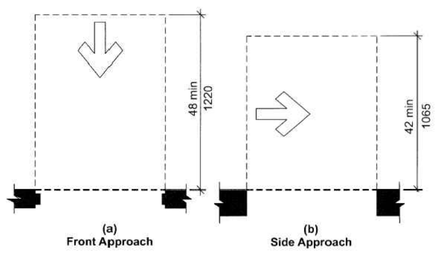

O MANEUVERING CLEARANCES AT DOORWAYS without DOORS (Section 404)
NO SCALE

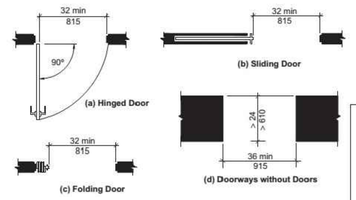

N CLEAR WIDTH OF DOORWAYS (Section 404)
NO SCALE

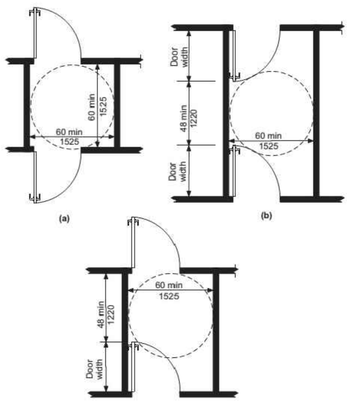

M TWO DOORS IN SERIES (Section 404)
NO SCALE

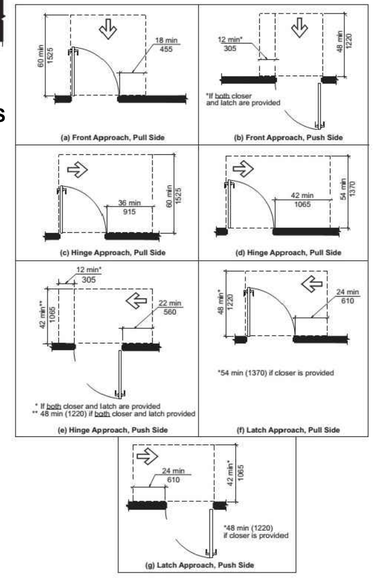

L MANEUVERING CLEARANCE AT MANUAL SWINGING DOORS (Section 404)
NO SCALE

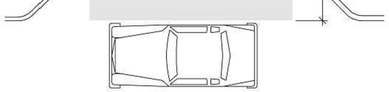

H PASSENGER LOADING ZONE (Section 503)
NO SCALE

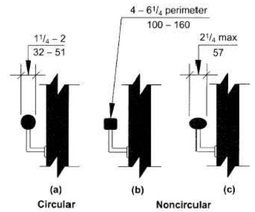

K HANDRAIL CROSS SECTION (Section 505)
NO SCALE

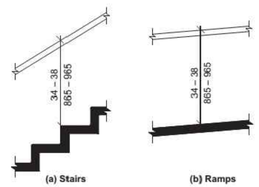

J HANDRAIL HEIGHT (Section 505)
NO SCALE

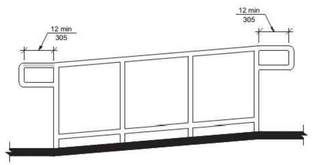

G RAMP TOP & BOTTOM HANDRAIL EXTENTION (Section 505)
NO SCALE

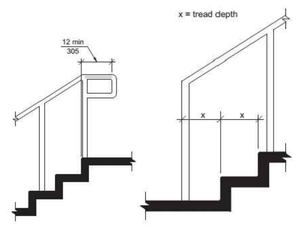

F STAIR TOP & BOTTOM HANDRAIL EXTENTION (Section 505)
NO SCALE

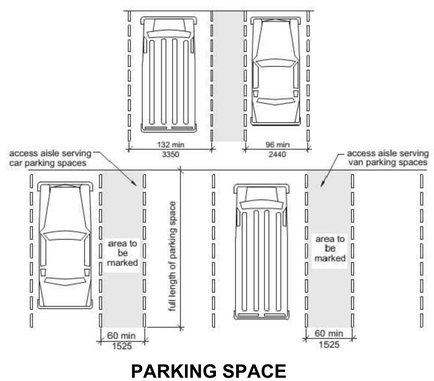

E PARKING SPACE (Section 502)
NO SCALE

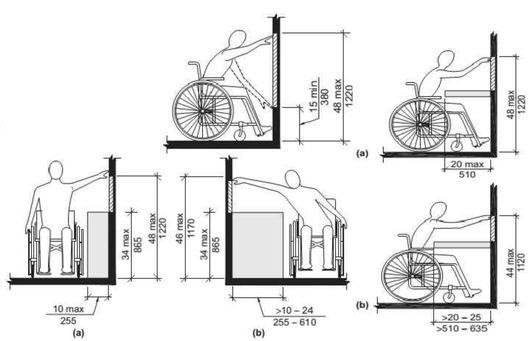

D REACH CLEARANCES (Section 308)
NO SCALE

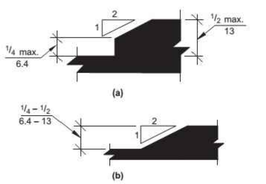

C CHANGES IN LEVEL (Section 303)
NO SCALE

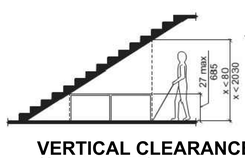

B VERTICAL CLEARANCE (Section 307)
NO SCALE

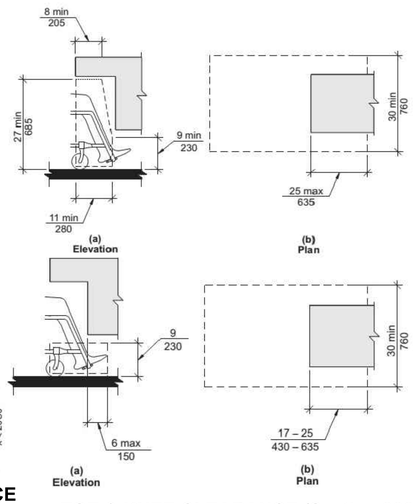

A TOE & KNEE CLEARANCE (Section 306)
NO SCALE

FOR REFERENCE ONLY

JonesGillamRenz
730 N. Ninth 1881 Main Street, Suite 301
Salina, KS 67401 Kansas City, MO 64108
785.827.0386 jgr@jgrarchitects.com

THE RESIDENCE AT HERITAGE WEST

NEW SENIOR-LIVING FACILITY

ANDOVER, KANSAS

CHRISTOPHER R. GILLAM
REGISTERED ARCHITECT
6979
1/3/2025
KANSAS
ARCHITECT

REVISION:

DATE: 1-3-2025
JOB: 24-3379
SHEET NO.:

ANSI1

COPYRIGHTED©

Wichita-Sedgwick County
Metropolitan Area Building
and Construction Department

REVIEWED FOR CODE COMPLIANCE

CORRECTIONS OR COMMENTS MADE ON THESE DRAWINGS AND THIS DOCUMENT DURING THIS REVIEW DO NOT RELIEVE CONTRACTOR FROM COMPLIANCE WITH ALL REQUIREMENTS OF THE CODE OF THE MABCD, THE CITY OF WICHITA OR SEDGWICK COUNTY. THIS REVIEW IS ONLY FOR GENERAL CONFORMANCE OF THE CODE. THE CONTRACTOR IS RESPONSIBLE FOR CONFORMING AND CORRELATING ALL TECHNIQUES OF CONSTRUCTION. THIS APPROVAL IS SUBJECT TO PROVISIONS OF SECTION 107.4 OF THE 2012 INTERNATIONAL BUILDING CODE.

DATE: 02/19/25 BY: William Jerauld Jr

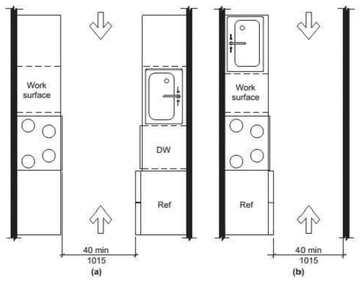

J PASS-THRU KITCHEN CLEARANCE (Section 804)
NO SCALE

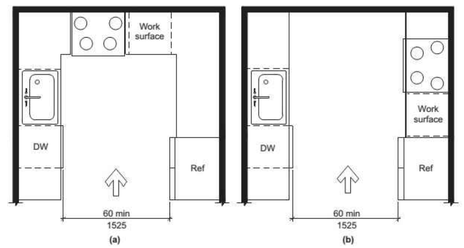

H U-SHAPED KITCHEN CLEARANCE (Section 804)
NO SCALE

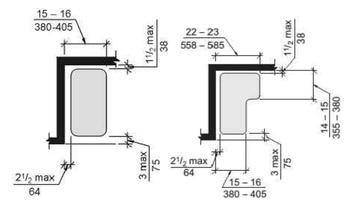

G SHOWER SEATS (Section 610)
NO SCALE

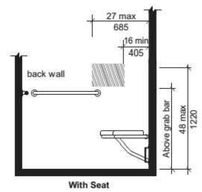

F ROLL-IN SHOWER CONTROLS LOCATION (Section 608)
NO SCALE

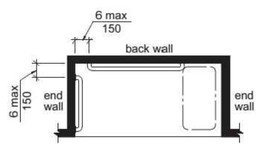

E ROLL-IN SHOWER GRAB BARS (Section 608)
NO SCALE

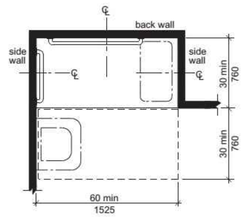

D ROLL-IN SHOWER SIZE & CLEARANCE (Section 608)
NO SCALE

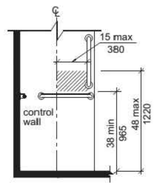

C TRANSFER SHOWER CONTROLS LOCATION (Section 608)
NO SCALE

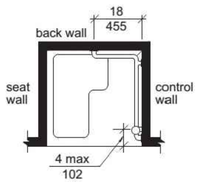

B TRANSFER SHOWER GRAB BARS (Section 608)
NO SCALE

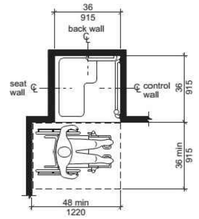

A TRANSFER SHOWER SIZE & CLEARANCE (Section 608)
NO SCALE

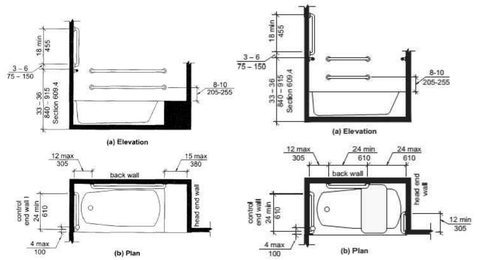

BB GRAB BARS FOR BATHTUBS (Section 607)
NO SCALE

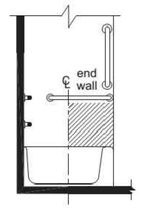

AA BATHTUB CONTROLS (Section 607)
NO SCALE

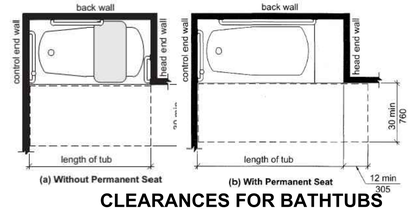

Z CLEARANCES FOR BATHTUBS (Section 607)
NO SCALE

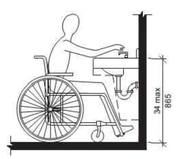

T HEIGHT OF LAVATORIES & SINKS (Section 606)
NO SCALE

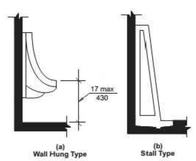

S HEIGHT OF URINALS (Section 605)
NO SCALE

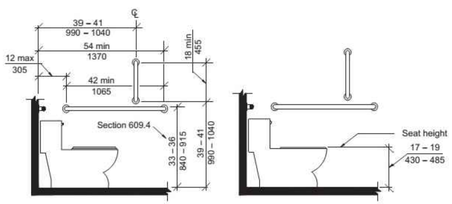

Y WATER CLOSET HEIGHT & SIDE WALL GRAB BAR (Section 604)
NO SCALE

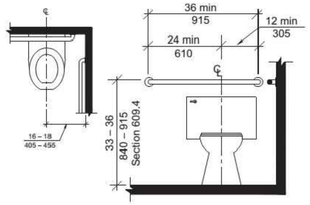

X WATER CLOSET LOCATION & REAR WALL GRAB BAR (Section 604)
NO SCALE

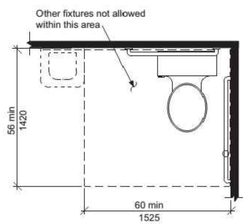

W CLEARANCES AT WATER CLOSET (Section 604)
NO SCALE

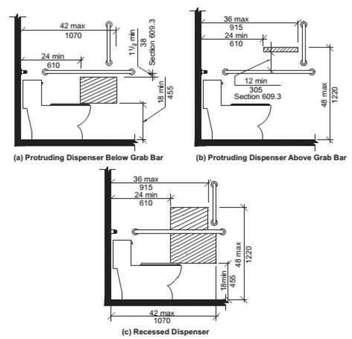

V DISPENCER OUTLET LOCATION (Section 604)
NO SCALE

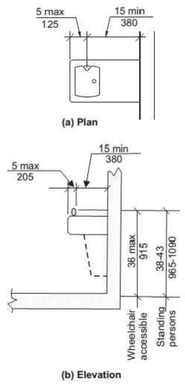

R DRINKING FOUNTAIN (Section 602)
NO SCALE

FOR REFERENCE ONLY

JonesGillamRenz
730 N. Ninth 1881 Main Street, Suite 301
Salina, KS 67401 Kansas City, MO 64108
785.827.0386 jgr@jgrarchitects.com

THE RESIDENCE AT HERITAGE WEST

NEW SENIOR-LIVING FACILITY

ANDOVER, KANSAS

CHRISTOPHER R. GILLAM
ARCHITECT LICENSED
6979
1/3/2025
KANSAS
ARCHITECT

REVISION:

DATE: 1–3–2025
JOB: 24–3379
SHEET NO.:

ANSI2

COPYRIGHTED©

Wichita-Sedgwick County
Metropolitan Area Building
and Construction Department

REVIEWED FOR CODE COMPLIANCE

CORRECTIONS OR COMMENTS MADE ON THESE DRAWINGS AND THIS DOCUMENT DURING THIS REVIEW DO NOT RELIEVE CONTRACTOR FROM COMPLIANCE WITH ALL REQUIREMENTS OF THE CODE OF THE MABCD, THE CITY OF WICHITA OR SEDGWICK COUNTY. THIS REVIEW IS ONLY FOR GENERAL CONFORMANCE OF THE CODE. THE CONTRACTOR IS RESPONSIBLE FOR CONFORMING AND CORRELATING ALL TECHNIQUES OF CONSTRUCTION. THIS APPROVAL IS SUBJECT TO PROVISIONS OF SECTION 107.4 OF THE 2012 INTERNATIONAL BUILDING CODE.

DATE: 02/19/25 BY: William Jerauld Jr

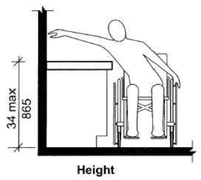

X LAVATORY AT TYPE B UNITS - OPT B BATH (Section 1004)
NO SCALE

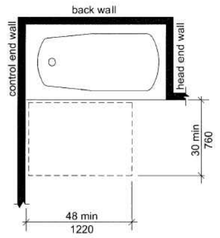

W BATHTUB CLEARANCES AT TYPE B UNITS - OPT B BATH (Section 1004)
NO SCALE

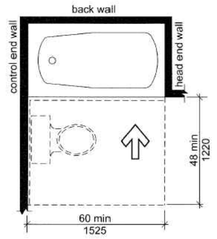

V BATHTUB CLEARANCES AT TYPE B UNITS - OPT A BATH (Section 1004)
NO SCALE

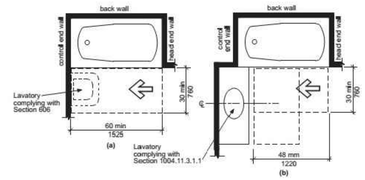

U BATHTUB CLEARANCES AT TYPE B UNITS - OPT A BATH (Section 1004)
NO SCALE

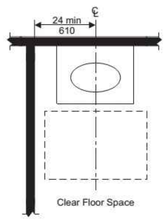

T LAVATORY AT TYPE B UNITS - OPT A BATH (Section 1004)
NO SCALE

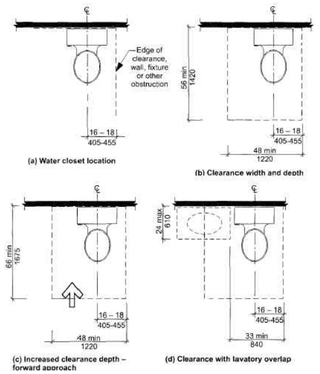

S WATER CLOSET CLEARANCES TYPE B UNITS (Section 1004)
NO SCALE

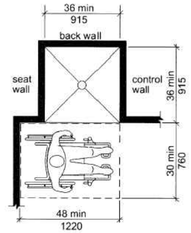

R TRANSFER SHOWER AT TYPE B UNITS (Section 1004)
NO SCALE

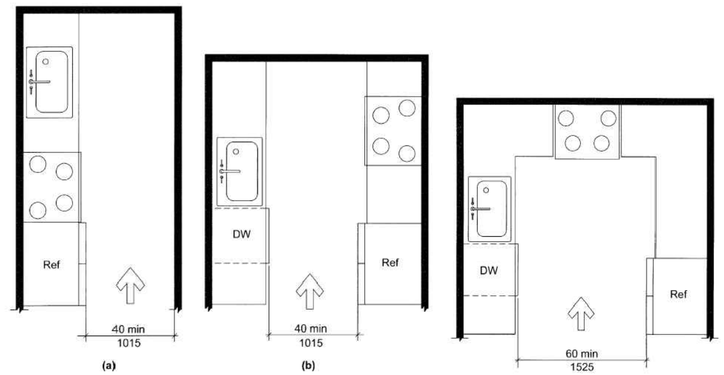

Q MIN KITCHEN CLEARANCE - TYPE B UNITS (Section 1004)
NO SCALE

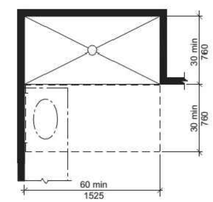

P ROLL-IN SHOWER CLEARANCES TYPE A UNITS (Section 1003)
NO SCALE

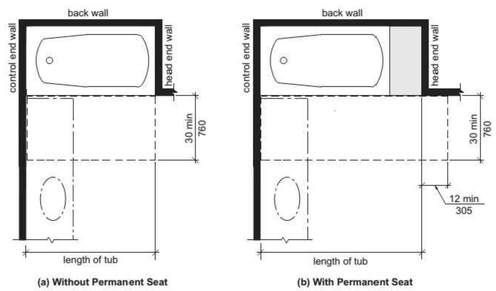

O BATHTUB CLEARANCES TYPE A UNITS (Section 1003)
NO SCALE

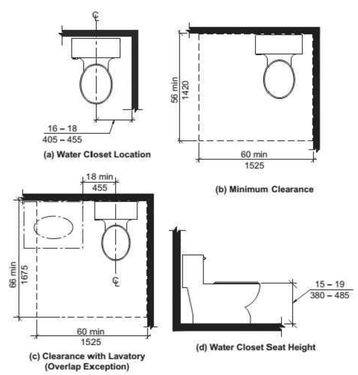

N WATER CLOSET CLEARANCES TYPE A UNITS (Section 1003)
NO SCALE

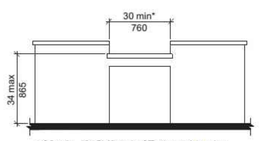

M WORK SURFACE - TYPE A UNITS (Section 1003)
NO SCALE

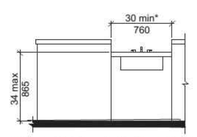

L KITCHEN SINK - TYPE A UNITS (Section 1003)
NO SCALE

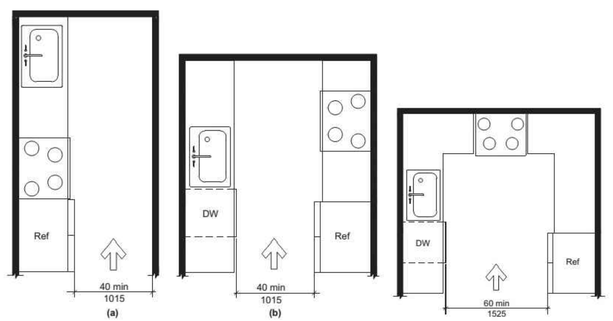

K MIN KITCHEN CLEARANCE - TYPE A UNITS (Section 1003)
NO SCALE

FOR REFERENCE ONLY

JonesGillamRenz
730 N. Ninth 1881 Main Street, Suite 301
Salina, KS 67401 Kansas City, MO 64108
785.827.0386 jgr@jgrarchitects.com

THE RESIDENCE AT HERITAGE WEST

NEW SENIOR-LIVING FACILITY

ANDOVER, KANSAS

CHRISTOPHER R. GILLAM
ARCHITECT LICENSED
6979
1/3/2025
KANSAS
ARCHITECT

REVISION:

DATE: 1–3–2025
JOB: 24–3379
SHEET NO.:

ANSI3

COPYRIGHTED©

Wichita-Sedgwick County
Metropolitan Area Building
and Construction Department

REVIEWED FOR CODE COMPLIANCE

CORRECTIONS OR COMMENTS MADE ON THESE DRAWINGS AND THIS DOCUMENT DURING THIS REVIEW DO NOT RELIEVE CONTRACTOR FROM COMPLIANCE WITH ALL REQUIREMENTS OF THE CODE OF THE MABCD, THE CITY OF WICHITA OR SEDGWICK COUNTY. THIS REVIEW IS ONLY FOR GENERAL CONFORMANCE OF THE CODE. THE CONTRACTOR IS RESPONSIBLE FOR CONFORMING AND CORRELATING ALL TECHNIQUES OF CONSTRUCTION. THIS APPROVAL IS SUBJECT TO PROVISIONS OF SECTION 107.4 OF THE 2012 INTERNATIONAL BUILDING CODE.

DATE: 02/19/25 BY: William Jerauld Jr

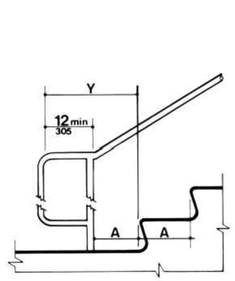

Figure 19(c)
Stair Handrails - Extension at Bottom of Run

Note: X is the 12 in minimum handrail extension required at each top riser. Y is the minimum handrail extension of 12 in plus the width of one tread that is required at each bottom riser.

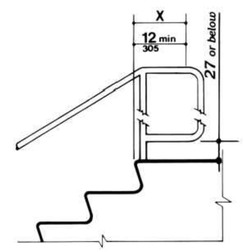

Figure 19(d)
Stair Handrails - Extension at Top of Run

Note: X is the 12 in minimum handrail extension required at each top riser. Y is the minimum handrail extension of 12 in plus the width of one tread that is required at each bottom riser.

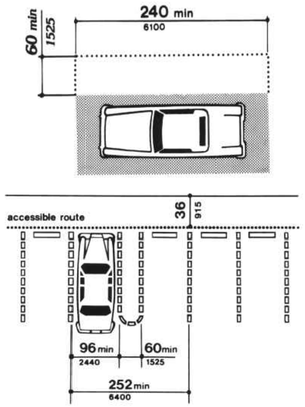

B STANDARD UFAS PARKING SPACES
NO SCALE

J STANDARD UFAS HANDRAILS
NO SCALE

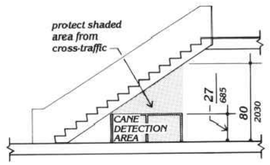

F GENERAL UFAS DIAGRAM
NO SCALE

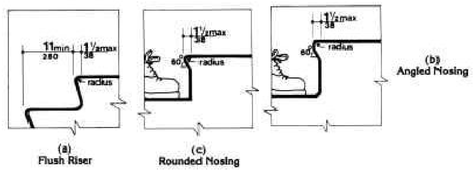

C STAIR NOSINGS
NO SCALE



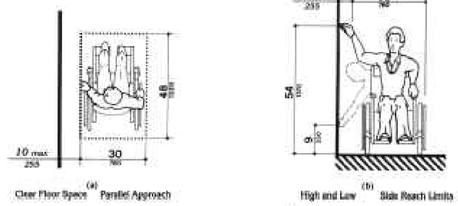

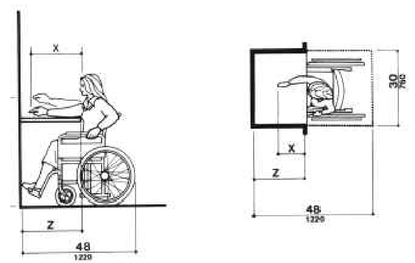

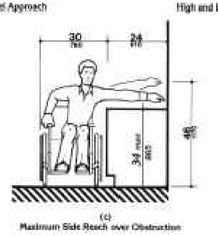

A STANDARD UFAS REACH DIAGRAMS
NO SCALE

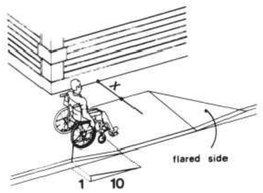

Figure 12(a)

4.7.5 SIDES OF CURB RAMPS. If a curb ramp is located where pedestrians must walk across the ramp, or where it is not protected by handrails or guardrails, then it shall have flared sides; the maximum slope of the flare shall be 1:10 (see Fig. 12(a)). Curb ramps with returned curbs may be used where pedestrians would not normally walk across the ramp (see Fig. 12(b)).

Note: If X is less than 48 inches, then the slope of the flared side shall not exceed 1:12.

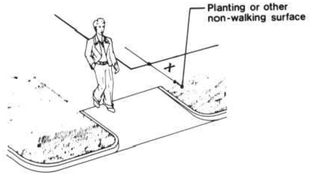

Figure 12(b)

H STANDARD UFAS CURB RAMPS
NO SCALE

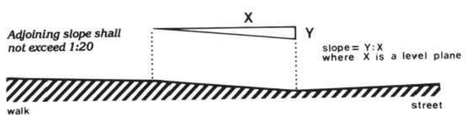

G STANDARD UFAS SLOPE
NO SCALE

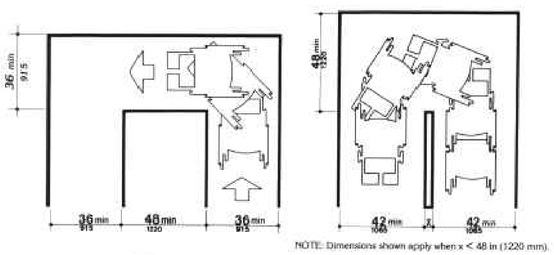

NOTE: Dimensions shown apply when x < 48 in (1220 mm).

E UFAS WIDTH DIAGRAMS
NO SCALE

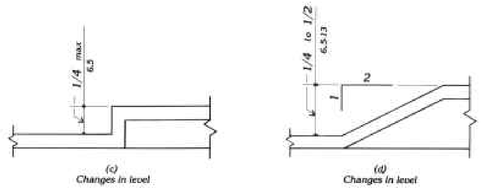

D UFAS CHANGE IN LEVEL DIAGRAM
NO SCALE

NOTE:
REFERENCE FULL UNIFORM FEDERAL ACCESSIBILITY STANDARDS FOR ADDITIONAL INFORMATION.

FOR REFERENCE ONLY

JonesGillamRenz
730 N. Ninth
Salina, KS 67401
1881 Main Street, Suite 301
Kansas City, MO 64108
785.827.0386
jgr@jgrarchitects.com

THE RESIDENCE AT HERITAGE WEST
NEW SENIOR-LIVING FACILITY
ANDOVER, KANSAS

CHRISTOPHER R. GILLAM
REGISTERED
6979
1/3/2025
KANSAS
ARCHITECT

REVISION:

DATE: 1-3-2025
JOB: 24-3379
SHEET NO.:

UFAS 1

COPYRIGHTED ©

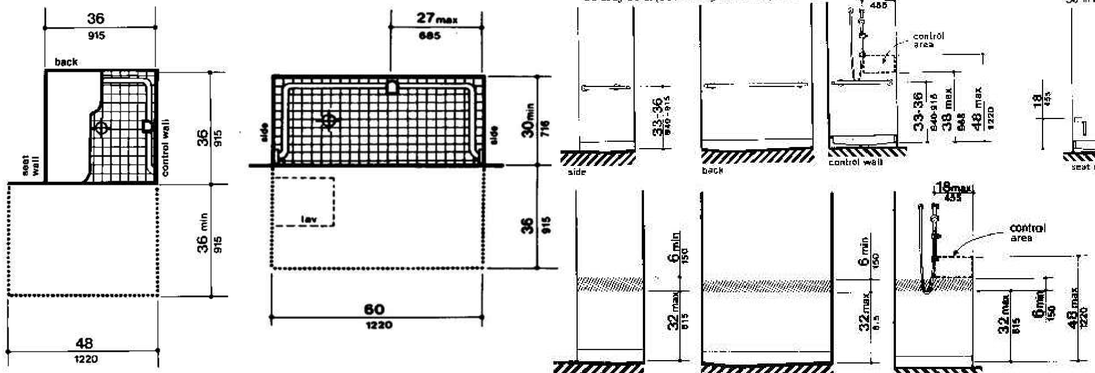

H STANDARD SHOWER UFAS DIAGRAMS

NO SCALE

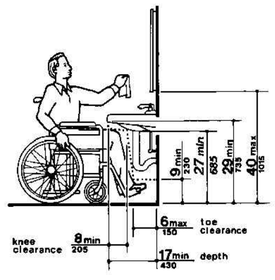

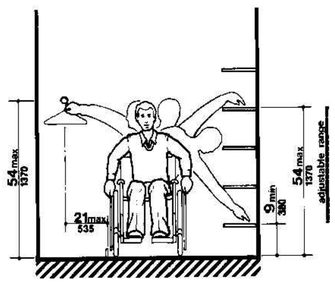

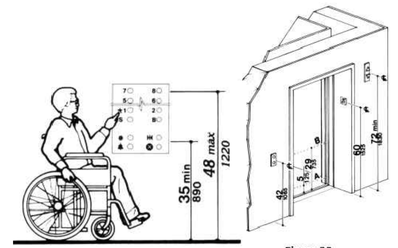

Figure 20
Hoistway and Elevator Entrances

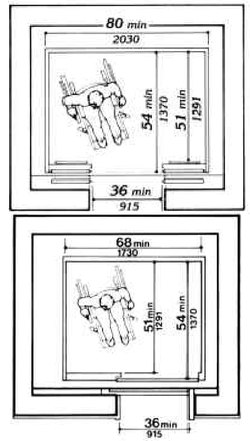

(b)

Note: The automatic door reopening device is activated if an object passes through either line A or line B. Line A and line B represent the vertical locations of the door reopening device not requiring contact.

Recommend the 80 in. interior clearance elevator car to properly accommodate an EMS cot

G UFAS LAVRATORY CLEARANCES

NO SCALE

F STANDARD UFAS CLOSET/STORAGE HEIGHT

NO SCALE

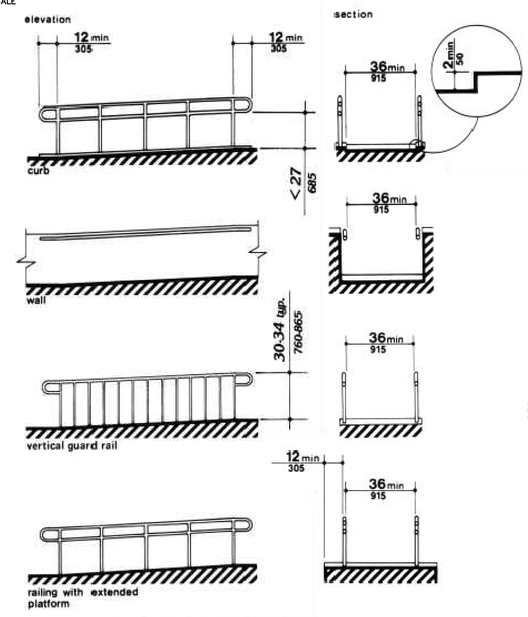

E STANDARD UFAS ELEVATOR DETAILS

NO SCALE

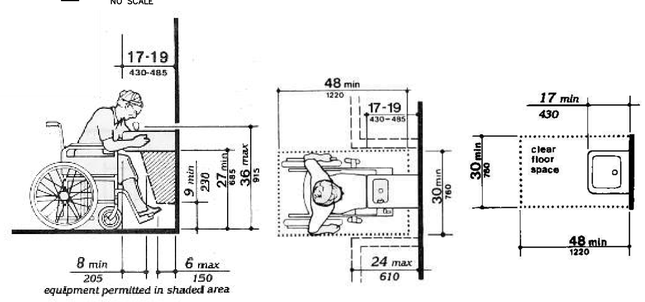

B STANDARD UFAS DRINKING FOUNTAIN CLEARANCE

NO SCALE

SYMBOL KEY:
1. Countertop or wall-mounted oven.
2. Pull-out board preferred with side-opening door.
3. Clear open space.
4. Bottom-hinged door.

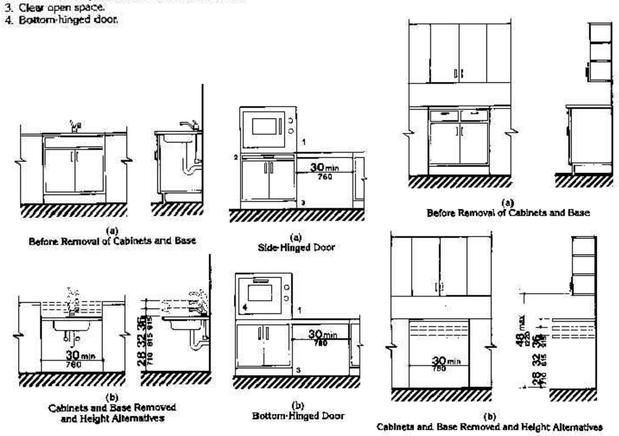

D STANDARD UFAS KITCHEN DIAGRAMS

NO SCALE

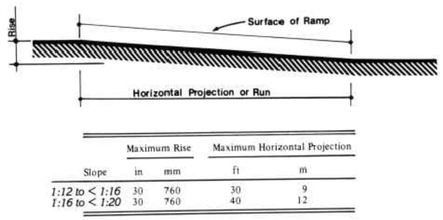

Slope	Maximum Rise in	Maximum Rise mm	Maximum Horizontal Projection ft	Maximum Horizontal Projection m
1:12 to < 1:16	30	760	30	9
1:16 to < 1:20	30	760	40	12

NOTE:
REFERENCE FULL UNIFORM FEDERAL ACCESSIBILITY STANDARDS FOR ADDITIONAL INFORMATION.

C UFAS EDGE PROTECTION

NO SCALE

A SLOPE AND RISE

NO SCALE

FOR REFERENCE ONLY

Wichita-Sedgwick County
Metropolitan Area Building
and Construction Department

REVIEWED FOR CODE COMPLIANCE

CORRECTIONS OR COMMENTS MADE ON THESE DRAWINGS AND THIS DOCUMENT DURING THIS REVIEW DO NOT RELIEVE CONTRACTOR FROM COMPLIANCE WITH ALL REQUIREMENTS OF THE CODE OF THE MARCH, THE CITY OF WICHITA OR SEDGWICK COUNTY. THIS REVIEW IS ONLY FOR GENERAL CONFORMANCE OF THE CODE. THE CONTRACTOR IS RESPONSIBLE FOR CONFORMING AND CORRELATING ALL TECHNIQUES OF CONSTRUCTION. THIS APPROVAL IS SUBJECT TO PROVISIONS OF SECTION 107.4 OF THE 2012 INTERNATIONAL BUILDING CODE.

DATE: 02/19/25 BY: William Jerauld Jr

JonesGillamRenz
730 N. Ninth
Salina, KS 67401
1881 Main Street, Suite 301
Kansas City, MO 64108
785.827.0386
jgr@jgrarchitects.com

THE RESIDENCE AT HERITAGE WEST

NEW SENIOR-LIVING FACILITY

ANDOVER, KANSAS

CHRISTOPHER R. GILLAM
LICENSED
ARCHITECT
6979
1/3/2025
KANSAS

REVISION:

DATE: 1-3-2025
JOB: 24-3379
SHEET NO.:

UFAS 2

COPYRIGHTED ©

Wichita-Sedgwick County
Metropolitan Area Building
and Construction Department

REVIEWED FOR CODE COMPLIANCE

CORRECTIONS OR COMMENTS MADE ON THESE DRAWINGS AND THIS DOCUMENT DURING THIS REVIEW DO NOT RELIEVE CONTRACTOR FROM COMPLIANCE WITH ALL REQUIREMENTS OF THE CODE OF THE MARCH, THE CITY OF WICHITA OR SEDGWICK COUNTY. THIS REVIEW IS ONLY FOR GENERAL CONFORMANCE OF THE CODE. THE CONTRACTOR IS RESPONSIBLE FOR CONFORMING AND CORRELATING ALL TECHNIQUES OF CONSTRUCTION. THIS APPROVAL IS SUBJECT TO PROVISIONS OF SECTION 107.4 OF THE 2012 INTERNATIONAL BUILDING CODE.

DATE: 02/19/25 BY: William Jerauld Jr

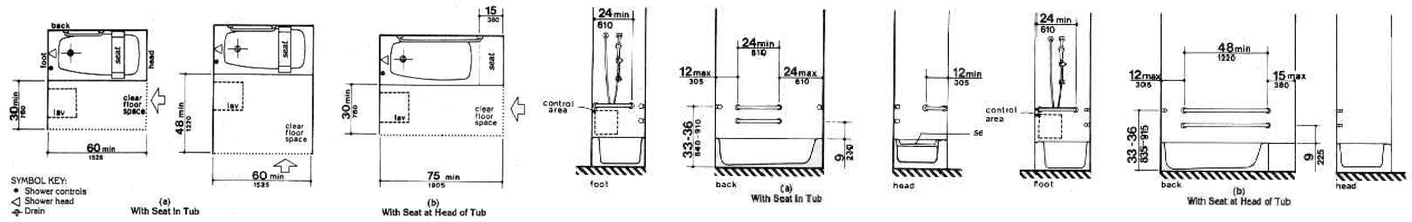

C STANDARD BATHROOM/TUB DIAGRAMS

NO SCALE

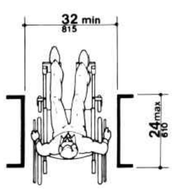

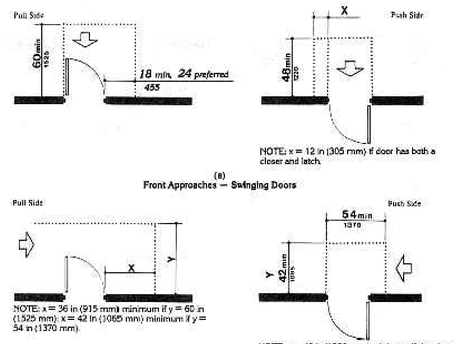

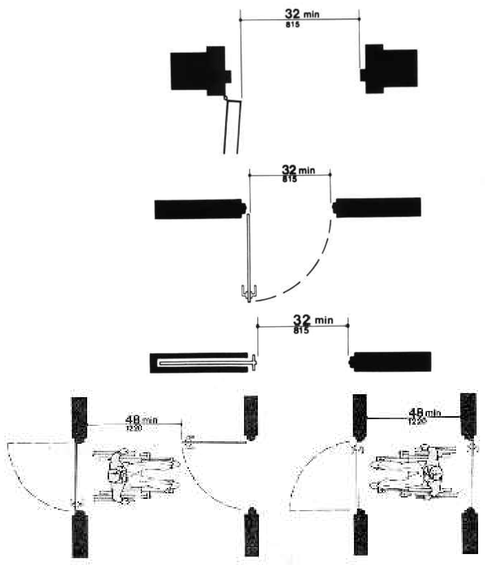

B STANDARD UFAS DOOR APRROACH/CLEARANCES

NO SCALE

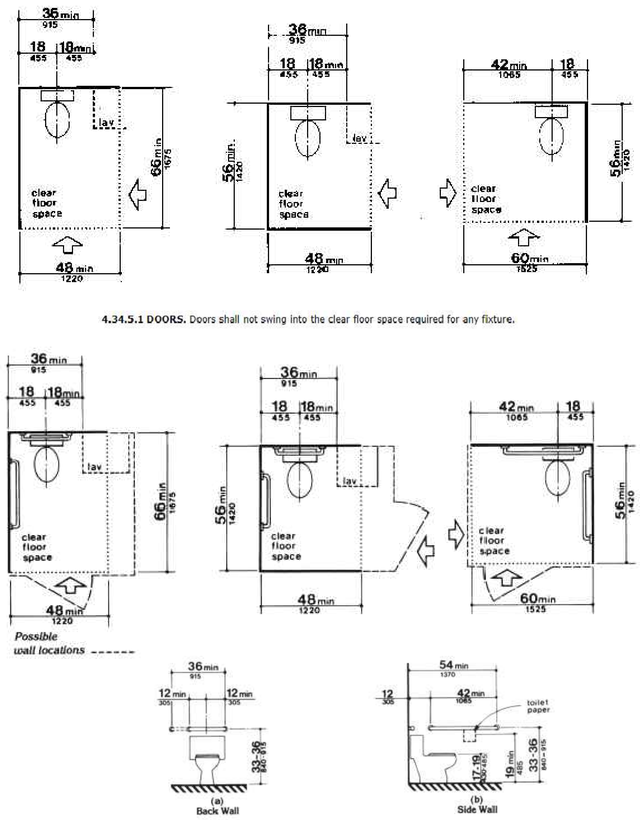

A STANDARD UFAS TOILERT/WATER CLOSET DIAGRAMS

NO SCALE

EXCEPTION: In instances of alteration work where provision of a standard stall (Fig. 30(a)) is structurally impracticable or where plumbing code requirements prevent combining existing stalls to provide space, an alternate stall (Fig. 30(b)) may be provided in lieu of the standard stall.

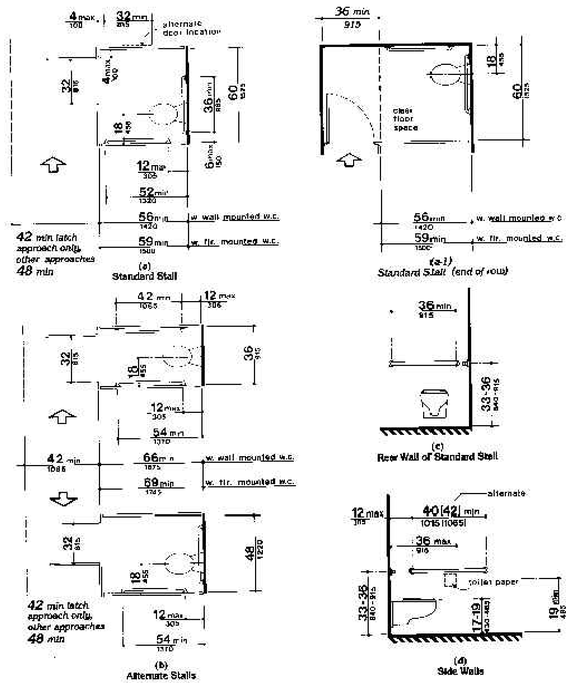

NOTE:
REFERENCE FULL UNIFORM FEDERAL ACCESSIBILITY STANDARDS FOR ADDITIONAL INFORMATION.

FOR REFERENCE ONLY

JonesGillamRenz
730 N. Ninth 1881 Main Street, Suite 301
Salina, KS 67401 Kansas City, MO 64108
785.827.0386 jgr@jgrarchitects.com

THE RESIDENCE AT HERITAGE WEST

NEW SENIOR-LIVING FACILITY

ANDOVER, KANSAS

CHRISTOPHER R. GILLAM LICENSED 6979 1/3/2025 KANSAS ARCHITECT

REVISION:

DATE: 1-3-2025
JOB: 24-3379
SHEET NO.:

UFAS 3

COPYRIGHTED ©

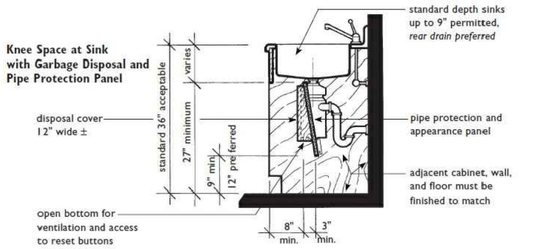

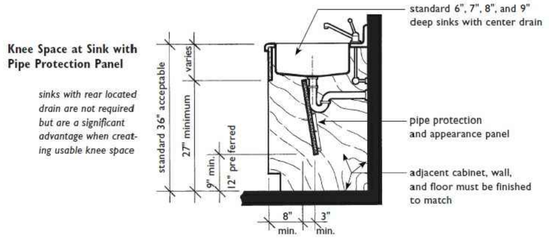

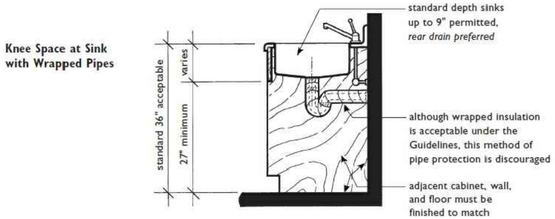

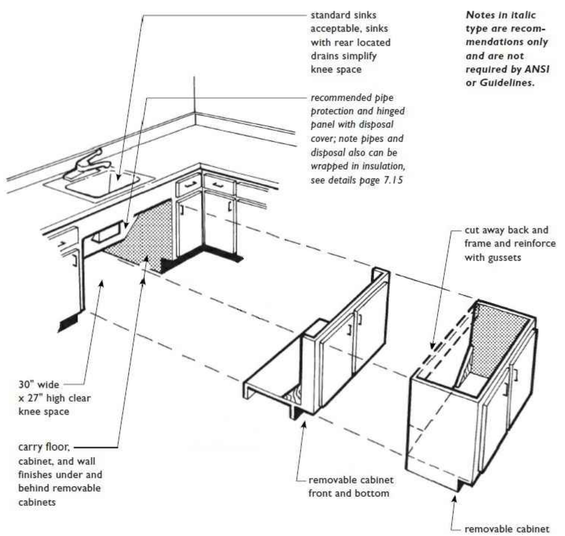

Possible Removable Cabinet Options for Required Knee Spaces at Sinks or Cooktops in Narrow (Less Than 60" Wide) U-Shaped Kitchens

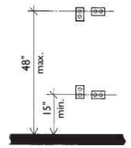

Mounting Height for Outlets

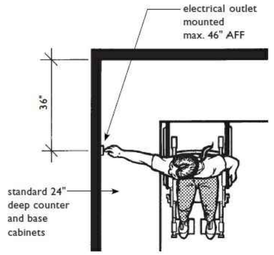

Electrical Outlets on Walls Over Cabinets Must Be a Minimum of 36" from a Corner

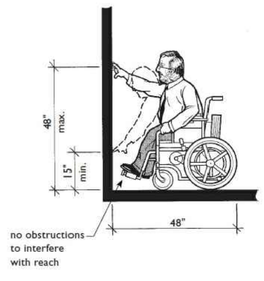

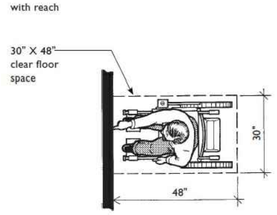

High and Low Forward Reach Limits From a Perpendicular Approach

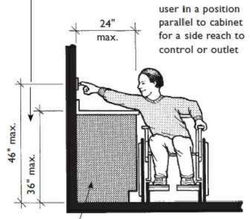

Maximum Side Reach (From a Parallel Approach) Over an Obstruction

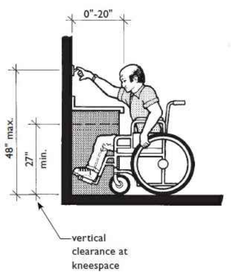

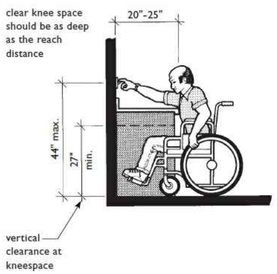

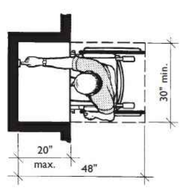

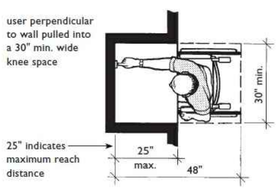

Maximum Forward Reach (From a Perpendicular Approach) over an Obstruction

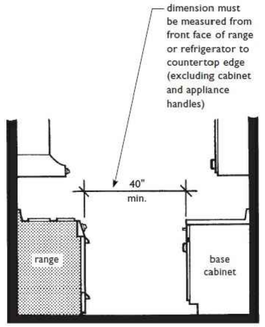

Minimum Clearance between Range and Opposing Base Cabinet

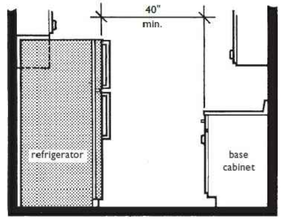

Minimum Clearance between Refrigerator and Opposing Base Cabinet

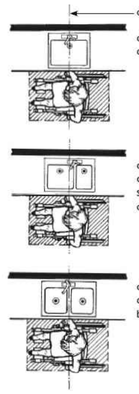

clear floor space for at least one type of approach (forward or parallel) must be centered on the refrigerator; this applies to side-by-side as well as over/under models

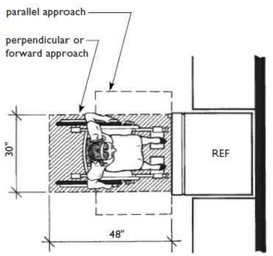

Space for Either a Forward or Parallel Approach Must Be Provided

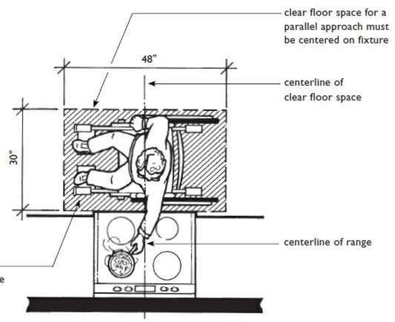

Space for Parallel Approach Required at Range and Cooktop

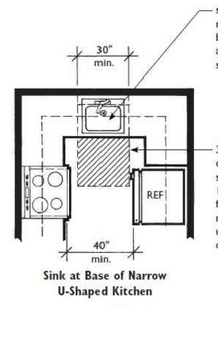

Sink at Base of Narrow U-Shaped Kitchen

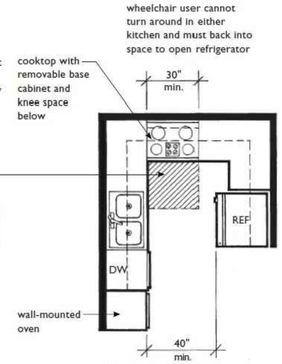

Cooktop at Base of Narrow U-Shaped Kitchen (Not Allowed for a Range)

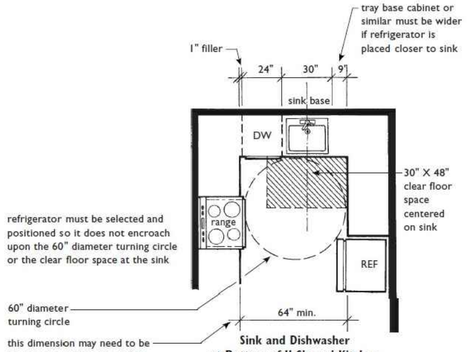

Sink and Dishwasher at Bottom of U-Shaped Kitchen Increases Room Width

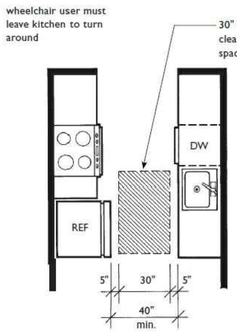

40" Minimum Clearance Between all Counters, Base Cabinets, Appliances, and Walls

Wichita-Sedgwick County Metropolitan Area Building and Construction Department
REVIEWED FOR CODE COMPLIANCE
CORRECTIONS OR COMMENTS MADE ON THESE DRAWINGS AND THIS DOCUMENT DURING THIS REVIEW DO NOT RELIEVE CONTRACTOR FROM COMPLIANCE WITH ALL REQUIREMENTS OF THE CODE OF THE MABCD, THE CITY OF WICHITA OR SEDGWICK COUNTY. THIS REVIEW IS ONLY FOR GENERAL CONFORMANCE OF THE CODE. THE CONTRACTOR IS RESPONSIBLE FOR CONFORMING AND CORRELATING ALL TECHNIQUES OF CONSTRUCTION. THIS APPROVAL IS SUBJECT TO PROVISIONS OF SECTION 107.4 OF THE 2012 INTERNATIONAL BUILDING CODE.
DATE: 02/19/25 BY: William Jerauld Jr

JonesGillamRenz
730 N. Ninth 1881 Main Street, Suite 301
Salina, KS 67401 Kansas City, MO 64108
785.827.0386 jgr@jgrarchitects.com

THE RESIDENCE AT HERITAGE WEST
NEW SENIOR-LIVING FACILITY
ANDOVER, KANSAS

CHRISTOPHER R. GILLAM REGISTERED ARCHITECT 6979 1/3/2025 KANSAS

REVISION:

DATE: 1–3–2025
JOB: 24–3379
SHEET NO.:

FH1

COPYRIGHTED©

FOR REFERENCE ONLY

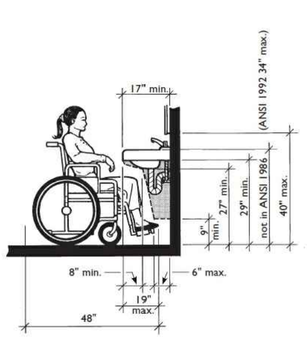

ANSI 1986 Requirements at Knee Space
(Guidance for Knee Space in A Bathrooms)

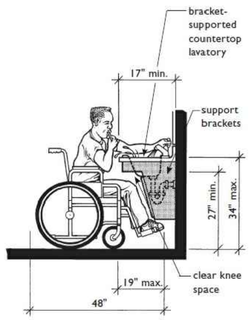

Knee Space at Lavatories that Meets the Requirements for B Bathrooms

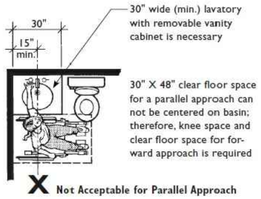

Removable Base Cabinet Must Be Provided Because Clear Floor Space Can Not Be Centered
(Required in A and B Bathrooms)

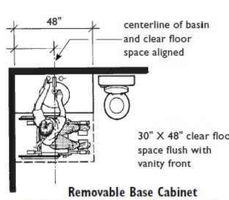

Removable Base Cabinet
Not Required Because Clear Floor Space Centered on Basin
(Applicable in A and B Bathrooms)

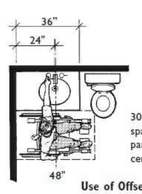

Use of Offset Basin
to Reduce Lavatory Length
(Applicable in A and B Bathrooms)

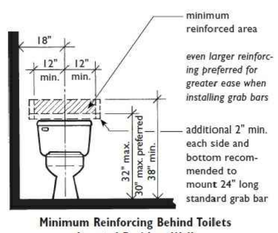

Minimum Reinforcing Behind Toilets
Located Beside a Wall

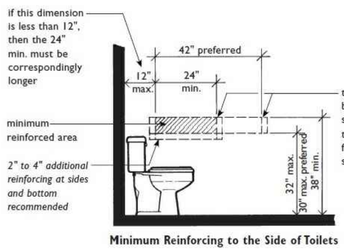

Minimum Reinforcing to the Side of Toilets

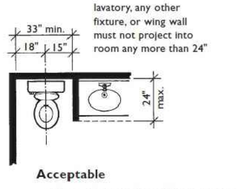

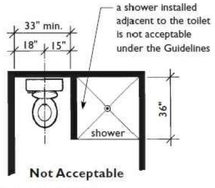

Some Features May Overlap Clear Floor Space at Toilet

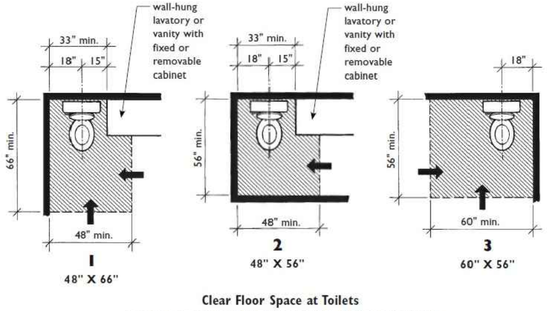

Clear Floor Space at Toilets
(One of the Three Must be Provided in "A" and "B" Bathrooms)

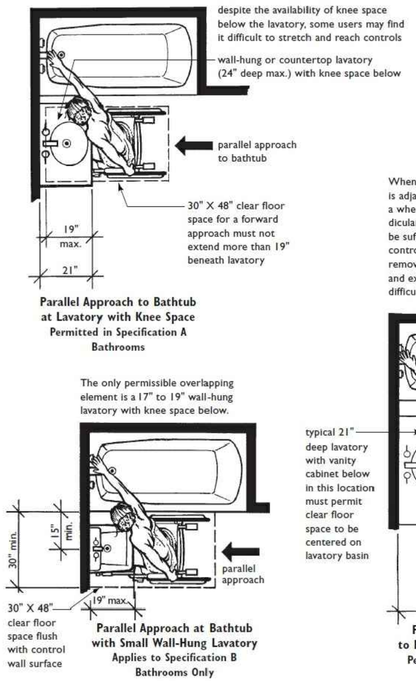

Parallel Approach to Bathtub
at Lavatory with Knee Space
Permitted in Specification A Bathrooms

Parallel Approach at Bathtub
with Small Wall-Hung Lavatory
Applies to Specification B Bathrooms Only

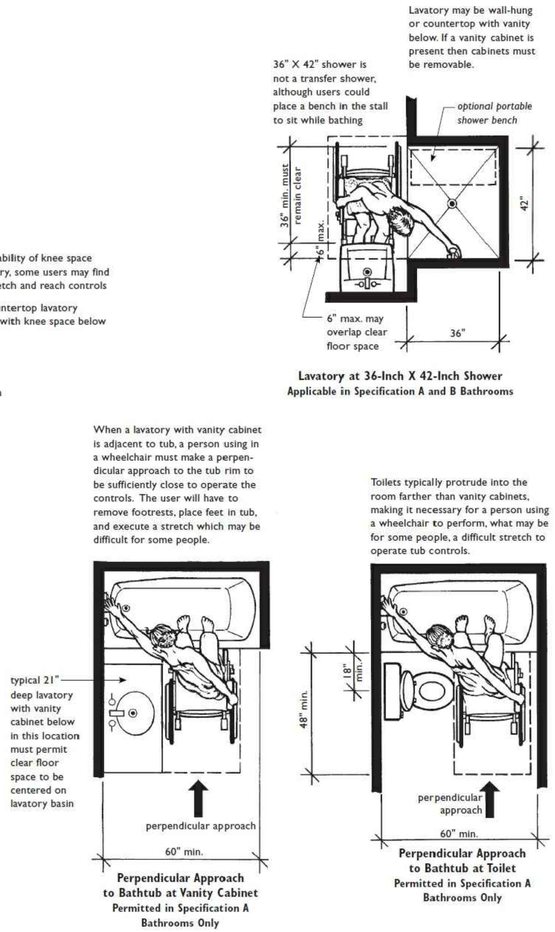

Perpendicular Approach
to Bathtub at Vanity Cabinet
Permitted in Specification A Bathrooms Only

Perpendicular Approach
to Bathtub at Toilet
Permitted in Specification A Bathrooms Only

Clear Floor Space at Bathtubs/Showers
Shaded Areas Must Remain Unobstructed
(Taken from Guideline Figures 7(b) and 8)

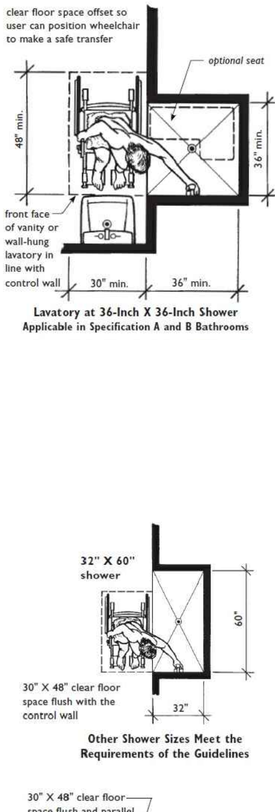

Lavatory at 36-Inch X 36-Inch Shower
Applicable in Specification A and B Bathrooms

Lavatory at 36-Inch X 42-Inch Shower
Applicable in Specification A and B Bathrooms

Other Shower Sizes Meet the
Requirements of the Guidelines

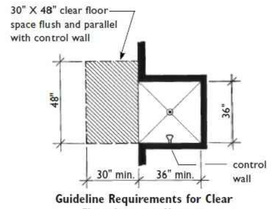

Guideline Requirements for Clear
Floor Space at Showers

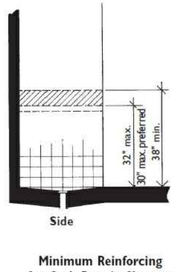

Minimum Reinforcing
for Grab Bars in Showers

In Specification B bathrooms, when shower is only bathing fixture and is a nominal 36" X 36", it must have reinforcing for grab bars and a wall-mounted shower seat.

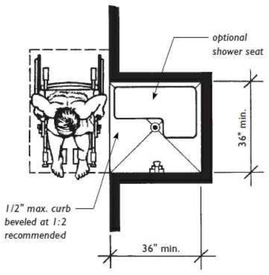

When Shower Stall
Is the Only Bathing Fixture It Must Be at Least 36 Inches X 36 Inches

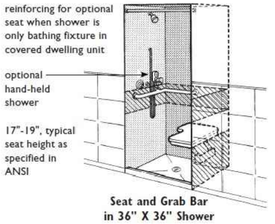

Seat and Grab Bar
in 36" X 36" Shower

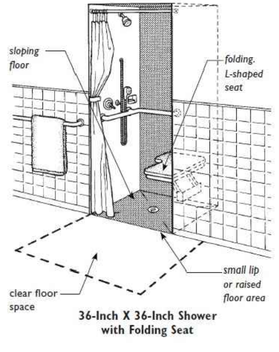

36-Inch X 36-Inch Shower
with Folding Seat

FOR REFERENCE ONLY

Wichita-Sedgwick County Metropolitan Area Building and Construction Department

REVIEWED FOR CODE COMPLIANCE

CORRECTIONS OR COMMENTS MADE ON THESE DRAWINGS AND THIS DOCUMENT DURING THIS REVIEW DO NOT RELIEVE CONTRACTOR FROM COMPLIANCE WITH ALL REQUIREMENTS OF THE CODE OF THE MABCD, THE CITY OF WICHITA OR SEDGWICK COUNTY. THIS REVIEW IS ONLY FOR GENERAL CONFORMANCE OF THE CODE. THE CONTRACTOR IS RESPONSIBLE FOR CONFORMING AND CORRELATING ALL TECHNIQUES OF CONSTRUCTION. THIS APPROVAL IS SUBJECT TO PROVISIONS OF SECTION 107.4 OF THE 2012 INTERNATIONAL BUILDING CODE.

DATE: 02/19/25 BY: William Jerauld Jr

JonesGillamRenz
730 N. Ninth 1881 Main Street, Suite 301
Salina, KS 67401 Kansas City, MO 64108
785.827.0386 jgr@jgrarchitects.com

THE RESIDENCE AT HERITAGE WEST

NEW SENIOR-LIVING FACILITY

ANDOVER, KANSAS

CHRISTOPHER R. GILLAM REGISTERED 6979 1/3/2025 KANSAS ARCHITECT

REVISION:

DATE: 1-3-2025
JOB: 24-3379
SHEET NO.:

FH2

COPYRIGHTED ©

Sliding Secondary Door at Wood Deck
showing allowable changes in level at exterior sliding glass doors to balcony or patio where 1/2-inch maximum changes in level are permitted.

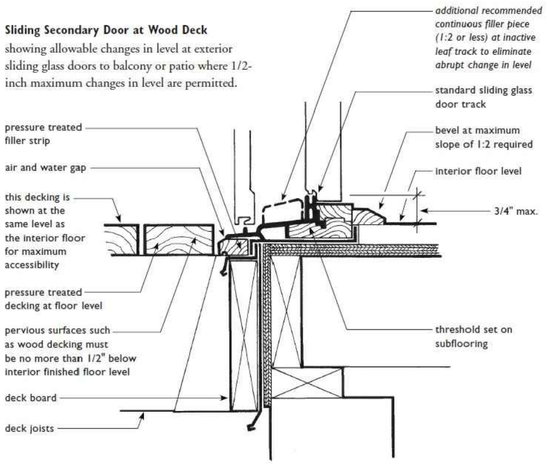

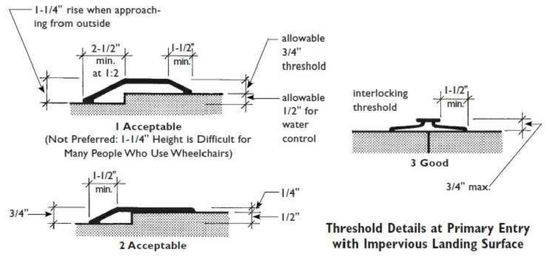

Threshold Details at Primary Entry with Impervious Landing Surface

Swinging Primary Entry Door at Concrete Landing
showing allowable changes in level at primary entry doors with direct exterior access onto concrete or other impervious landing surface where 1/2-inch maximum changes in level are permitted.

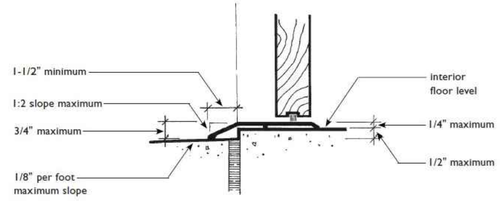

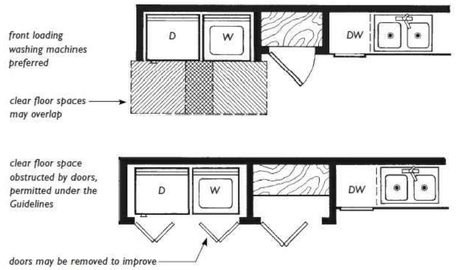

Clear Floor Space at Laundry Equipment Not Required But Recommended

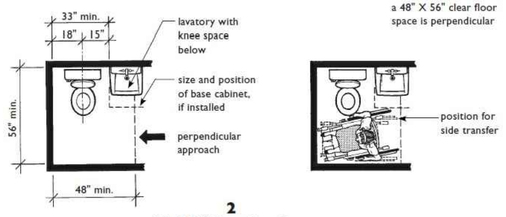

2
48" X 56" Clear Floor Space
(with Overlapping Lavatory)

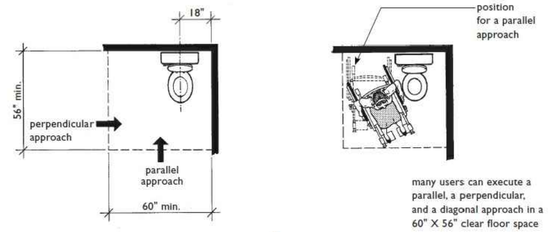

3
60" X 56" Clear Floor Space
(with No Overlapping Elements)

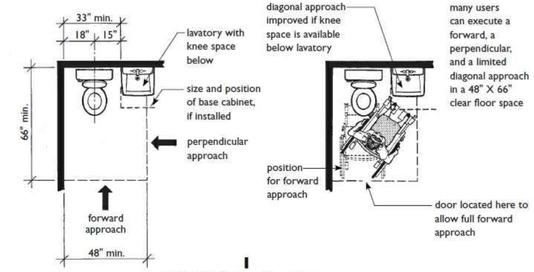

1
48" X 66" Clear Floor Space
(with Overlapping Lavatory)

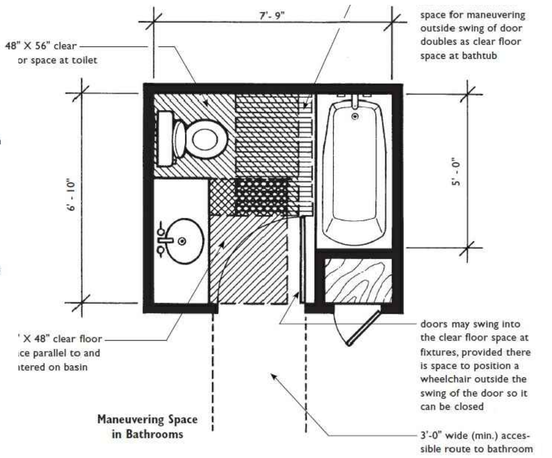

Maneuvering Space in Bathrooms

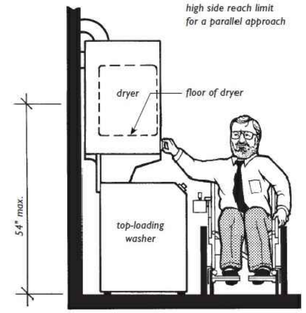

Stacked Washer/Dryer Unit with Dryer and All Controls Within Reach Range of Seated User

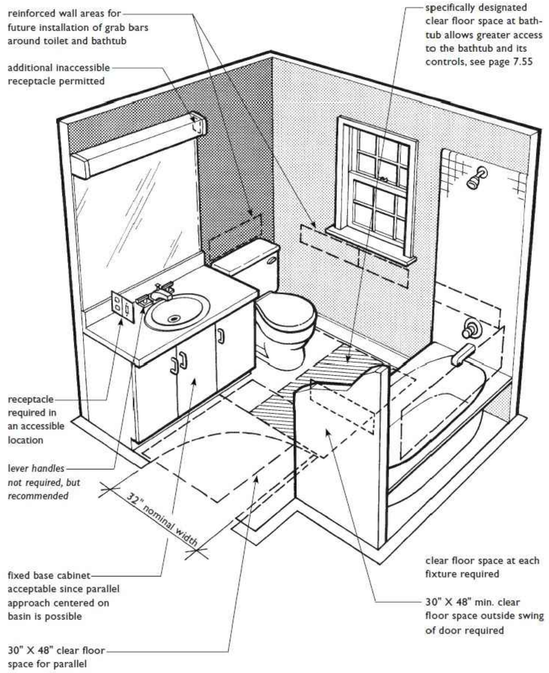

Example "B" Bathroom
Greater Access to Bathtub
6'-10" X 7'-9"
(Similar to Plan on Page 7.67)

Notes in italic type are recommendations only and are not required by the Guidelines.

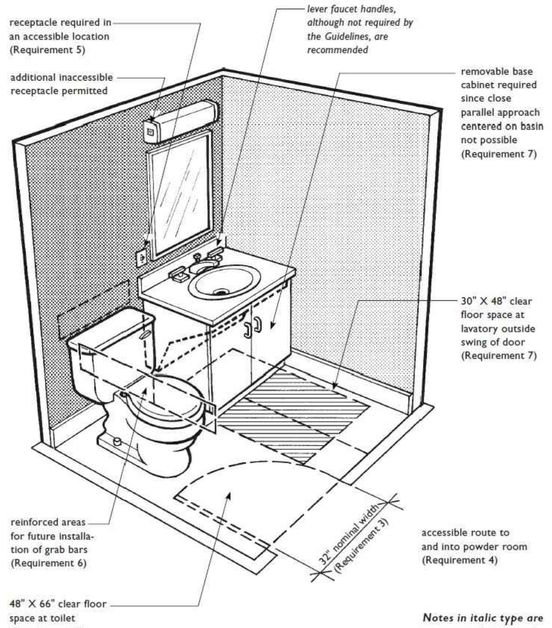

Usable Powder Room
5'-6" X 5'-8"
(See Plan Page 7.81)

Notes in italic type are recommendations only and are not required by the Guidelines.

Powder Room in Single-Story Dwelling Unit Must Meet Only Requirements 3, 4, and 5

Powder Room Must Meet Requirements 3, 4, 5, 6, and 7 When It Is the Only Toilet Facility on the Entry Level of a Multistory Unit in a Building with One or More Elevators

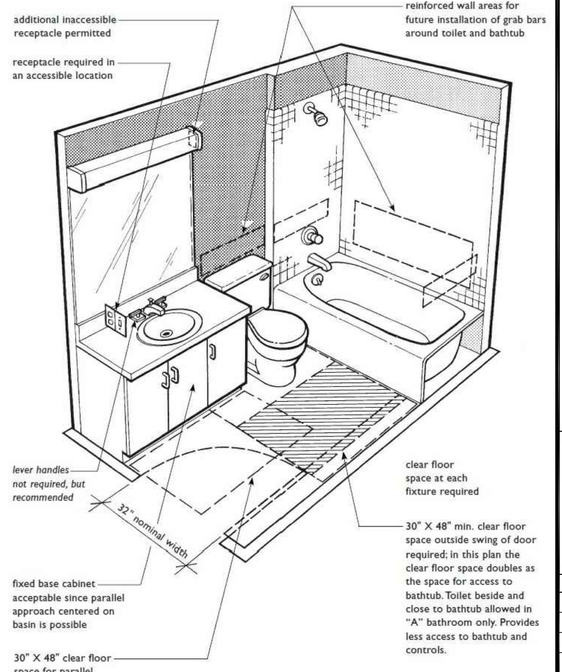

Example "A" Bathroom
9'-4" X 5'-2"
(See plan page 7.66)

Notes in italic type are recommendations only and are not required by the Guidelines.

FOR REFERENCE ONLY

Wichita-Sedgwick County
Metropolitan Area Building
and Construction Department

REVIEWED FOR CODE COMPLIANCE

CORRECTIONS OR COMMENTS MADE ON THESE DRAWINGS AND THIS DOCUMENT DURING THIS REVIEW DO NOT RELIEVE CONTRACTOR FROM COMPLIANCE WITH ALL REQUIREMENTS OF THE CODE OF THE MARCH, THE CITY OF WICHITA OR SEDGWICK COUNTY. THIS REVIEW IS ONLY FOR GENERAL CONFORMANCE OF THE CODE. THE CONTRACTOR IS RESPONSIBLE FOR CONFORMING AND CORRELATING ALL TECHNIQUES OF CONSTRUCTION. THIS APPROVAL IS SUBJECT TO PROVISIONS OF SECTION 107.4 OF THE 2012 INTERNATIONAL BUILDING CODE.

DATE: 02/19/25 BY: William Jerauld Jr

JonesGillamRenz
730 N. Ninth 1881 Main Street, Suite 301
Salina, KS 67401 Kansas City, MO 64108
785.827.0386 jgr@jgrarchitects.com

THE RESIDENCE AT HERITAGE WEST
NEW SENIOR-LIVING FACILITY
ANDOVER, KANSAS

CHRISTOPHER R. GILLAM REGISTERED 6979 1/3/2025 KANSAS ARCHITECT

REVISION:	
DATE:	1–3–2025
JOB:	24–3379
SHEET NO.:	

FH3

COPYRIGHTED ©

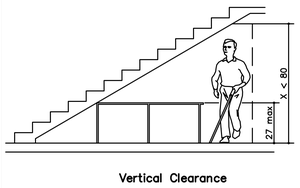

Vertical Clearance

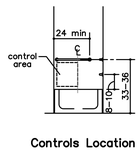

Controls Location

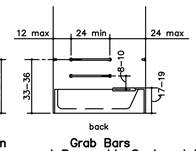

Grab Bars at Removable Seat

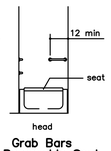

Grab Bars at Removable Seat

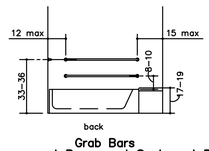

Grab Bars at Permanent Seat

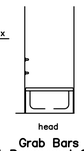

Grab Bars at Permanent Seat

S STANDARD VERTICAL CLEARANCE

NO SCALE

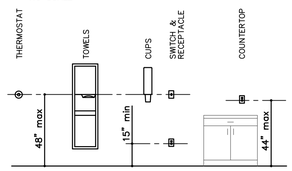

P STANDARD CONTROL REACH LIMITATIONS DETAILS

NO SCALE

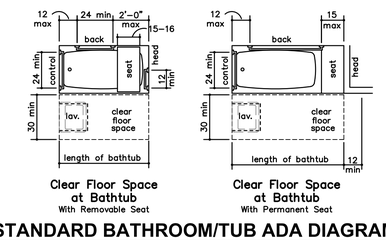

Clear Floor Space at Bathtub With Removable Seat

Clear Floor Space at Bathtub With Permanent Seat

O STANDARD BATHROOM/TUB ADA DIAGRAMS

NO SCALE

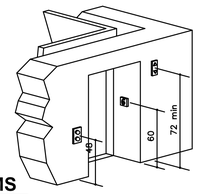

Hoistway and Elevator Entrances

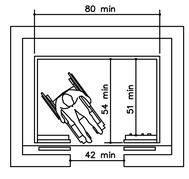

Minimum Dimensions for Elevator Car

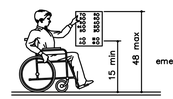

Car Control Height

N STANDARD ELEVATOR ADA DIAGRAMS

NO SCALE

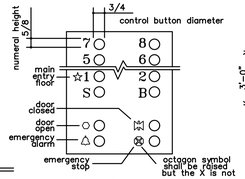

Panel Detail

R STANDARD REACH ADA DIAGRAMS

NO SCALE

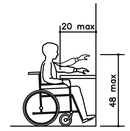

Obstructed High Forward Reach

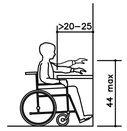

Unobstructed Forward Reach

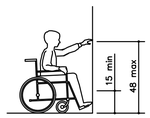

Unobstructed Side Reach

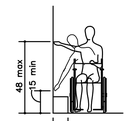

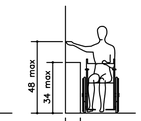

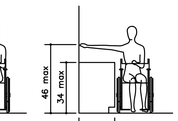

Obstructed High Side Reach

Q THRESHOLD ADA DIAGRAMS

NO SCALE

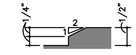

Beveled Change in Level

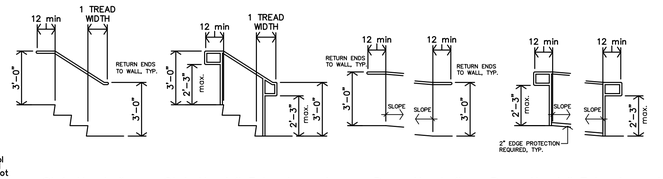

Stair Handrail Extensions at Walls

Stair Handail Extensions at Freestanding Handrails

Ramp Handrail Extensions at Walls

Ramp Handail Extensions at Freestanding Handrails

M STANDARD RAMP/STAIR HANDRAIL EXTENSIONS

NO SCALE

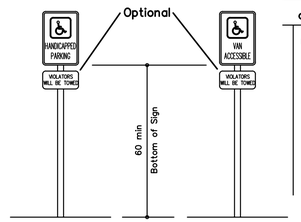

Typical Handicapped Parking Signage

Van Accessible Handicapped Parking Signage

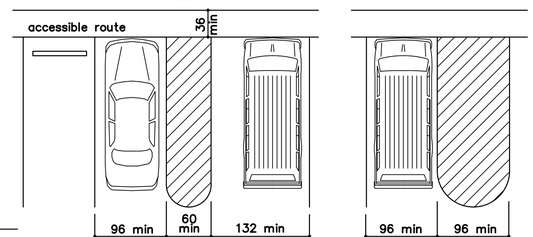

Handicap Accessible Parking Stalls

Van Accessible Parking Stall (per 502.2 exception)

L STANDARD PARKING ADA DIAGRAMS

NO SCALE

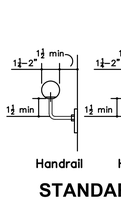

Handrail

Handrail

Handrail

Grab Bar

K STANDARD HANDRAIL/GRAB BAR DETAILS

NO SCALE

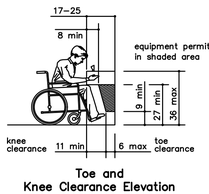

Toe and Knee Clearance Elevation

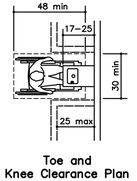

Toe and Knee Clearance Plan

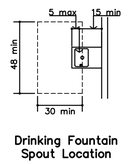

Drinking Fountain Spout Location

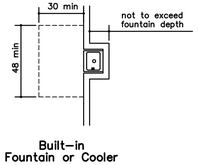

Built–in Fountain or Cooler

J STANDARD DRINKING FOUNTAIN DETAILS

NO SCALE

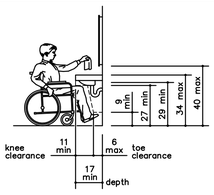

Lavatory Clearances

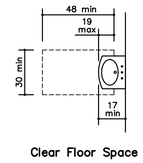

Clear Floor Space at Lavatories

H STANDARD LAVATORY DETAILS

NO SCALE

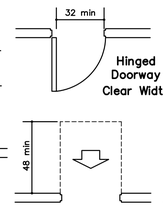

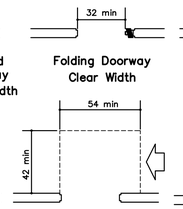

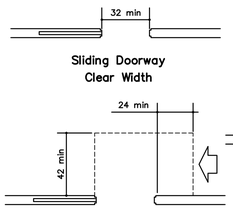

Front Approach – Sliding or Folding Doors

Side Approach – Sliding or Folding Doors

Stop or Latch Side Approach – Sliding or Folding Doors

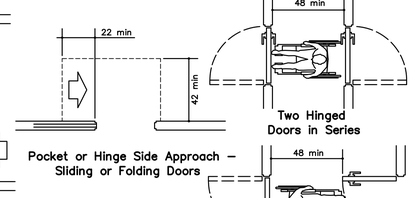

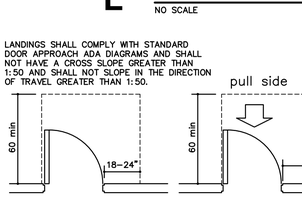

Exterior Landing

Front Approach – Swinging Door

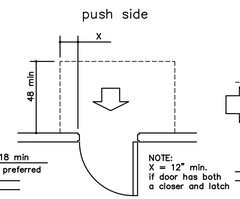

Front Approach – Swinging Door

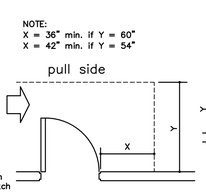

Hinge Side Approach – Swinging Door

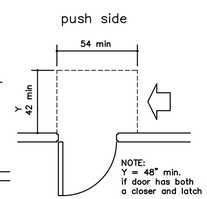

Side Approach – Swinging Door

Latch Side Approach Swinging Door

Latch Side Approach Swinging Door

G STANDARD DOOR APPROACH ADA DIAGRAMS

NO SCALE

Location of Tactile Signs at Doors

Height of Tactile Signs above Finish Floors

F TACTILE SIGN DIAGRAM

NO SCALE

36" by 36" Stall Shower Size and Clearances

WITHOUT SEAT

30" by 60" Stall Standard Roll in Type Shower Compartment Size and Clearance

WITH SEAT

30" by 60" Stall Standard Roll in Type Shower Compartment Size and Clearance

Seat Design

36" by 36" Stall Grab bars at Shower Stall

36" by 60" Stall Grab bars at Shower Stall

30" by 60" Stall Grab bars at Shower Stall

30" by 60" Stall Grab bars at Shower Stall

E STANDARD SHOWER ADA DIAGRAMS

NO SCALE

Overlap of Water Closet Clearance in Residential Dwelling Units (Exception)

Clear Floor Space at Water Closet

Grab Bars at Water Closets

Back Wall of Standard Stall

D STANDARD TOILET ADA DIAGRAMS

NO SCALE

Clear Floor Space at Urinal

Heights at Urinal

C STANDARD URINAL ADA DIAGRAMS

NO SCALE

Wheelchair Accessible Toilet Compartment

Ambulatory Accessible Toilet Compartment

B STANDARD TOILET STALL ADA DIAGRAMS

NO SCALE

Clear Floor or Ground Space

(a) Forward Approach

(b) Parallel Approach

Maneuvering Clearance in an Alcove, Parallel Approach

Maneuvering Clearance in an Alcove Forward Approach

Wheelchair Turning Space

A STANDARD ADA DIAGRAMS

NO SCALE

T–Shaped Space for 180° Turns

180° Turn Exception

180° Turn

FOR REFERENCE ONLY

Wichita-Sedgwick County Metropolitan Area Building and Construction Department

REVIEWED FOR CODE COMPLIANCE

CORRECTIONS OR COMMENTS MADE ON THESE DRAWINGS AND THIS DOCUMENT DURING THIS REVIEW DO NOT RELIEVE CONTRACTOR FROM COMPLIANCE WITH ALL REQUIREMENTS OF THE CODE OF THE MABCD, THE CITY OF WICHITA OR SEDGWICK COUNTY. THIS REVIEW IS ONLY FOR GENERAL CONFORMANCE OF THE CODE. THE CONTRACTOR IS RESPONSIBLE FOR CONFORMING AND CORRELATING ALL TECHNIQUES OF CONSTRUCTION. THIS APPROVAL IS SUBJECT TO PROVISIONS OF SECTION 107.4 OF THE 2012 INTERNATIONAL BUILDING CODE.

DATE: 02/19/25 BY: William Jerauld Jr

JonesGillamRenz
730 N. Ninth 1881 Main Street, Suite 301
Salina, KS 67401 Kansas City, MO 64108
785.827.0386 jgr@jgrarchitects.com

THE RESIDENCE AT HERITAGE WEST

NEW SENIOR-LIVING FACILITY

ANDOVER, KANSAS

CHRISTOPHER R. GILLAM LICENSED 6979 1/3/2025 KANSAS ARCHITECT

REVISION:

DATE: 1-3-2025

JOB: 24-3379

SHEET NO.:

ADA

COPYRIGHTED ©

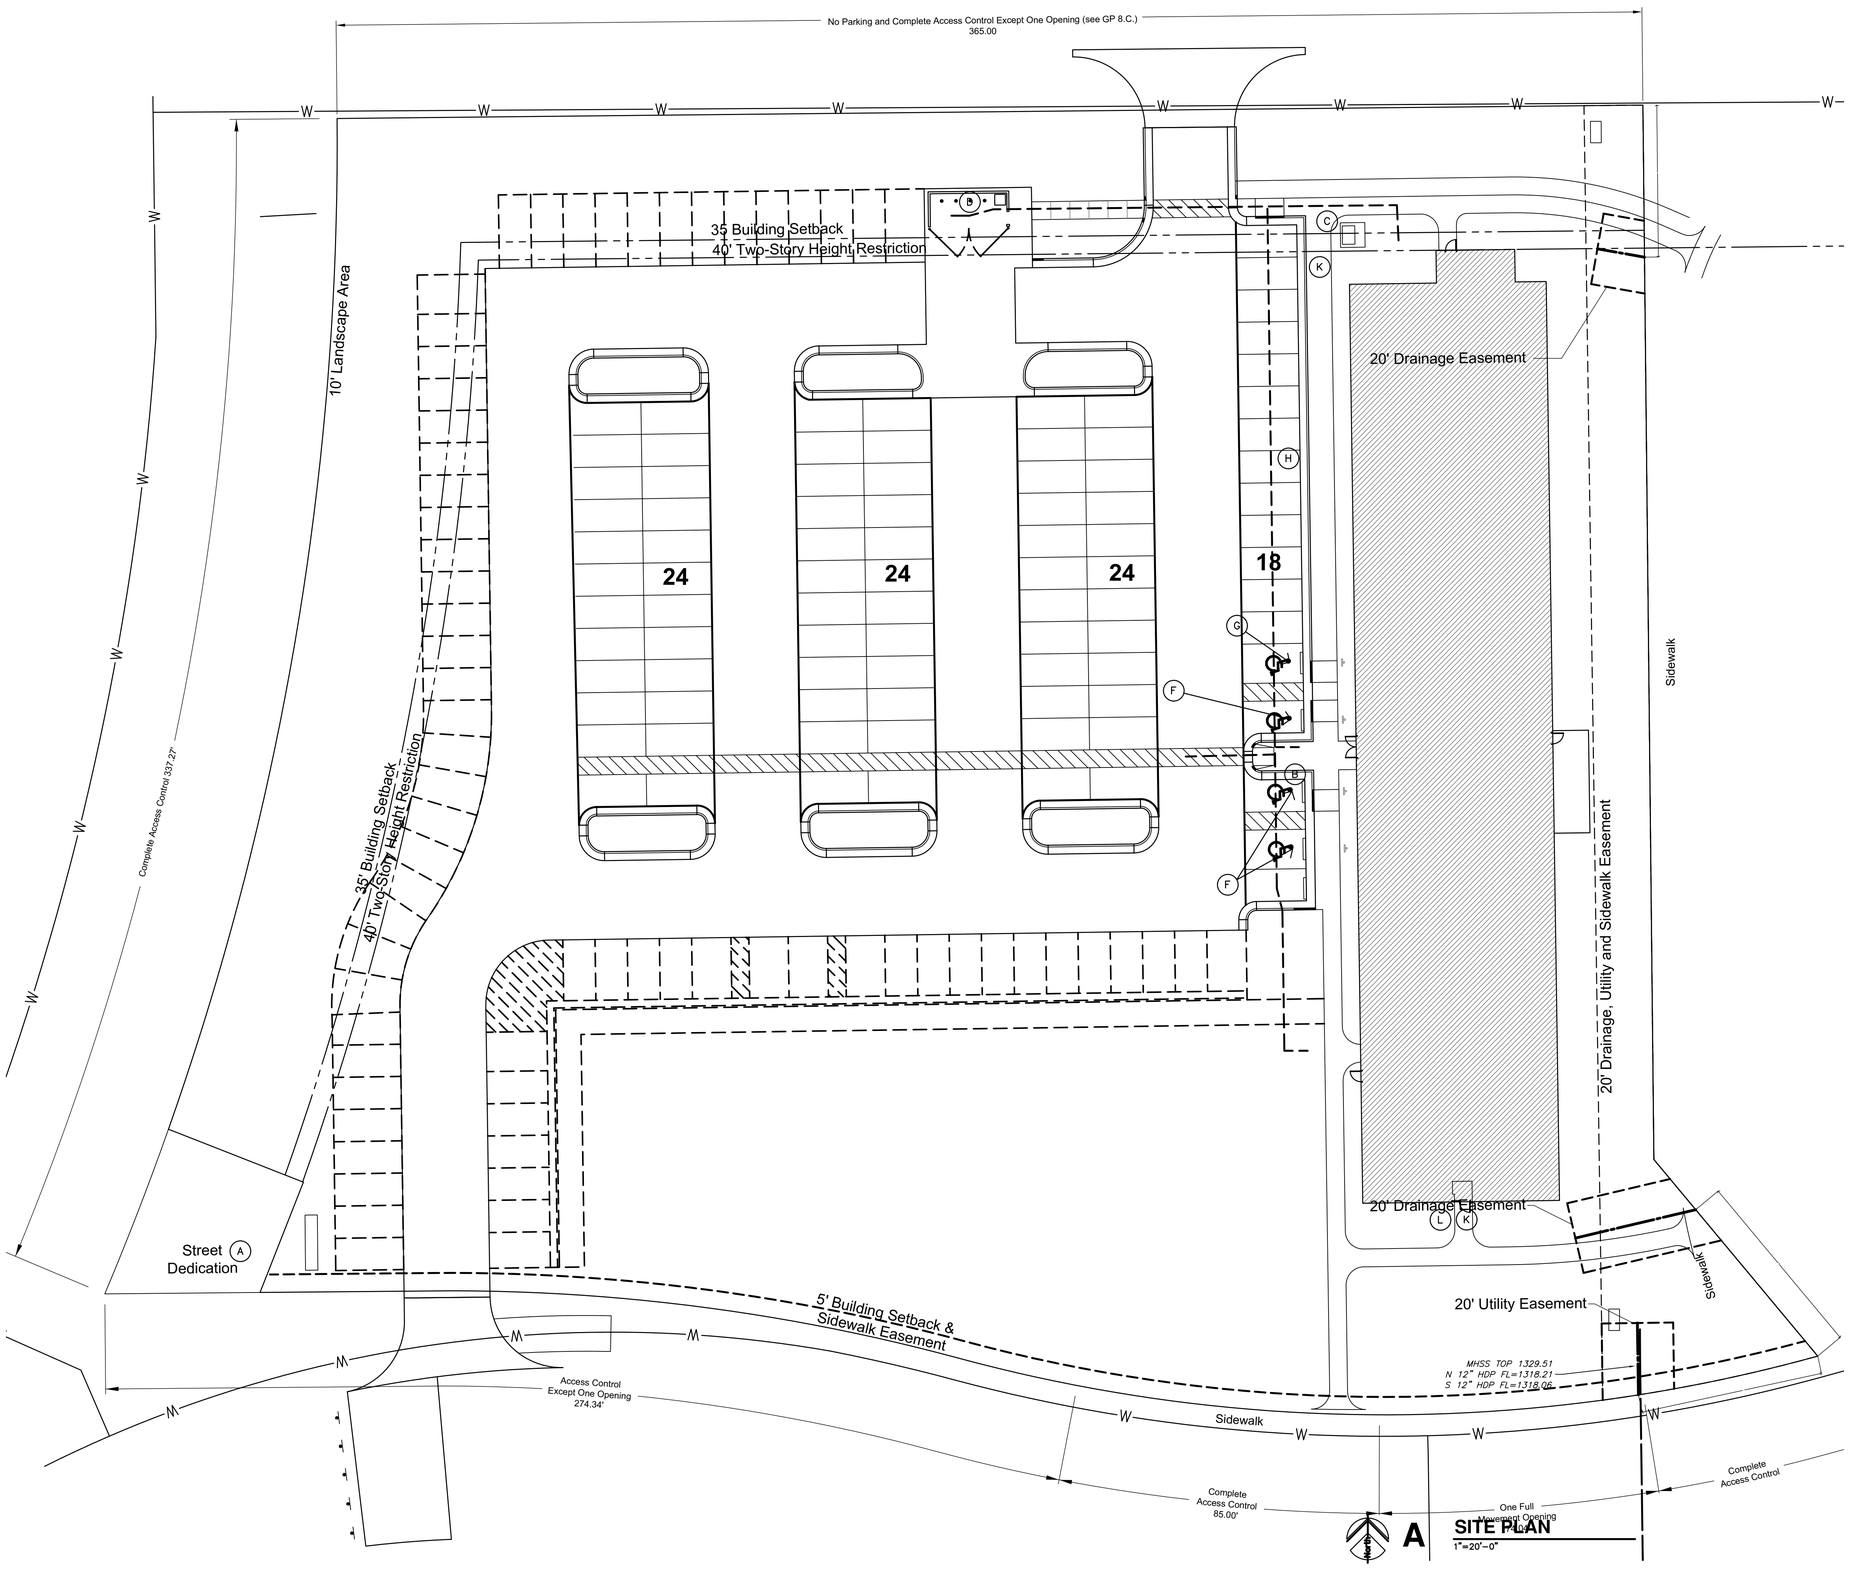

Wichita-Sedgwick County
Metropolitan Area Building
and Construction Department

REVIEWED FOR CODE COMPLIANCE

CORRECTIONS OR COMMENTS MADE ON THESE DRAWINGS AND THIS DOCUMENT DURING THIS REVIEW DO NOT RELIEVE CONTRACTOR FROM COMPLIANCE WITH ALL REQUIREMENTS OF THE CODE OF THE MABCD, THE CITY OF WICHITA OR SEDGWICK COUNTY. THIS REVIEW IS ONLY FOR GENERAL CONFORMANCE OF THE CODE. THE CONTRACTOR IS RESPONSIBLE FOR CONFORMING AND CORRELATING ALL TECHNIQUES OF CONSTRUCTION. THIS APPROVAL IS SUBJECT TO PROVISIONS OF SECTION 107.4 OF THE 2012 INTERNATIONAL BUILDING CODE.

DATE: 02/19/25 BY: William Jerauld Jr

ACCESSIBLE UNIT LEGEND

(4) UNITS SHALL BE ACCESSIBLE – 5% of total
(2) 1–bedroom
(2) 2–bedroom

(2) UNITS SHALL BE HEARING & VISION IMPAIRED ACCESSIBLE – 2% of total
(1) 1–bedroom
(1) 2–bedroom

ACCESSIBLE WALK OR PATH

PARKING SUMMARY

CODE REQUIRED	
TOTAL STALLS	90
HANDICAP STALLS	3

PROVIDED	
HANDICAP PARKING STALLS	4
STANDARD PARKING STALLS	86
TOTAL PARKING STALLS	90
PARKING RATIO (STALLS/UNITS)	1.5

LOT COVERAGE

SITE ACRES	SITE SQUARE FOOT	BLDG COVERAGE (GSF FOOTPRINT)	LOT COVERAGE
3.09 ACRES	134,384	13,700 sf	10.19%

UNIT SUMMARY

UNIT TYPE	TOTAL NO. of UNITS
1–BED, 1–BATH	40
2–BED, 1–BATH	20
TOTAL	60

SITE PLAN KEY NOTES

A	MONUMENT SIGN, BASE BID REF. SHEET A1.2
B	KNOX BOX COORD. W/ FIRE DEPT. (TYP)
C	BUILDING TRANSFORMER REF. ELECT. DWGS. CONTRACTOR TO COORDINATE SIZE OF CONC. PAD WITH ELECT. COMPANY
D	HC TRASH ENCLOSURE REF. SHEET A1.2
E	
F	NEW POLE MOUNTED H.C. PARKING SIGN MOUNT BTM. OF SIGN @ 60"A.F.F. (TYP)
G	NEW POLE MOUNTED H.C. "VAN" PARKING SIGN MOUNT BTM. OF SIGN @ 60"A.F.F. (TYP)
H	DASHED LINE INDICATES ACCESSIBLE PATH
K	BUILDING METER CENTER REF. ELECT. DWGS
L	BUILDING FIRE SPRINKLER ROOM REF. MECH. DWGS

NOTE:
CONC. SLABS @ SITE AMENITIES SHALL BE 4"th. 3,500 PSI W/ 6x6–W1.2xW1.2 WWF. SLOPE ACROSS SLAB NO MORE THAN 2% (1/8" PER 12") OVER 4"th. GRANULAR FILL (MIN.) COMPACTED OVER SUBGRADE, PREP PER SOILS REPORT.

JonesGillamRenz
730 N. Ninth
Salina, KS 67401
1881 Main Street, Suite 301
Kansas City, MO 64108
785.827.0386
jgr@jgrarchitects.com

THE RESIDENCE AT HERITAGE WEST

NEW SENIOR-LIVING FACILITY

ANDOVER, KANSAS

CHRISTOPHER R. GILLAM
REGISTERED ARCHITECT
6979
1/3/2025
KANSAS
ARCHITECT

REVISION:

DATE: 1–3–2025
JOB: 24–3379
SHEET NO.:

A1.1

COPYRIGHTED©

Wichita-Sedgwick County
Metropolitan Area Building
and Construction Department

REVIEWED FOR CODE COMPLIANCE

CORRECTIONS OR COMMENTS MADE ON THESE DRAWINGS AND THIS DOCUMENT DURING THIS REVIEW DO NOT RELIEVE CONTRACTOR FROM COMPLIANCE WITH ALL REQUIREMENTS OF THE CODE OF THE MABCD, THE CITY OF WICHITA OR SEDGWICK COUNTY. THIS REVIEW IS ONLY FOR GENERAL CONFORMANCE OF THE CODE. THE CONTRACTOR IS RESPONSIBLE FOR CONFORMING AND CORRELATING ALL TECHNIQUES OF CONSTRUCTION. THIS APPROVAL IS SUBJECT TO PROVISIONS OF SECTION 107.4 OF THE 2012 INTERNATIONAL BUILDING CODE.

DATE: 02/19/25 BY: William Jerauld Jr

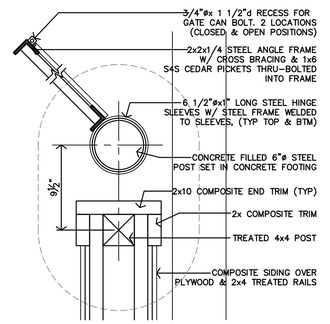

D DETAIL
1 1/2"=1'-0"

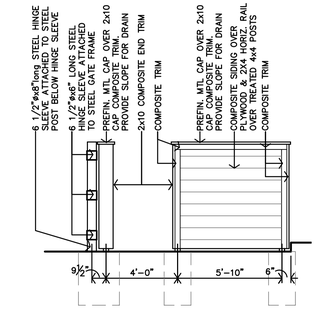

C TRASH ENCLOSURE SIDE ELEVATION
1/4"=1'-0"

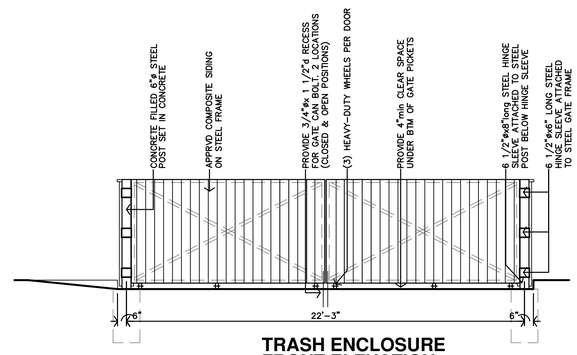

B TRASH ENCLOSURE FRONT ELEVATION
1/4"=1'-0"

DO NOT CONSTRUCT ANY PART OF THE TRASH PAD, ENCLOSURE AND/OR ACCESS TO, UNTILL AFTER CONFIRMATION AND COORDINATION OF LOCAL TRASH SERVICE. DUE TO DIFFERENT TRASH COMPANIES, TRUCKS AND PICK-UP PROCESSES, CONFIRMATION OF THE TRASH SERVICE AND COORDINATION OF THE DESIGN AND LAYOUT OF THE PAD, ENCLOSURE AND ACCESS MUST BE COMPLETED.

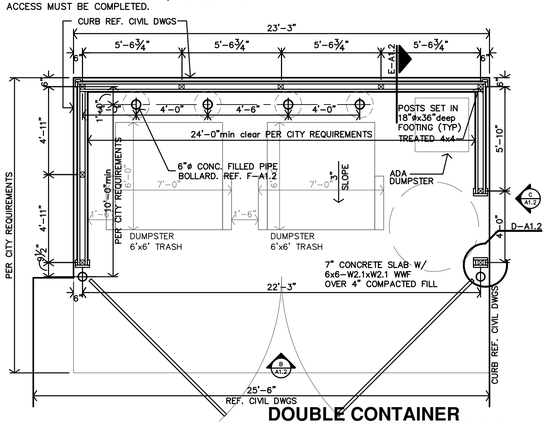

A DOUBLE CONTAINER TRASH ENCLOSURE PLAN
1/4"=1'-0"

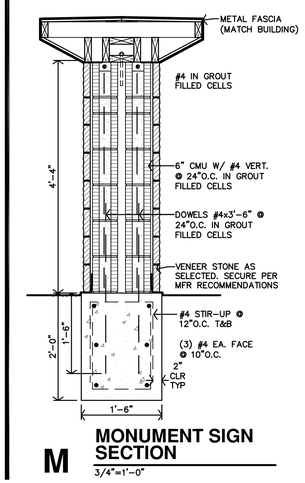

M MONUMENT SIGN SECTION
3/4"=1'-0"

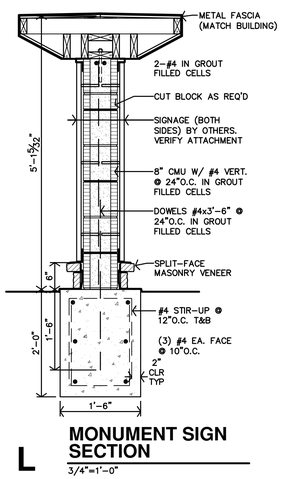

L MONUMENT SIGN SECTION
3/4"=1'-0"

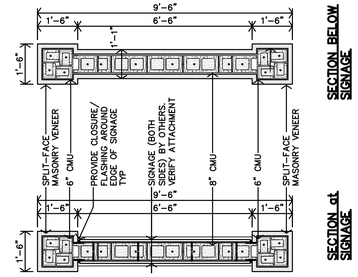

K MONUMENT SIGN SECTION
3/8"=1'-0"

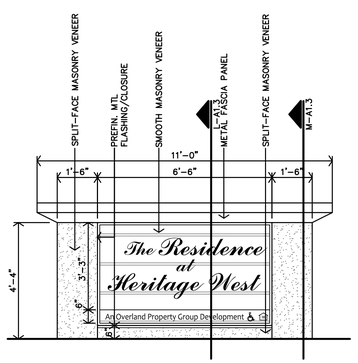

N MONUMENT SIGN ELEVATION
3/8"=1'-0"

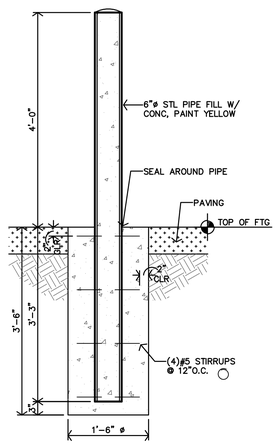

F BOLLARD DETAIL
3/4"=1'-0"

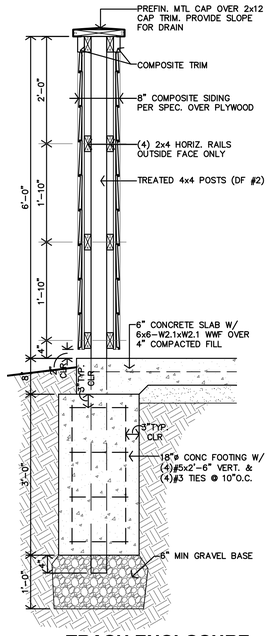

E TRASH ENCLOSURE SECTION
3/4"=1'-0"

JonesGillamRenz
730 N. Ninth
Salina, KS 67401
785.827.0386
1881 Main Street, Suite 301
Kansas City, MO 64108
jgr@jgrarchitects.com

THE RESIDENCE AT HERITAGE WEST

NEW SENIOR-LIVING FACILITY

ANDOVER, KANSAS

CHRISTOPHER R. GILLAM
REGISTERED ARCHITECT
6979
1/3/2025
KANSAS
ARCHITECT

REVISION:

DATE: 1-3-2025
JOB: 24-3379
SHEET NO.:

A1.2

COPYRIGHTED ©

APARTMENT CHART

TYPE OF APARTMENT	1ST FLOOR	2ND FLOOR	3RD FLOOR	4TH FLOOR	TOTAL
ACCESSIBLE UNITS (w/ REMOVEABLE TUB SEAT)	A11	B10	C5	D12	4
HEARING/VISION IMPAIRED & ADAPTABLE UNITS	A7			D6	2
ALL REMAINING UNITS ADAPTABLE	A1,A2,A3,A4,A5,A6,A8,A12,A13,A14,A15,A16	B1,B2,B3,B4,B5,B6,B7,B8,B9,B11,B12,B13,B14,B15,B16	C1,C2,C3,C4,C6,C7,C8,C9,C10,C11,C12,C13,C14,C15,C16	D1,D2,D3,D4,D5,D7,D8,D9,D10,D11,D13,D14	54
TOTAL	14	16	16	14	60

C5, B10 – 1BED ACCESSIBLE
A11, D12 – 2BED ACCESSIBLE

A7 – 1BED HEARING & VISION
D6 – 2BED HEARING & VISION

NOTE:
UNIT NUMBERS SHOWN ARE FOR CONSTRUCTION PURPOSES ONLY & DO NOT REFLECT FINAL UNIT NUMBERING/LETTERING.

ARCHITECTURAL GENERAL NOTES

1. CONTRACTOR SHALL FIELD VERIFY ALL DIMENSIONS & CONDITIONS.
2. INSTALL MATERIALS AND/OR FINISHES AS INDICATED, IMPLIED OR AS REQUIRED FOR COMPLETE & FINISHED INSTALLATION.
3. ALL WORK SHALL BE IN CONFORMANCE W/ APPLICABLE BUILDING CODES & ORDINANCES.
4. ALL NEW CONSTRUCTION SHALL BE IN CONFORMANCE TO ADA REQUIREMENTS. REFERENCE ADA FOR TYPICAL MINIMUM CLEARANCE REQUIRED.
5. IF THERE IS A DISCREPANCY BETWEEN DRAWINGS AND FIELD CONDITIONS NOTIFY ARCHITECT PRIOR TO PROCEEDING WITH WORK SO THAT ANY ISSUES MAY BE CLARIFIED.
6. DOORS ARE TYPICALLY LOCATED WITH HINGE-SIDE JAMB 4" FROM ADJACENT WALL UNLESS NOTED OTHERWISE OR REQUIRED TO MEET LATCH-SIDE CLEARANCE PER ADA.
7. FEC – INDICATES LOCATION OF RECESSED FIRE EXTINGUISHER CABINET. REF SPECS. AND DETAILS A/B-A2.0 FIRE EXTINGUISHERS SHALL BE INSTALLED & PROVIDED IN ACCORDANCE W/ NFPA 10 & 2012 IBC, SECTION 906. REF. SHEET A2.0
8. MHO – INDICATES DOOR WITH MAGNETIC HOLD OPEN.
9. F.O.S. – INDICATES DIMENSIONS ARE TO THE FACE OF STUD AT THE EXTERIOR WALLS U.N.O.
10. FURNITURE SHOWN IS BY OWNER.
11. (R) INDICATES RADON PIPE LOCATION. REF. 0-A4.7

EXTERIOR PARTITION SCHEDULE

REF. SHEET CFP FOR ADDITIONAL CODE INFORMATION

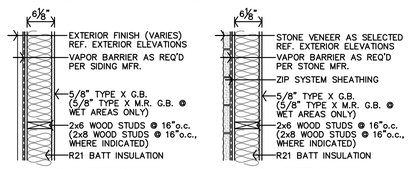

TYPICAL EXTERIOR WALL AT SIDING

TYPICAL EXTERIOR WALL AT STONE

1A TYPE 1A

PARTITION NOTES:
1. ALL WALLS TO BE EXTEND TO STRUCTURE, UNLESS NOTED OR DETAILED OTHERWISE
2. LOAD BEARING WALLS & FIRE PARTITIONS SHALL EXTEND TO DECK, SEALED SMOKE TIGHT.
3. REF. SHEET CFP FOR ADDITIONAL CODE INFORMATION
4. REF. STRUCTURAL FOR SHEAR WALL LOCATIONS, MATERIAL & SECTIONS
5. FIRE BLOCKING REQUIRED PER 2012 IBC SEC. 708 & 718. @ 10'-0"O.C. VERT. & HORIZ. AND @ ALL BACK TO BACK ELECTRICAL OUTLETS. (1) LAYER – 5/8" TYPE X G.B. OR 1/2" PLYWOOD TO EXTEND THRU SPACE (REF. SHEET A4.9)
6. ALL LISTED ASSEMBLIES ARE PROPRIETARY; ALL SUBSTITUTIONS SHALL FIRST BE SUBMITTED TO ARCHITECT, AND ARE NOT TO BE INSTALLED PRIOR TO WRITTEN APPROVAL FROM ARCHITECT.
7. REF. SHEET A4.9 FOR FIRE PENETRATION REQUIREMENTS @ ALL PLUMBING CHASES AND ALL PENETRATIONS THRU RATED WALLS, FLOOR/CEILING & CEILING/ROOF ASSEMBLIES

INTERIOR PARTITION SCHEDULE

- **ALL WALLS TO BE EXTEND TO STRUCTURE, UNLESS NOTED OR DETAILED OTHERWISE**
- **LOAD BEARING WALLS & FIRE PARTITIONS SHALL EXTEND TO DECK, SEALED SMOKE TIGHT.**
- **REF. SHEET CFP FOR ADDITIONAL CODE INFORMATION**

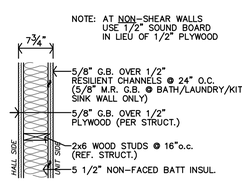

TYPICAL UNIT/HALL WALL

2A TYPE 2
1-HOUR RATED (UL U305) STC 56
ATTACH PER ul REQUIREMENTS
NOTE: HALL TO BE 30min RATED

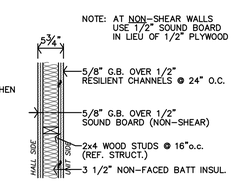

UNIT ENTRY/HALL WALL

2B TYPE 2
1-HOUR RATED (UL U305) STC 56
ATTACH PER ul REQUIREMENTS
NOTE: HALL TO BE 30min RATED

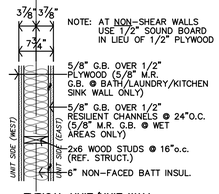

TYPICAL UNIT/UNIT WALL

3 TYPE 3
1-HOUR RATED (UL U305) STC 56
ATTACH PER ul REQUIREMENTS

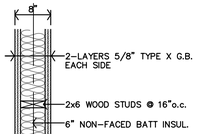

4 TYPE 4
2-HOUR RATED FIRE WALL (UL U301) (UL RATING 2HR)

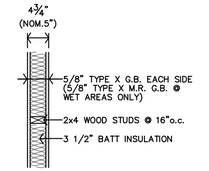

5r TYPE 5r
STC 34 1-HOUR RATED (UL U305)
ATTACH PER ul REQUIREMENTS

5 TYPE 5
NON-RATED

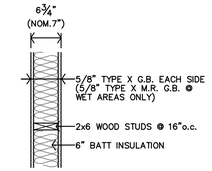

6r TYPE 6r
STC 35 1-HOUR RATED (UL U305)
ATTACH PER ul REQUIREMENTS

6 TYPE 6
NON-RATED

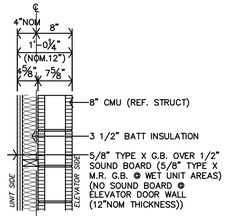

7 TYPE 7
2-HOUR RATED FIRE WALL (UL U905 (UL RATING 2HR)

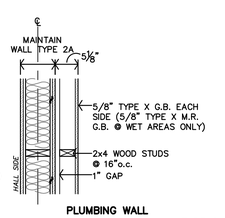

8 TYPE 8
PLUMBING WALL
STC 56

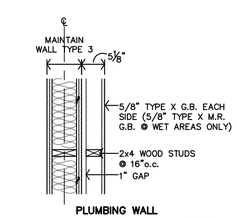

9 TYPE 9
PLUMBING WALL
STC 56

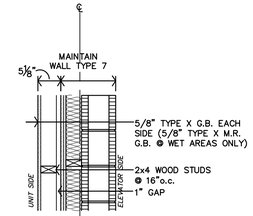

10 TYPE 10
PLUMBING WALL
STC 56

HORIZONTAL ASSEMBLIES

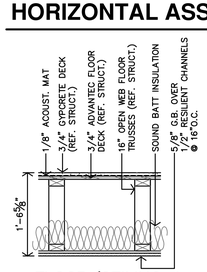

FLOOR/CEILING A
1-HOUR RATED (UL L528)
ATTACH PER ul REQUIREMENTS

NOTES:
1. DRAFTSTOPPING TO BE INSTALLED PER 2012 IBC SECTION 718.4
2. FIRE BLOCKING REQUIRED PER 2012 IBC SEC. 718.2. (1) LAYER – 5/8" G.B. OR 1/2" PLYWOOD TO EXTEND THRU SPACE (REF. L/N-A4.7)
3. STC RATING 50 MIN & IIC RATING 50 MIN PER IBC 2012, SEC. 1207.2 & 1207.3
4. G.B. SHALL BE SELECTED FROM THE UL LISTED MANUFACTURERS PRODUCTS.

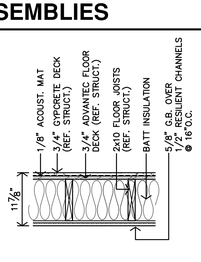

FLOOR/CEILING B
1-HOUR RATED (UL L501)
ATTACH PER ul REQUIREMENTS

NOTES:
1. DRAFTSTOPPING TO BE INSTALLED PER 2012 IBC SECTION 718.4
2. FIRE BLOCKING REQUIRED PER 2012 IBC SEC. 718.2. (1) LAYER – 5/8" G.B. OR 1/2" PLYWOOD TO EXTEND THRU SPACE (REF. L-A4.7 & M-A4.7)

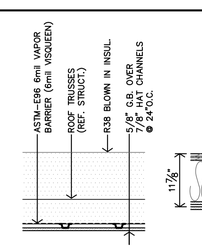

ROOF/CEILING A
1-HOUR RATED (UL P522)
ATTACH PER ul REQUIREMENTS

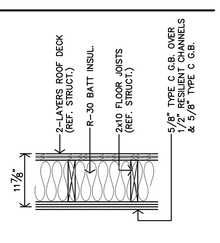

ROOF/CEILING B
1-HOUR RATED (UL L505)
ATTACH PER ul REQUIREMENTS

NOTES:
1. DRAFTSTOPPING TO BE INSTALLED PER 2018 IBC SECTION 718.4
2. FIRE BLOCKING REQUIRED PER 2018 IBC SEC. 718.2. (1) LAYER – 5/8" TYPE X G.B. OR 1/2" PLYWOOD TO EXTEND THRU SPACE (REF. M-A4.7 & N-A4.7)

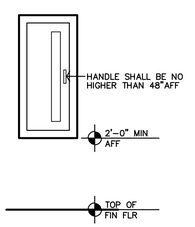

B TYPICAL FEC MOUNTING HGT
3/4"=1'-0"

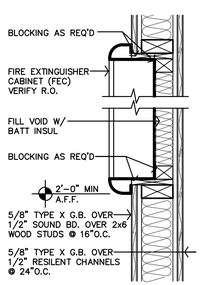

A FIRE EXTINGUISHER CABINET DTL @ 1HR WALL
1 1/2"=1'-0"

Wichita-Sedgwick County
Metropolitan Area Building
and Construction Department

REVIEWED FOR CODE COMPLIANCE

CORRECTIONS OR COMMENTS MADE ON THESE DRAWINGS AND THIS DOCUMENT DURING THIS REVIEW DO NOT RELIEVE CONTRACTOR FROM COMPLIANCE WITH ALL REQUIREMENTS OF THE CODE OF THE MABCD, THE CITY OF WICHITA OR SEDGWICK COUNTY. THIS REVIEW IS ONLY FOR GENERAL CONFORMANCE OF THE CODE. THE CONTRACTOR IS RESPONSIBLE FOR CONFORMING AND CORRELATING ALL TECHNIQUES OF CONSTRUCTION. THIS APPROVAL IS SUBJECT TO PROVISIONS OF SECTION 107.4 OF THE 2012 INTERNATIONAL BUILDING CODE.

DATE: 02/19/25 BY: William Jerauld Jr

JonesGillamRenz
730 N. Ninth 1881 Main Street, Suite 301
Salina, KS 67401 Kansas City, MO 64108
785.827.0386 jgr@jgrarchitects.com

THE RESIDENCE AT HERITAGE WEST

NEW SENIOR-LIVING FACILITY

ANDOVER, KANSAS

CHRISTOPHER R. GILLAM
REGISTERED ARCHITECT
6979
1/3/2025
KANSAS
ARCHITECT

REVISION:

DATE: 1-3-2025
JOB: 24-3379
SHEET NO.:

A2.0

COPYRIGHTED©

Wichita-Sedgwick County
Metropolitan Area Building
and Construction Department

REVIEWED FOR CODE COMPLIANCE

CORRECTIONS OR COMMENTS MADE ON THESE DRAWINGS AND THIS DOCUMENT DURING THIS REVIEW DO NOT RELIEVE CONTRACTOR FROM COMPLIANCE WITH ALL REQUIREMENTS OF THE CODE OF THE MABCD, THE CITY OF WICHITA OR SEDGWICK COUNTY. THIS REVIEW IS ONLY FOR GENERAL CONFORMANCE OF THE CODE. THE CONTRACTOR IS RESPONSIBLE FOR CONFORMING AND CORRELATING ALL TECHNIQUES OF CONSTRUCTION. THIS APPROVAL IS SUBJECT TO PROVISIONS OF SECTION 107.4 OF THE 2012 INTERNATIONAL BUILDING CODE.

DATE: 02/19/25 BY: William Jerauld Jr

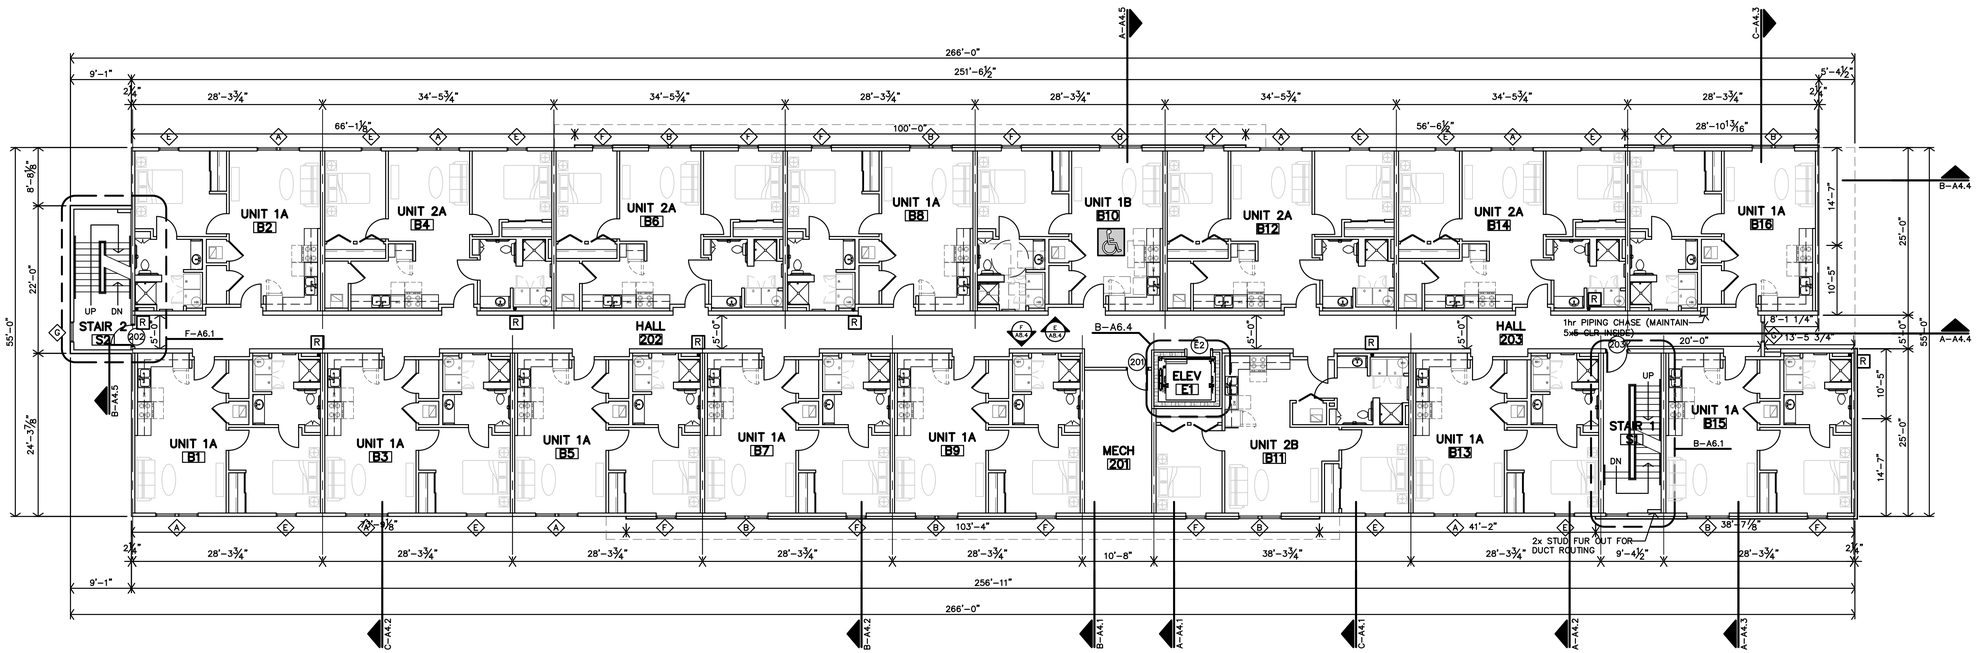

B **SECOND FLOOR PLAN**
3/32"=1'-0"

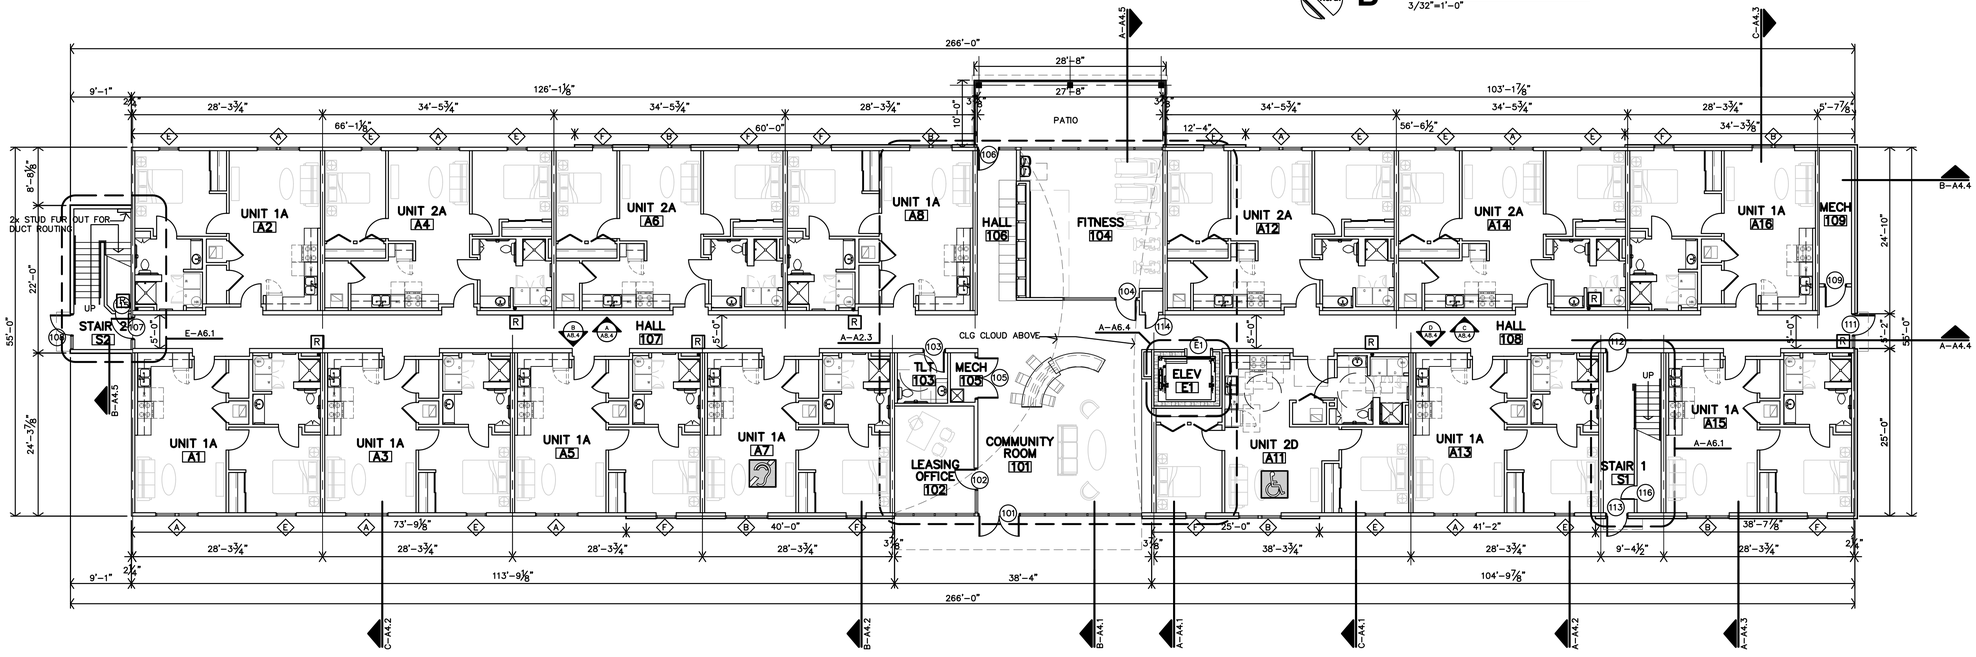

A **FIRST FLOOR PLAN**
3/32"=1'-0"

JonesGillamRenz
730 N. Ninth
Salina, KS 67401
1881 Main Street, Suite 301
Kansas City, MO 64108
785.827.0386
jgr@jgrarchitects.com

THE RESIDENCE AT HERITAGE WEST

NEW SENIOR-LIVING FACILITY

ANDOVER, KANSAS

CHRISTOPHER R. GILLAM
ARCHITECT LICENSED
6979
1/3/2025
KANSAS

REVISION:	
DATE:	1-3-2025
JOB:	24-3379
SHEET NO.:	A2.1

COPYRIGHTED©

Wichita-Sedgwick County
Metropolitan Area Building
and Construction Department

REVIEWED FOR CODE COMPLIANCE

CORRECTIONS OR COMMENTS MADE ON THESE DRAWINGS AND THIS DOCUMENT DURING THIS REVIEW DO NOT RELIEVE CONTRACTOR FROM COMPLIANCE WITH ALL REQUIREMENTS OF THE CODE OF THE MABCD, THE CITY OF WICHITA OR SEDGWICK COUNTY. THIS REVIEW IS ONLY FOR GENERAL CONFORMANCE OF THE CODE. THE CONTRACTOR IS RESPONSIBLE FOR CONFORMING AND CORRELATING ALL TECHNIQUES OF CONSTRUCTION. THIS APPROVAL IS SUBJECT TO PROVISIONS OF SECTION 107.4 OF THE 2012 INTERNATIONAL BUILDING CODE.

DATE: 02/19/25 BY: William Jerauld Jr

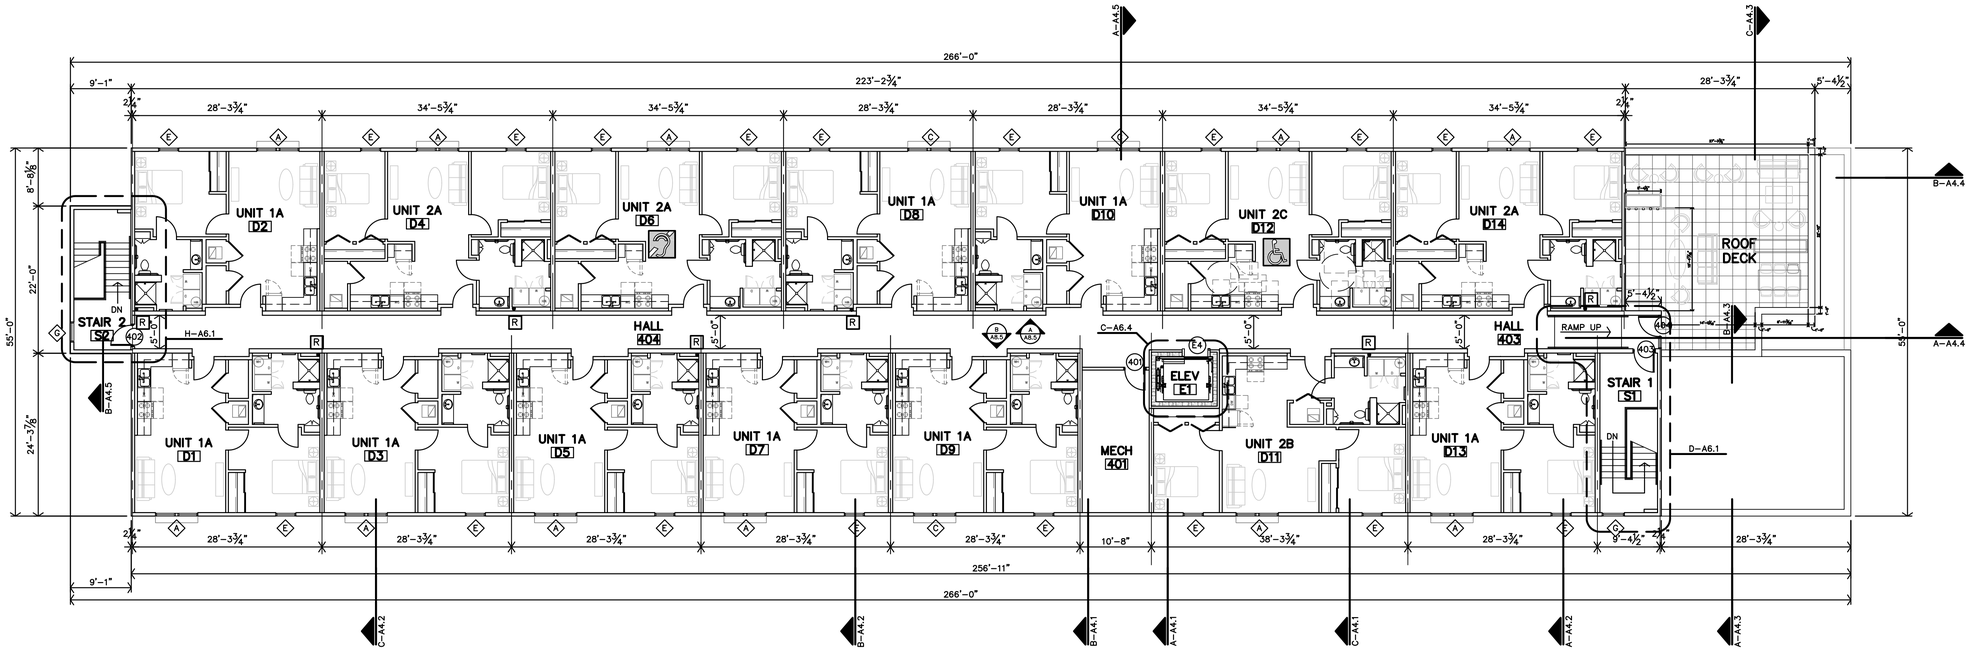

North **B** FOURTH FLOOR PLAN
3/32"=1'-0"

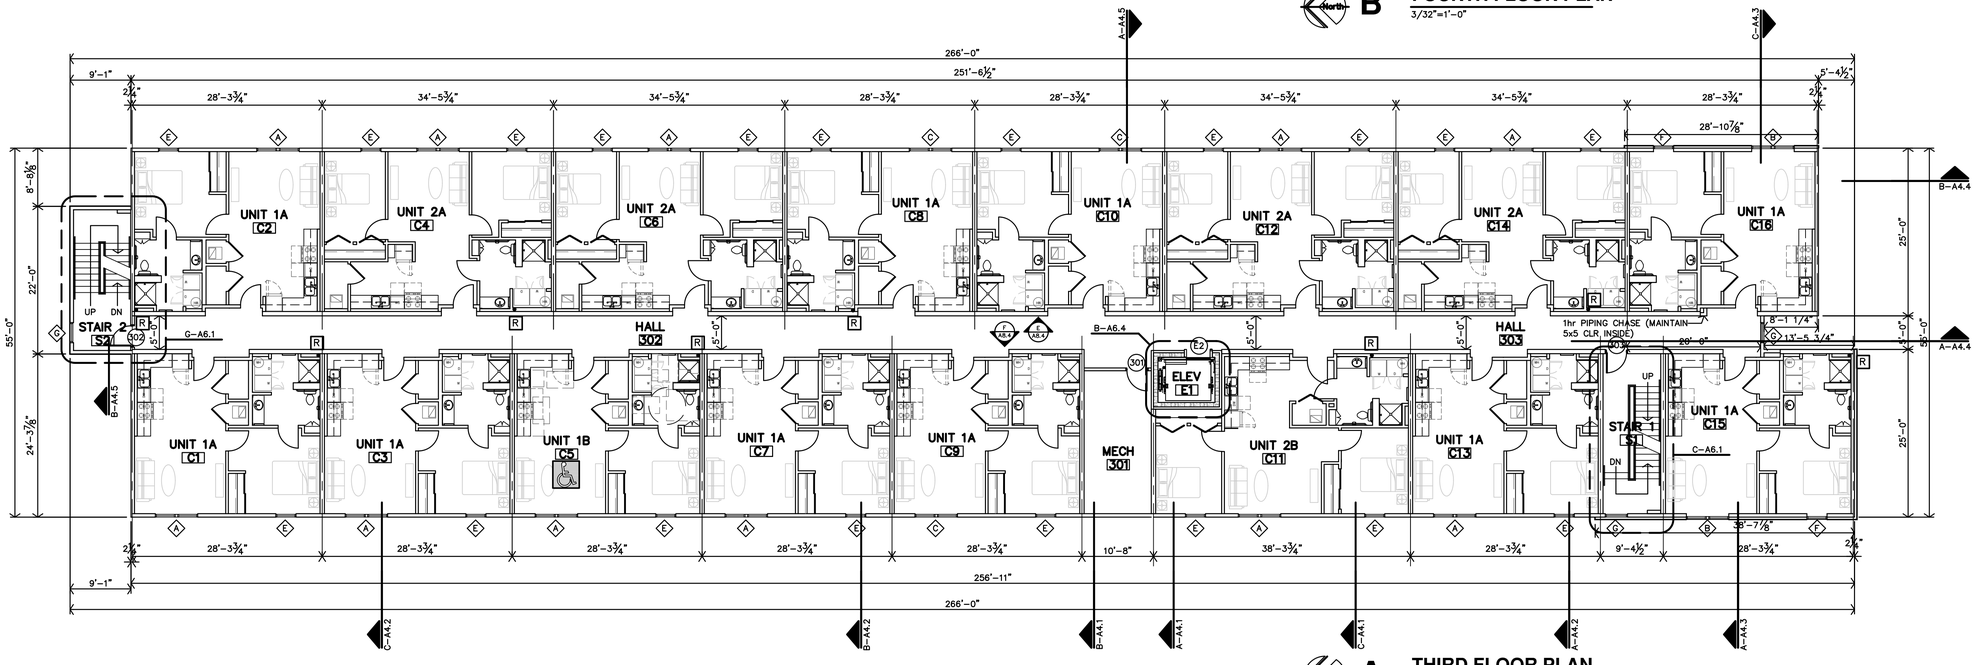

North **A** THIRD FLOOR PLAN
3/32"=1'-0"

JonesGillamRenz
730 N. Ninth
Salina, KS 67401
1881 Main Street, Suite 301
Kansas City, MO 64108
785.827.0386
jgr@jgrarchitects.com

THE RESIDENCE AT HERITAGE WEST

NEW SENIOR-LIVING FACILITY

ANDOVER, KANSAS

CHRISTOPHER R. GILLAM
REGISTERED ARCHITECT
6979
1/3/2025
KANSAS ARCHITECT

REVISION:

DATE: 1-3-2025
JOB: 24-3379
SHEET NO.:

A2.2

COPYRIGHTED ©

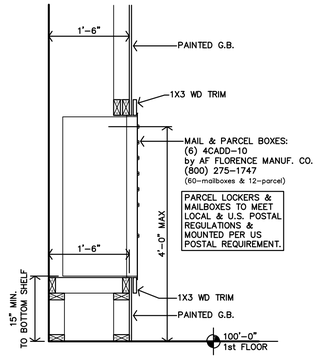

D WALL SECTION @ MAIL CENTER

3/4"=1'-0"

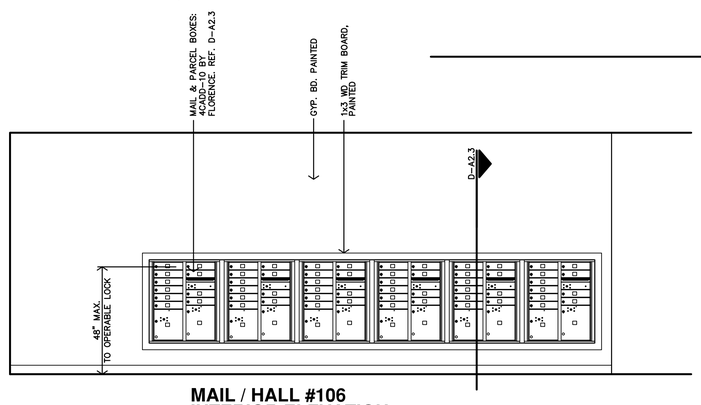

C MAIL / HALL #106 INTERIOR ELEVATION

3/8"=1'-0"

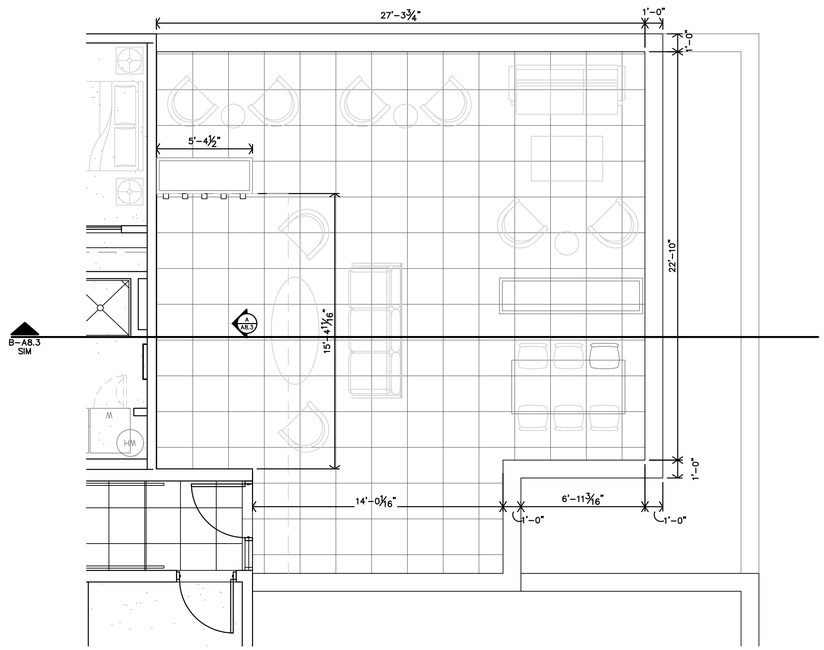

B ENLARGED ROOFTOP DECK PLAN

1/4"=1'-0"

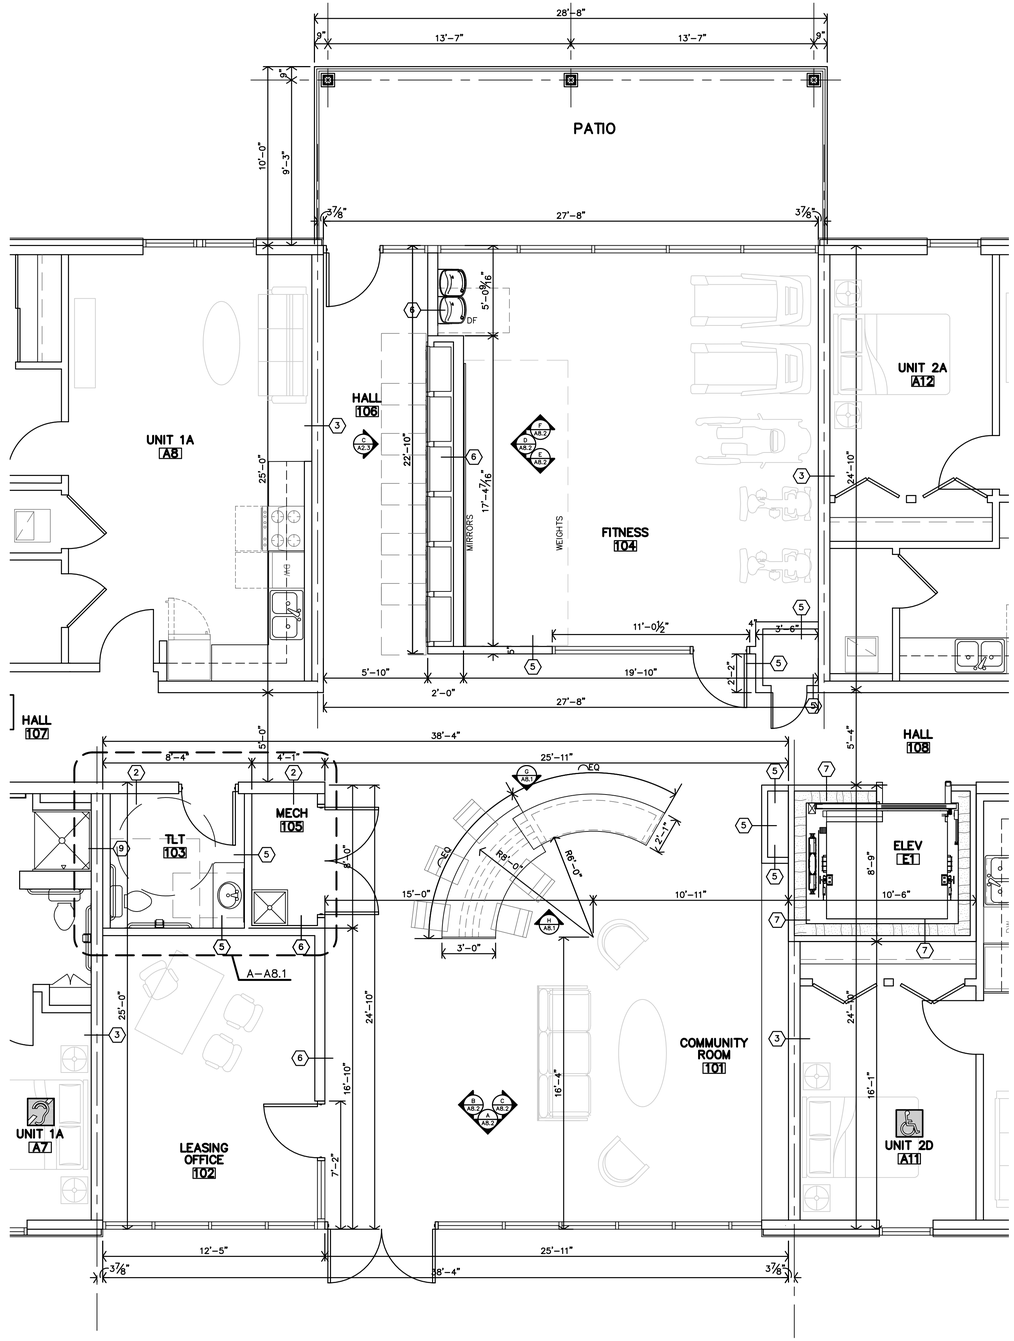

A ENLARGED COMMUNITY ROOM & FITNESS CENTER PLAN

1/4"=1'-0"

Wichita-Sedgwick County
Metropolitan Area Building
and Construction Department

REVIEWED FOR CODE COMPLIANCE

CORRECTIONS OR COMMENTS MADE ON THESE DRAWINGS AND THIS DOCUMENT DURING THIS REVIEW DO NOT RELIEVE CONTRACTOR FROM COMPLIANCE WITH ALL REQUIREMENTS OF THE CODE OF THE MABCD, THE CITY OF WICHITA OR SEDGWICK COUNTY. THIS REVIEW IS ONLY FOR GENERAL CONFORMANCE OF THE CODE. THE CONTRACTOR IS RESPONSIBLE FOR CONFORMING AND CORRELATING ALL TECHNIQUES OF CONSTRUCTION. THIS APPROVAL IS SUBJECT TO PROVISIONS OF SECTION 107.4 OF THE 2012 INTERNATIONAL BUILDING CODE.

DATE: 02/19/25 BY: William Jerauld Jr

JonesGillamRenz
730 N. Ninth
Salina, KS 67401
1881 Main Street, Suite 301
Kansas City, MO 64108
785.827.0386
jgr@jgrarchitects.com

THE RESIDENCE AT HERITAGE WEST

NEW SENIOR-LIVING FACILITY

ANDOVER, KANSAS

CHRISTOPHER R. GILLAM
KANSAS LICENSED
6979
1/3/2025
ARCHITECT

REVISION:

DATE: 1-3-2025
JOB: 24-3379
SHEET NO.:

A2.3

COPYRIGHTED ©

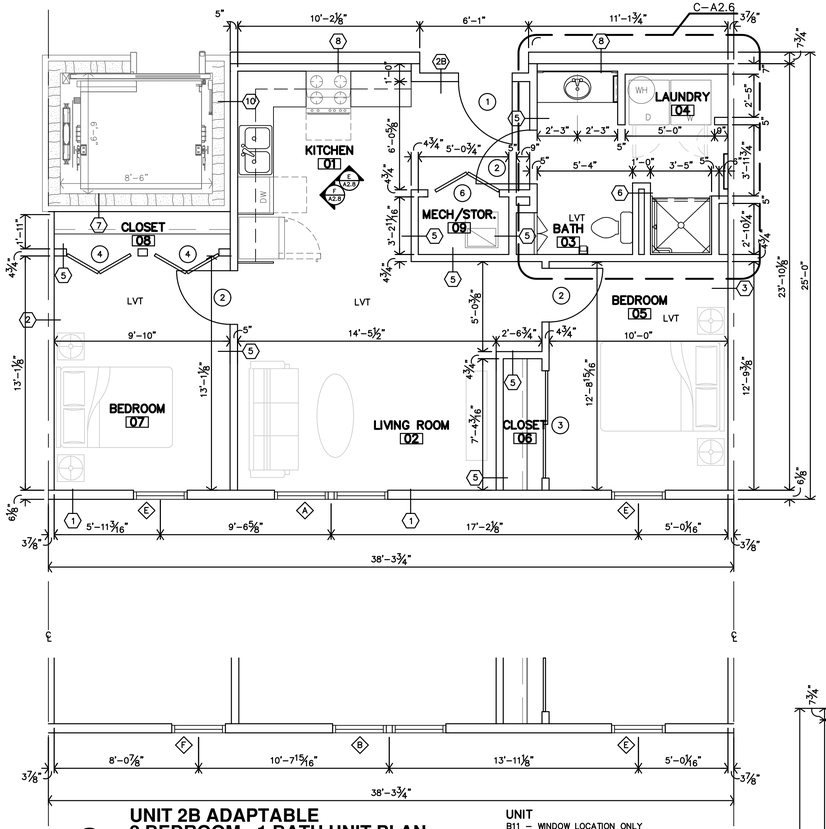

C UNIT 2B ADAPTABLE
2 BEDROOM - 1 BATH UNIT PLAN

1/4"=1'-0" 800 SF

UNIT
B11 – WINDOW LOCATION ONLY

APARTMENT GENERAL NOTES

1. REF STRUCTURAL DRAWINGS FOR SHEAR WALL LOCATIONS.
2. TYPICAL GROUND FLOOR FINISH FLOOR ELEVATION IS REFERENCED AS 100'–0". CONTRACTOR SHALL VERIFY BUILDING ELEVATION WITH SITE CIVIL DRAWINGS.
3. REFERENCE SITE PLAN SHEET A1.1 FOR LOCATION & ORIENTATION OF BUILDINGS.
4. CONTRACTOR SHALL PROVIDE SINGLE PLASTIC COATED WIRE SHELVES & ROD AT ALL CLOSETS U.N.O.
5. CONTRACTOR SHALL PROVIDE FIREBLOCKING, ANCHOR BOLTS AND ANY REQUIRED SHEAR WALL BLOCKING AS REQUIRED BY STRUCTURAL DRAWINGS.
6. CONTRACTOR TO PROVIDE FIRE BLOCKING AT PARTY WALL AT 10'–0" O.C., TYPICAL. CONTRACTOR TO PROVIDE FIRE BLOCKING AT PARTY WALL AT ALL BACK TO BACK ELECTRICAL OUTLETS. PROVIDED AND INSTALL ALL FIRE BLOCKING AND DRAFTSTOPS PER 2012 IBC, SECTIONS 718.
7. FIRE EXTINGUISHERS SHALL BE INSTALLED & PROVIDED IN ACCORDANCE WITH NFPA 10 & 2012 IBC, SECTION 906.1. LOCATED PER CFP SHEET.
8. ALL PENETRATIONS THRU RATED WALLS AND/OR FLOOR ASSEMBLIES SHALL BE FIRESTOPPED PER APPROVED U.L. DESIGNS.
9. HOSE BIBS TO BE LOCATED 6"min. ABOVE WAINSCOT (30"MIN ABV. FIN. FLOOR).
10. TYPICAL AT UNIT WINDOWS, BOTTOM OF HEADER IS 90" ABV. FIN. FLR. REF. WALL SECTIONS & STRUCT.
11. KITCHEN RECEPTACLES TO BE @ 44"max ABOVE FIN FLR.
12. SUBMIT VERIFICATION THAT ALL CONSTRUCTION MATERIAL WILL MEET US EPA CRITERIA PARTICULARLY MATERIALS THAT WILL BE OBTAINED FROM INTERNATIONAL SOURCES. ALSO PROVIDE VERIFICATION THAT THE CONSTRUCTION WILL NOT RESULT IN OR CONTAIN HAZARDOUS MATERIALS.
13. ALL WALL DIMENSIONS ARE TO FACE OF GYP. BD. UNLESS NOTED OTHERWISE.
14. F.O.S. = FACE OF STUD
15. HEARING/VISION IMPAIRED UNITS (WHERE INDICATED ON SHEET A2.0): CONTRACTOR SHALL INSTALL EQUIPMENT REQUIRED PER 2010 ADA SEC. 809.5. REF. ELECT. DWGS
16. FE = WALL MOUNTED FIRE EXTINGUISHER REF. SPECIFICATIONS.
17. REF SHEET A2.0 FOR PARTITION SCHEDULE.
18. VLP = VINYL PLANK
19. CPT = CARPET
20. DOORS ARE TYPICALLY LOCATED 4" FROM CORNER U.N.O.

ADAPTABLE NOTES

21. ADAPTABLE UNITS (WHERE INDICATED ON SHEET A2.1 & A2.2): ALL UNITS NOT LABELED ACCESSIBLE

REFERENCE ENLARGED PLANS AND DETAILS FOR ADDITIONAL INFORMATION

1–BEDROOM, CONTRACTOR TO INSTALL REMOVABLE CABINET WHERE INDICATED & 2x8 BLOCKING IN WALLS FOR FUTURE GRAB BARS @ ALL TOILET, SHOWER SURROUNDS & BASES AND COUNTERTOPS. KNEE CLEARANCES TO BE PROVIDED AT ALL SINKS WITH REMOVABLE BASE CABINETS.

2–BEDROOM, CONTRACTOR TO INSTALL REMOVABLE CABINETS WHERE INDICATED. INSTALL 2x8 BLOCKING IN WALLS FOR FUTURE GRAB BARS @ ALL TOILETS, SHOWER SURROUNDS & BASES AND COUNTERTOPS AT BATHS #03. KNEE CLEARANCES TO PROVIDED AT ALL SINKS WITH REMOVABLE BASE CABINETS..

ALL UNITS, CONTRACTOR TO INSTALL REMOVABLE CABINET FRONTS @ SINK & WORK SPACE IN KITCHEN #01. KNEE CLEARANCES TO BE PROVIDED AT ALL SINKS.

–AT ALL REMOVABLE CABINETS, FLOORS & WALLS SHALL BE FINISHED. NO PLUMBING MODIFICATIONS ALLOWED AFTER CABINET FRONT IS REMOVED. CONTRACTOR SHALL PROVIDE HOT WATER & DRAIN PIPE COVERS. OWNER SHALL INSTALL COVER AFTER CABINET FRONT IS REMOVED.

–TOILETS SHALL BE ADA COMPLIANT (17"–19" HIGH).

–CONTRACTOR TO INSTALL BLOCKING PER ICC/ANSI A117.1–2009.

–REMOVABLE CABINETS REQUIRED WERE PARALLEL APPROACH SPACE CENTERED ON SINK IS NOT PROVIDED.

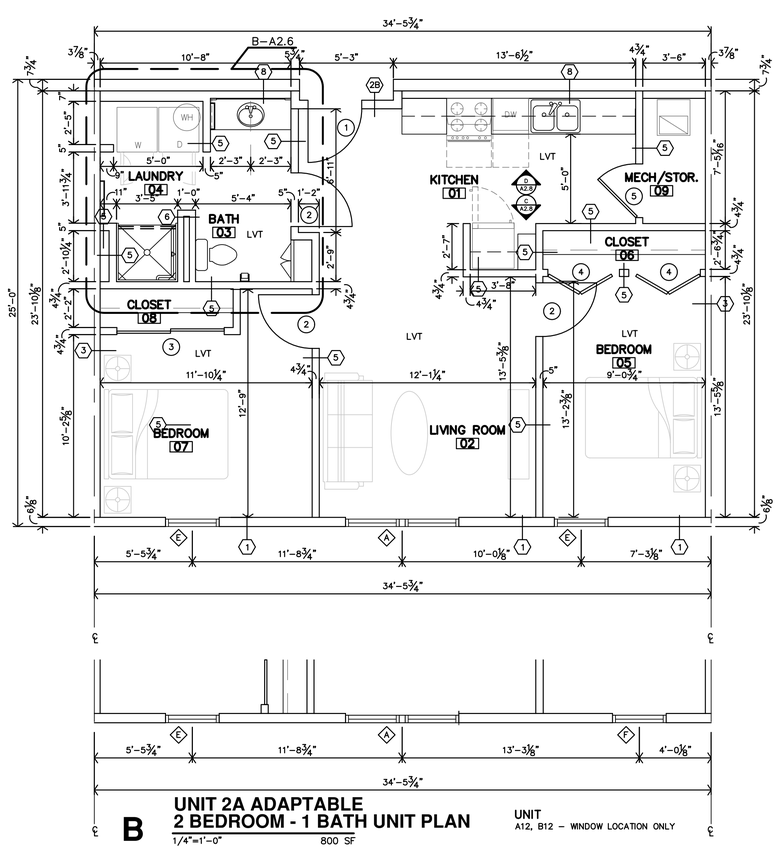

B UNIT 2A ADAPTABLE
2 BEDROOM - 1 BATH UNIT PLAN

1/4"=1'-0" 800 SF

UNIT
A12, B12 – WINDOW LOCATION ONLY

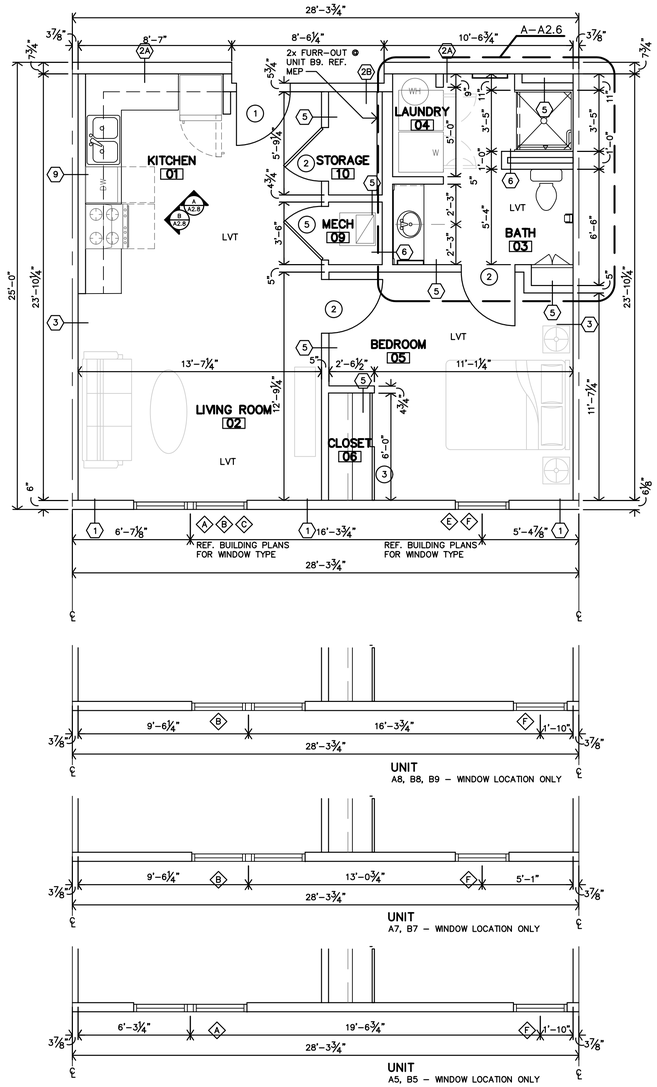

A UNIT 1A ADAPTABLE
1 BEDROOM - 1 BATH UNIT PLAN

1/4"=1'-0" 650 SF

Wichita-Sedgwick County
Metropolitan Area Building
and Construction Department

REVIEWED FOR CODE COMPLIANCE

CORRECTIONS OR COMMENTS MADE ON THESE DRAWINGS AND THIS DOCUMENT DURING THIS REVIEW DO NOT RELIEVE CONTRACTOR FROM COMPLIANCE WITH ALL REQUIREMENTS OF THE CODE OF THE MABCD, THE CITY OF WICHITA OR SEDGWICK COUNTY. THIS REVIEW IS ONLY FOR GENERAL CONFORMANCE OF THE CODE. THE CONTRACTOR IS RESPONSIBLE FOR CONFORMING AND CORRELATING ALL TECHNIQUES OF CONSTRUCTION. THIS APPROVAL IS SUBJECT TO PROVISIONS OF SECTION 107.4 OF THE 2012 INTERNATIONAL BUILDING CODE.

DATE: 02/19/25 BY: William Jerauld Jr

JonesGillamRenz
730 N. Ninth 1881 Main Street, Suite 301
Salina, KS 67401 Kansas City, MO 64108
785.827.0386 jgr@jgrarchitects.com

THE RESIDENCE AT HERITAGE WEST

NEW SENIOR-LIVING FACILITY

ANDOVER, KANSAS

CHRISTOPHER R. GILLAM
REGISTERED ARCHITECT
6979
1/3/2025
KANSAS
ARCHITECT

REVISION:

DATE: 1–3–2025
JOB: 24–3379
SHEET NO.:

A2.4

COPYRIGHTED©

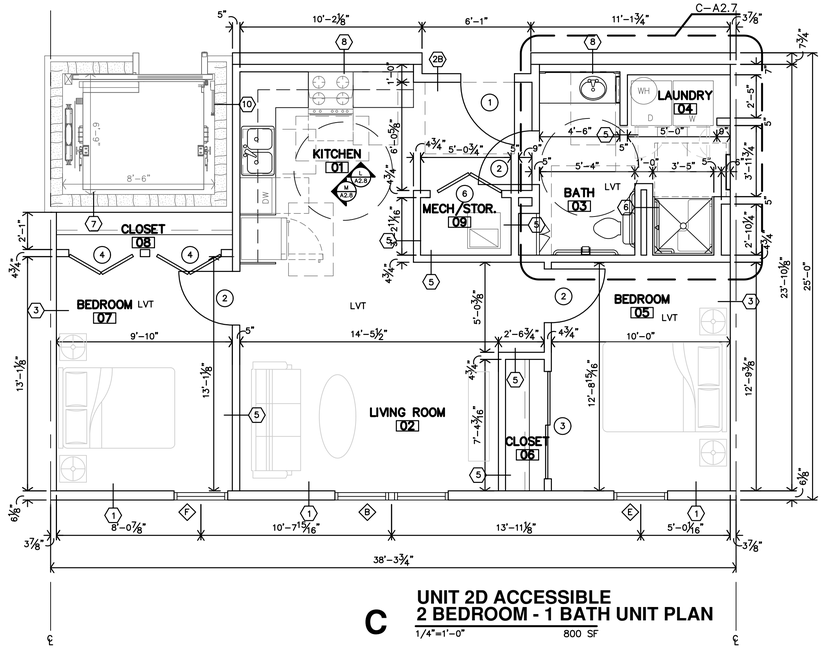

C UNIT 2D ACCESSIBLE 2 BEDROOM - 1 BATH UNIT PLAN

1/4"=1'–0" 800 SF

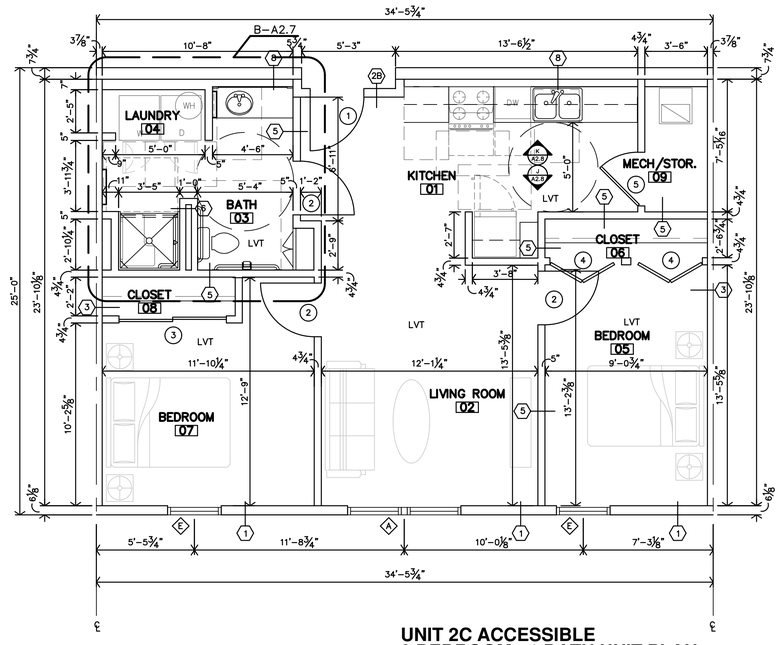

B UNIT 2C ACCESSIBLE 2 BEDROOM - 1 BATH UNIT PLAN

1/4"=1'–0" 800 SF

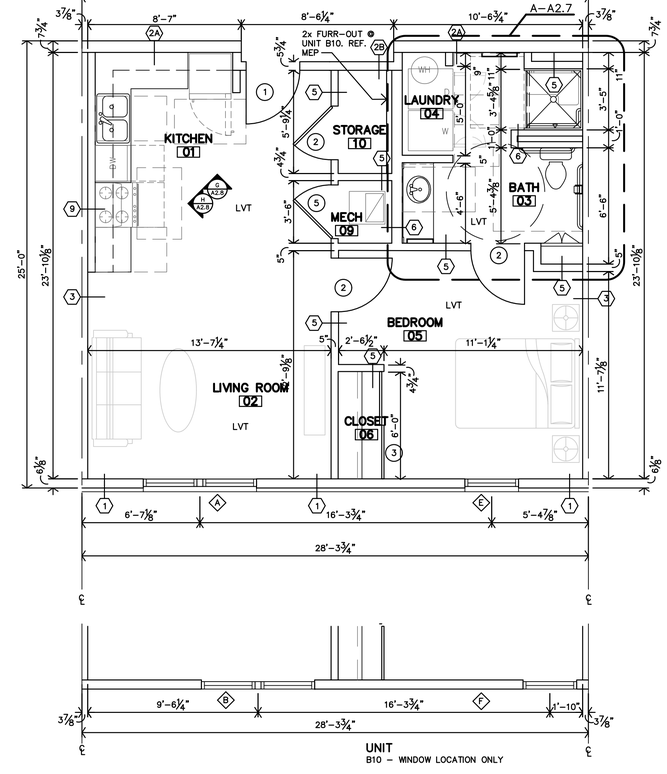

A UNIT 1B ACCESSIBLE 1 BEDROOM - 1 BATH UNIT PLAN

1/4"=1'–0" 650 SF

APARTMENT GENERAL NOTES

1. REF STRUCTURAL DRAWINGS FOR SHEAR WALL LOCATIONS.
2. TYPICAL GROUND FLOOR FINISH FLOOR ELEVATION IS REFERENCED AS 100'–0". CONTRACTOR SHALL VERIFY BUILDING ELEVATION WITH SITE CIVIL DRAWINGS.
3. REFERENCE SITE PLAN SHEET A1.1 FOR LOCATION & ORIENTATION OF BUILDINGS.
4. CONTRACTOR SHALL PROVIDE SINGLE PLASTIC COATED WIRE SHELVES & ROD AT ALL CLOSETS U.N.O.
5. CONTRACTOR SHALL PROVIDE FIREBLOCKING, ANCHOR BOLTS AND ANY REQUIRED SHEAR WALL BLOCKING AS REQUIRED BY STRUCTURAL DRAWINGS.
6. CONTRACTOR TO PROVIDE FIRE BLOCKING AT PARTY WALL AT 10'–0" O.C., TYPICAL. CONTRACTOR TO PROVIDE FIRE BLOCKING AT PARTY WALL AT ALL BACK TO BACK ELECTRICAL OUTLETS. PROVIDED AND INSTALL ALL FIRE BLOCKING AND DRAFTSTOPS PER 2012 IBC, SECTION 718.
7. FIRE EXTINGUISHERS SHALL BE INSTALLED & PROVIDED IN ACCORDANCE WITH NFPA 10 & 2012 IBC, SECTION 906.1. LOCATED PER CFP SHEET.
8. ALL PENETRATIONS THRU RATED WALLS AND/OR FLOOR ASSEMBLIES SHALL BE FIRESTOPPED PER APPROVED U.L. DESIGNS.
9. HOSE BIBS TO BE LOCATED 6"min. ABOVE WAINSCOT (30"MIN ABV. FIN. FLOOR).
10. TYPICAL AT UNIT WINDOWS, BOTTOM OF HEADER IS 90" ABV. FIN. FLR. REF. WALL SECTIONS & STRUCT.
11. KITCHEN RECEPTACLES TO BE @ 44"max ABOVE FIN FLR.
12. SUBMIT VERIFICATION THAT ALL CONSTRUCTION MATERIAL WILL MEET US EPA CRITERIA PARTICULARLY MATERIALS THAT WILL BE OBTAINED FROM INTERNATIONAL SOURCES. ALSO PROVIDE VERIFICATION THAT THE CONSTRUCTION WILL NOT RESULT IN OR CONTAIN HAZARDOUS MATERIALS.
13. ALL WALL DIMENSIONS ARE TO FACE OF GYP. BD. UNLESS NOTED OTHERWISE.
14. F.O.S. = FACE OF STUD
15. HEARING/VISION IMPAIRED UNITS (WHERE INDICATED ON SHEET A2.0):
    - CONTRACTOR SHALL INSTALL EQUIPMENT REQUIRED PER 2010 ADA SEC. 809.5.
    - REF. ELECT. DWGS
16. FE = WALL MOUNTED FIRE EXTINGUISHER REF. SPECIFICATIONS.
17. REF SHEET A2.0 FOR PARTITION SCHEDULE.
18. VLP = VINYL PLANK
19. CPT = CARPET
20. DOORS ARE TYPICALLY LOCATED 4" FROM CORNER U.N.O.

ACCESSIBLE UNIT NOTES

21. ACCESSIBLE UNITS (WHERE INDICATED ON SHEET A2.1 & A2.2):
    - REFERENCE ENLARGED PLANS AND DETAILS FOR ADDITIONAL INFORMATION
    - 1–BEDROOM, CONTRACTOR TO INSTALL 2x8 BLOCKING IN WALLS FOR GRAB BARS @ TOILET, SHOWER SURROUNDS & BASES AND @ SINKS & COUNTERTOPS. KNEE CLEARANCES TO PROVIDED AT ALL SINKS.
    - 2–BEDROOM, CONTRACTOR TO INSTALL 2x8 BLOCKING IN WALLS FOR GRAB BARS @ ALL TOILETS, SHOWER SURROUNDS & BASES AND @ SINKS & COUNTERTOPS AT BATHS #03. KNEE CLEARANCES TO PROVIDED AT ALL SINKS.
    - ALL UNITS, CONTRACTOR TO INSTALL REMOVABLE CABINET FRONTS @ SINK & WORK SPACE IN KITCHEN #01 WHERE INDICATED. KNEE CLEARANCES TO PROVIDED AT ALL SINKS.
      –CONTRACTOR SHALL INSTALL HOT WATER & DRAIN PIPES COVERS.
      –TOILETS SHALL BE ADA COMPLIANT (17"–19" HIGH).
      –CONTRACTOR TO INSTALL BLOCKING AND PROVIDE & INSTALL GRAB BARS PER ICC/ANSI A117.1–2009.

Wichita-Sedgwick County
Metropolitan Area Building
and Construction Department

REVIEWED FOR CODE COMPLIANCE

CORRECTIONS OR COMMENTS MADE ON THESE DRAWINGS AND THIS DOCUMENT DURING THIS REVIEW DO NOT RELIEVE CONTRACTOR FROM COMPLIANCE WITH ALL REQUIREMENTS OF THE CODE OF THE MABCD, THE CITY OF WICHITA OR SEDGWICK COUNTY. THIS REVIEW IS ONLY FOR GENERAL CONFORMANCE OF THE CODE. THE CONTRACTOR IS RESPONSIBLE FOR CONFORMING AND CORRELATING ALL TECHNIQUES OF CONSTRUCTION. THIS APPROVAL IS SUBJECT TO PROVISIONS OF SECTION 107.4 OF THE 2012 INTERNATIONAL BUILDING CODE.

DATE: 02/19/25 BY: William Jerauld Jr

JonesGillamRenz
730 N. Ninth 1881 Main Street, Suite 301
Salina, KS 67401 Kansas City, MO 64108
785.827.0386 jgr@jgrarchitects.com

THE RESIDENCE AT HERITAGE WEST

NEW SENIOR-LIVING FACILITY

ANDOVER, KANSAS

CHRISTOPHER R. GILLAM
REGISTERED ARCHITECT LICENSED
6979
1/3/2025
KANSAS ARCHITECT

REVISION:

DATE: 1–3–2025
JOB: 24–3379
SHEET NO.:

A2.5

COPYRIGHTED ©

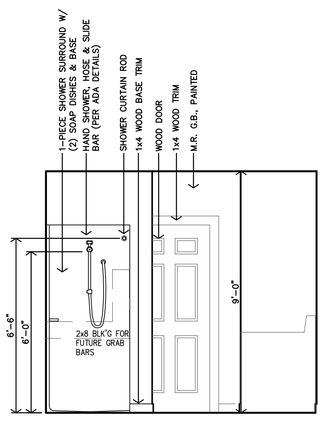

J UNIT 1A ADAPTABLE - BATH #03 INTERIOR ELEVATION
3/8"=1'-0" UNIT 2A & 2B SIM.

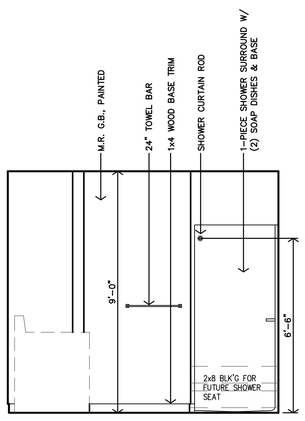

H UNIT 1A ADAPTABLE - BATH #03 INTERIOR ELEVATION
3/8"=1'-0" UNIT 2A & 2B SIM.

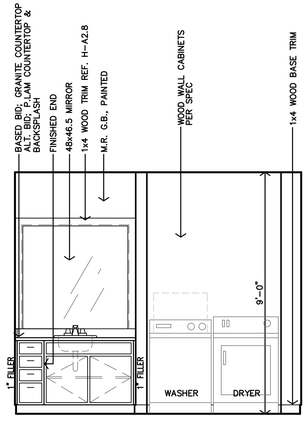

G UNIT 1A ADAPTABLE - BATH #03 INTERIOR ELEVATION
3/8"=1'-0" UNIT 2A & 2B SIM.

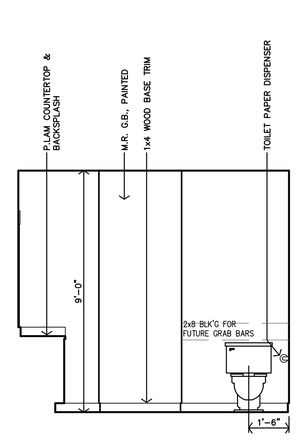

F UNIT 1A ADAPTABLE - BATH #03 INTERIOR ELEVATION
3/8"=1'-0" UNIT 2A & 2B SIM.

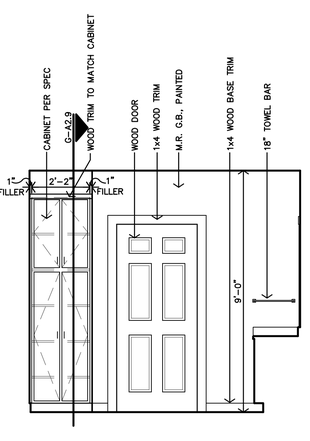

E UNIT 1A ADAPTABLE - BATH #03 INTERIOR ELEVATION
3/8"=1'-0" UNIT 2A & 2B SIM.

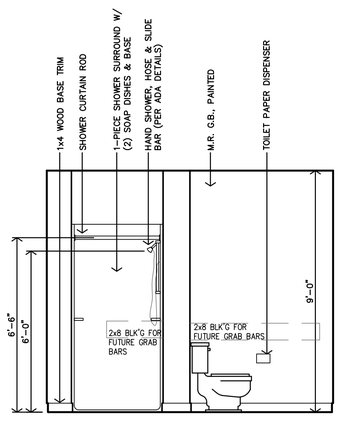

D UNIT 1A ADAPTABLE - BATH #03 INTERIOR ELEVATION
3/8"=1'-0" UNIT 2A & 2B SIM.

ENLARGED BATH NOTES:

1. REF UNIT GENERAL NOTES FOR ADDITIONAL DIRECTION ON THIS SHEET.
2. ALL DIMENSIONS ARE TO FACE OF GYP. BD. UNLESS NOTED OTHERWISE
3. CONTRACTOR TO INSTALL 2x8 BLOCKING IN WALLS FOR ALL WALL MOUNTED/SUPPORTED COUNTERTOPS & BRACES, SHOWER UNIT, TOWEL BARS, GRABS BARS, SHOWER SEAT, ETC. AS REQ'D. (REF. K/L/M/N/O-A2.9)
4. LOCATION OF WASHER & DRYER IS CRITICAL. WASHER IS TO BE LEFT OF DRYER, ALWAYS. THIS NEEDS TO BE COORDINATED ON SITE. ACCESSIBLE UNITS DESIGNED AROUND 27wX30d WASHER & DRYER.

BATH KEYNOTES:

- (A) NO CABINETS ABOVE WASHER & DRYER
- (B) VERIFY SIZE w/ SHOWER UNIT
- (C) WATER HEATER W/ SHELF REF. MECH. DRAWINGS
- (D) FLOORING TO BE CONTINUOUS @ SINK CABINETS & KITCHEN WORKSPACE

LEGEND

M MIRROR
TP TOILET PAPER DISPENSER
GB GRAB BAR
TB TOWEL BAR
SD SOAP DISH
SR SHOWER ROD
SH SHOWER SEAT

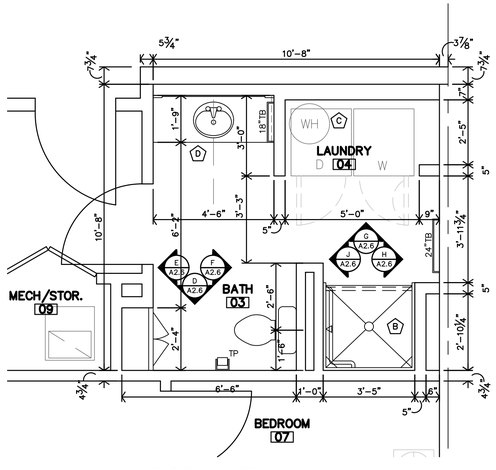

C UNIT 2B ADAPTABLE ENLARGED BATH#03 PLAN
3/8"=1'-0"

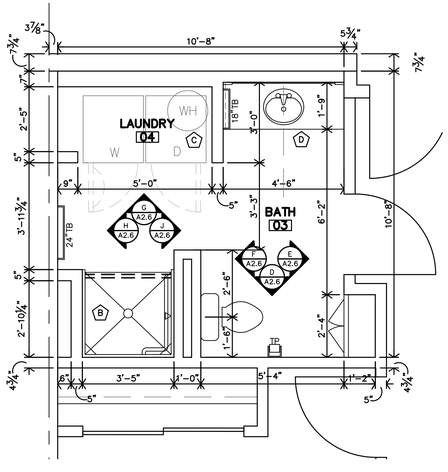

B UNIT 2A ADAPTABLE ENLARGED BATH#03 PLAN
3/8"=1'-0"

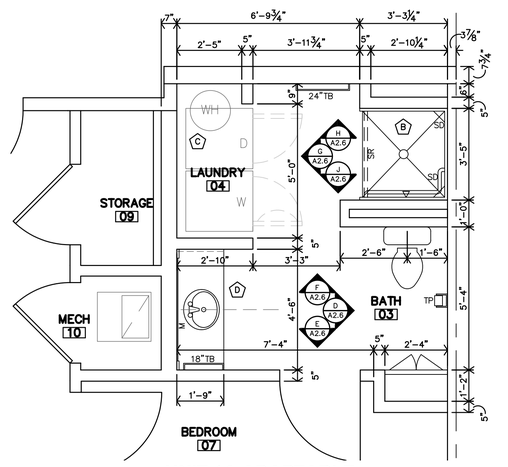

A UNIT 1A ADAPTABLE ENLARGED BATH#03 PLAN
3/8"=1'-0"

Wichita-Sedgwick County
Metropolitan Area Building
and Construction Department

REVIEWED FOR CODE COMPLIANCE

CORRECTIONS OR COMMENTS MADE ON THESE DRAWINGS AND THIS DOCUMENT DURING THIS REVIEW DO NOT RELIEVE CONTRACTOR FROM COMPLIANCE WITH ALL REQUIREMENTS OF THE CODE OF THE MABCD, THE CITY OF WICHITA OR SEDGWICK COUNTY. THIS REVIEW IS ONLY FOR GENERAL CONFORMANCE OF THE CODE. THE CONTRACTOR IS RESPONSIBLE FOR CONFORMING AND CORRELATING ALL TECHNIQUES OF CONSTRUCTION. THIS APPROVAL IS SUBJECT TO PROVISIONS OF SECTION 107.4 OF THE 2012 INTERNATIONAL BUILDING CODE.

DATE: 02/19/25 BY: William Jerauld Jr

JonesGillamRenz
730 N. Ninth
Salina, KS 67401
785.827.0386
1881 Main Street, Suite 301
Kansas City, MO 64108
jgr@jgrarchitects.com

THE RESIDENCE AT HERITAGE WEST

NEW SENIOR-LIVING FACILITY

ANDOVER, KANSAS

CHRISTOPHER R. GILLAM
ARCHITECT LICENSED
6979
1/3/2025
KANSAS
ARCHITECT

REVISION:

DATE: 1-3-2025
JOB: 24-3379
SHEET NO.:

A2.6

COPYRIGHTED ©

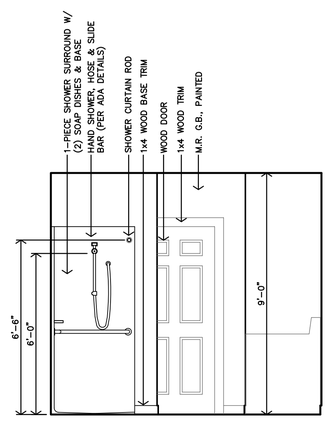

J **UNIT 1B ACCESSIBLE - BATH #03 INTERIOR ELEVATION**
3/8"=1'-0" UNIT 2A & 2B SIM.

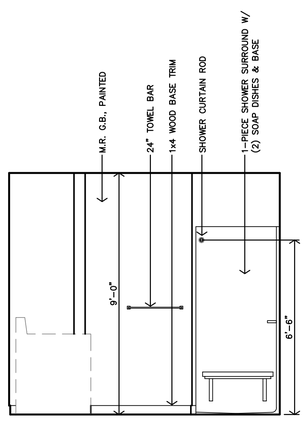

H **UNIT 1B ACCESSIBLE - BATH #03 INTERIOR ELEVATION**
3/8"=1'-0" UNIT 2A & 2B SIM.

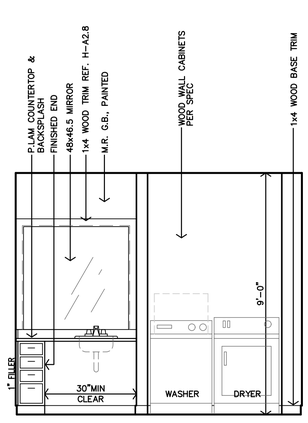

G **UNIT 1B ACCESSIBLE - BATH #03 INTERIOR ELEVATION**
3/8"=1'-0" UNIT 2A & 2B SIM.

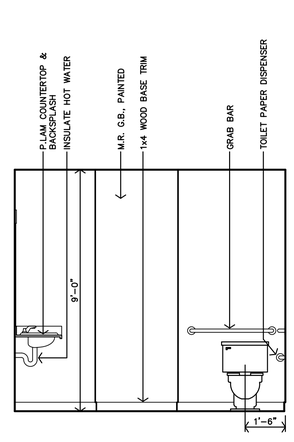

F **UNIT 1B ACCESSIBLE - BATH #03 INTERIOR ELEVATION**
3/8"=1'-0" UNIT 2A & 2B SIM.

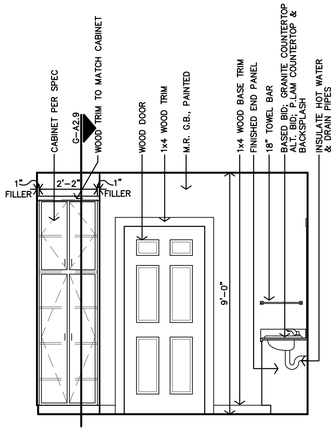

E **UNIT 1B ACCESSIBLE - BATH #03 INTERIOR ELEVATION**
3/8"=1'-0" UNIT 2A & 2B SIM.

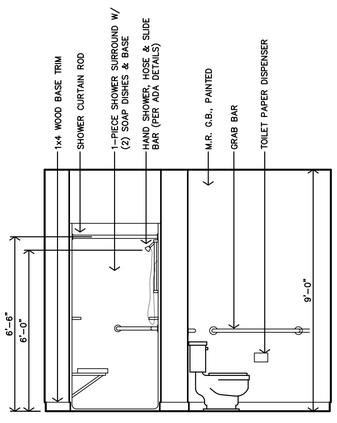

D **UNIT 1B ACCESSIBLE - BATH #03 INTERIOR ELEVATION**
3/8"=1'-0" UNIT 2A & 2B SIM.

ENLARGED BATH NOTES:

1. REF UNIT GENERAL NOTES FOR ADDITIONAL DIRECTION ON THIS SHEET.
2. ALL DIMENSIONS ARE TO FACE OF GYP. BD. UNLESS NOTED OTHERWISE
3. CONTRACTOR TO INSTALL 2x8 BLOCKING IN WALLS FOR ALL WALL MOUNTED/SUPPORTED COUNTERTOPS & BRACES, SHOWER UNIT, TOWEL BARS, GRABS BARS, SHOWER SEAT, ETC. AS REQ'D. (REF. K/L/M/N/O-A2.9)
4. LOCATION OF WASHER & DRYER IS CRITICAL. WASHER IS TO BE LEFT OF DRYER, ALWAYS. THIS NEEDS TO BE COORDINATED ON SITE. ACCESSIBLE UNITS DESIGNED AROUND 27"x30d WASHER & DRYER.

BATH KEYNOTES:

- (A) NO CABINETS ABOVE WASHER & DRYER
- (B) VERIFY SIZE w/ SHOWER UNIT
- (C) WATER HEATER w/ SHELF REF. MECH. DRAWINGS
- (D) FLOORING TO BE CONTINUOUS @ SINK CABINETS & KITCHEN WORKSPACE

LEGEND

M	MIRROR
TP	TOILET PAPER DISPENSER
GB	GRAB BAR
TB	TOWEL BAR
SD	SOAP DISH
SR	SHOWER ROD
SH	SHOWER SEAT

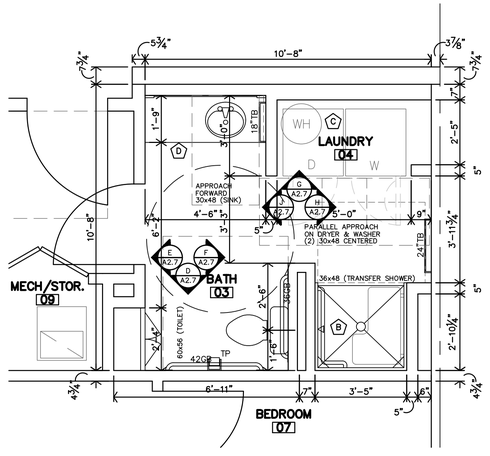

C **UNIT 2D ACCESSIBLE ENLARGED BATH#03 PLAN**
3/8"=1'-0"

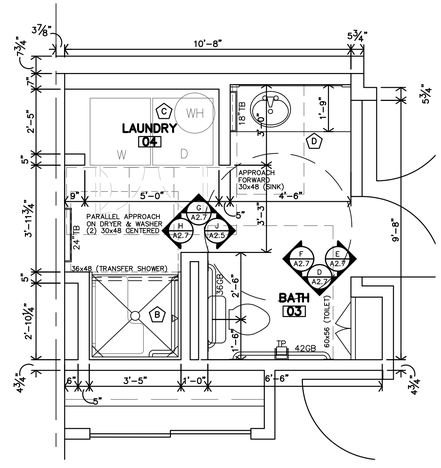

B **UNIT 2C ACCESSIBLE ENLARGED BATH#03 PLAN**
3/8"=1'-0"

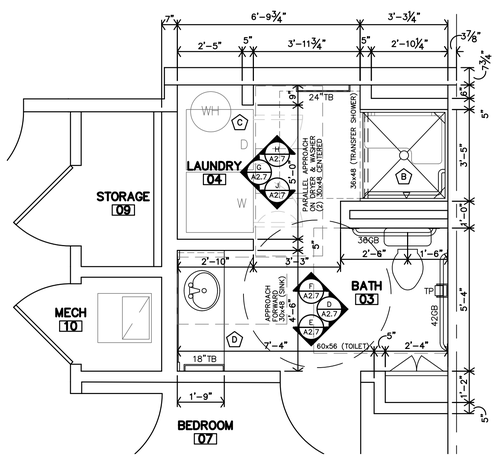

A **UNIT 1B ACCESSIBLE ENLARGED BATH#03 PLAN**
3/8"=1'-0"

Wichita-Sedgwick County
Metropolitan Area Building
and Construction Department

REVIEWED FOR CODE COMPLIANCE

CORRECTIONS OR COMMENTS MADE ON THESE DRAWINGS AND THIS DOCUMENT DURING THIS REVIEW DO NOT RELIEVE CONTRACTOR FROM COMPLIANCE WITH ALL REQUIREMENTS OF THE CODE OF THE MABCD, THE CITY OF WICHITA OR SEDGWICK COUNTY. THIS REVIEW IS ONLY FOR GENERAL CONFORMANCE OF THE CODE. THE CONTRACTOR IS RESPONSIBLE FOR CONFORMING AND CORRELATING ALL TECHNIQUES OF CONSTRUCTION. THIS APPROVAL IS SUBJECT TO PROVISIONS OF SECTION 107.4 OF THE 2012 INTERNATIONAL BUILDING CODE.

DATE: 02/19/25 BY: William Jerauld Jr

JonesGillamRenz
730 N. Ninth
Salina, KS 67401
785.827.0386
1881 Main Street, Suite 301
Kansas City, MO 64108
jgr@jgrarchitects.com

THE RESIDENCE AT HERITAGE WEST

NEW SENIOR-LIVING FACILITY

ANDOVER, KANSAS

CHRISTOPHER R. GILLAM
6979
1/3/2025
KANSAS
ARCHITECT

REVISION:

DATE: 1-3-2025
JOB: 24-3379
SHEET NO.:

A2.7

COPYRIGHTED©

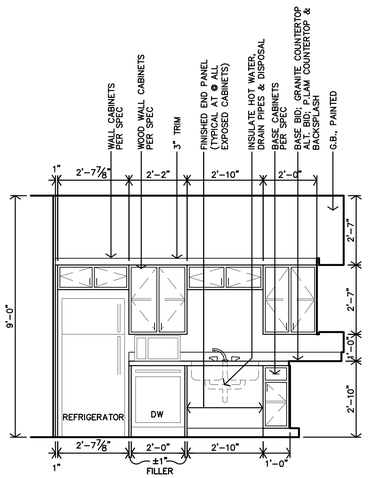

UNIT 2D
ACCESSIBLE - KITCHEN #01
INTERIOR ELEVATION
3/8"=1'-0"

M

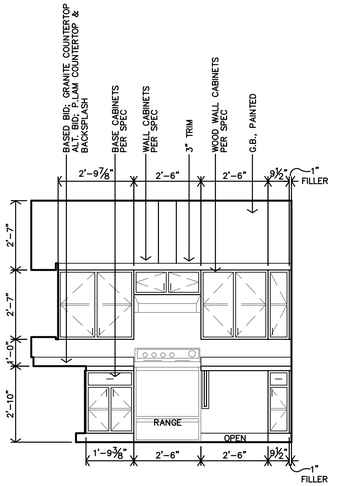

UNIT 2D
ACCESSIBLE - KITCHEN #01
INTERIOR ELEVATION
3/8"=1'-0"

L

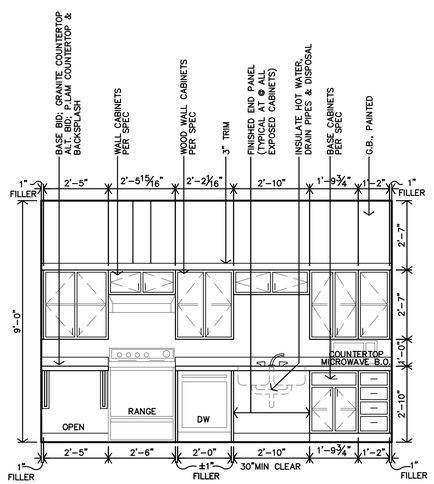

UNIT 2C
ACCESSIBLE - KITCHEN #01
INTERIOR ELEVATION
3/8"=1'-0"

K

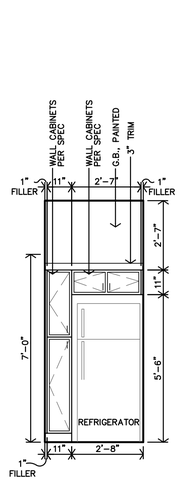

UNIT 2C
ACCESSIBLE - KITCHEN #01
INTERIOR ELEVATION
3/8"=1'-0"

J

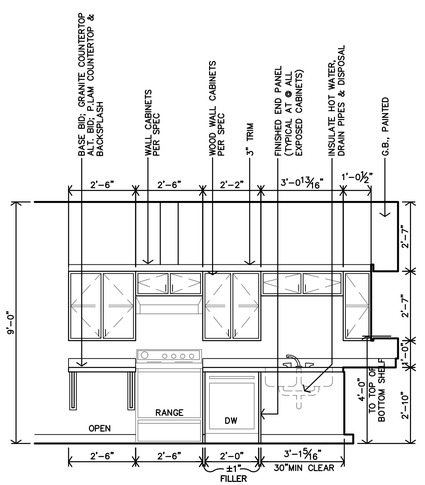

UNIT 1B
ACCESSIBLE - KITCHEN #01
INTERIOR ELEVATION
3/8"=1'-0"

H

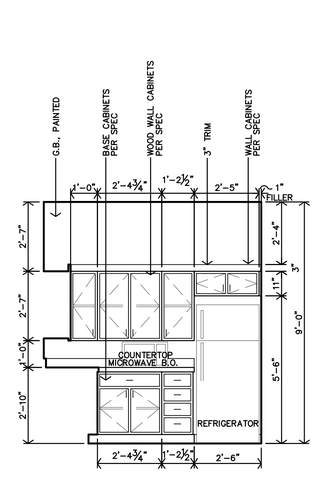

UNIT 1B
ACCESSIBLE - KITCHEN #01
INTERIOR ELEVATION
3/8"=1'-0"

G

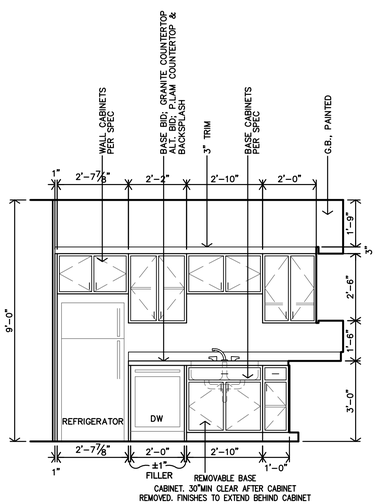

UNIT 2B
ADAPTABLE - KITCHEN #01
INTERIOR ELEVATION
3/8"=1'-0"

F

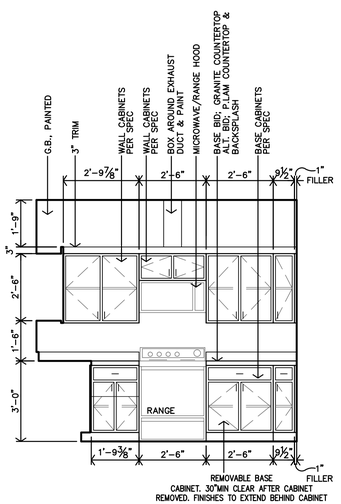

UNIT 2B
ADAPTABLE - KITCHEN #01
INTERIOR ELEVATION
3/8"=1'-0"

E

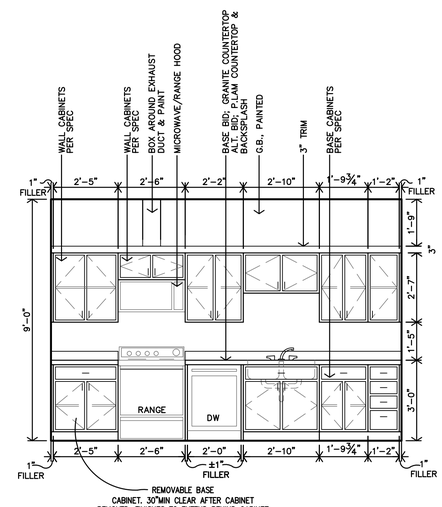

UNIT 2A
ADABTABLE - KITCHEN #01
INTERIOR ELEVATION
3/8"=1'-0"

D

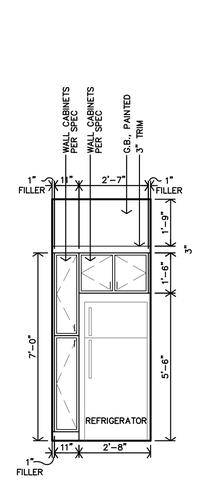

UNIT 2A
ADAPTABLE - KITCHEN #01
INTERIOR ELEVATION
3/8"=1'-0"

C

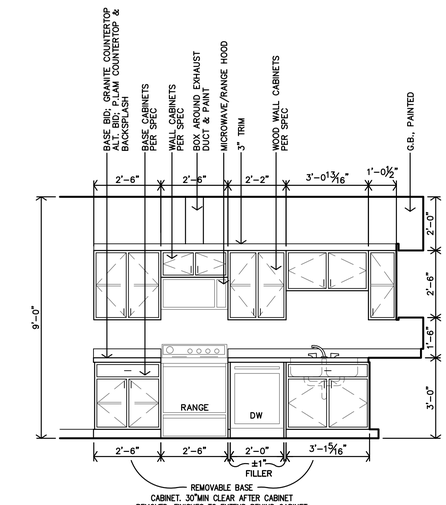

UNIT 1A
ADAPTBALE - KITCHEN #01
INTERIOR ELEVATION
3/8"=1'-0"

B

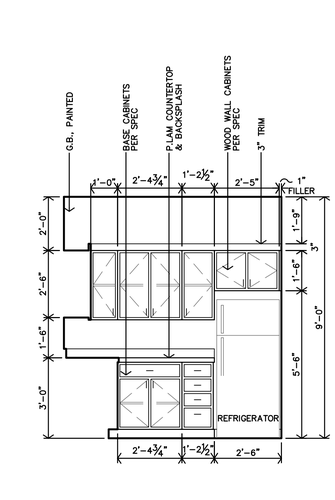

UNIT 1A
ADAPTABLE - KITCHEN #01
INTERIOR ELEVATION
3/8"=1'-0"

A

Wichita-Sedgwick County
Metropolitan Area Building
and Construction Department

REVIEWED FOR CODE COMPLIANCE

CORRECTIONS OR COMMENTS MADE ON THESE DRAWINGS AND THIS DOCUMENT DURING THIS REVIEW DO NOT RELIEVE CONTRACTOR FROM COMPLIANCE WITH ALL REQUIREMENTS OF THE CODE OF THE MABCD, THE CITY OF WICHITA OR SEDGWICK COUNTY. THIS REVIEW IS ONLY FOR GENERAL CONFORMANCE OF THE CODE. THE CONTRACTOR IS RESPONSIBLE FOR CONFORMING AND CORRELATING ALL TECHNIQUES OF CONSTRUCTION. THIS APPROVAL IS SUBJECT TO PROVISIONS OF SECTION 107.4 OF THE 2012 INTERNATIONAL BUILDING CODE.

DATE: 02/19/25 BY: William Jerauld Jr

JonesGillamRenz
730 N. Ninth
Salina, KS 67401
785.827.0386
1881 Main Street, Suite 301
Kansas City, MO 64108
jgr@jgrarchitects.com

THE RESIDENCE AT HERITAGE WEST

NEW SENIOR-LIVING FACILITY

ANDOVER, KANSAS

CHRISTOPHER R. GILLAM
REGISTERED
6979
1/3/2025
KANSAS
ARCHITECT

REVISION:

DATE: 1-3-2025
JOB: 24-3379
SHEET NO.:

A2.8

COPYRIGHTED©

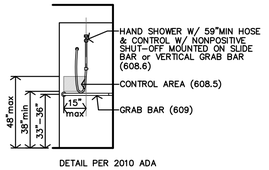

DETAIL PER 2010 ADA

O TYP. HEIGHTS @ ACCESSIBLE SHOWER CONTROL WALL

1/4"=1'-0" FOR ACCESSIBLE HEIGHTS

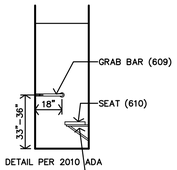

DETAIL PER 2010 ADA

N TYP. HEIGHTS @ ACCESSIBLE SHOWER BACK WALL

1/4"=1'-0" FOR ACCESSIBLE HEIGHTS

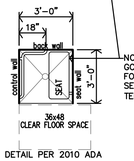

NOTE:
GC TO INSTALL BLOCKING FOR FUTURE FIXED SEAT. SEAT TO BE INSTALLED AT TENANT'S REQUEST.

DETAIL PER 2010 ADA

M TYP. HEIGHTS @ ACCESSIBLE SHOWER PLAN

1/4"=1'-0" FOR ACCESSIBLE HEIGHTS

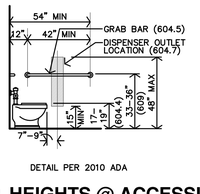

DETAIL PER 2010 ADA

L TYP. HEIGHTS @ ACCESSIBLE TOILET SIDE WALL

1/4"=1'-0" FOR ACCESSIBLE HEIGHTS

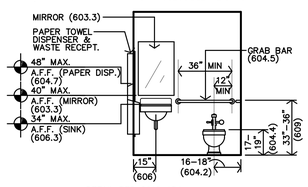

DETAIL PER 2010 ADA

K TYP. HEIGHTS @ ACCESSIBLE TOILET REAR WALL

1/4"=1'-0" FOR ACCESSIBLE HEIGHTS

UNIT ACCESSIBLE BATH DETAILS

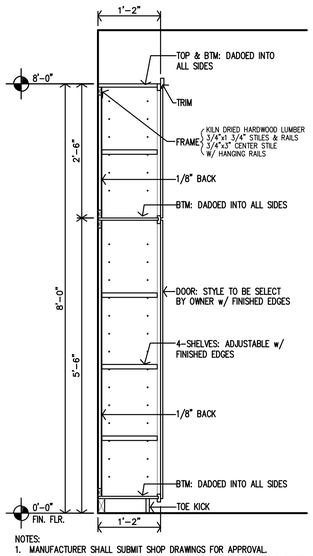

NOTES:
1. MANUFACTURER SHALL SUBMIT SHOP DRAWINGS FOR APPROVAL.
2. MANUFACTURER SHALL PROVIDE ALL FILLERS/BRACES TO MATCH CABINETS.
3. REF. UNIT FLOOR PLANS FOR WIDTH OF CABINET.

G SECTION @ BATH CABINET

3/4"=1'-0"

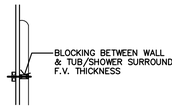

J TYPICAL TUB/SHOWER SURROUND BLOCKING

NTS

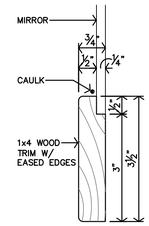

H MIRROR TRIM DETAIL

6"=1'-0"

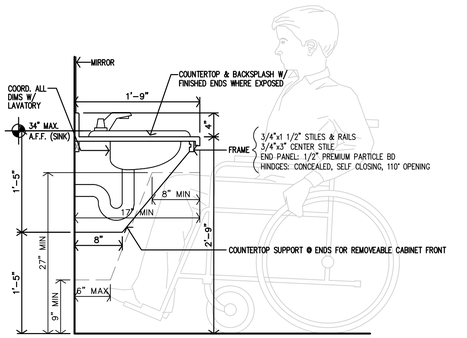

F SECTION @ ACCESSIBLE BATHROOM VANITY

1"=1'-0"

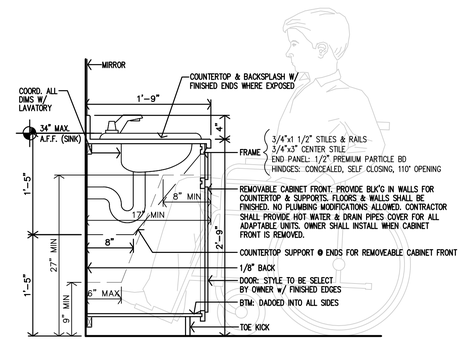

E SECTION @ ADAPTABLE BATHROOM VANITY

1"=1'-0"

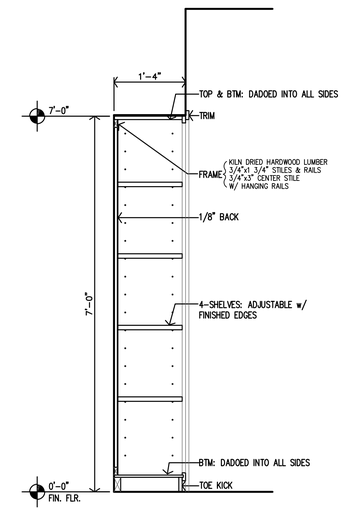

NOTES:
1. MANUFACTURER SHALL SUBMIT SHOP DRAWINGS FOR APPROVAL.
2. MANUFACTURER SHALL PROVIDE ALL FILLERS/BRACES TO MATCH CABINETS.
3. REF. UNIT FLOOR PLANS FOR WIDTH OF CABINET.

D SECTION @ KITCHEN CABINETS

3/4"=1'-0"

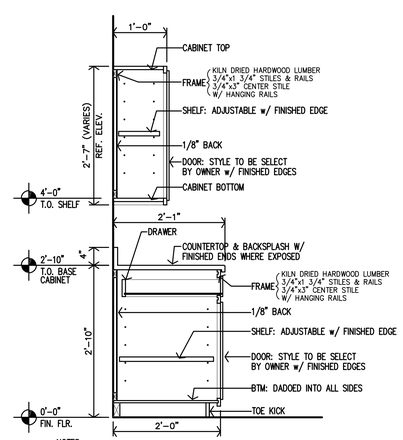

NOTES:
1. MANUFACTURER SHALL SUBMIT SHOP DRAWINGS FOR APPROVAL.
2. MANUFACTURER SHALL PROVIDE ALL FILLERS/BRACES TO MATCH CABINETS.

C SECTION @ ACCESSIBLE KITCHEN CABINETS

3/4"=1'-0"

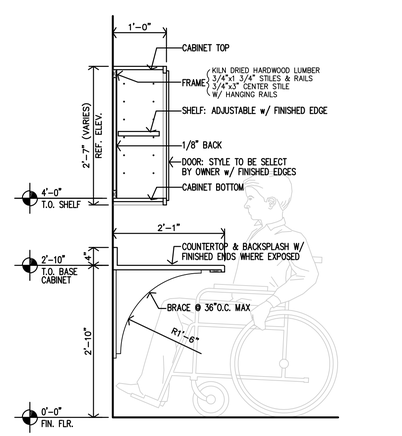

NOTES:
1. MANUFACTURER SHALL SUBMIT SHOP DRAWINGS FOR APPROVAL.
2. MANUFACTURER SHALL PROVIDE ALL FILLERS/BRACES TO MATCH CABINETS.

B SECTION @ ACCESSIBLE KITCHEN WORK SPACE

3/4"=1'-0"

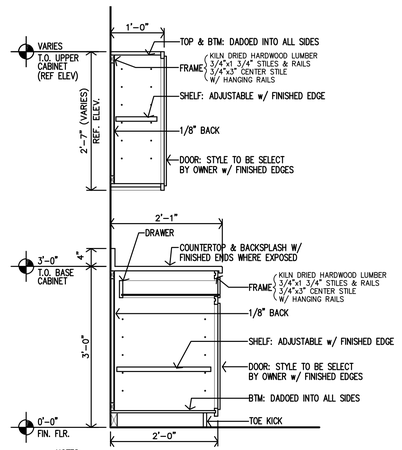

NOTES:
1. MANUFACTURER SHALL SUBMIT SHOP DRAWINGS FOR APPROVAL.
2. MANUFACTURER SHALL PROVIDE ALL FILLERS/BRACES TO MATCH CABINETS.

A SECTION @ ADAPTABLE KITCHEN CABINETS

3/4"=1'-0"

Wichita-Sedgwick County
Metropolitan Area Building and Construction Department

REVIEWED FOR CODE COMPLIANCE

CORRECTIONS OR COMMENTS MADE ON THESE DRAWINGS AND THIS DOCUMENT DURING THIS REVIEW DO NOT RELIEVE CONTRACTOR FROM COMPLIANCE WITH ALL REQUIREMENTS OF THE CODE OF THE MARCH, THE CITY OF WICHITA OR SEDGWICK COUNTY. THIS REVIEW IS ONLY FOR GENERAL CONFORMANCE OF THE CODE. THE CONTRACTOR IS RESPONSIBLE FOR CONFORMING AND CORRELATING ALL TECHNIQUES OF CONSTRUCTION. THIS APPROVAL IS SUBJECT TO PROVISIONS OF SECTION 107.4 OF THE 2012 INTERNATIONAL BUILDING CODE.

DATE: 02/19/25 BY: William Jerauld Jr

JonesGillamRenz
730 N. Ninth
Salina, KS 67401
1881 Main Street, Suite 301
Kansas City, MO 64108
785.827.0386
jgr@jgrarchitects.com

THE RESIDENCE AT HERITAGE WEST

NEW SENIOR-LIVING FACILITY

ANDOVER, KANSAS

CHRISTOPHER R. GILLAM REGISTERED ARCHITECT 6979 1/3/2025 KANSAS ARCHITECT

REVISION:

DATE: 1-3-2025
JOB: 24-3379
SHEET NO.:

A2.9

COPYRIGHTED ©

EXTERIOR MATERIALS

MASONRY
HONED COTTONWOOD TOP LEDGE SPLIT–FACE COTTONWOOD TOP LEDGE
FIBER CEMENT SIDING
6" FACE LAP SIDING – PAINTED 4" FACE LAP SIDING – PAINTED SMOOTH PANEL SIDING – PAINTED
METAL FASCIA/PANEL
LAMINATED METAL PANEL – PREFINISHED

*CJ – CONTROL JOINT, LEAVE 3/8" GAP THROUGH THE VENEER AND FILL WITH BACKER ROD AND SEALANT.

Wichita-Sedgwick County
Metropolitan Area Building
and Construction Department

REVIEWED FOR CODE COMPLIANCE

CORRECTIONS OR COMMENTS MADE ON THESE DRAWINGS AND THIS DOCUMENT DURING THIS REVIEW DO NOT RELIEVE CONTRACTOR FROM COMPLIANCE WITH ALL REQUIREMENTS OF THE CODE OF THE MABCD, THE CITY OF WICHITA OR SEDGWICK COUNTY. THIS REVIEW IS ONLY FOR GENERAL CONFORMANCE OF THE CODE. THE CONTRACTOR IS RESPONSIBLE FOR CONFORMING AND CORRELATING ALL TECHNIQUES OF CONSTRUCTION. THIS APPROVAL IS SUBJECT TO PROVISIONS OF SECTION 107.4 OF THE 2012 INTERNATIONAL BUILDING CODE.

DATE: 02/19/25 BY: William Jerauld Jr

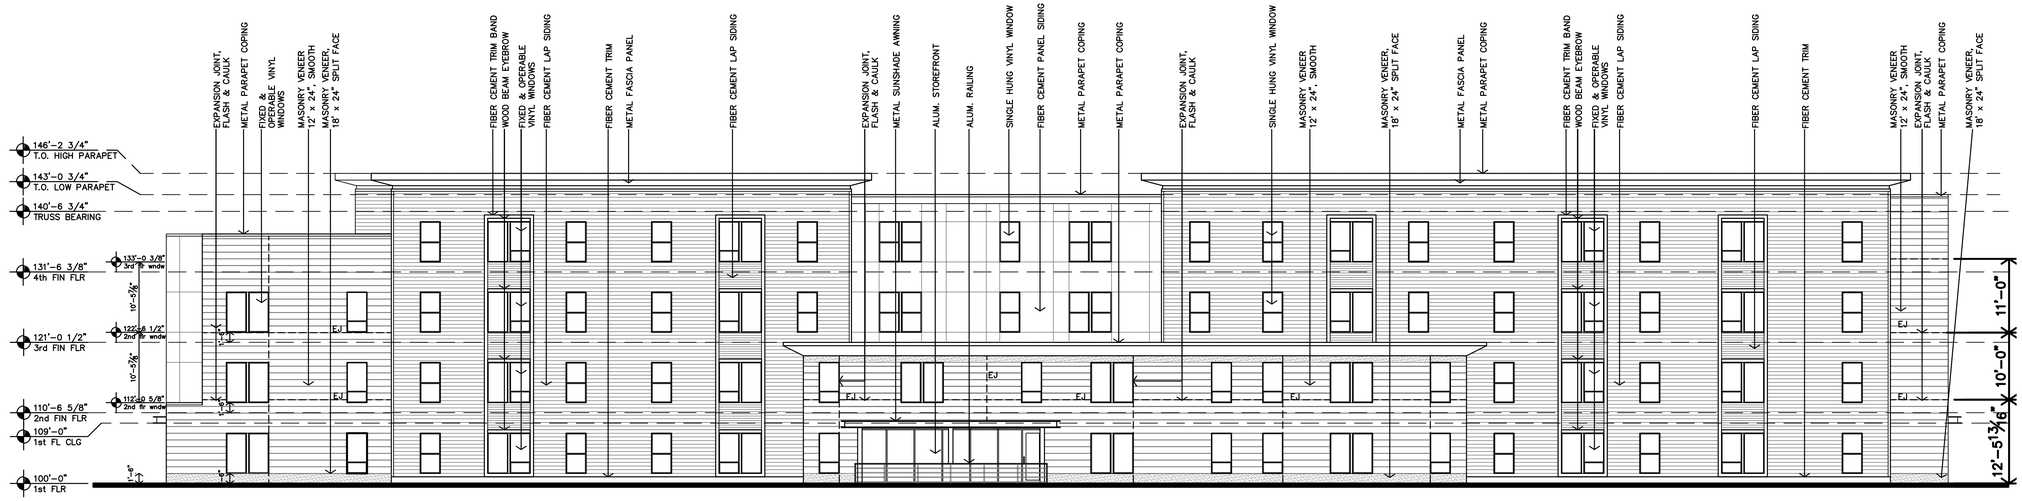

B EAST EXTERIOR ELEVATION
3/32"=1'-0"

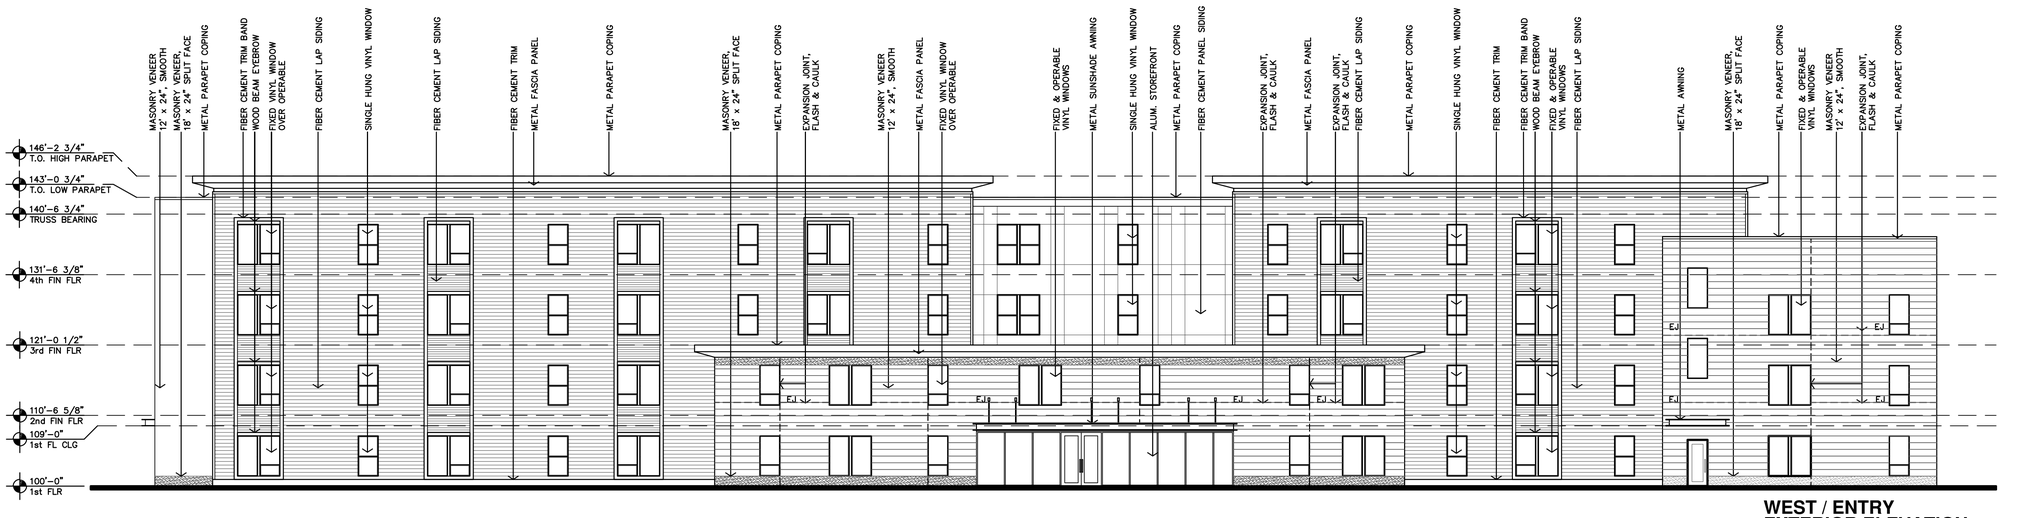

A WEST / ENTRY EXTERIOR ELEVATION
3/32"=1'-0"

JonesGillamRenz
730 N. Ninth
Salina, KS 67401
1881 Main Street, Suite 301
Kansas City, MO 64108
785.827.0386
jgr@jgrarchitects.com

THE RESIDENCE AT HERITAGE WEST

NEW SENIOR-LIVING FACILITY

ANDOVER, KANSAS

CHRISTOPHER R. GILLAM
REGISTERED ARCHITECT
6979
1/3/2025
KANSAS ARCHITECT

REVISION:

DATE: 1-3-2025
JOB: 24-3379
SHEET NO.:

A3.1

COPYRIGHTED©

EXTERIOR MATERIALS

MASONRY
HONED COTTONWOOD TOP LEDGE SPLIT–FACE COTTONWOOD TOP LEDGE
FIBER CEMENT SIDING
6" FACE LAP SIDING – PAINTED 4" FACE LAP SIDING – PAINTED SMOOTH PANEL SIDING – PAINTED
METAL FASCIA/PANEL
LAMINATED METAL PANEL – PREFINISHED

*CJ – CONTROL JOINT, LEAVE 3/8" GAP THROUGH THE VENEER AND FILL WITH BACKER ROD AND SEALANT.

Wichita-Sedgwick County
Metropolitan Area Building
and Construction Department

REVIEWED FOR CODE COMPLIANCE

CORRECTIONS OR COMMENTS MADE ON THESE DRAWINGS AND THIS DOCUMENT DURING THIS REVIEW DO NOT RELIEVE CONTRACTOR FROM COMPLIANCE WITH ALL REQUIREMENTS OF THE CODE OF THE MABCD, THE CITY OF WICHITA OR SEDGWICK COUNTY. THIS REVIEW IS ONLY FOR GENERAL CONFORMANCE OF THE CODE. THE CONTRACTOR IS RESPONSIBLE FOR CONFORMING AND CORRELATING ALL TECHNIQUES OF CONSTRUCTION. THIS APPROVAL IS SUBJECT TO PROVISIONS OF SECTION 107.4 OF THE 2012 INTERNATIONAL BUILDING CODE.

DATE: 02/19/25 BY: William Jerauld Jr

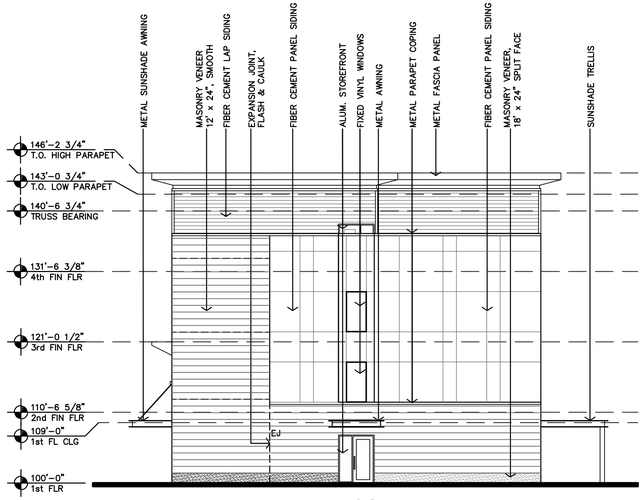

B SOUTH END EXTERIOR ELEVATION
3/32"=1'–0"

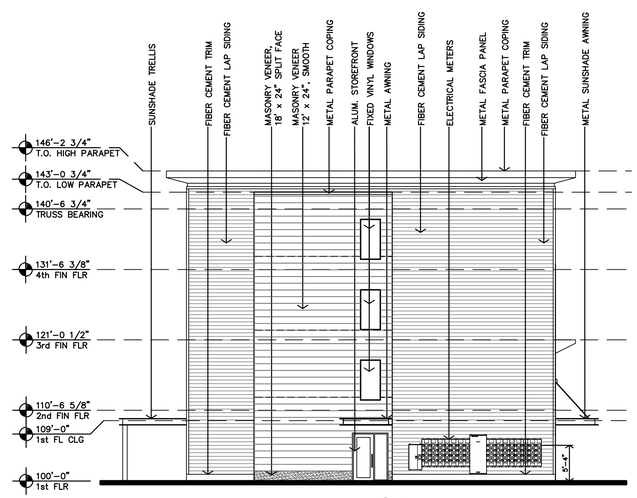

A NORTH END EXTERIOR ELEVATION
3/32"=1'–0"

JonesGillamRenz
730 N. Ninth
Salina, KS 67401
785.827.0386
1881 Main Street, Suite 301
Kansas City, MO 64108
jgr@jgrarchitects.com

THE RESIDENCE AT HERITAGE WEST

NEW SENIOR-LIVING FACILITY

ANDOVER, KANSAS

CHRISTOPHER R. CULLUM
ARCHITECT
6979
1/3/2025
KANSAS

REVISION:

DATE: 1–3–2025
JOB: 24–3379
SHEET NO.:

A3.2

COPYRIGHTED ©

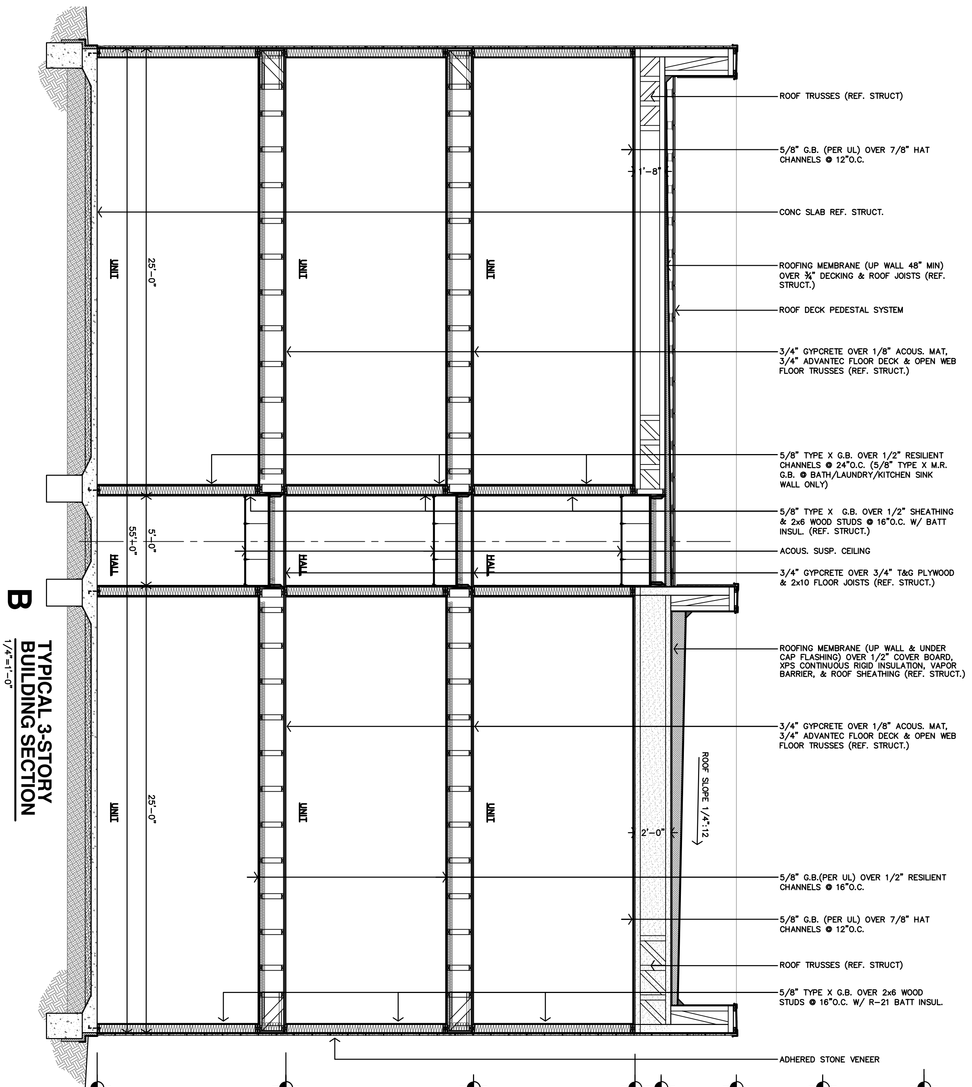

B TYPICAL 3-STORY BUILDING SECTION
1/4"=1'-0"

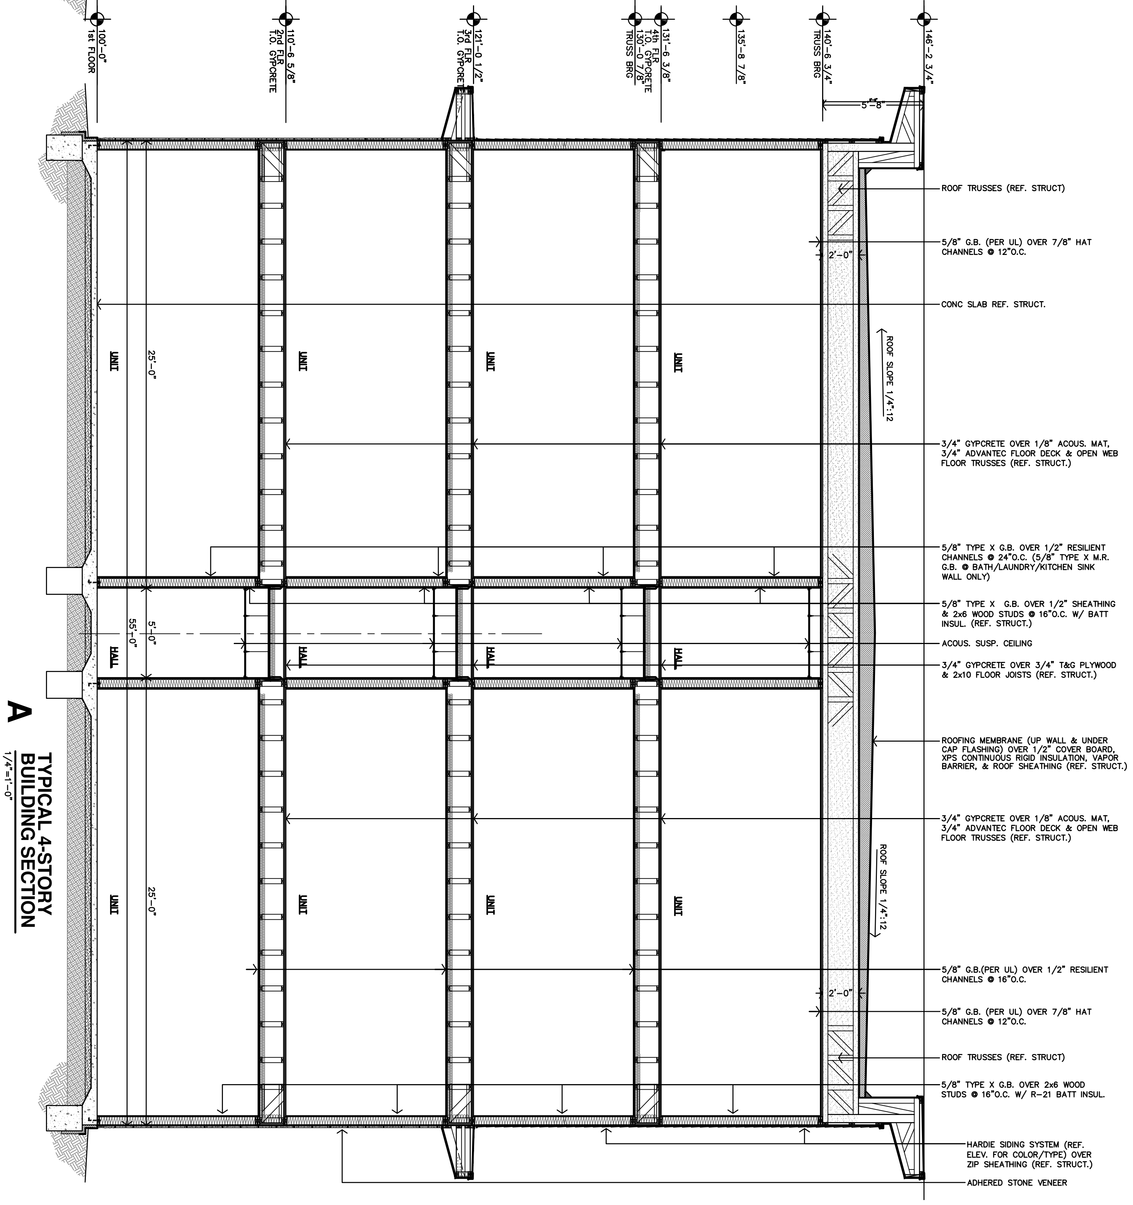

A TYPICAL 4-STORY BUILDING SECTION
1/4"=1'-0"

Wichita-Sedgewick County
Metropolitan Area Building
and Construction Department

REVIEWED FOR CODE COMPLIANCE

CORRECTIONS OR COMMENTS MADE ON THESE DRAWINGS DO NOT RELIEVE OR LESSEN THE RESPONSIBILITY OF ANY PERSON OWNING, DESIGNING OR CONSTRUCTING ANY PROJECT, FROM COMPLYING WITH ALL REQUIREMENTS OF THE CODES AND ORDINANCES OF THE CITY OF WICHITA AND SEDGWICK COUNTY. THIS REVIEW DOES NOT RELIEVE THE OWNER OR HIS RESPONSIBLE AGENT FROM COMPLIANCE WITH ALL APPLICABLE CODES AND ORDINANCES OF THE CITY OF WICHITA AND SEDGWICK COUNTY. THIS REVIEW IS LIMITED TO THE REQUIREMENTS OF THE INTERNATIONAL BUILDING CODE.

DATE: 02/19/25 BY: William Jarnutt Jr

SUBJECT TO PROVISIONS OF SECTION 107.4 OF THE 2012 INTERNATIONAL BUILDING CODE.

THE RESIDENCE AT HERITAGE WEST

NEW SENIOR-LIVING FACILITY

ANDOVER, KANSAS

JonesGillamRenz
730 N. Ninth
Salina, KS 67401
785.827.0386
1881 Main Street, Suite 301
Kansas City, MO 64108
jgr@jgrarchitects.com

CHRISTOPHER R. CLEMENT
NO. 25656
REGISTERED ARCHITECT
1/6/2025

DATE: 1-3-2025
JOB: 24-3379
SHEET NO.: **A3.3**

REVISION:

COPYRIGHTED ©

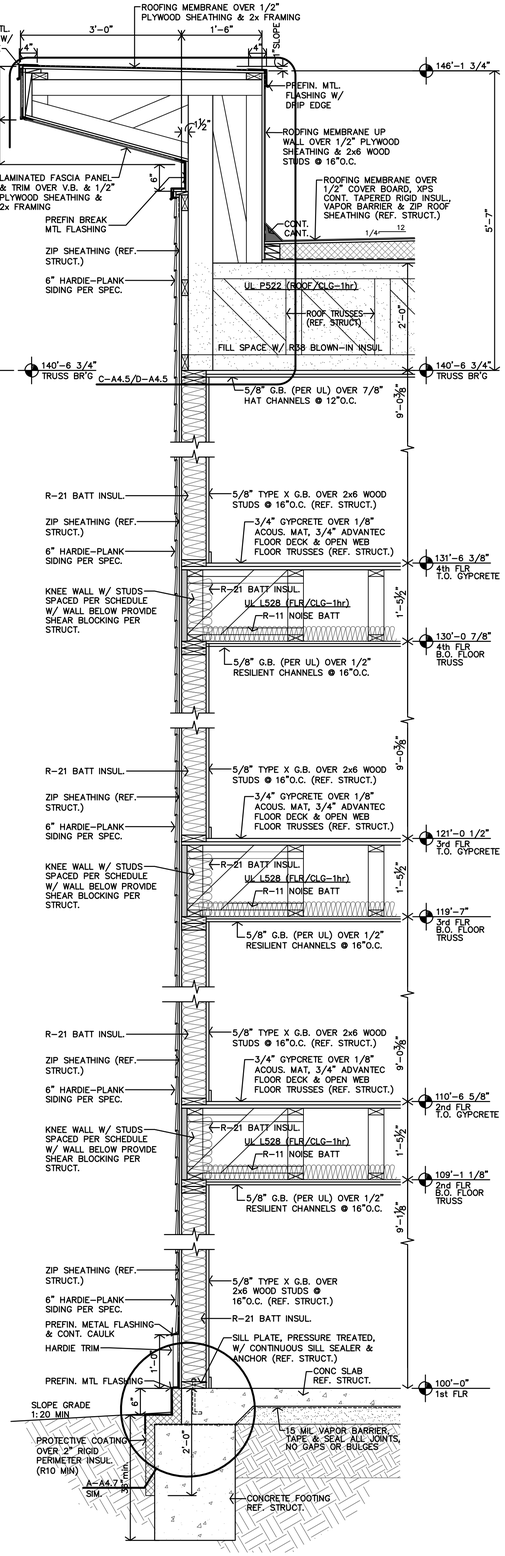

C **TYPICAL WALL SECTION**
3/4"=1'-0"

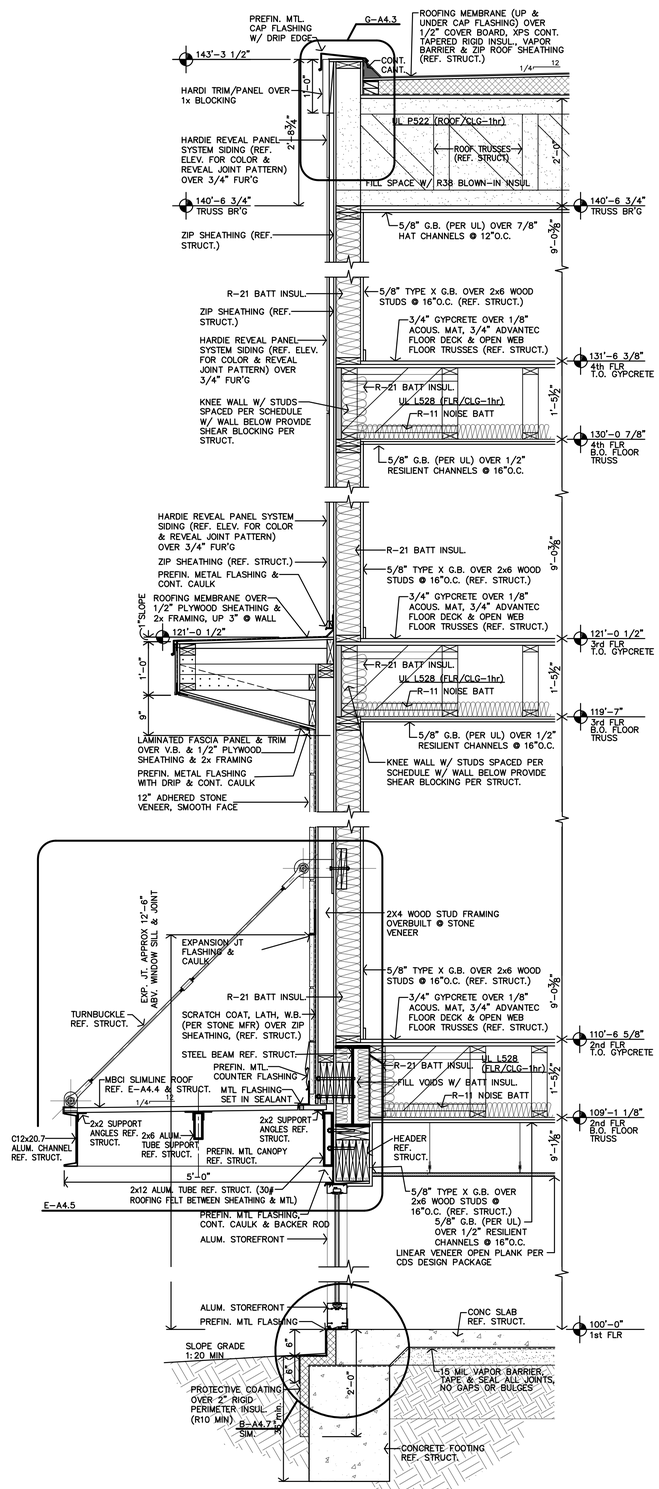

B **CENTER TYPICAL WALL SECTION**
3/4"=1'-0"

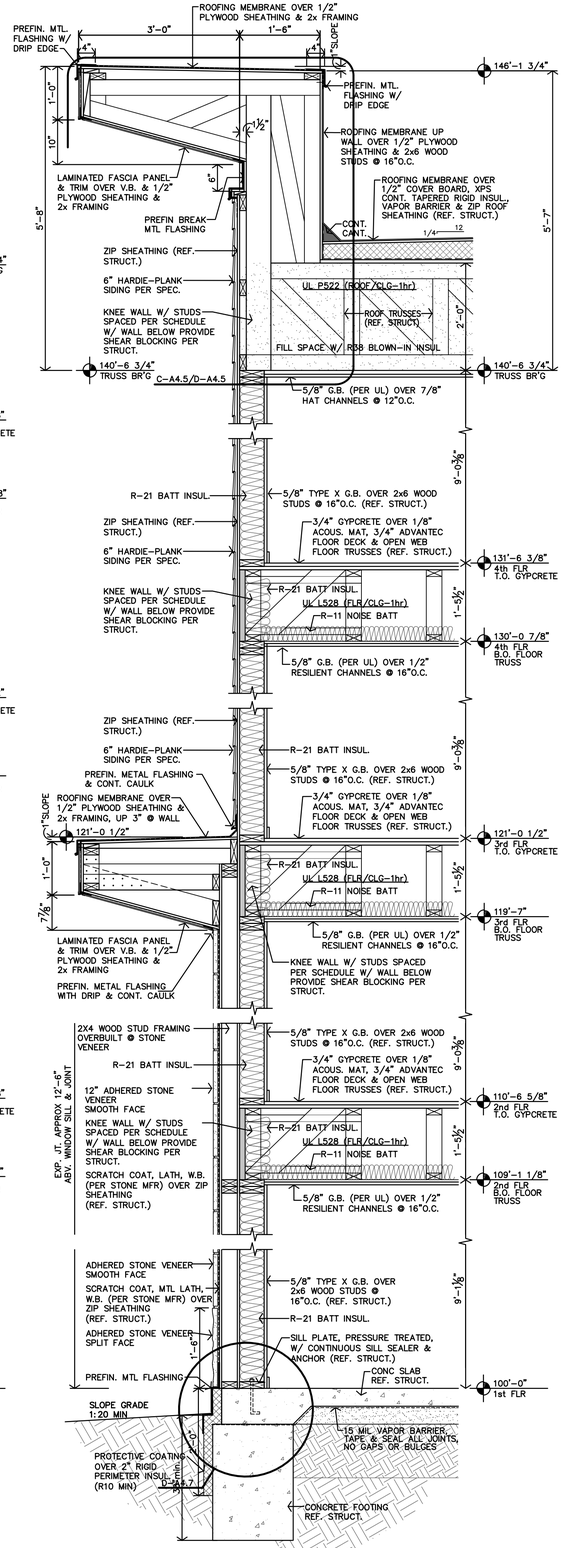

A **CENTER TYPICAL WALL SECTION**
3/4"=1'-0"

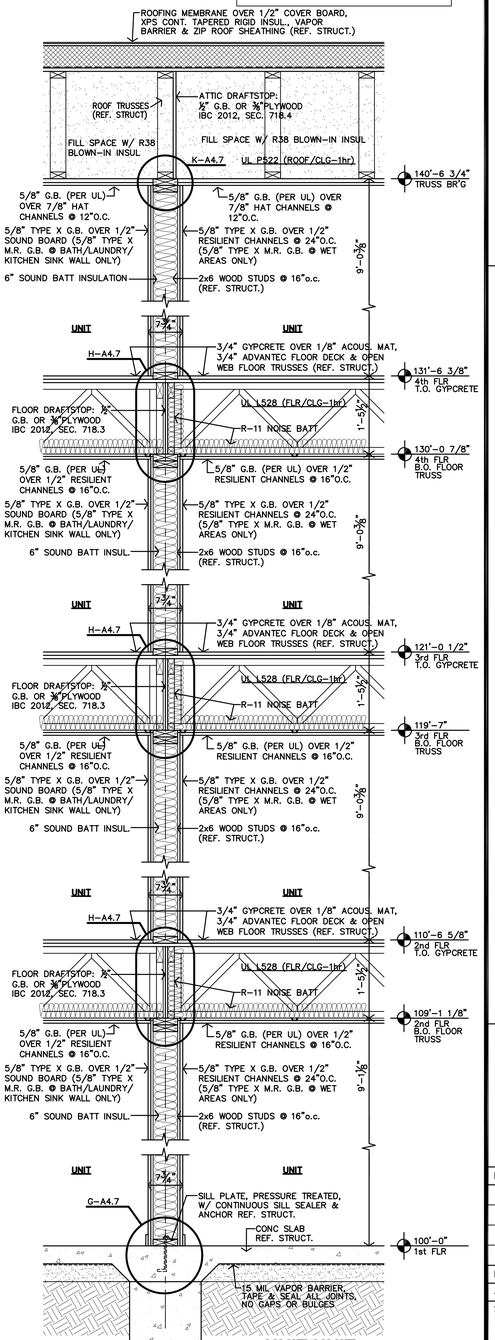

D **UNIT/UNIT WALL SECTION**
3/4"=1'-0"

Wichita-Sedgwick County Metropolitan Area Building and Construction Department

REVIEWED FOR CODE COMPLIANCE

CORRECTIONS OR COMMENTS MADE ON THESE DRAWINGS AND THIS DOCUMENT DURING THIS REVIEW DO NOT RELIEVE CONTRACTOR FROM COMPLIANCE WITH ALL REQUIREMENTS OF THE CODE OF THE MABCD, THE CITY OF WICHITA OR SEDGWICK COUNTY. THIS REVIEW IS ONLY FOR GENERAL CONFORMANCE OF THE CODE. THE CONTRACTOR IS RESPONSIBLE FOR CONFORMING AND CORRELATING ALL TECHNIQUES OF CONSTRUCTION. THIS APPROVAL IS SUBJECT TO PROVISIONS OF SECTION 107.4 OF THE 2012 INTERNATIONAL BUILDING CODE.

DATE: 02/19/25 BY: William Jerauld Jr

JonesGillamRenz
730 N. Ninth 1881 Main Street, Suite 301
Salina, KS 67401 Kansas City, MO 64108
785.827.0386 jgr@jgrarchitects.com

THE RESIDENCE AT HERITAGE WEST

NEW SENIOR-LIVING FACILITY

ANDOVER, KANSAS

CHRISTOPHER R. GILLAM LICENSED 6979 1/3/2025 KANSAS ARCHITECT

REVISION:

DATE: 1-3-2025
JOB: 24-3379
SHEET NO.:

A4.1

COPYRIGHTED ©

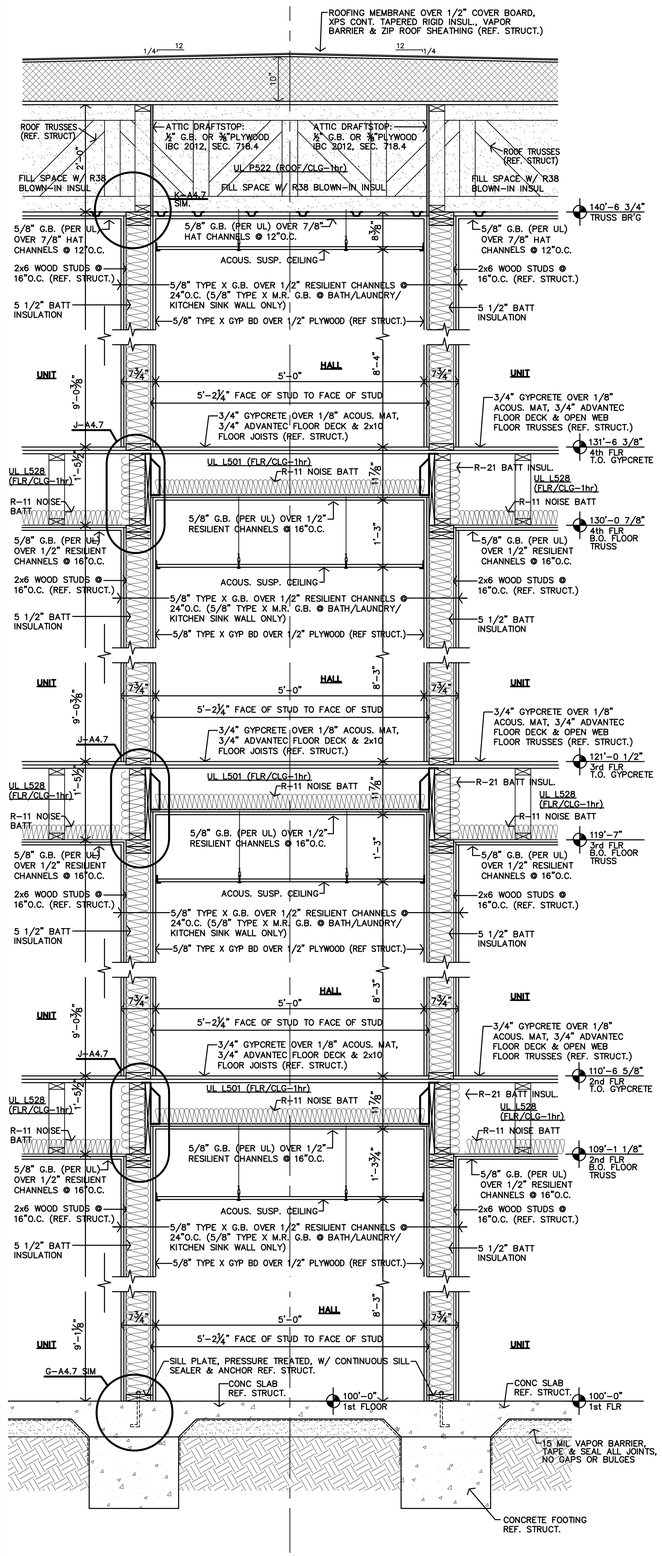

C CORRIDOR WALL SECTION
3/4"=1'-0"

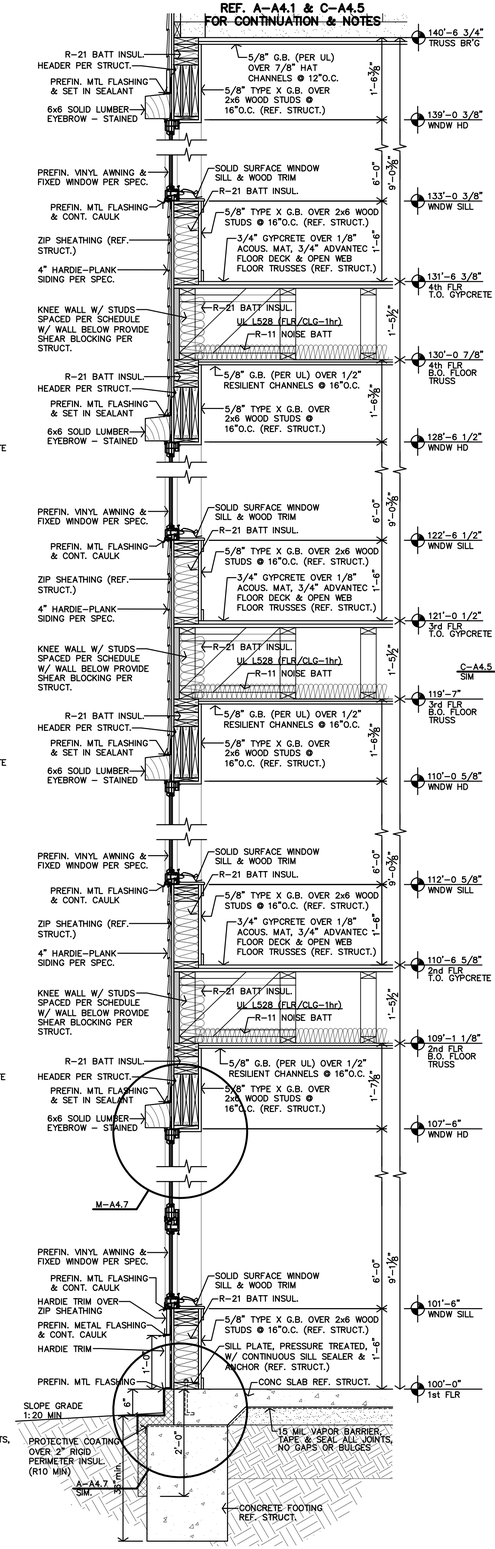

C TYPICAL WALL SECTION
3/4"=1'-0"

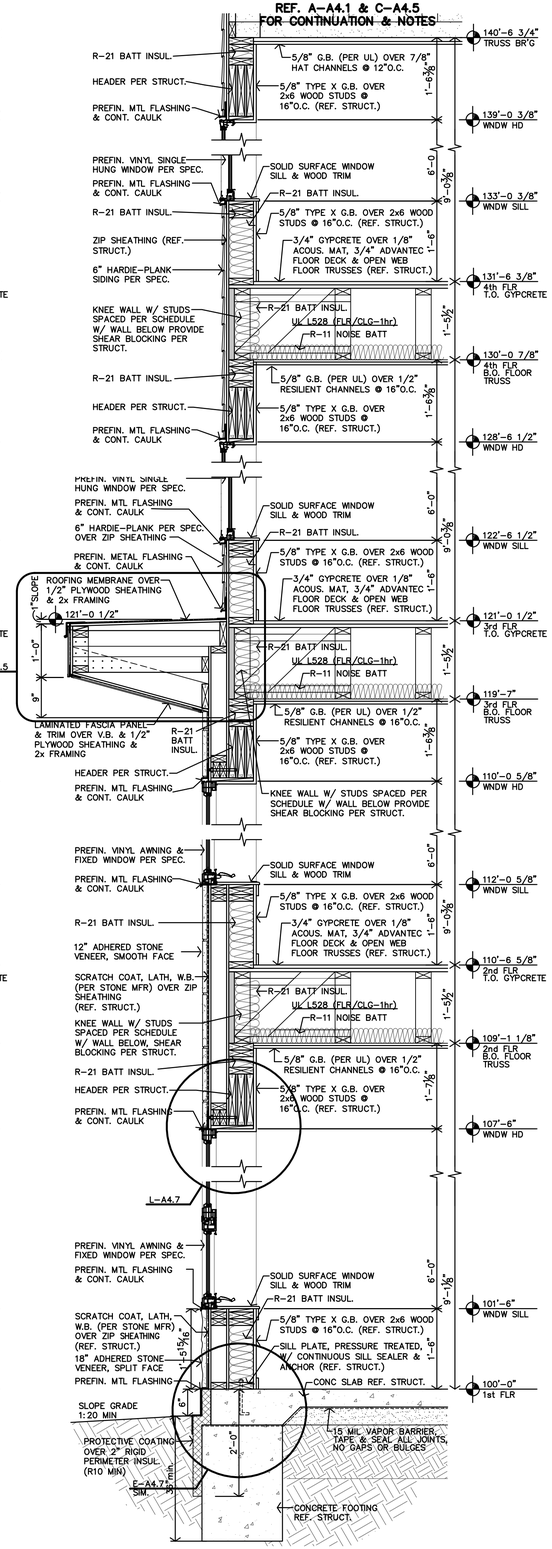

B CENTER TYPICAL WALL SECTION
3/4"=1'-0"

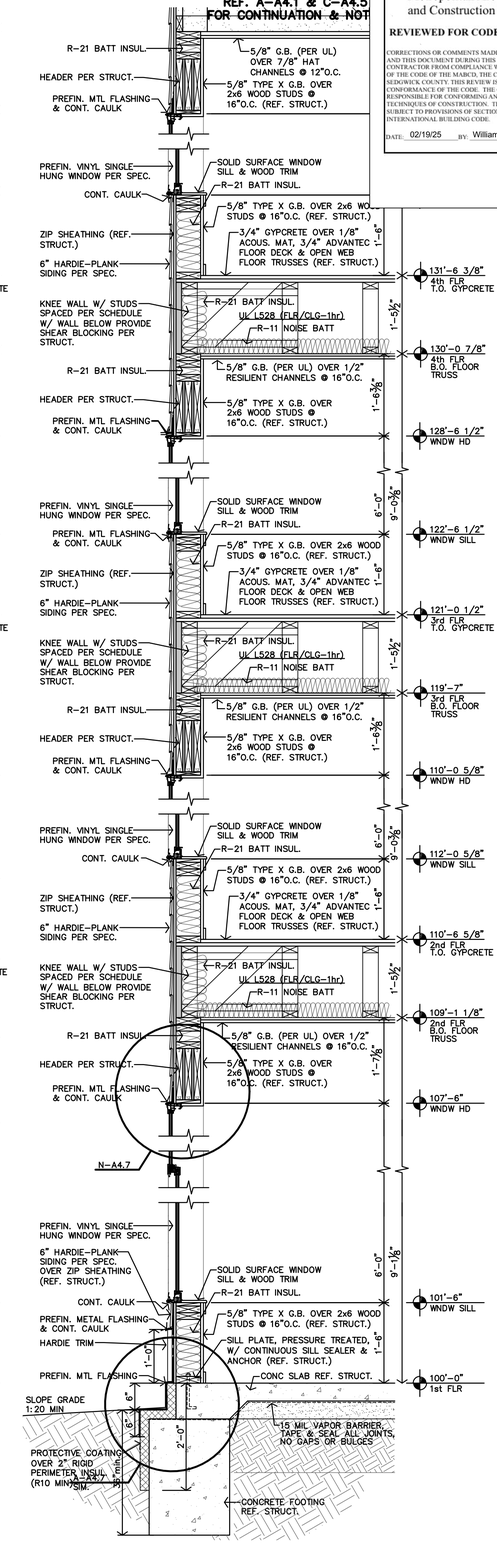

A TYPICAL WALL SECTION
3/4"=1'-0"

Wichita-Sedgwick County Metropolitan Area Building and Construction Department

REVIEWED FOR CODE COMPLIANCE

CORRECTIONS OR COMMENTS MADE ON THESE DRAWINGS AND THIS DOCUMENT DURING THIS REVIEW DO NOT RELIEVE CONTRACTOR FROM COMPLIANCE WITH ALL REQUIREMENTS OF THE CODE OF THE MARCH. THE CITY OF WICHITA OR SEDGWICK COUNTY. THIS REVIEW IS ONLY FOR GENERAL CONFORMANCE OF THE CODE. THE CONTRACTOR IS RESPONSIBLE FOR CONFORMING AND CORRELATING ALL TECHNIQUES OF CONSTRUCTION. THIS APPROVAL IS SUBJECT TO PROVISIONS OF SECTION 107.4 OF THE 2012 INTERNATIONAL BUILDING CODE.

DATE: 02/19/25 BY: William Jerauld Jr

JonesGillamRenz
730 N. Ninth 1881 Main Street, Suite 301
Salina, KS 67401 Kansas City, MO 64108
785.827.0386 jgr@jgrarchitects.com

THE RESIDENCE AT HERITAGE WEST

NEW SENIOR-LIVING FACILITY

ANDOVER, KANSAS

CHRISTOPHER R. GILLAM
6979
1/3/2025
KANSAS
ARCHITECT

REVISION:

DATE: 1-3-2025
JOB: 24-3379
SHEET NO.:

A4.2

COPYRIGHTED ©

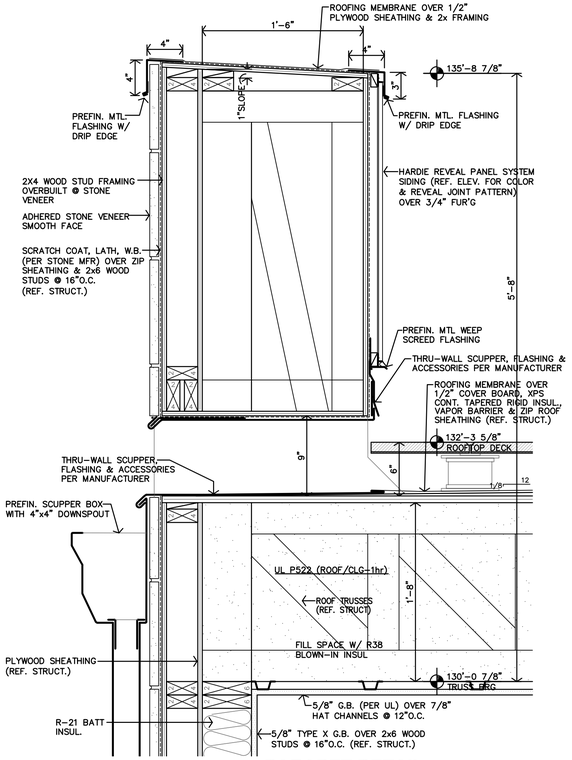

E **PARAPET DETAIL**
1 1/2"=1'-0"

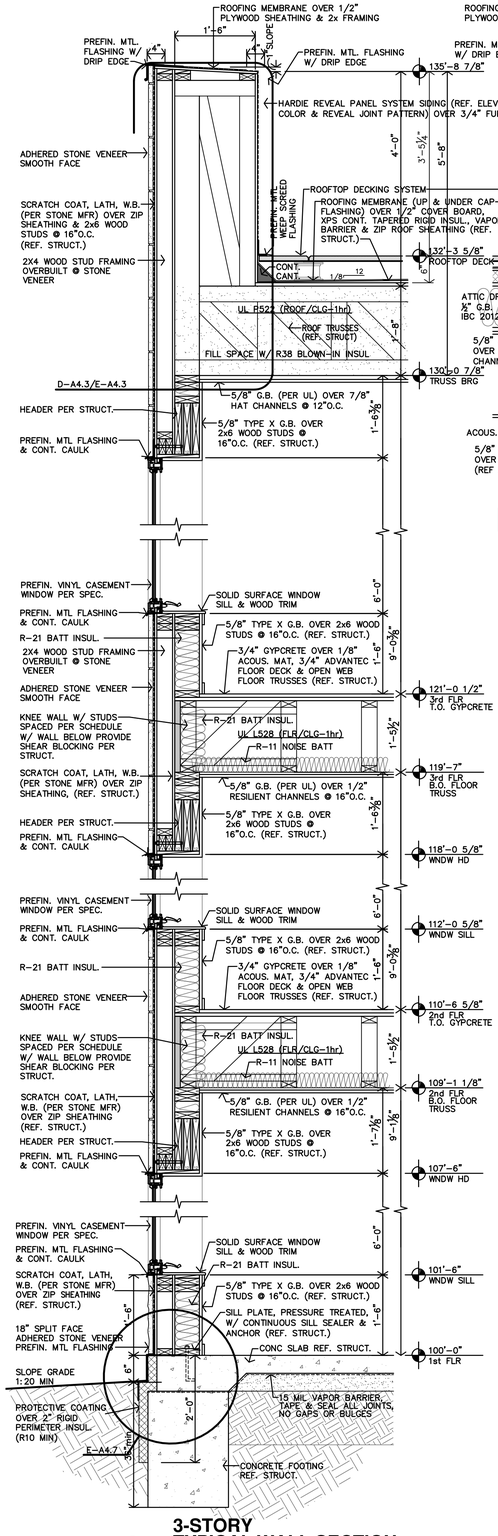

C **3-STORY TYPICAL WALL SECTION**
3/4"=1'-0"

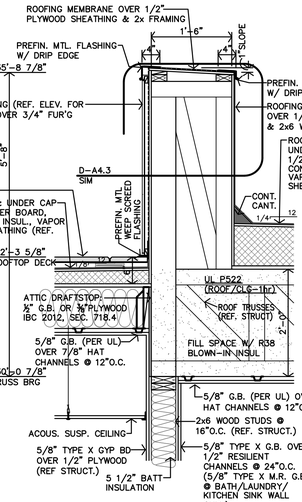

B **DETAIL**
3/4"=1'-0"

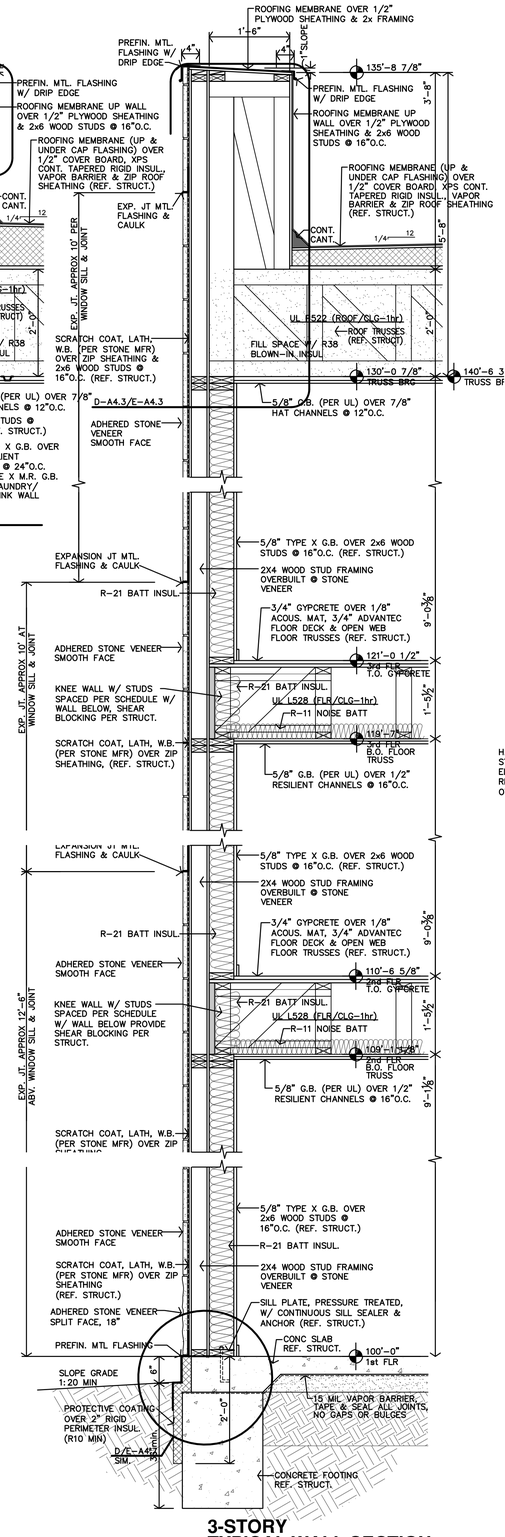

A **3-STORY TYPICAL WALL SECTION**
3/4"=1'-0"

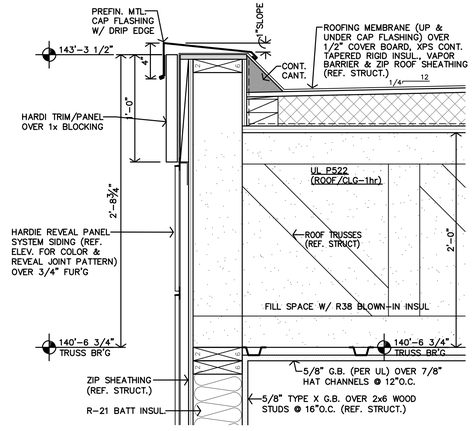

G **PARAPET DETAIL**
1 1/2"=1'-0"

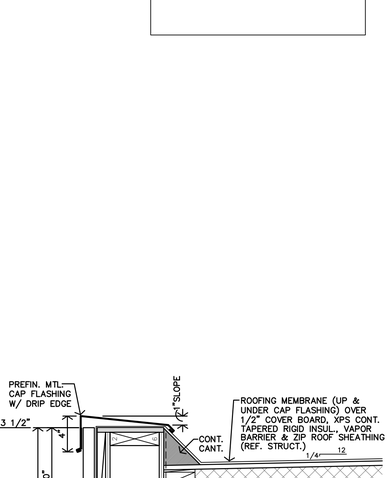

F **STONE VENEER EXPANSION JOINT DETAIL**
SIM. REFERENCE MANUFACTURER

Wichita-Sedgwick County Metropolitan Area Building and Construction Department

REVIEWED FOR CODE COMPLIANCE

CORRECTIONS OR COMMENTS MADE ON THESE DRAWINGS AND THIS DOCUMENT DURING THIS REVIEW DO NOT RELIEVE CONTRACTOR FROM COMPLIANCE WITH ALL REQUIREMENTS OF THE CODE OF THE MARCH. THE CITY OF WICHITA OR SEDGWICK COUNTY. THIS REVIEW IS ONLY FOR GENERAL CONFORMANCE OF THE CODE. THE CONTRACTOR IS RESPONSIBLE FOR CONFORMING AND CORRELATING ALL TECHNIQUES OF CONSTRUCTION. THIS APPROVAL IS SUBJECT TO PROVISIONS OF SECTION 107.4 OF THE 2012 INTERNATIONAL BUILDING CODE.

DATE: 02/19/25 BY: William Jerauld Jr

JonesGillamRenz
730 N. Ninth
Salina, KS 67401
1881 Main Street, Suite 301
Kansas City, MO 64108
785.827.0386
jgr@jgrarchitects.com

THE RESIDENCE AT HERITAGE WEST

NEW SENIOR-LIVING FACILITY

ANDOVER, KANSAS

CHRISTOPHER R. GILLAM CERTIFICATE 6979 1/3/2025 KANSAS ARCHITECT

REVISION:

DATE: 1-3-2025
JOB: 24-3379
SHEET NO.:

A4.3

COPYRIGHTED©

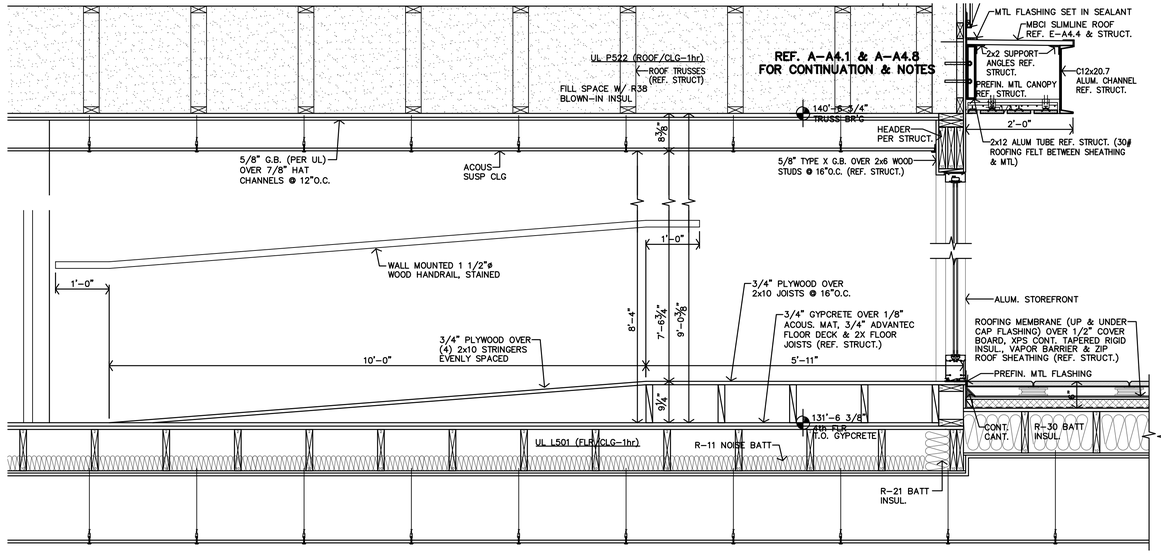

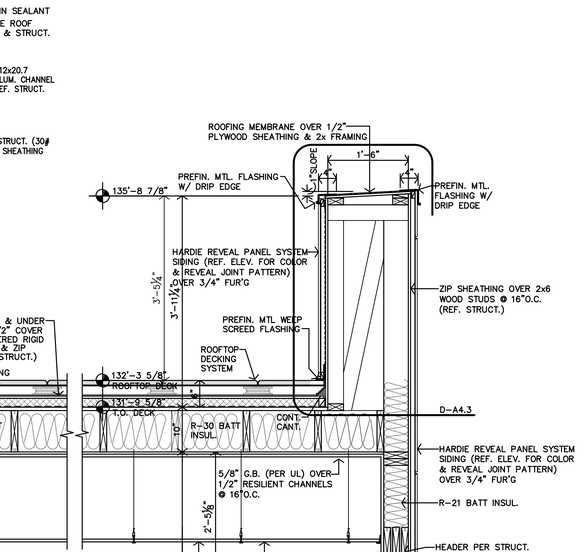

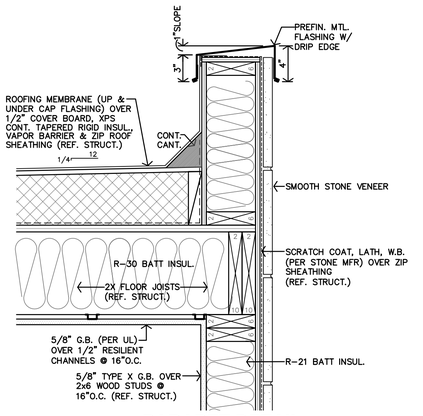

D PARAPET DETAIL
1 1/2"=1'-0"

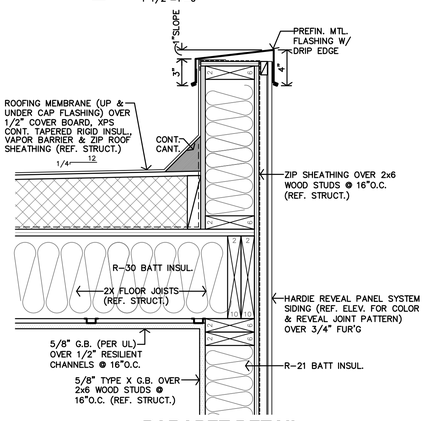

C PARAPET DETAIL
1 1/2"=1'-0"

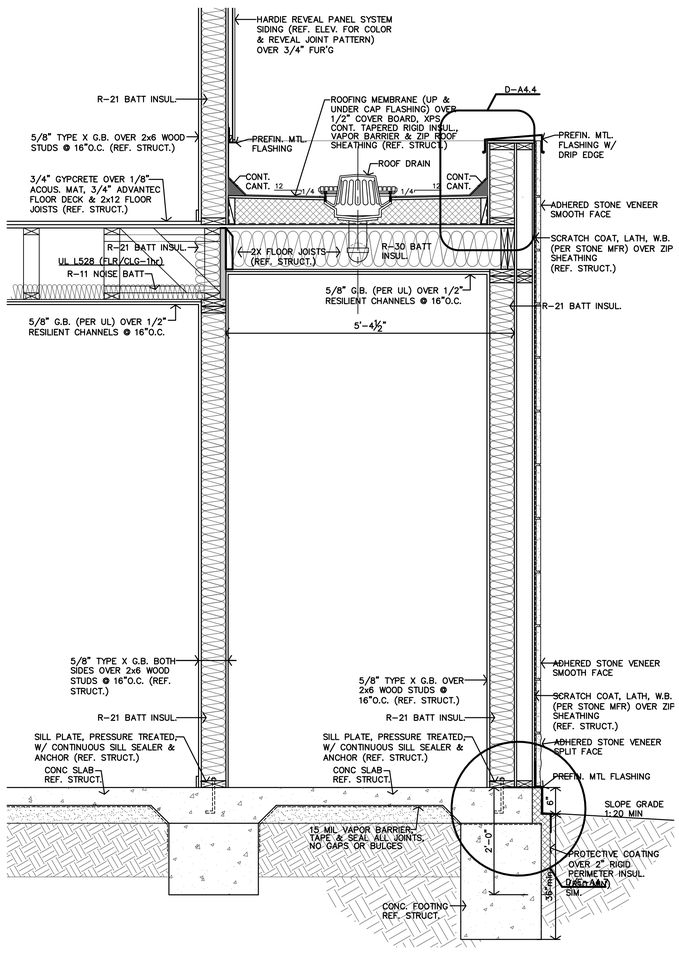

B WALL SECTION
3/4"=1'-0"

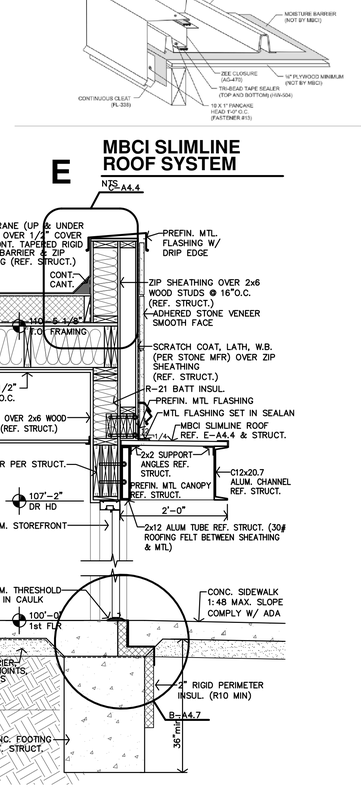

A WALL SECTION
3/4"=1'-0"

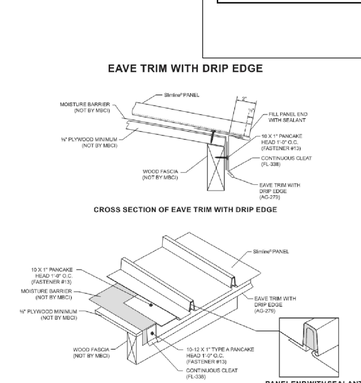

Wichita-Sedgwick County Metropolitan Area Building and Construction Department
REVIEWED FOR CODE COMPLIANCE
CORRECTIONS OR COMMENTS MADE ON THESE DRAWINGS AND THIS DOCUMENT DURING THIS REVIEW DO NOT RELIEVE CONTRACTOR FROM COMPLIANCE WITH ALL REQUIREMENTS OF THE CODE OF THE MABCD, THE CITY OF WICHITA OR SEDGWICK COUNTY. THIS REVIEW IS ONLY FOR GENERAL CONFORMANCE OF THE CODE. THE CONTRACTOR IS RESPONSIBLE FOR CONFORMING AND CORRELATING ALL TECHNIQUES OF CONSTRUCTION. THIS APPROVAL IS SUBJECT TO PROVISIONS OF SECTION 107.4 OF THE 2012 INTERNATIONAL BUILDING CODE.
DATE: 02/19/25 BY: William Jerauld Jr

JonesGillamRenz
730 N. Ninth 1881 Main Street, Suite 301
Salina, KS 67401 Kansas City, MO 64108
785.827.0386 jgr@jgrarchitects.com

THE RESIDENCE AT HERITAGE WEST
NEW SENIOR-LIVING FACILITY
ANDOVER, KANSAS

CHRISTOPHER R. GILL
REGISTERED
6979
1/3/2025
KANSAS
ARCHITECT

REVISION:

DATE: 1-3-2025
JOB: 24-3379
SHEET NO.:

A4.4

COPYRIGHTED©

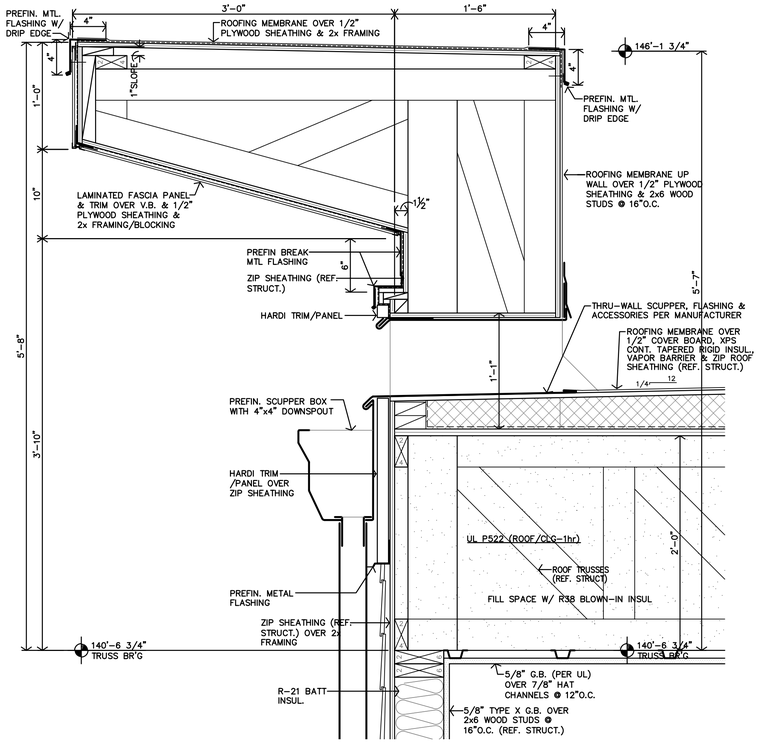

D SCUPPER BOX DETAIL

1 1/2"=1'-0"

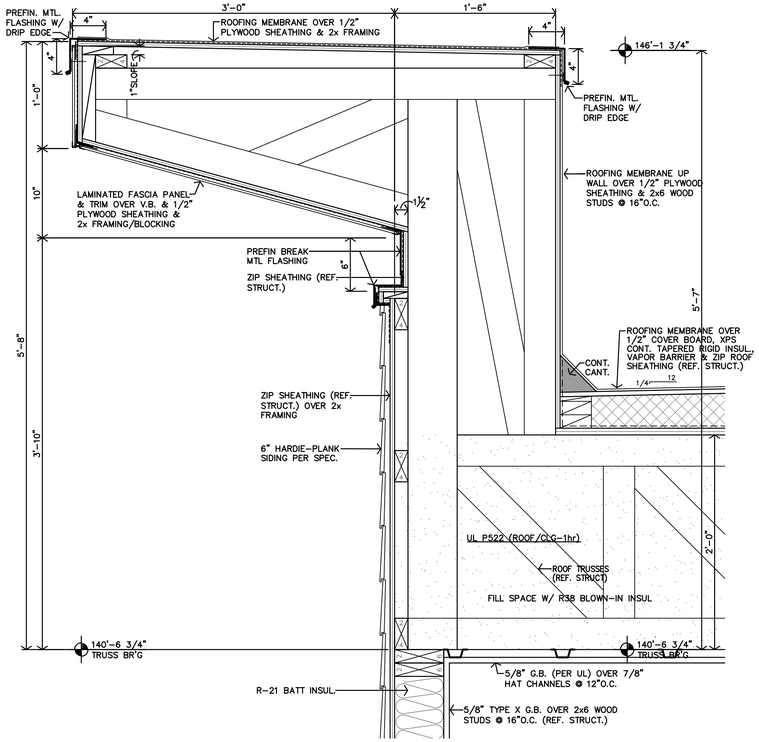

C PARAPET DETAIL

1 1/2"=1'-0"

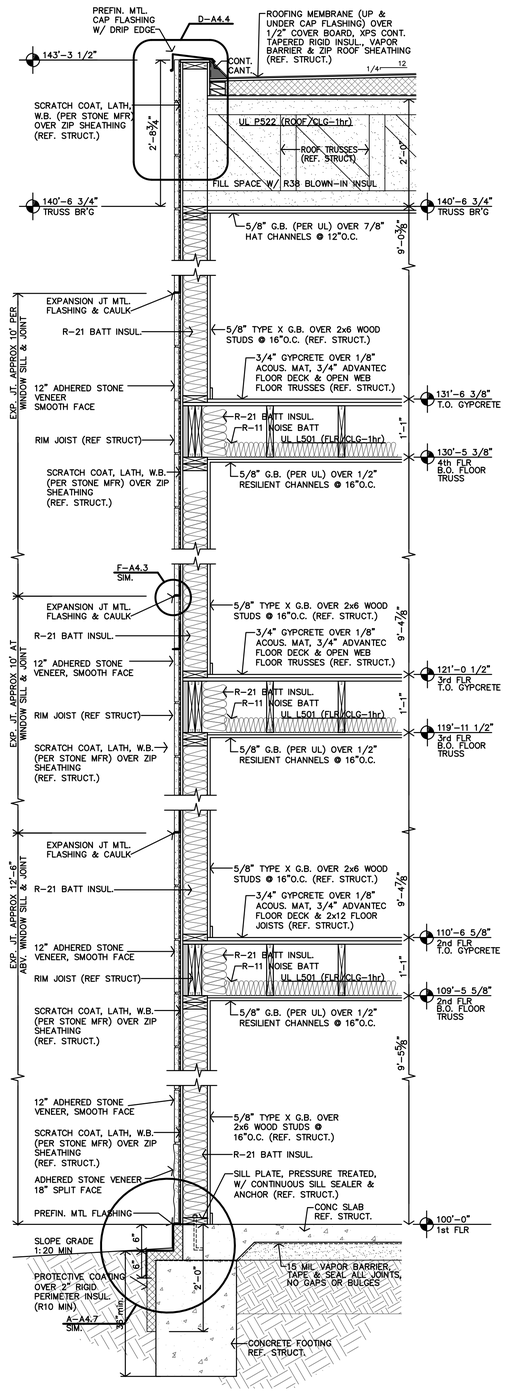

B TYPICAL WALL SECTION

3/4"=1'-0"

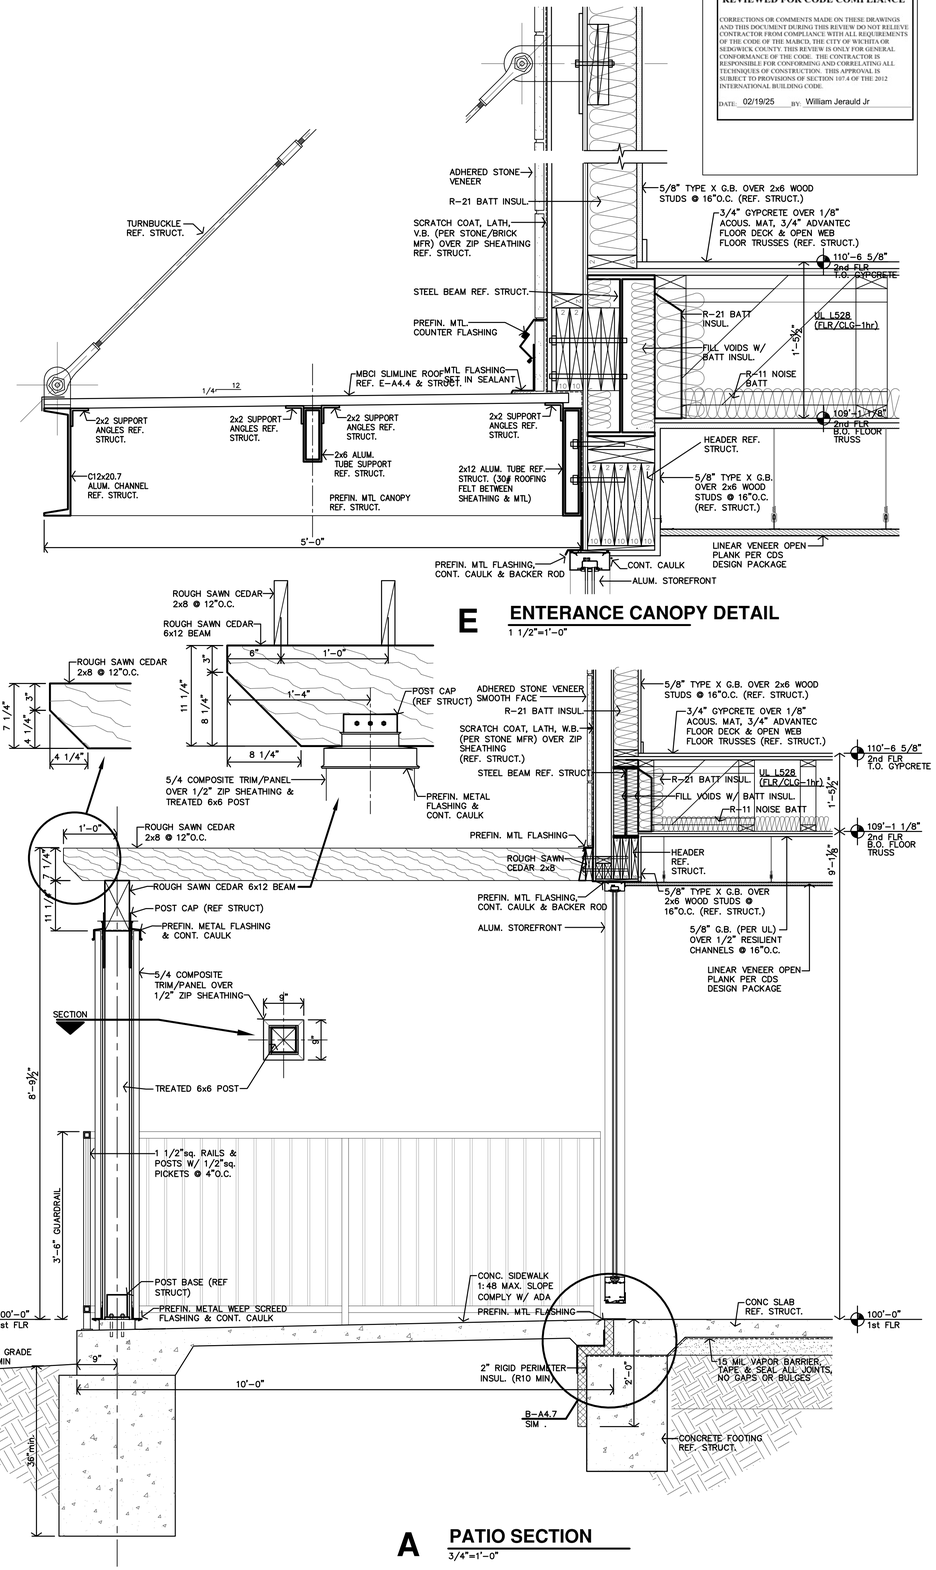

E ENTERANCE CANOPY DETAIL

1 1/2"=1'-0"

A PATIO SECTION

3/4"=1'-0"

Wichita-Sedgwick County
Metropolitan Area Building
and Construction Department

REVIEWED FOR CODE COMPLIANCE

CORRECTIONS OR COMMENTS MADE ON THESE DRAWINGS AND THIS DOCUMENT DURING THIS REVIEW DO NOT RELIEVE CONTRACTOR FROM COMPLIANCE WITH ALL REQUIREMENTS OF THE CODE OF THE MABCD, THE CITY OF WICHITA OR SEDGWICK COUNTY. THIS REVIEW IS ONLY FOR GENERAL CONFORMANCE OF THE CODE. THE CONTRACTOR IS RESPONSIBLE FOR CONFORMING AND CORRELATING ALL TECHNIQUES OF CONSTRUCTION. THIS APPROVAL IS SUBJECT TO PROVISIONS OF SECTION 107.4 OF THE 2012 INTERNATIONAL BUILDING CODE.

DATE: 02/19/25 BY: William Jerauld Jr

JonesGillamRenz
730 N. Ninth
Salina, KS 67401
1881 Main Street, Suite 301
Kansas City, MO 64108
785.827.0386
jgr@jgrarchitects.com

THE RESIDENCE AT HERITAGE WEST

NEW SENIOR-LIVING FACILITY

ANDOVER, KANSAS

CHRISTOPHER R. GILLAM
REGISTERED
6979
1/3/2025
KANSAS
ARCHITECT

REVISION:

DATE: 1-3-2025
JOB: 24-3379
SHEET NO.:

A4.5

COPYRIGHTED©

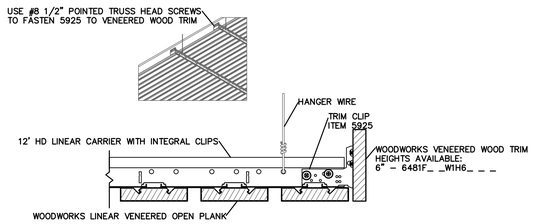

P **CEILING DETAIL**
3"=1'–0"

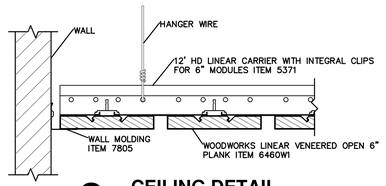

O **CEILING DETAIL**
3"=1'–0"

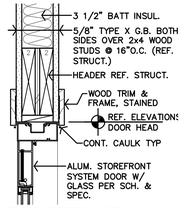

N **ALUM STOREFRONT DOOR HEAD @ INTERIOR**
1 1/2"=1'–0" JAMB SIMILAR

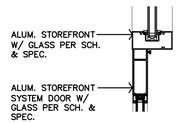

M **ALUM STOREFRONT DOOR HEAD @ MULLION**
1 1/2"=1'–0" JAMB SIMILAR

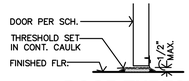

L **DOOR THRESHOLD DTL.**
1 1/2"=1'–0"

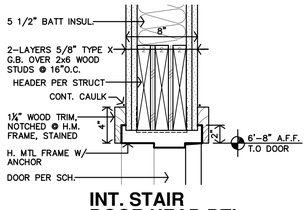

K **INT. STAIR DOOR HEAD DTL.**
1 1/2"=1'–0"

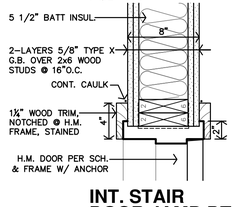

J **INT. STAIR DOOR JAMB DTL.**
1 1/2"=1'–0"

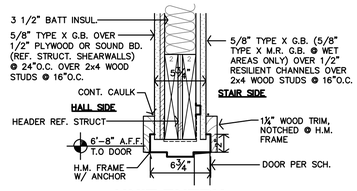

H **UNIT ENTRY DOOR HEAD DTL.**
1 1/2"=1'–0"

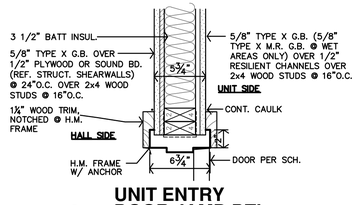

G **UNIT ENTRY DOOR JAMB DTL.**
1 1/2"=1'–0"

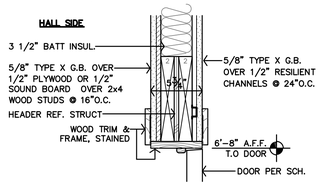

F **HALLWAY WALL DOOR HEAD DTL.**
1 1/2"=1'–0"

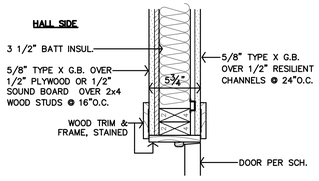

E **HALLWAY WALL DOOR JAMB DTL.**
1 1/2"=1'–0"

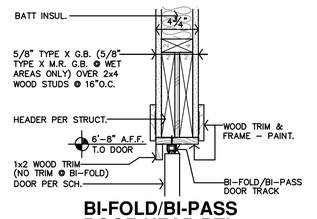

D **BI-FOLD/BI-PASS DOOR HEAD DTL.**
1 1/2"=1'–0"

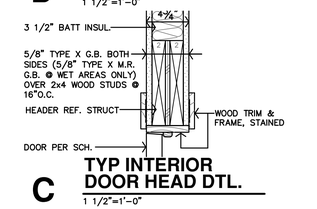

C **TYP INTERIOR DOOR HEAD DTL.**
1 1/2"=1'–0"

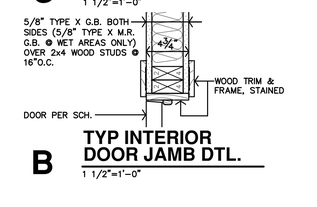

B **TYP INTERIOR DOOR JAMB DTL.**
1 1/2"=1'–0"

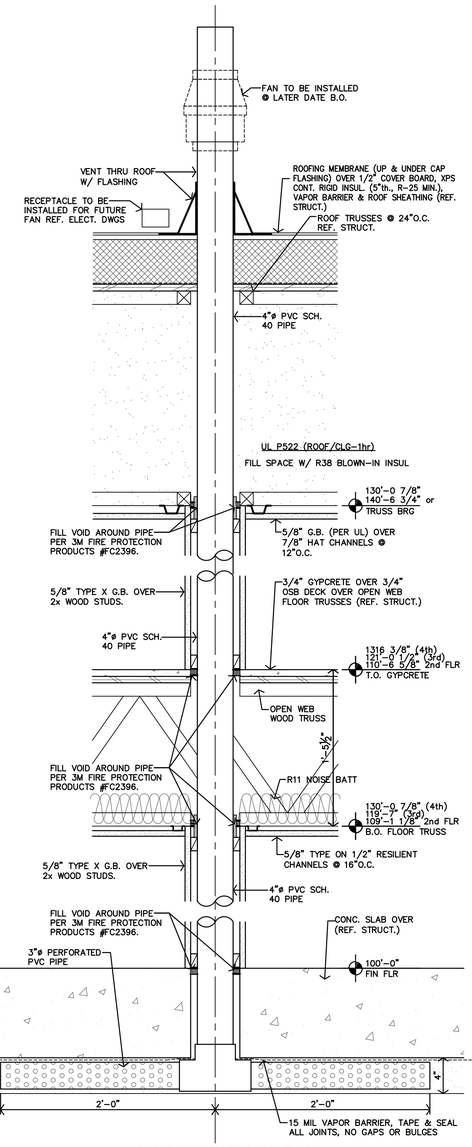

A **RADON PIPE DETAIL**
1 1/2"=1'–0"

Wichita-Sedgwick County
Metropolitan Area Building
and Construction Department

REVIEWED FOR CODE COMPLIANCE

CORRECTIONS OR COMMENTS MADE ON THESE DRAWINGS AND THIS DOCUMENT DURING THIS REVIEW DO NOT RELIEVE CONTRACTOR FROM COMPLIANCE WITH ALL REQUIREMENTS OF THE CODE OF THE MABCD, THE CITY OF WICHITA OR SEDGWICK COUNTY. THIS REVIEW IS ONLY FOR GENERAL CONFORMANCE OF THE CODE. THE CONTRACTOR IS RESPONSIBLE FOR CONFORMING AND CORRELATING ALL TECHNIQUES OF CONSTRUCTION. THIS APPROVAL IS SUBJECT TO PROVISIONS OF SECTION 107.4 OF THE 2012 INTERNATIONAL BUILDING CODE.

DATE: 02/19/25 BY: William Jerauld Jr

JonesGillamRenz
730 N. Ninth 1881 Main Street, Suite 301
Salina, KS 67401 Kansas City, MO 64108
785.827.0386 jgr@jgrarchitects.com

THE RESIDENCE AT HERITAGE WEST

NEW SENIOR-LIVING FACILITY

ANDOVER, KANSAS

CHRISTOPHER R. GILLAM
REGISTERED ARCHITECT
6979
1/3/2025
KANSAS
ARCHITECT

REVISION:

DATE: 1–3–2025
JOB: 24–3379
SHEET NO.:

A4.6

COPYRIGHTED©

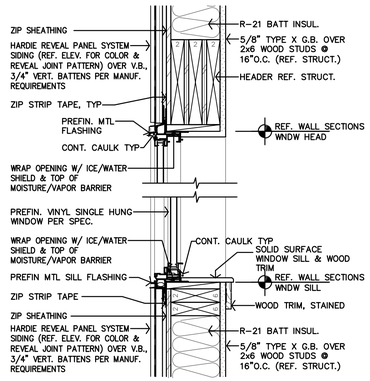

O **SINGLE HUNG -REVEAL PANEL WINDOW HD & SILL**

1 1/2"=1'-0" JAMB SIMILAR

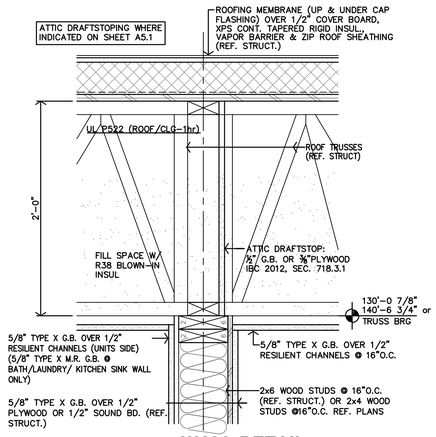

K **WALL DETAIL**

1 1/2"=1'-0"

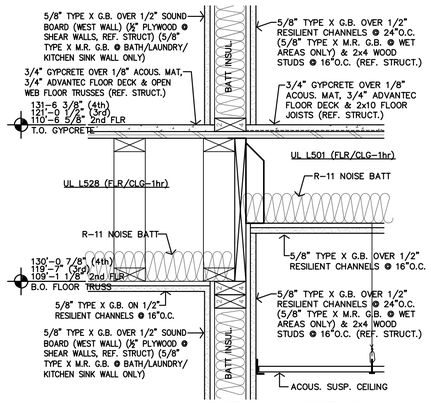

J **UNIT/HALL DETAIL**

1 1/2"=1'-0"

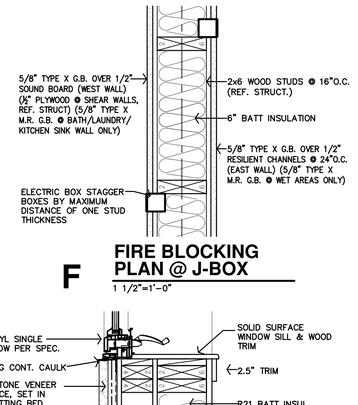

H **UNIT/UNIT DETAIL**

1 1/2"=1'-0"

G **UNIT/UNIT DETAIL**

1 1/2"=1'-0"

F **FIRE BLOCKING PLAN @ J-BOX**

1 1/2"=1'-0"

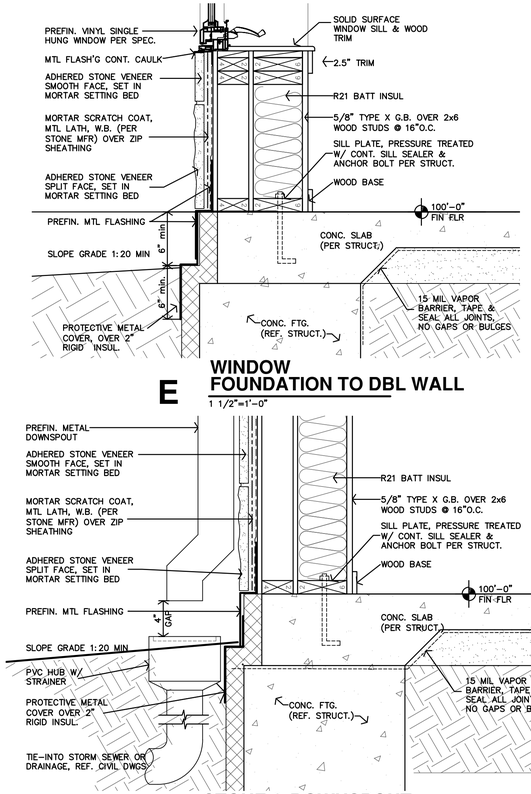

E **WINDOW FOUNDATION TO DBL WALL**

1 1/2"=1'-0"

D **STONE & DOWNSPOUT FOUNDATION TO DBL WALL**

1 1/2"=1'-0"

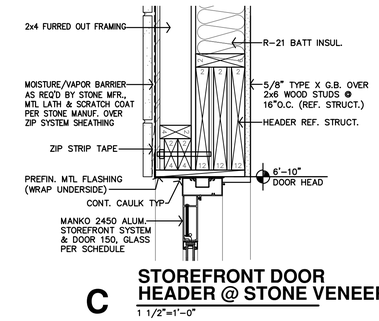

C **STOREFRONT DOOR HEADER @ STONE VENEER**

1 1/2"=1'-0"

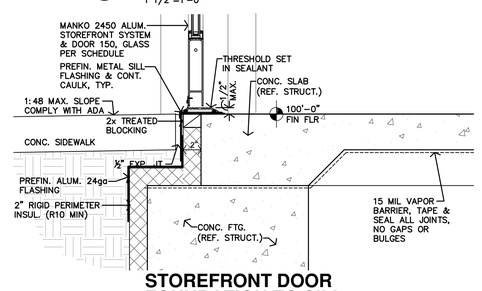

B **STOREFRONT DOOR FOUNDATION TO SILL**

1 1/2"=1'-0"

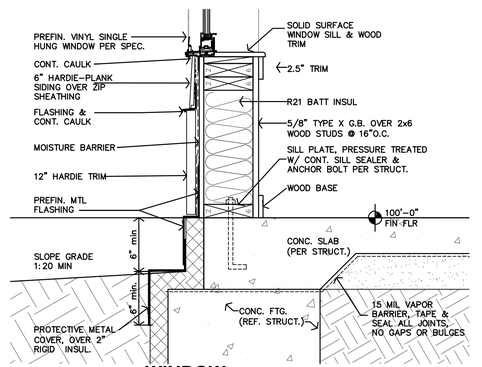

A **WINDOW FOUNDATION TO WALL**

1 1/2"=1'-0"

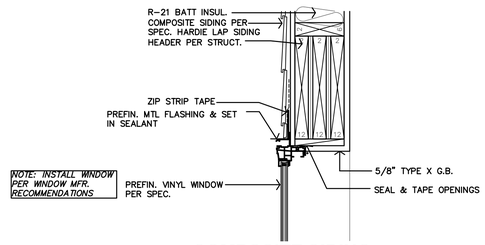

N **COMPOSITE SIDING WINDOW HEAD DETAIL**

1 1/2"=1'-0"

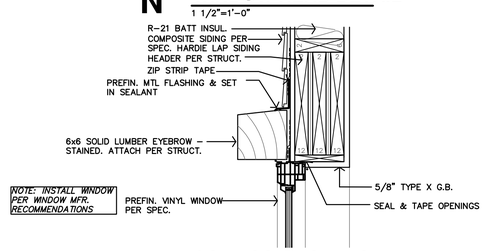

M **COMPOSITE SIDING WINDOW HEAD DETAIL**

1 1/2"=1'-0"

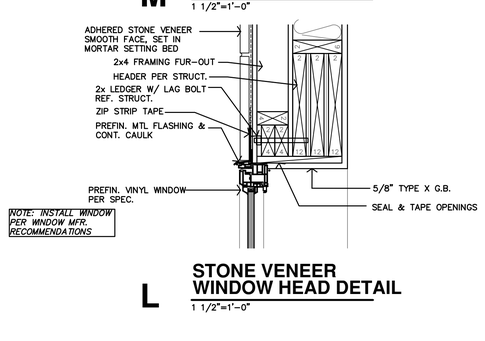

L **STONE VENEER WINDOW HEAD DETAIL**

1 1/2"=1'-0"

Wichita-Sedgwick County Metropolitan Area Building and Construction Department

REVIEWED FOR CODE COMPLIANCE

CORRECTIONS OR COMMENTS MADE ON THESE DRAWINGS AND THIS DOCUMENT DURING THIS REVIEW DO NOT RELIEVE CONTRACTOR FROM COMPLIANCE WITH ALL REQUIREMENTS OF THE CODE OF THE MABCD, THE CITY OF WICHITA OR SEDGWICK COUNTY. THIS REVIEW IS ONLY FOR GENERAL CONFORMANCE OF THE CODE. THE CONTRACTOR IS RESPONSIBLE FOR CONFORMING AND CORRELATING ALL TECHNIQUES OF CONSTRUCTION. THIS APPROVAL IS SUBJECT TO PROVISIONS OF SECTION 107.4 OF THE 2012 INTERNATIONAL BUILDING CODE.

DATE: 02/19/25 BY: William Jerauld Jr

JonesGillamRenz
730 N. Ninth 1881 Main Street, Suite 301
Salina, KS 67401 Kansas City, MO 64108
785.827.0386 jgr@jgrarchitects.com

THE RESIDENCE AT HERITAGE WEST

NEW SENIOR-LIVING FACILITY

ANDOVER, KANSAS

CHRISTOPHER R. GILLAM — LICENSED — 6979 — 1/3/2025 — KANSAS — ARCHITECT

REVISION:

DATE: 1-3-2025

JOB: 24-3379

SHEET NO.:

A4.7

COPYRIGHTED©

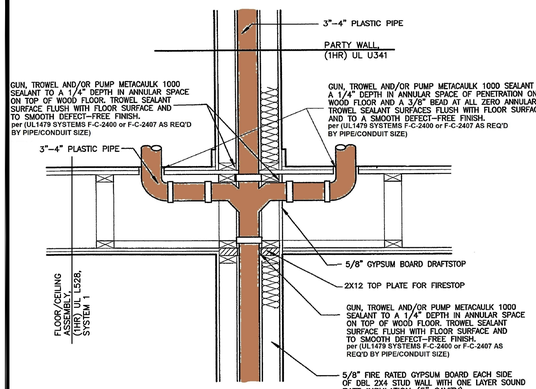

PENETRATION ASSEMBLY #1

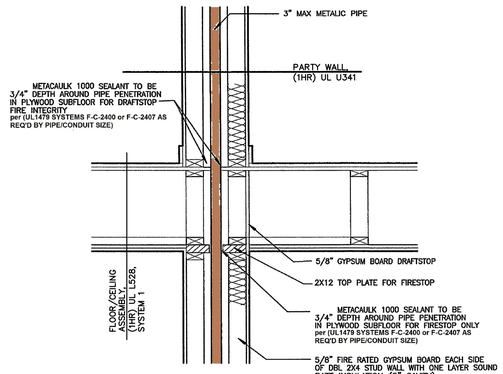

PENETRATION ASSEMBLY #2

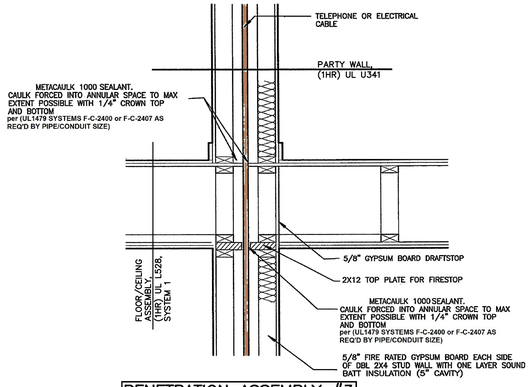

PENETRATION ASSEMBLY #3

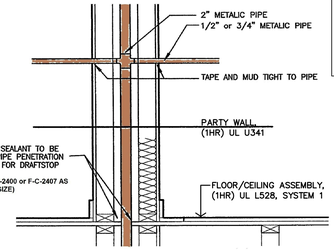

PENETRATION ASSEMBLY #4

ASSEMBLIES SHOWN FOR FIRE PENETRATION REQUIREMENTS & SEALING DETAILS/SOLUTIONS ONLY. REFER TO ARCH & MEP PLAN SHEETS FOR LOCATION OF ALL PLUMBING. NOTE LOCATIONS OF ALL PLUMBING WALLS ON PLANS. PLUMBING TO BE ROUTED PER MEP SHEETS.

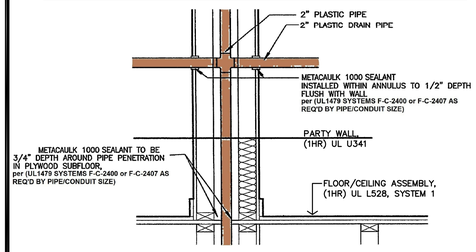

PENETRATION ASSEMBLY #5

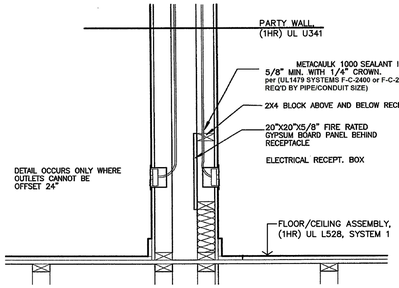

PENETRATION ASSEMBLY #6

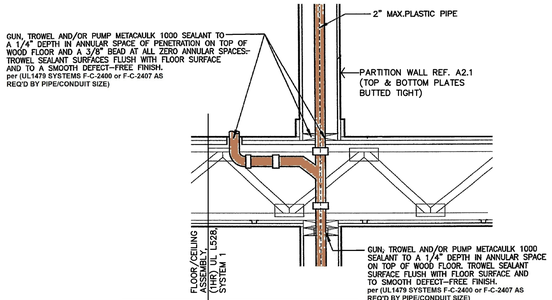

PENETRATION ASSEMBLY #7

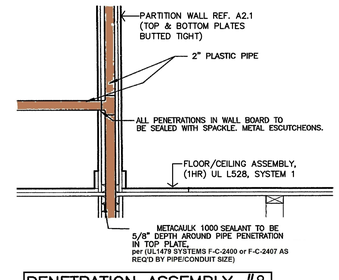

PENETRATION ASSEMBLY #8

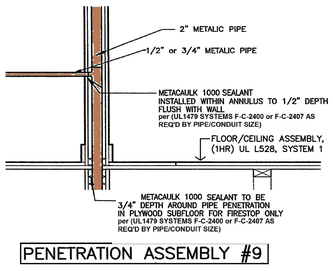

PENETRATION ASSEMBLY #9

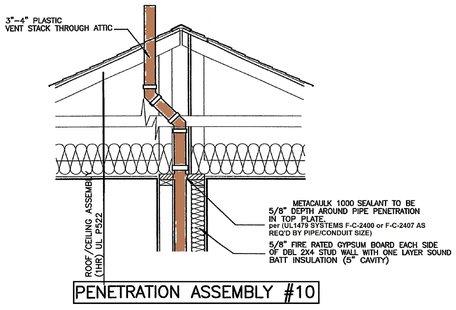

PENETRATION ASSEMBLY #10

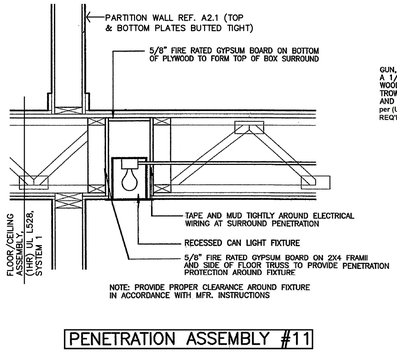

PENETRATION ASSEMBLY #11

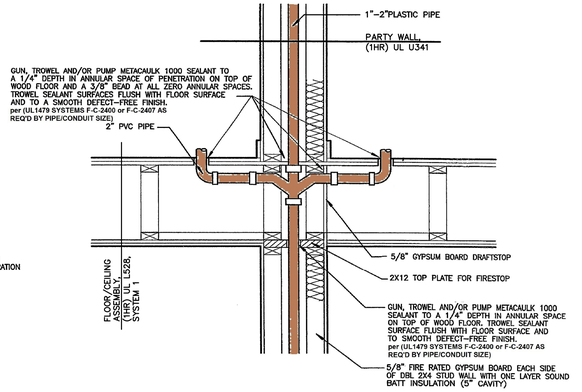

PENETRATION ASSEMBLY #12

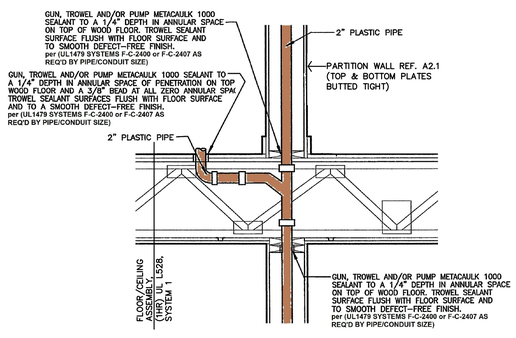

PENETRATION ASSEMBLY #13

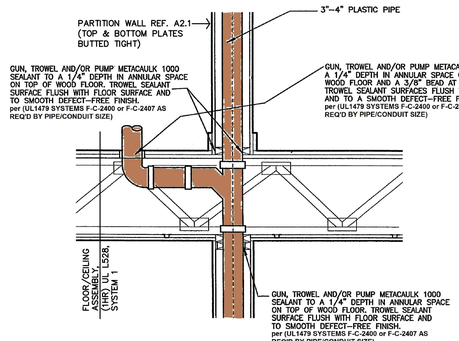

PENETRATION ASSEMBLY #14

FIRE PENETRATION ASSEMBLIES

NOT TO SCALE

ASSEMBLIES SHOWN FOR FIRE PENETRATION REQUIREMENTS & SEALING DETAILS/SOLUTIONS ONLY. REFER TO ARCH & MEP PLAN SHEETS FOR LOCATION OF ALL PLUMBING. NOTE LOCATIONS OF ALL PLUMBING WALLS ON PLANS. PLUMBING TO BE ROUTED PER MEP SHEETS.

Wichita-Sedgwick County Metropolitan Area Building and Construction Department

REVIEWED FOR CODE COMPLIANCE

CORRECTIONS OR COMMENTS MADE ON THESE DRAWINGS AND THIS DOCUMENT DURING THIS REVIEW DO NOT RELIEVE CONTRACTOR FROM COMPLIANCE WITH ALL REQUIREMENTS OF THE CODE OF THE MABCD, THE CITY OF WICHITA OR SEDGWICK COUNTY. THIS REVIEW IS ONLY FOR GENERAL CONFORMANCE OF THE CODE. THE CONTRACTOR IS RESPONSIBLE FOR CONFORMING AND CORRELATING ALL TECHNIQUES OF CONSTRUCTION. THIS APPROVAL IS SUBJECT TO PROVISIONS OF SECTION 107.4 OF THE 2012 INTERNATIONAL BUILDING CODE.

DATE: 02/19/25 BY: William Jerauld Jr

JonesGillamRenz
730 N. Ninth 1881 Main Street, Suite 301
Salina, KS 67401 Kansas City, MO 64108
785.827.0386 jgr@jgrarchitects.com

THE RESIDENCE AT HERITAGE WEST

NEW SENIOR-LIVING FACILITY

ANDOVER, KANSAS

CHRISTOPHER R. GILLAM LICENSED 6979 1/3/2025 KANSAS ARCHITECT

REVISION:	
DATE:	1–3–2025
JOB:	24–3379
SHEET NO.:	

A4.8

COPYRIGHTED ©

TABLE R402.4.1.1 AIR BARRIER AND INSULATION INSTALLATION[a]

COMPONENT	AIR BARRIER CRITERIA	INSULATION INSTALLATION CRITERIA
General requirements	A continuous air barrier shall be installed in the building envelope. The exterior thermal envelope contains a continuous air barrier. Breaks or joints in the air barrier shall be sealed.	Air-permeable insulation shall not be used as a sealing material.
Ceiling/attic	The air barrier in any dropped ceiling or soffit shall be aligned with the insulation and any gaps in the air barrier shall be sealed. Access openings, drop down stairs or knee wall doors to unconditioned attic spaces shall be sealed.	The insulation in any dropped ceiling/soffit shall be aligned with the air barrier.
Walls	The junction of the foundation and sill plate shall be sealed. The junction of the top plate and the top of exterior walls shall be sealed. Knee walls shall be sealed.	Cavities within corners and headers of frame walls shall be insulated by completely filling the cavity with a material having a thermal resistance, *R*-value, of not less than R-3 per inch. Exterior thermal envelope insulation for framed walls shall be installed in substantial contact and continuous alignment with the air barrier.
Windows, skylights and doors	The space between framing and skylights, and the jambs of windows and doors, shall be sealed.	—
Rim joists	Rim joists shall include the air barrier.	Rim joists shall be insulated.
Floors, including cantilevered floors and floors above garages	The air barrier shall be installed at any exposed edge of insulation.	Floor framing cavity insulation shall be installed to maintain permanent contact with the underside of subfloor decking. Alternatively, floor framing cavity insulation shall be in contact with the top side of sheathing, or continuous insulation installed on the underside of floor framing; and shall extend from the bottom to the top of all perimeter floor framing members.
Crawl space walls	Exposed earth in unvented crawl spaces shall be covered with a Class I vapor retarder with overlapping joints taped.	Crawl space insulation, where provided instead of floor insulation, shall be permanently attached to the walls.
Shafts, penetrations	Duct shafts, utility penetrations, and flue shafts opening to exterior or unconditioned space shall be sealed.	—
Narrow cavities	—	Batts to be installed in narrow cavities shall be cut to fit or narrow cavities shall be filled with insulation that on installation readily conforms to the available cavity space.
Garage separation	Air sealing shall be provided between the garage and conditioned spaces.	—
Recessed lighting	Recessed light fixtures installed in the building thermal envelope shall be sealed to the finished surface.	Recessed light fixtures installed in the building thermal envelope shall be air tight and IC rated.
Plumbing and wiring	—	In exterior walls, batt insulation shall be cut neatly to fit around wiring and plumbing, or insulation, that on installation readily conforms to available space, shall extend behind piping and wiring.
Shower/tub on exterior wall	The air barrier installed at exterior walls adjacent to showers and tubs shall separate the wall from the shower or tub.	Exterior walls adjacent to showers and tubs shall be insulated.
Electrical/phone box on exterior walls	The air barrier shall be installed behind electrical and communication boxes. Alternatively, air-sealed boxes shall be installed.	—
HVAC register boots	HVAC supply and return register boots that penetrate building thermal envelope shall be sealed to the subfloor, wall covering or ceiling penetrated by the boot.	—
Concealed sprinklers	Where required to be sealed, concealed fire sprinklers shall only be sealed in a manner that is recommended by the manufacturer. Caulking or other adhesive sealants shall not be used to fill voids between fire sprinkler cover plates and walls or ceilings.	—

Wichita-Sedgwick County
~~Metropolitan Area Building~~
and Construction Department

REVIEWED FOR CODE COMPLIANCE

CORRECTIONS OR COMMENTS MADE ON THESE DRAWINGS AND THIS DOCUMENT DURING THIS REVIEW DO NOT RELIEVE CONTRACTOR FROM COMPLIANCE WITH ALL REQUIREMENTS OF THE CODE OF THE MABCD, THE CITY OF WICHITA OR SEDGWICK COUNTY. THIS REVIEW IS ONLY FOR GENERAL CONFORMANCE OF THE CODE. THE CONTRACTOR IS RESPONSIBLE FOR CONFORMING AND CORRELATING ALL TECHNIQUES OF CONSTRUCTION. THIS APPROVAL IS SUBJECT TO PROVISIONS OF SECTION 107.4 OF THE 2012 INTERNATIONAL BUILDING CODE.

DATE: 02/19/25 BY: William Jerauld Jr

REQUIRED AIR INFILTRATION SEALING MEASURES TO ACHIEVE CODE TARGET 5 ACH50.

- SPRAY RIMS WITH CLOSED CELL SPRAY FOAM INSULATION
- FULL TOP PLATE AIR SEALING AT ALL TOP PLATE LOCATIONS. NOT ONLY EXTERIOR BOUNDARIES AT THIRD FLOOR
- AIR TIGHT OR FLANGED ELECTRICAL BOXES
- AIR SEALING AROUND THE ROUGH OPENING OF ALL UNIT DOORS.
- PICTURE FRAME AIR SEALING AT ALL EXTERIOR AND DEMISING WALL STUD BAYS

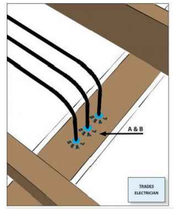

Air seal around all wiring installed through walls, ceilings, and flooring to keep conditioned air from leaking into unconditioned space.

ELECTRICAL PENETRATION

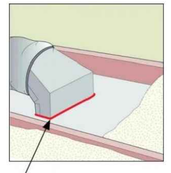

Caulk air seals the boot to the ceiling

DUCT BOOTS AIR SEALING

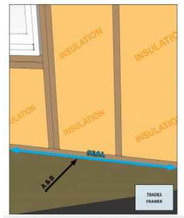

Air seal above-grade sill plates adjacent to conditioned space to minimize air leakage.

BOTTOM PLATE

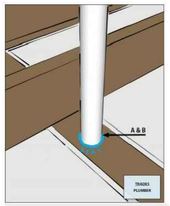

Air seal around all plumbing and piping installed through walls, ceilings, and flooring to keep conditioned air from leaking into unconditioned space.

PLUMBING AND PIPING PENETRATION

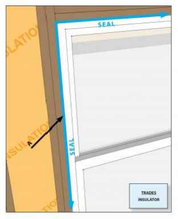

Air seal the rough opening around doors and windows to minimize air leakage.

WINDOW & DOOR ROUGH OPENING

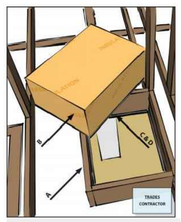

Air seal attic access panels and drop-down stairs to minimize air leakage.

ATTIC HATCH

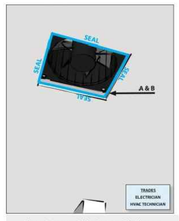

Air seal around kitchen and bathroom exhaust fans to keep conditioned air from leaking into unconditioned space.

EXHAUST FAN PENETRATION

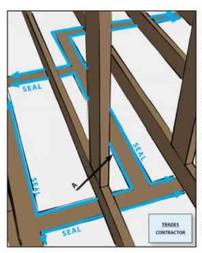

Air seal drywall to top plates at all attic/wall interfaces to minimize air leakage.

Install drywall then seal the seam from the attic side with caulk, foam, or drywall adhesive (but not other construction adhesives).
OR
Before installing drywall, install caulk or other sealant or a foam gasket to the face of the top plate then install the drywall. If this method is used, make sure the sealant or gasket remains intact during the drywall installation.

TOP PLATE

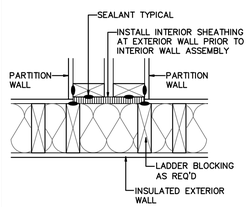

PARTITION WALL

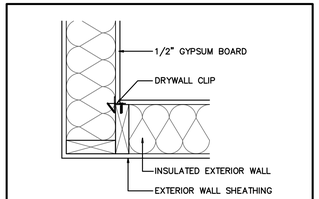

2-STUD CORNER WITH DRYWALL CLIPS

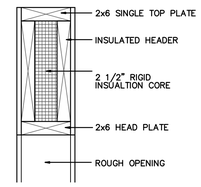

SITE-BUILT INSULATED HEADER

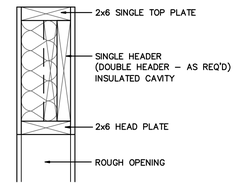

OUTSET HEADER WITH HEAD PLATE

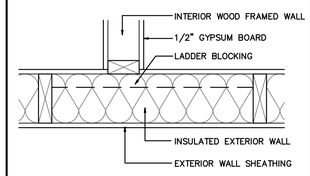

INTERIOR INTERSECTING WALL WITH LADDER BLOCKING

DETAILS FROM GreenBuildingAdvisor.com

A ENERGY FRAMING AND AIR INFILTRATION

1 1/2"=1'-0"

JonesGillamRenz
730 N. Ninth
Salina, KS 67401
1881 Main Street, Suite 301
Kansas City, MO 64108
785.827.0386
jgr@jgrarchitects.com

THE RESIDENCE AT HERITAGE WEST

NEW SENIOR-LIVING FACILITY

ANDOVER, KANSAS

CHRISTOPHER R. CYR
REGISTERED
6979
1/3/2025
KANSAS
ARCHITECT

REVISION:

DATE: 1-3-2025
JOB: 24-3379
SHEET NO.:

A4.9

COPYRIGHTED©

ROOF GENERAL NOTES

1. CONTRACTOR SHALL FIELD VERIFY ALL DIMENSIONS & CONDITIONS.
2. MANUFACTURER & INSTALLER SHALL BE RESPONSIBLE FOR TOTAL ROOF SYSTEM INCLUDING TRANSITIONS, FLASHINGS, ETC. TO MAINTAIN WATER TIGHT ROOF SYSTEM. SUBMIT MANUFACTURERS AND ROOFING SYSTEMS PER THE GENERAL CONDITIONS.
3. MANUFACTURER SHALL WARRANT TOTAL ROOF SYSTEM.
4. REF STRUCTURAL DRAWINGS FOR SHEAR WALL LOCATIONS.
5. PLUMBING VENT STACKS, FLUES, FRESH AIR INTAKES, ETC. NOT SHOWN FOR CLARITY. VERIFY LOCATION WITH MECHANICAL & PLUMBING DRAWINGS.
6. RD – INDICATES ROOF DRAIN LOCATIONS.
7. CONTRACTOR SHALL TIE–IN AND COORDINATE WITH UNDERGROUND DRAINAGE PIPE, EACH DOWNSPOUT LOCATION. REFERENCE CIVIL DRAWINGS.
8. INSTALL FIREBLOCKING, ANCHOR BOLTS AND ANY REQUIRED SHEAR WALL BLOCKING AS REQUIRED BY STRUCTURAL DRAWINGS.
9. CAULK & SEAL WATERTIGHT ALL JOINTS & TRANSITIONS.
10. ALL METAL MATERIALS (I.E. VALLEYS, FLASHINGS, ETC...) SHALL BE .0217" THICK (26 GA) PREFINISHED GALVANIZED OR ALUM. ZINC ALLOY. ALL FASTENERS MUST BE COMPATIBLE WITH ASSOCIATED METALS/MATERIALS. METALS MUST BE INSTALLED PER SMACNA's "ARCHITECTURAL SHEET METAL MANUAL."
11. CONTRACTOR MUST COMPLY WITH ALL STATE & LOCAL CODES & REGULATIONS.
12. PROVIDE PERMANENT IDENTIFICATION ACCEPTABLE TO LOCAL AUTHORITIES AT ALL DRAFTSTOPS AND DRAFTSTOP ACCESS
13. CONTRACTOR TO INSTALL ICE & WATER SHIELD @ ALL TRANSITIONS & METAL FLASHING. (IF APPLICABLE)
14. BUILDING EQUIPPED THROUGHOUT W/ AN AUTOMATIC SPRINKLER SYSTEM IN ACCORDANCE IN ACCORDANCE W/ 2012 IBC SECTION 903.3.1.2.
15. MAINTAIN A 36" CLEARANCE AROUND ALL MECH UNITS.

ALUMINUM TRELLIS NOTES

1. CONTRACTOR TO FIELD VERIFY ALL CONDITIONS & DIMENSIONS PRIOR TO FABRICATION.
2. ALL ALUMINUM TO BE PREFINISHED.
3. F.O.S. = FACE OF STUD
4. F.O.B. = FACE OF BRICK

ATTIC DRAFTSTOPPING & VENTILATION

1. DRAFTSTOPPING IS PROVIDED IN THE ATTIC SPACE ACCORDING TO 2012 IBC SECTION 718.4. DRAFTSTOPPING AREA CALCULATIONS SHOWN ON ROOF PLAN, THIS SHEET. 13 AREAS TOTAL.
2. CROSS VENTILATION PROVIDED, ROOF AND INSULATION DESIGN MEETS 2012 IBC SECTION 1203.2: ENCLOSED RAFTER ASSEMBLIES WITH 1" MINIMUM AIR SPACE.

LEGEND

1. INSTALL 60–MIL TPO ROOFING MEMBRANE OVER 1/2" COVER BOARD, XPS TAPERED RIGID INSUL., ROOF SHEATHING & ROOF TRUSSES (REF. STRUCT). PROVIDE TERMINATION BARS, FLASHING, SEALANT, & CAULKING. RUN ROOFING MEMBRANE UP BACKSIDE OF PARAPETS AND INSTALL PARAPET METAL FLASHING CAPS (COLOR TO BE DETERMINED). ENTIRE ROOF ASSEMBLY SHALL BE PROVIDED AND INSTALLED AS REQUIRED & RECOMMENDED BY MANUFACTURER FOR A 20–YEAR, FULL COVERAGE WARRANTY.
2. 2–HR FIRE PARTITION TO UNDERSIDE OF DECK. (ELEVATOR SHAFT BELOW)
3. INSTALL GRAVITY VENTILATOR, SIM. TO GREENHECK GRS–16–QD, (MUST HAVE 1.45 SF OF NFA OR GREATER).
4. LOCATION OF ROOF HATCH & SAFETY RAIL PER SPEC. 2012 IBC SEC. 1009.16 STAIRWAY TO ROOF:

	INDICATES ROOFING MATERIAL
SDS	INDICATES LOCATION OF A PREFIN. THRU–WALL SCUPPER & BOX W/ 4"x4" DOWNSPOUT. DOWNSPOUTS TO BE ROUTED UNDERGROUND TO NEARBY STORM DRAIN. REFERENCE CIVIL DWGS.
OS	INDICATES LOCATION OF A PREFIN. THRU–WALL OVERFLOW SCUPPER & BOX W/ LAMBS TONGUE. TO BE LOCATED MIN. 2" ABOVE LOW POINT ON ROOF.

LOWER ROOF - DRAFTSTOPPING & ATTIC VENTILATION

DRAFTSTOPPING IS NOT REQUIRED, PER IBC 2012 SECTION 718.4. AREA IS LESS THAN 3,000 SF.

ATTIC VENTILATION PER IBC 2012, SECTION 1203.2 (EXCEPTION 2), 1/300 WITH ASTM 396 VAPOR BARRIER INSTALLED IN ROOF/CEILING ASSEMBLY.

AREA 13 (1,557 SF)
ATTIC AREA MUST PROVIDE
(1,557/300 = 5.19sf NFA)
5.19sf OF NET FREE AREA @ ROOF SURFACE

UPPER ROOF - DRAFTSTOPPING & ATTIC VENTILATION

DRAFTSTOPPING IS PROVIDED IN THE ATTIC SPACE ACCORDING TO 2012 IBC SECTIONS 708.4 & 718.4.
DRAFTSTOPPING AREA CALCULATIONS SHOWN ON ROOF PLAN, THIS SHEET.

AREA 1 (198 SF)
ATTIC AREA MUST PROVIDE
(198/300 = 0.66sf NFA)

AREA 2 (1,635 SF)
ATTIC AREA MUST PROVIDE
(1,635/300 = 5.45sf NFA)

AREA 3 (1,808 SF)
ATTIC AREA MUST PROVIDE
(1,808/300 = 6.03sf NFA)

AREA 4 (1,539 SF)
ATTIC AREA MUST PROVIDE
(1,539/300 = 5.13sf NFA)

AREA 5 (1,676 SF)
ATTIC AREA MUST PROVIDE
(1,676/300 = 5.59sf NFA)

AREA 6 (1,502 SF)
ATTIC AREA MUST PROVIDE
(1,502/300 = 5.01sf NFA)

AREA 7 (687 SF)
ATTIC AREA MUST PROVIDE
(687/300 = 2.29sf NFA)

AREA 8 (234 SF)
ATTIC AREA MUST PROVIDE
(234/300 = 0.78sf NFA)

AREA 9 (1,639 SF)
ATTIC AREA MUST PROVIDE
(1,639/300 = 786.72sf NFA)

AREA 10 (1,054 SF)
ATTIC AREA MUST PROVIDE
(1,054/300 = 3.51sf NFA)

AREA 11 (1,741 SF)
ATTIC AREA MUST PROVIDE
(1,741/300 = 5.80sf NFA)

ATTIC AREA MUST PROVIDE
(349/300 = 1.16sf NFA)

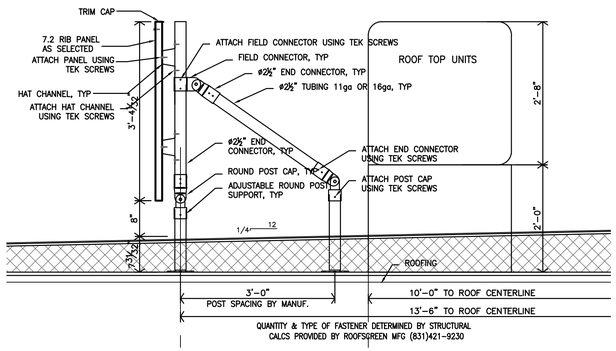

B ROOF SCREEN SECTION
3/4"=1'-0"

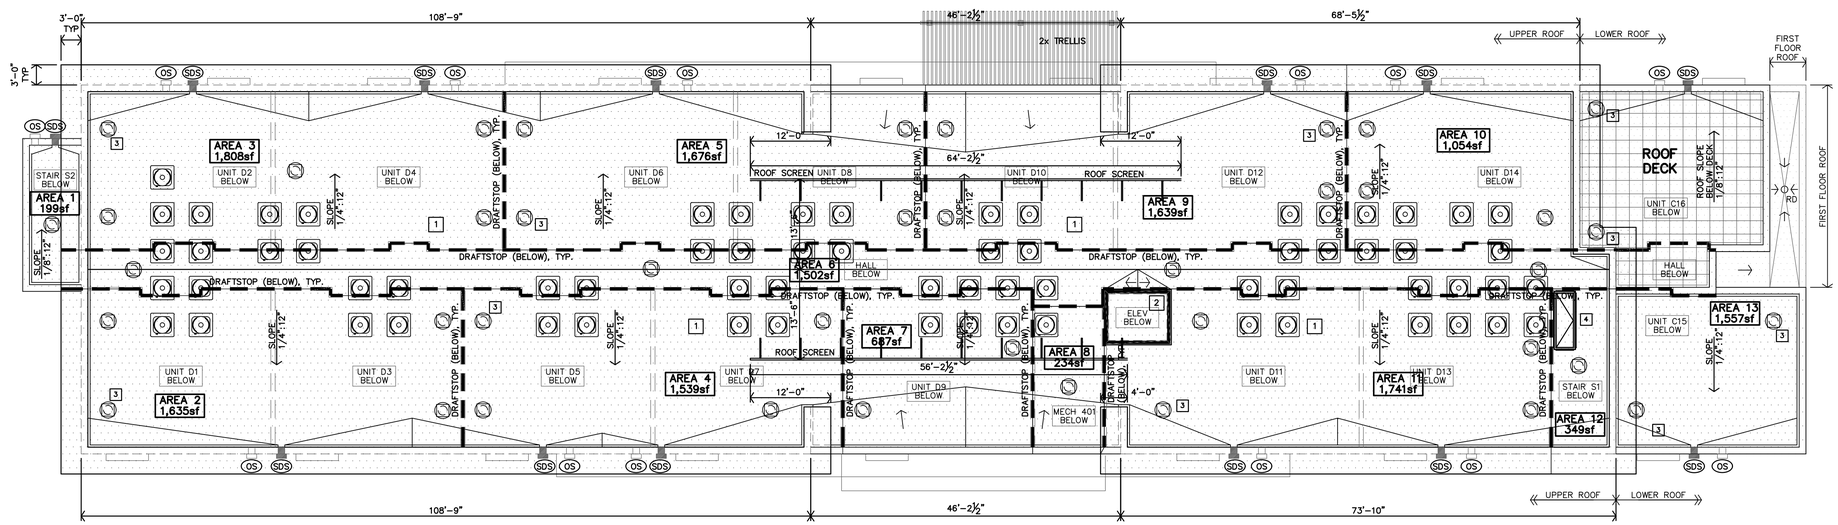

A ROOF PLAN
3/32"=1'-0"

Wichita-Sedgwick County
Metropolitan Area Building
and Construction Department

REVIEWED FOR CODE COMPLIANCE

CORRECTIONS OR COMMENTS MADE ON THESE DRAWINGS AND THIS DOCUMENT DURING THIS REVIEW DO NOT RELIEVE CONTRACTOR FROM COMPLIANCE WITH ALL REQUIREMENTS OF THE CODE OF THE MABCD, THE CITY OF WICHITA OR SEDGWICK COUNTY. THIS REVIEW IS ONLY FOR GENERAL CONFORMANCE OF THE CODE. THE CONTRACTOR IS RESPONSIBLE FOR CONFORMING AND CORRELATING ALL TECHNIQUES OF CONSTRUCTION. THIS APPROVAL IS SUBJECT TO PROVISIONS OF SECTION 107.4 OF THE 2012 INTERNATIONAL BUILDING CODE.

DATE: 02/19/25 BY: William Jerauld Jr

JonesGillamRenz
730 N. Ninth 1881 Main Street, Suite 301
Salina, KS 67401 Kansas City, MO 64108
785.827.0386 jgr@jgrarchitects.com

THE RESIDENCE AT HERITAGE WEST

NEW SENIOR-LIVING FACILITY

ANDOVER, KANSAS

REGISTERED
6979
1/3/2025
KANSAS
ARCHITECT

REVISION:

DATE: 1-3-2025
JOB: 24-3379
SHEET NO.:

A5.1

COPYRIGHTED ©

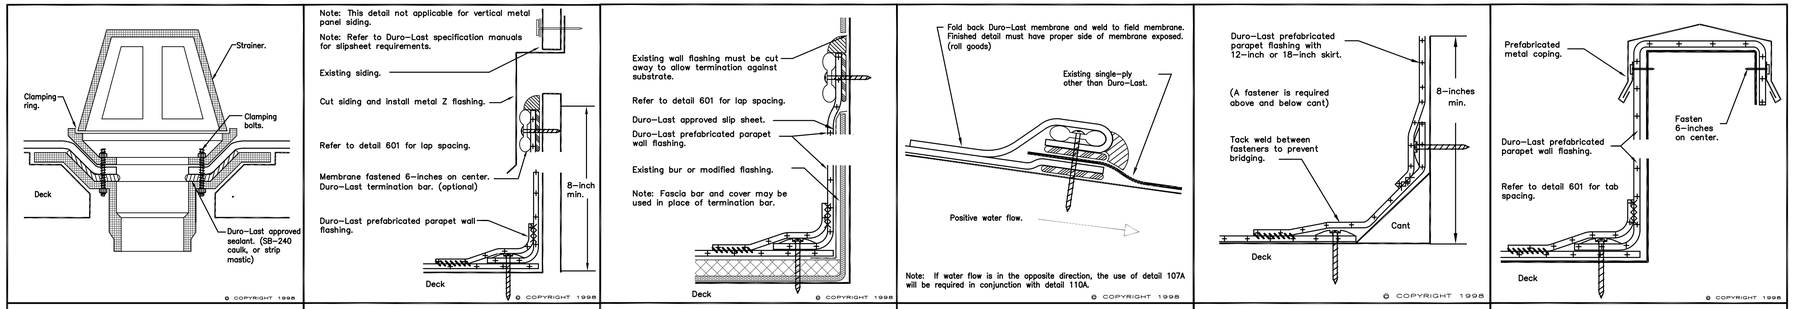

DRAWING NO.	DATE: 10\1\98			
201B	DRAWN BY: KNOX	SCALE:NONE	ROOF DRAIN DETAIL New Construction or Reroof	DURO-LAST, INC. 525 MORLEY DRIVE SAGINAW, MI 48601
611A	DRAWN BY: KNOX	SCALE:NONE	SIDING DETAIL New Construction or Reroof	DURO-LAST, INC. 525 MORLEY DRIVE SAGINAW, MI 48601
608A	DRAWN BY: KNOX	SCALE:NONE	PARAPET WALL New Construction or Reroof	DURO-LAST, INC. 525 MORLEY DRIVE SAGINAW, MI 48601
110A	DRAWN BY: KNOX	SCALE:NONE	SINGLE-PLY TIE-IN New Construction or Reroof	DURO-LAST, INC. 525 MORLEY DRIVE SAGINAW, MI 48601
606C	DRAWN BY: KNOX	SCALE:NONE	PARAPET WITH CANT New Construction or Reroof	DURO-LAST, INC. 525 MORLEY DRIVE SAGINAW, MI 48601
605A	DRAWN BY: KNOX	SCALE:NONE	PARAPET WALL New Construction or Reroof	DURO-LAST, INC. 525 MORLEY DRIVE SAGINAW, MI 48601

DURO-LAST MECHANICALLY ATTACHED ROOFING DETAILS

BASIS OF SPECIFICATION. ACTUAL FIELD AND SUBSTRATE CONDITIONS VARY-REFERENCE SPECIFICATIONS

ROOFING DETAILS THIS SHEET ARE FOR BASE BID, DUROLAST OR FIRESTONE TPO MEMBRANE ROOF SYSTEM. THESE ARE MANUFACTURER'S STANDARD DETAILS FOR BASIS OF SPECIFICATION, AND FOR REFERENCE PURPOSES ONLY. FIELD CONDITIONS VARY. CONTRACTOR IS RESPONSIBLE TO INSTALL A COMPLETE, WEATHER-TIGHT ASSEMBLY IN FULL COMPLIANCE WITH THE SPECIFIED WARRANTIES.

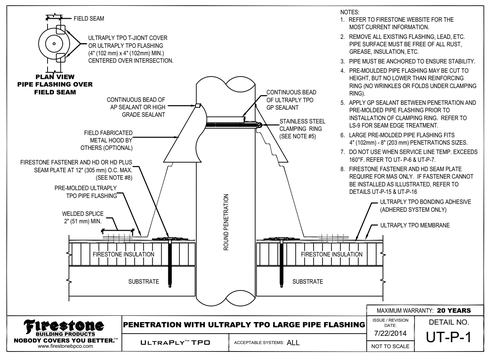

Firestone BUILDING PRODUCTS NOBODY COVERS YOU BETTER.™ www.firestonebpco.com

PENETRATION WITH ULTRAPLY TPO LARGE PIPE FLASHING			
ULTRAPLY™ TPO	ACCEPTABLE SYSTEMS: ALL	ISSUE / REVISION DATE: 7/22/2014	NOT TO SCALE

MAXIMUM WARRANTY: 20 YEARS — DETAIL NO. UT-P-1

G LARGE PIPE DTL.
NO SCALE

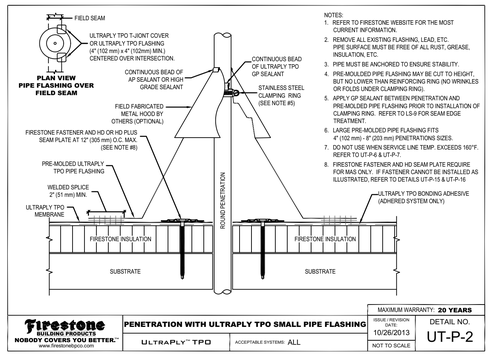

Firestone BUILDING PRODUCTS NOBODY COVERS YOU BETTER.™ www.firestonebpco.com

PENETRATION WITH ULTRAPLY TPO SMALL PIPE FLASHING			
ULTRAPLY™ TPO	ACCEPTABLE SYSTEMS: ALL	ISSUE / REVISION DATE: 10/26/2013	NOT TO SCALE

MAXIMUM WARRANTY: 20 YEARS — DETAIL NO. UT-P-2

F SMALL PIPE DTL.
NO SCALE

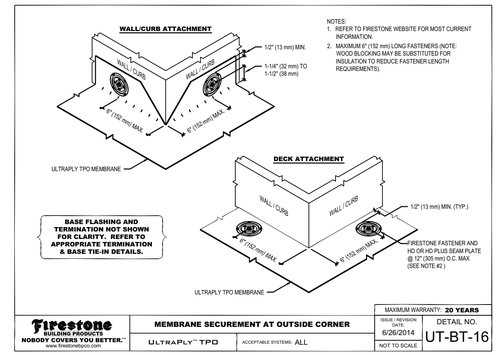

Firestone BUILDING PRODUCTS NOBODY COVERS YOU BETTER.™ www.firestonebpco.com

MEMBRANE SECUREMENT AT OUTSIDE CORNER			
ULTRAPLY™ TPO	ACCEPTABLE SYSTEMS: ALL	ISSUE / REVISION DATE: 6/26/2014	NOT TO SCALE

MAXIMUM WARRANTY: 20 YEARS — DETAIL NO. UT-BT-16

E OUTSIDE CORNER DTL.
NO SCALE

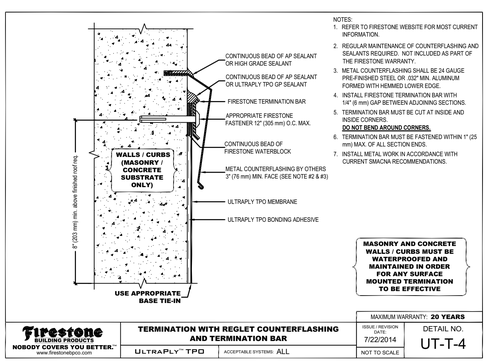

Firestone BUILDING PRODUCTS NOBODY COVERS YOU BETTER.™ www.firestonebpco.com

TERMINATION WITH REGLET COUNTERFLASHING AND TERMINATION BAR			
ULTRAPLY™ TPO	ACCEPTABLE SYSTEMS: ALL	ISSUE / REVISION DATE: 7/22/2014	NOT TO SCALE

MAXIMUM WARRANTY: 20 YEARS — DETAIL NO. UT-T-4

D FLASHING DETAIL
NO SCALE

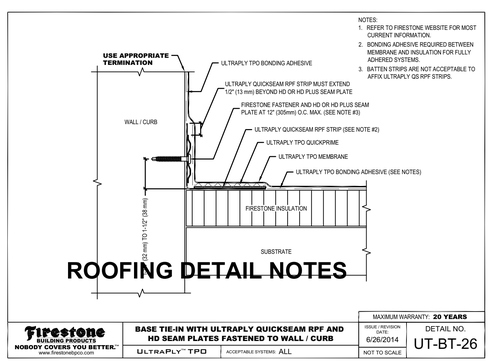

Firestone BUILDING PRODUCTS NOBODY COVERS YOU BETTER.™ www.firestonebpco.com

BASE TIE-IN WITH ULTRAPLY QUICKSEAM RPF AND HD SEAM PLATES FASTENED TO WALL / CURB			
ULTRAPLY™ TPO	ACCEPTABLE SYSTEMS: ALL	ISSUE / REVISION DATE: 6/26/2014	NOT TO SCALE

MAXIMUM WARRANTY: 20 YEARS — DETAIL NO. UT-BT-26

C ROOF-TO-WALL TIE-IN
NO SCALE

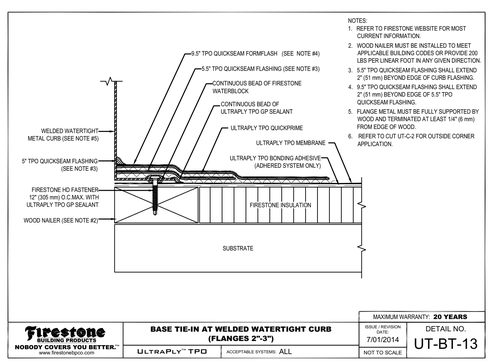

Firestone BUILDING PRODUCTS NOBODY COVERS YOU BETTER.™ www.firestonebpco.com

BASE TIE-IN AT WELDED WATERTIGHT CURB (FLANGES 2"-3")			
ULTRAPLY™ TPO	ACCEPTABLE SYSTEMS: ALL	7/01/2014	NOT TO SCALE

MAXIMUM WARRANTY: 20 YEARS — DETAIL NO. UT-BT-13

B EQUP. CURB DETAIL
NO SCALE

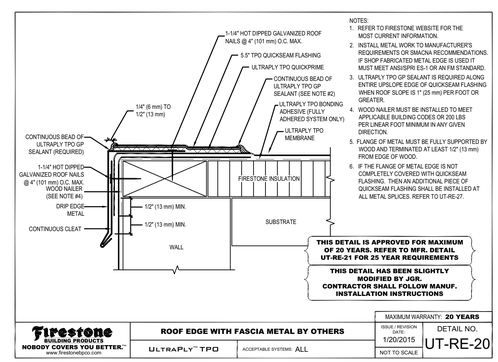

Firestone BUILDING PRODUCTS NOBODY COVERS YOU BETTER.™ www.firestonebpco.com

ROOF EDGE WITH FASCIA METAL BY OTHERS			
ULTRAPLY™ TPO	ACCEPTABLE SYSTEMS: ALL	ISSUE / REVISION DATE: 1/20/2015	NOT TO SCALE

MAXIMUM WARRANTY: 20 YEARS — DETAIL NO. UT-RE-20

A ROOF EDGE DTL.
NO SCALE

FIRESTONE FULLY ADHERED TPO ROOFING STANDARD DETAILS

BASIS OF SPECIFICATION. ACTUAL FIELD AND SUBSTRATE CONDITIONS VARY-REFERENCE SPECIFICATIONS

Wichita-Sedgwick County Metropolitan Area Building and Construction Department

REVIEWED FOR CODE COMPLIANCE

CORRECTIONS OR COMMENTS MADE ON THESE DRAWINGS AND THIS DOCUMENT DURING THIS REVIEW DO NOT RELIEVE CONTRACTOR FROM COMPLIANCE WITH ALL REQUIREMENTS OF THE CODE OF THE MABCD, THE CITY OF WICHITA OR SEDGWICK COUNTY. THIS REVIEW IS ONLY FOR GENERAL CONFORMANCE OF THE CODE. THE CONTRACTOR IS RESPONSIBLE FOR CONFORMING AND CORRELATING ALL TECHNIQUES OF CONSTRUCTION. THIS APPROVAL IS SUBJECT TO PROVISIONS OF SECTION 107.4 OF THE 2012 INTERNATIONAL BUILDING CODE.

DATE: 02/19/25 BY: William Jerauld Jr

JonesGillamRenz
730 N. Ninth 1881 Main Street, Suite 301
Salina, KS 67401 Kansas City, MO 64108
785.827.0386 jgr@jgrarchitects.com

THE RESIDENCE AT HERITAGE WEST
NEW SENIOR-LIVING FACILITY
ANDOVER, KANSAS

CHRISTOPHER R. GILLAM LICENSED 6979 1/3/2025 KANSAS ARCHITECT

REVISION:

DATE: 1-3-2025
JOB: 24-3379
SHEET NO.:

A5.2

COPYRIGHTED ©

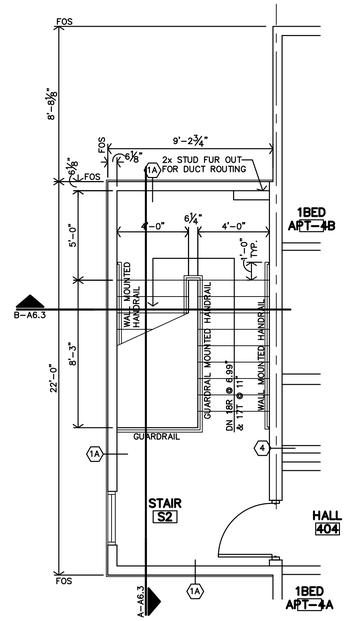

H **STAIR S2 4th FLOOR PLAN**
1/4"=1'-0"

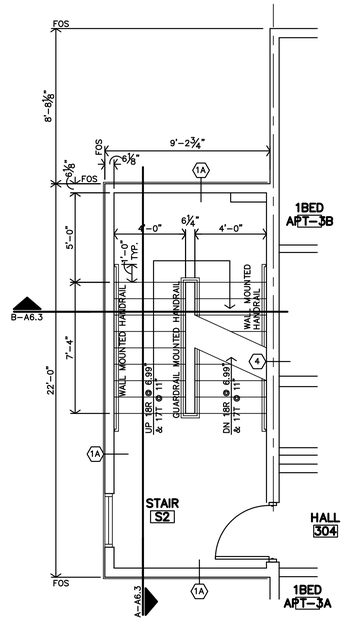

G **STAIR S2 3rd FLOOR PLAN**
1/4"=1'-0"

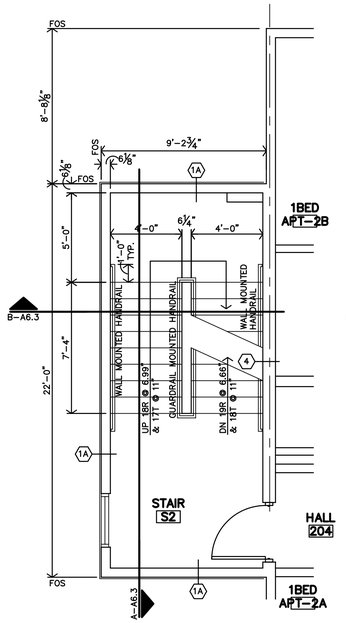

F **STAIR S2 2nd FLOOR PLAN**
1/4"=1'-0"

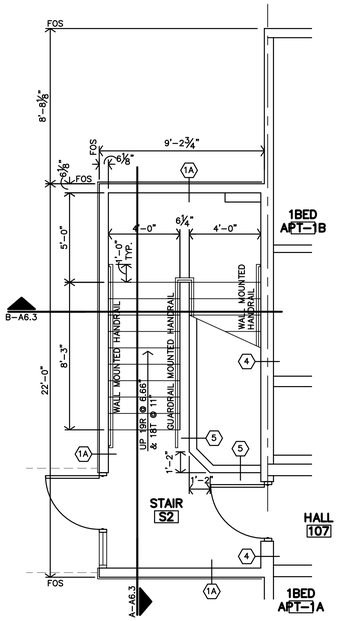

E **STAIR S2 1st FLOOR PLAN**
1/4"=1'-0"

Stair towers will need to accommodate stand pipe installation

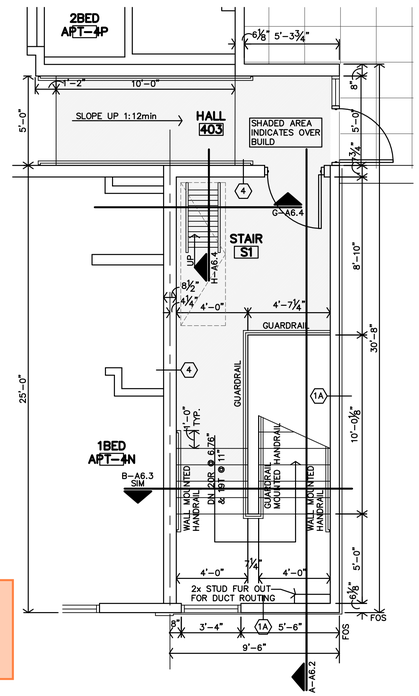

D **STAIR S1 4th FLOOR PLAN**
1/4"=1'-0"

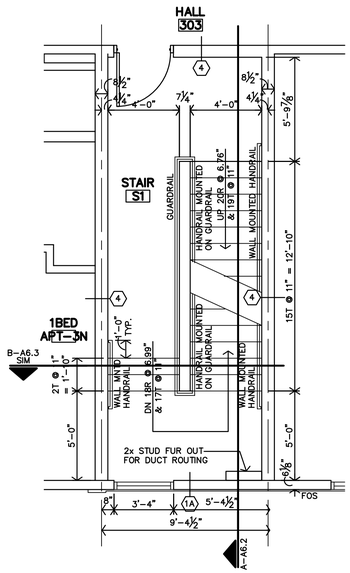

1/4"=1'-0"

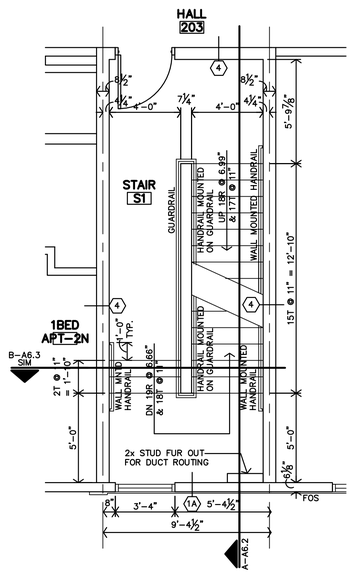

B **STAIR S1 2nd/3rd FLOOR PLAN**
1/4"=1'-0"

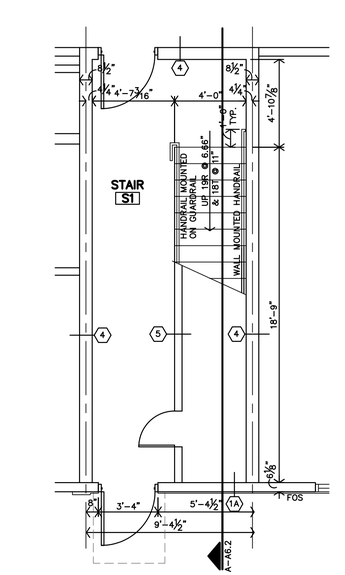

A **STAIR S1 1st FLOOR PLAN**
1/4"=1'-0"

Wichita-Sedgwick County
Metropolitan Area Building
and Construction Department

REVIEWED FOR CODE COMPLIANCE

CORRECTIONS OR COMMENTS MADE ON THESE DRAWINGS AND THIS DOCUMENT DURING THIS REVIEW DO NOT RELIEVE CONTRACTOR FROM COMPLIANCE WITH ALL REQUIREMENTS OF THE CODE OF THE MABCD, THE CITY OF WICHITA OR SEDGWICK COUNTY. THIS REVIEW IS ONLY FOR GENERAL CONFORMANCE OF THE CODE. THE CONTRACTOR IS RESPONSIBLE FOR CONFORMING AND CORRELATING ALL TECHNIQUES OF CONSTRUCTION. THIS APPROVAL IS SUBJECT TO PROVISIONS OF SECTION 107.4 OF THE 2012 INTERNATIONAL BUILDING CODE.

DATE: 02/19/25 BY: William Jerauld Jr

JonesGillamRenz
730 N. Ninth
Salina, KS 67401
1881 Main Street, Suite 301
Kansas City, MO 64108
785.827.0386
jgr@jgrarchitects.com

THE RESIDENCE AT HERITAGE WEST

NEW SENIOR-LIVING FACILITY

ANDOVER, KANSAS

CHRISTOPHER R. GILLAM
6979
1/3/2025
KANSAS
ARCHITECT

REVISION:

DATE: 1-3-2025
JOB: 24-3379
SHEET NO.:

A6.1

COPYRIGHTED ©

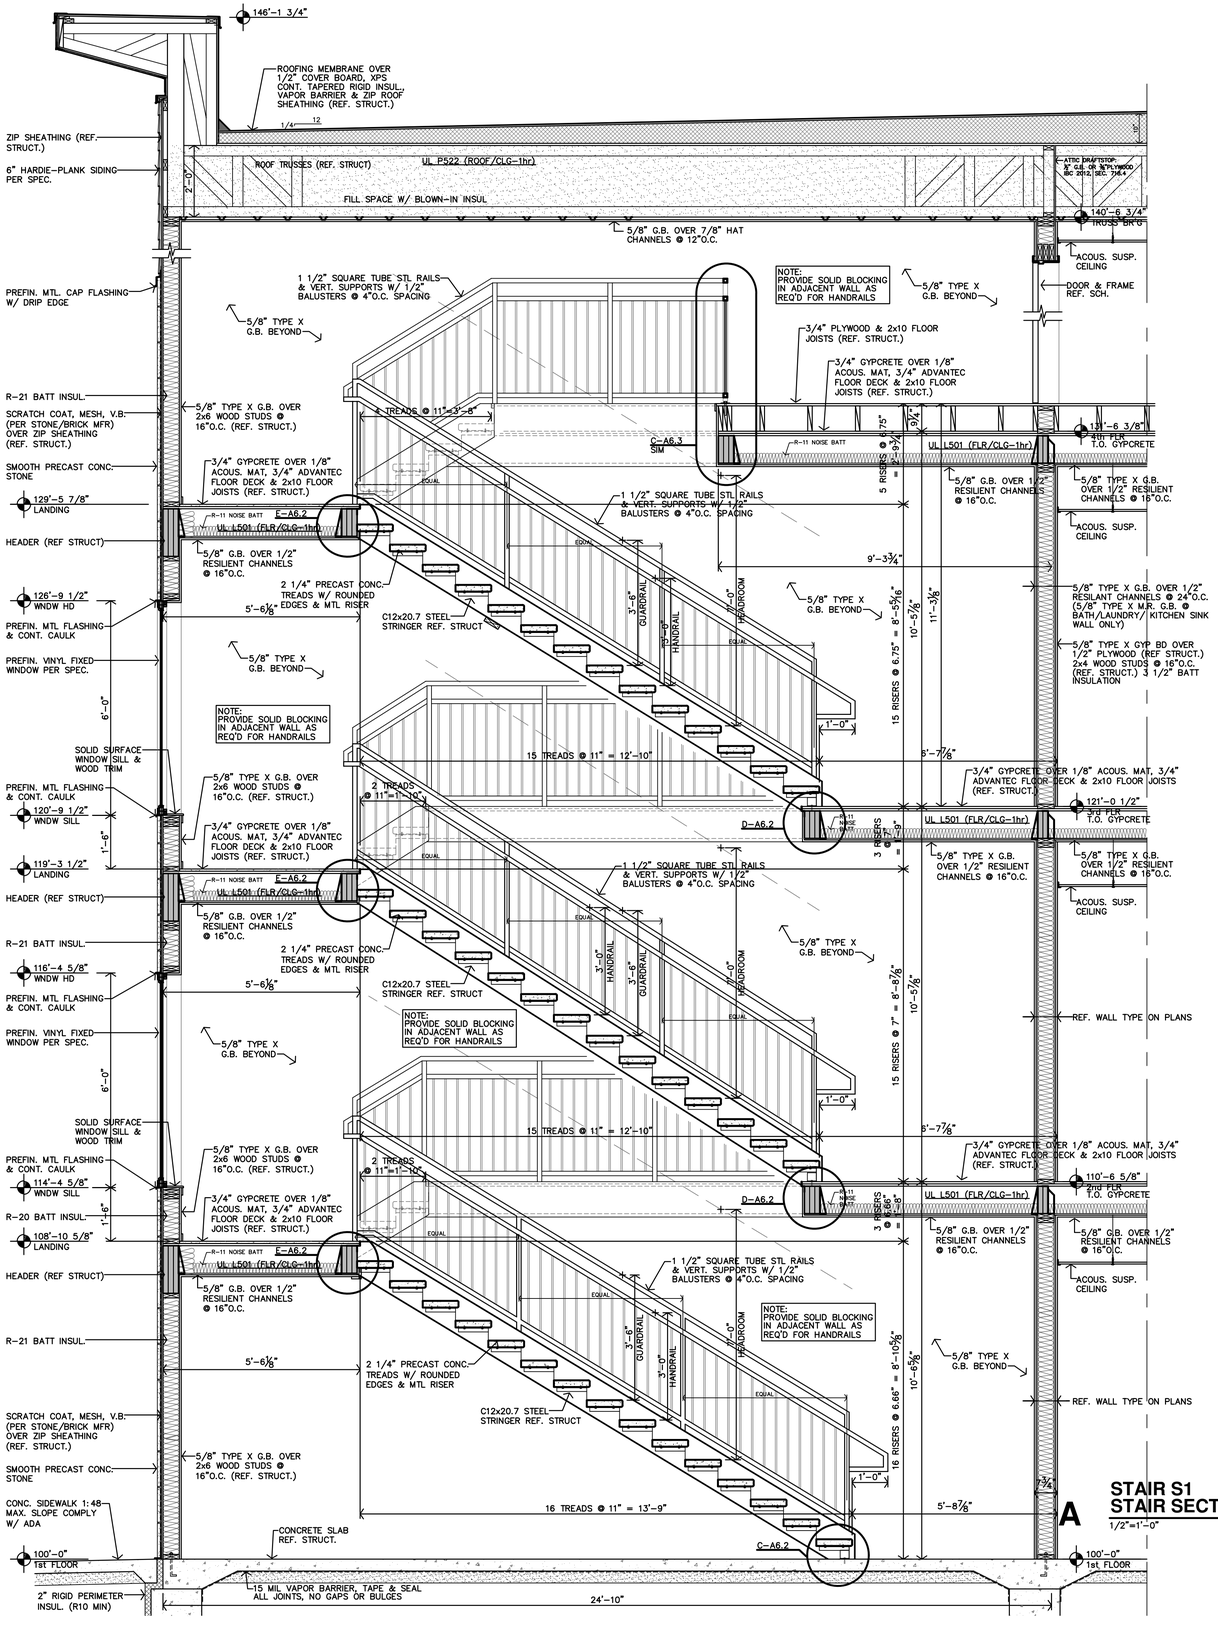

A **STAIR S1**
STAIR SECTION
1/2"=1'-0"

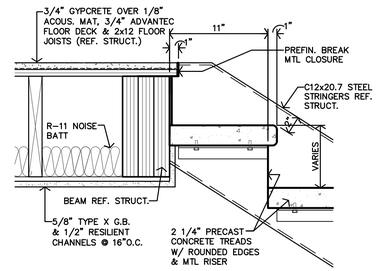

E **STAIR DETAIL**
1 1/2"=1'-0"

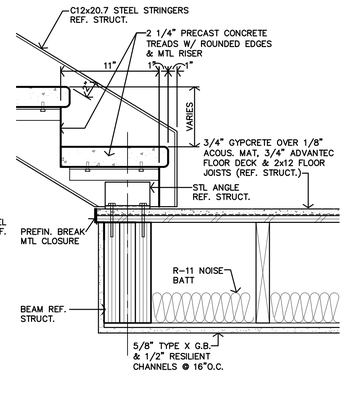

D **STAIR DETAIL**
1 1/2"=1'-0"

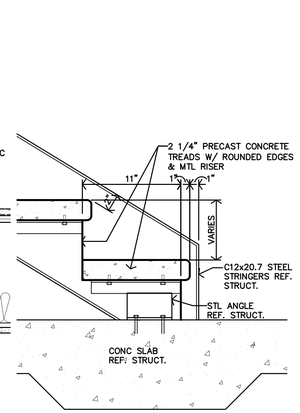

C **STAIR DETAIL**
1 1/2"=1'-0"

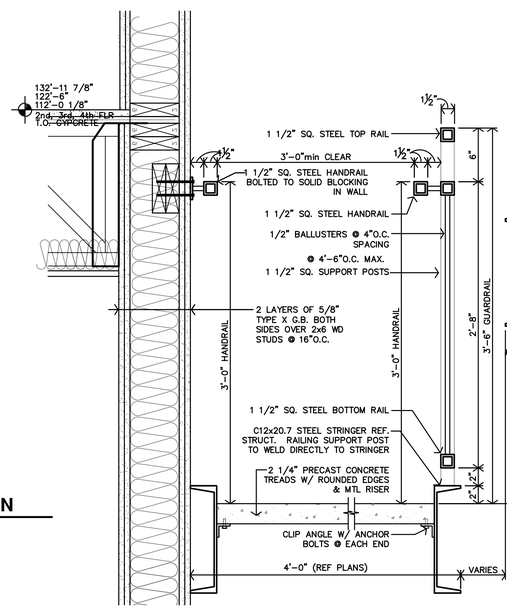

B **STAIR DETAIL**
1 1/2"=1'-0"

Wichita-Sedgwick County Metropolitan Area Building and Construction Department

REVIEWED FOR CODE COMPLIANCE

CORRECTIONS OR COMMENTS MADE ON THESE DRAWINGS AND THIS DOCUMENT DURING THIS REVIEW DO NOT RELIEVE CONTRACTOR FROM COMPLIANCE WITH ALL REQUIREMENTS OF THE CODE OF THE MABCD, THE CITY OF WICHITA OR SEDGWICK COUNTY. THIS REVIEW IS ONLY FOR GENERAL CONFORMANCE OF THE CODE. THE CONTRACTOR IS RESPONSIBLE FOR CONFORMING AND CORRELATING ALL TECHNIQUES OF CONSTRUCTION. THIS APPROVAL IS SUBJECT TO PROVISIONS OF SECTION 107.4 OF THE 2012 INTERNATIONAL BUILDING CODE.

DATE: 02/19/25 BY: William Jerauld Jr

JonesGillamRenz
730 N. Ninth 1881 Main Street, Suite 301
Salina, KS 67401 Kansas City, MO 64108
785.827.0386 jgr@jgrarchitects.com

THE RESIDENCE AT HERITAGE WEST

NEW SENIOR-LIVING FACILITY

ANDOVER, KANSAS

CHRISTOPHER R. GILLAM
REGISTERED ARCHITECT
6979
1/3/2025
KANSAS
ARCHITECT

REVISION:

DATE: 1-3-2025
JOB: 24-3379
SHEET NO.:

A6.2

COPYRIGHTED ©

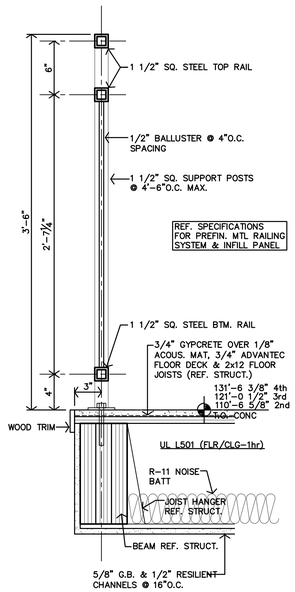

C STAIR DETAIL
1 1/2"=1'-0"

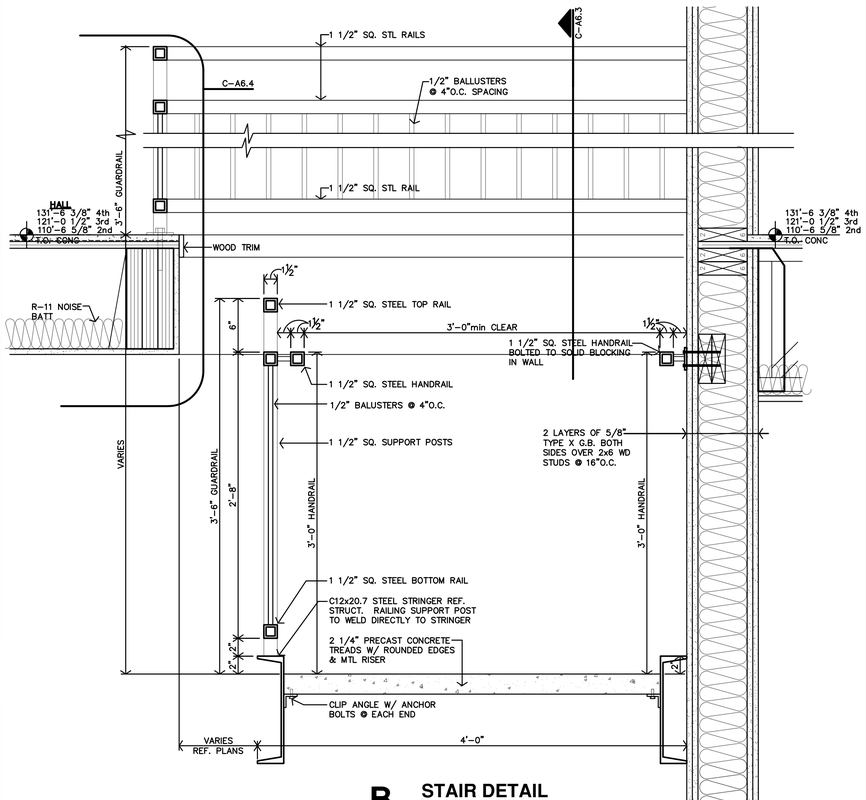

B STAIR DETAIL
1 1/2"=1'-0"

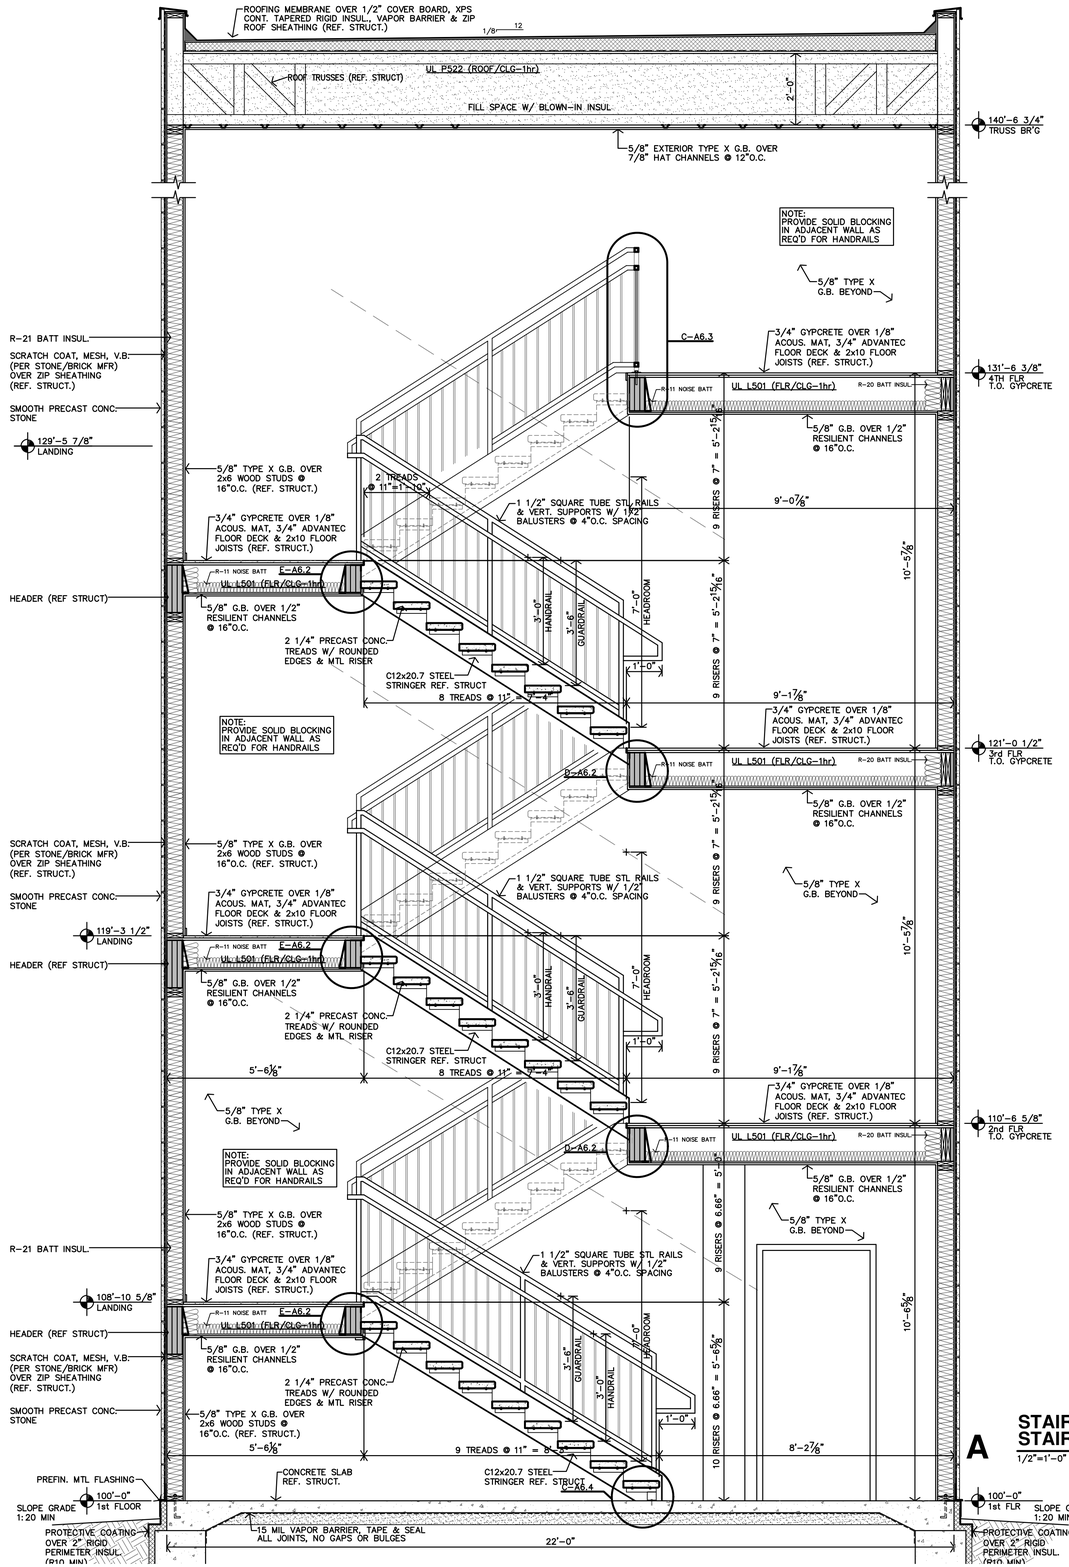

A STAIR S2 STAIR SECTION
1/2"=1'-0"

Wichita-Sedgwick County
Metropolitan Area Building
and Construction Department

REVIEWED FOR CODE COMPLIANCE

CORRECTIONS OR COMMENTS MADE ON THESE DRAWINGS AND THIS DOCUMENT DURING THIS REVIEW DO NOT RELIEVE CONTRACTOR FROM COMPLIANCE WITH ALL REQUIREMENTS OF THE CODE OF THE MABCD, THE CITY OF WICHITA OR SEDGWICK COUNTY. THIS REVIEW IS ONLY FOR GENERAL CONFORMANCE OF THE CODE. THE CONTRACTOR IS RESPONSIBLE FOR CONFORMING AND CORRELATING ALL TECHNIQUES OF CONSTRUCTION. THIS APPROVAL IS SUBJECT TO PROVISIONS OF SECTION 107.4 OF THE 2012 INTERNATIONAL BUILDING CODE.

DATE: 02/19/25 BY: William Jerauld Jr

JonesGillamRenz
730 N. Ninth
Salina, KS 67401
1881 Main Street, Suite 301
Kansas City, MO 64108
785.827.0386
jgr@jgrarchitects.com

THE RESIDENCE AT HERITAGE WEST
NEW SENIOR-LIVING FACILITY
ANDOVER, KANSAS

CHRISTOPHER R. GILL
6979
1/3/2025
KANSAS
ARCHITECT

REVISION:

DATE: 1-3-2025
JOB: 24-3379
SHEET NO.:

A6.3

COPYRIGHTED©

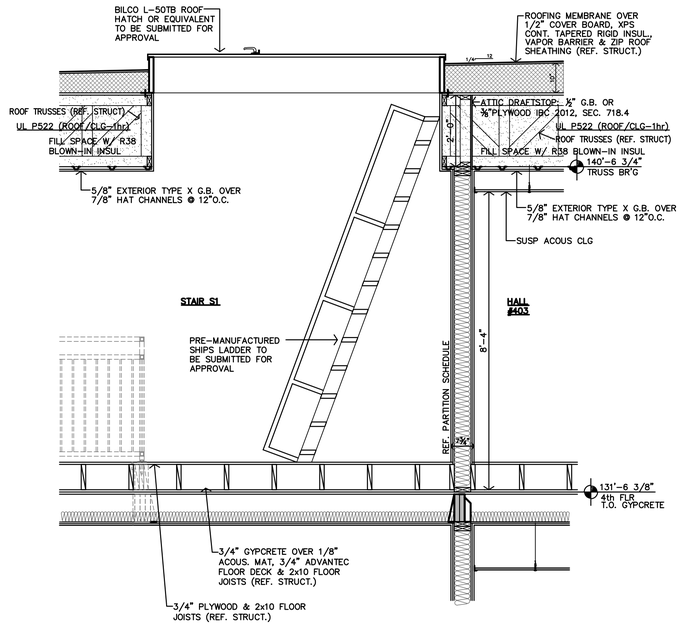

H ROOF ACCESS SECTION
1/2"=1'-0"

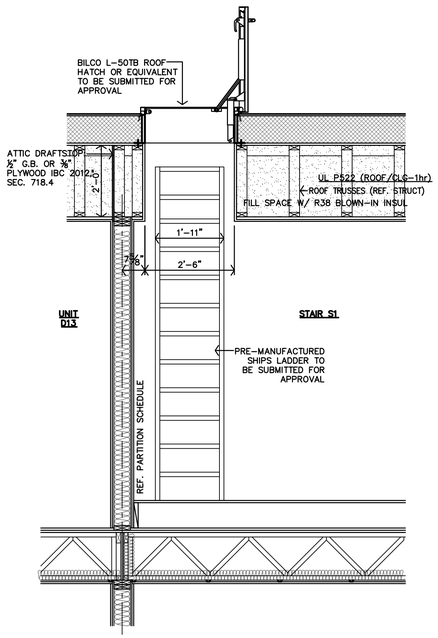

G ROOF ACCESS SECTION
1/2"=1'-0"

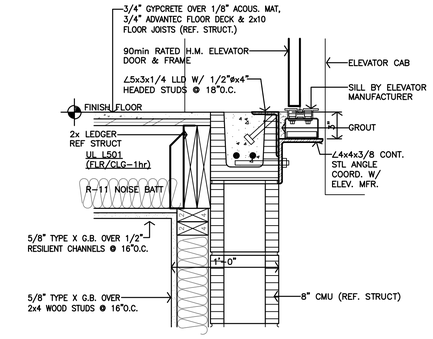

F ELEVATOR DETAIL
1 1/2"=1'-0"

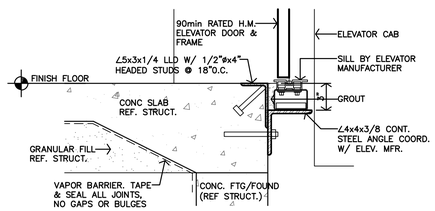

E ELEVATOR DETAIL
1 1/2"=1'-0"

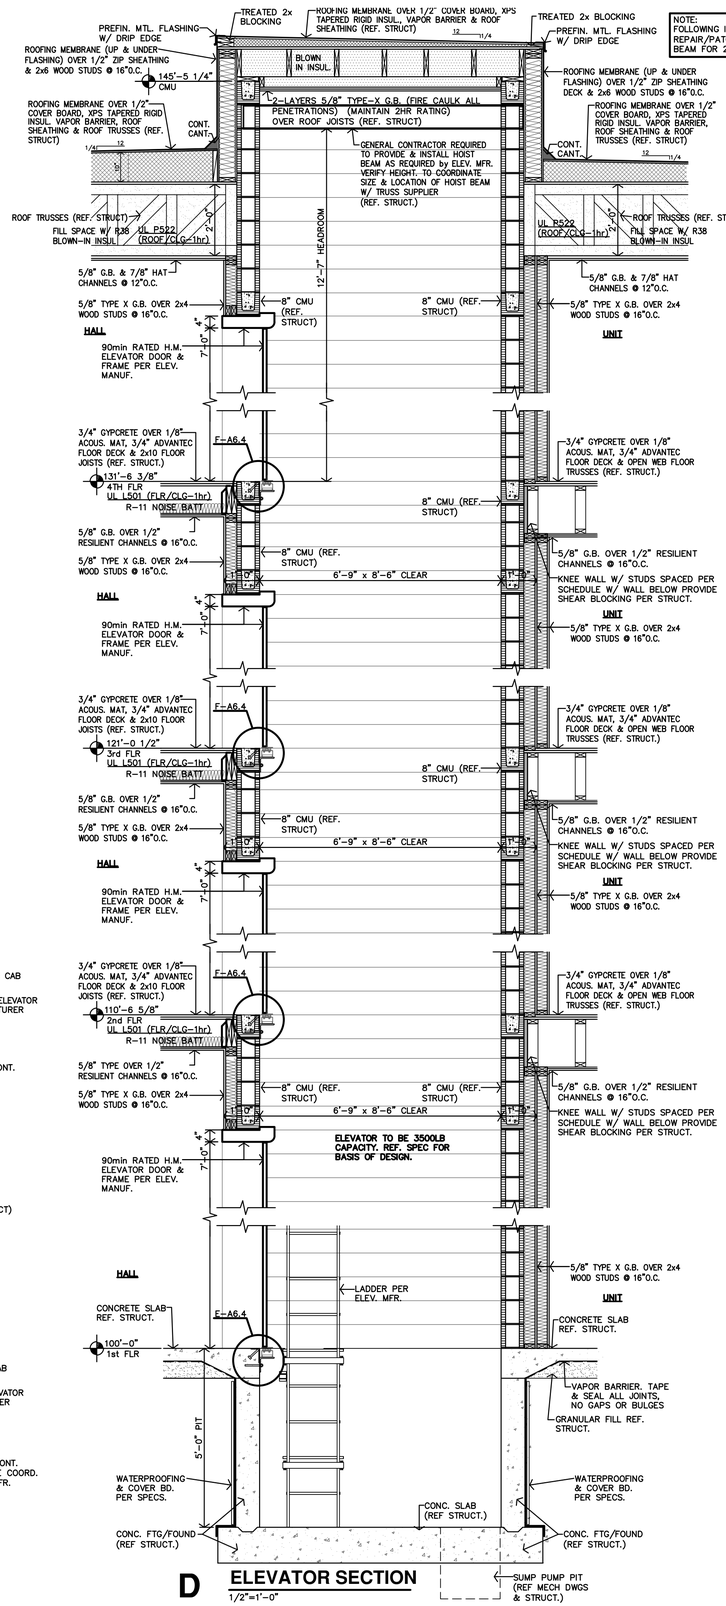

D ELEVATOR SECTION
1/2"=1'-0"

NOTE:
FOLLOWING INSTALLATION OF ELEVATOR REPAIR/PATCH G.B. OPENING AT HOIST BEAM FOR 2HR RATING

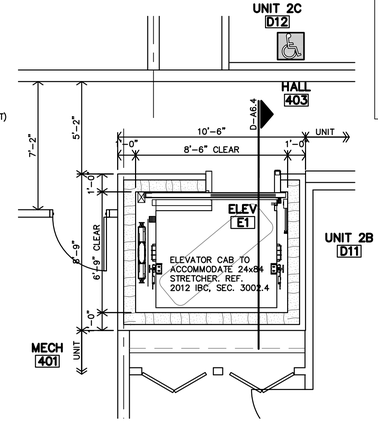

C FOURTH FLOOR ELEVATOR PLANS
1/2"=1'-0"

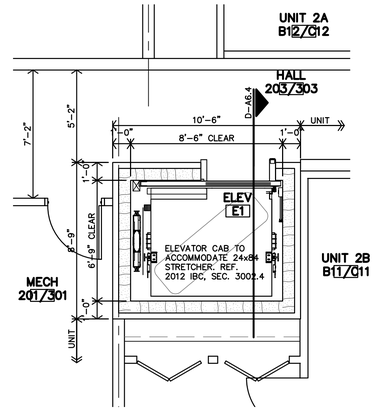

B SECOND/THIRD FLOOR ELEVATOR PLANS
1/2"=1'-0"

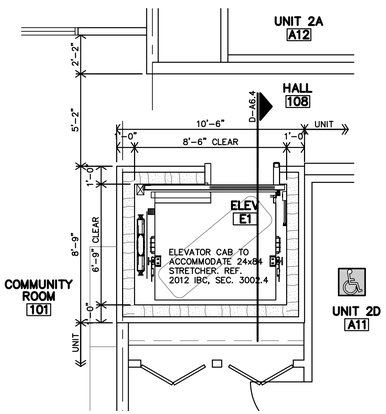

A FIRST FLOOR ELEVATOR PLAN
1/2"=1'-0"

Wichita-Sedgwick County Metropolitan Area Building and Construction Department

REVIEWED FOR CODE COMPLIANCE

CORRECTIONS OR COMMENTS MADE ON THESE DRAWINGS AND THIS DOCUMENT DURING THIS REVIEW DO NOT RELIEVE CONTRACTOR FROM COMPLIANCE WITH ALL REQUIREMENTS OF THE CODE OF THE MABCD, THE CITY OF WICHITA OR SEDGWICK COUNTY. THIS REVIEW IS ONLY FOR GENERAL CONFORMANCE OF THE CODE. THE CONTRACTOR IS RESPONSIBLE FOR CONFORMING AND CORRELATING ALL TECHNIQUES OF CONSTRUCTION. THIS APPROVAL IS SUBJECT TO PROVISIONS OF SECTION 107.4 OF THE 2012 INTERNATIONAL BUILDING CODE.

DATE: 02/19/25 BY: William Jerauld Jr

JonesGillamRenz
730 N. Ninth 1881 Main Street, Suite 301
Salina, KS 67401 Kansas City, MO 64108
785.827.0386 jgr@jgrarchitects.com

THE RESIDENCE AT HERITAGE WEST
NEW SENIOR-LIVING FACILITY
ANDOVER, KANSAS

CHRISTOPHER R. GILLAM LICENSED 6979 1/3/2025 KANSAS ARCHITECT

REVISION:
DATE: 1-3-2025
JOB: 24-3379
SHEET NO.:

A6.4

COPYRIGHTED ©

Wichita-Sedgwick County
Metropolitan Area Building
and Construction Department

REVIEWED FOR CODE COMPLIANCE

CORRECTIONS OR COMMENTS MADE ON THESE DRAWINGS AND THIS DOCUMENT DURING THIS REVIEW DO NOT RELIEVE CONTRACTOR FROM COMPLIANCE WITH ALL REQUIREMENTS OF THE CODE OF THE MABCD, THE CITY OF WICHITA OR SEDGWICK COUNTY. THIS REVIEW IS ONLY FOR GENERAL CONFORMANCE OF THE CODE. THE CONTRACTOR IS RESPONSIBLE FOR CONFORMING AND CORRELATING ALL TECHNIQUES OF CONSTRUCTION. THIS APPROVAL IS SUBJECT TO PROVISIONS OF SECTION 107.4 OF THE 2012 INTERNATIONAL BUILDING CODE.

DATE: 02/19/25 BY: William Jerauld Jr

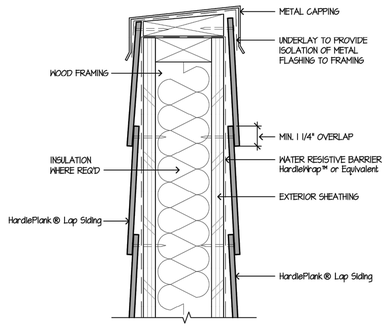

9 PARAPET

SCALE: 3"=1'-0"

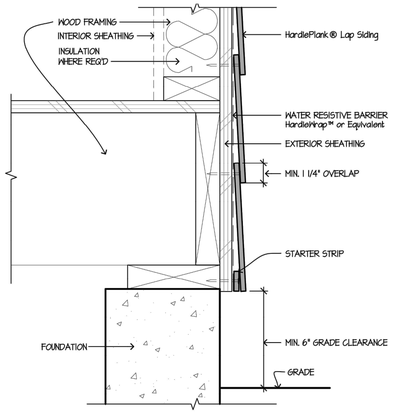

6 GRADE CLEARANCE

SCALE: 3"=1'-0"

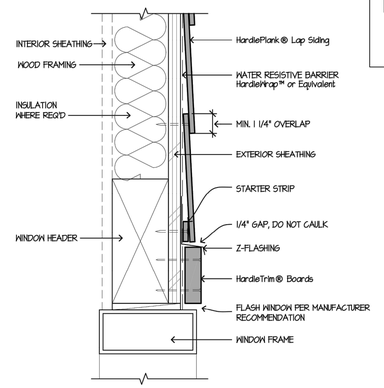

3 WINDOW/DOOR HEAD

SCALE: 3"=1'-0"

HARDIE LAP SIDING

Ref. Elevations for colors and sizes.

Manufacturers Installation Details, Contractor to install as indicated Actual Conditions May Vary

DETAILS ARE NOT TO SCALE

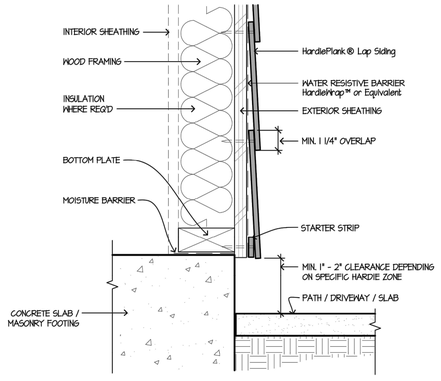

8 HARDSCAPE CLEARANCES, DECKS, PORCHES, PATIOS, WALKWAYS, ROOFS, ETC.

SCALE: 1/2"=1'-0"

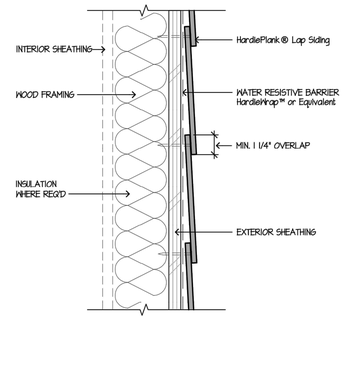

5 HORIZONTAL LAP VIEW

SCALE: 3"=1'-0"

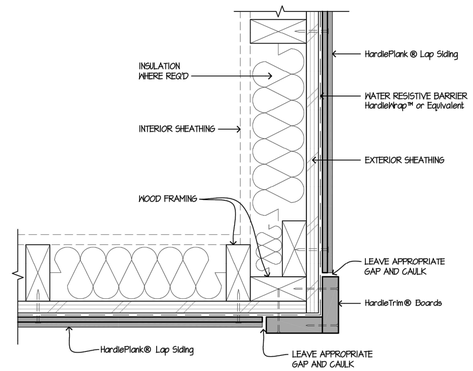

2 OUTSIDE CORNER

SCALE: 3"=1'-0"

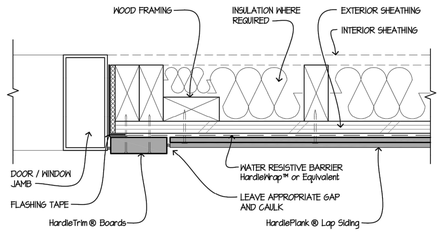

10 DOOR / WINDOW JAMB

SCALE: 3"=1'-0"

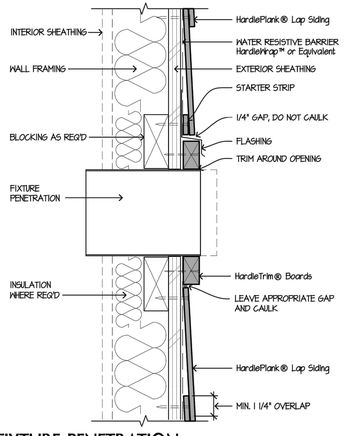

7 FIXTURE PENETRATION

SCALE: 3"=1'-0"

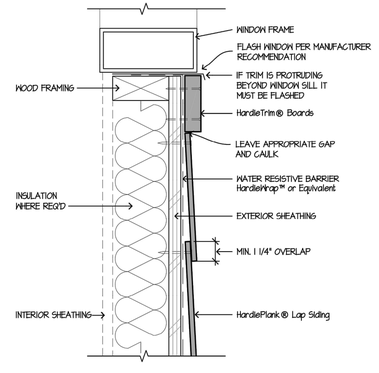

4 WINDOW SILL

SCALE: 3"=1'-0"

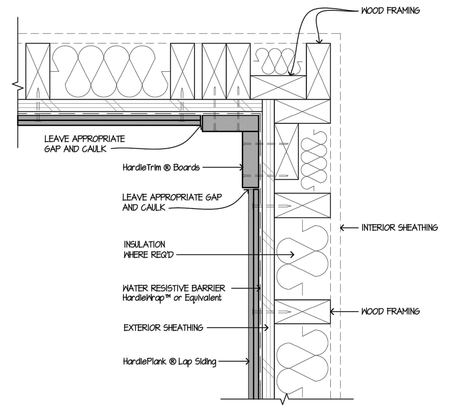

1 INSIDE CORNER

SCALE: 3"=1'-0"

JonesGillamRenz
730 N. Ninth 1881 Main Street, Suite 301
Salina, KS 67401 Kansas City, MO 64108
785.827.0386 jgr@jgrarchitects.com

THE RESIDENCE AT HERITAGE WEST

NEW SENIOR-LIVING FACILITY

ANDOVER, KANSAS

CHRISTOPHER R. GILLAM
REGISTERED
6979
1/3/2025
KANSAS
ARCHITECT

REVISION:

DATE: 1-3-2025
JOB: 24-3379
SHEET NO.:

A6.5

COPYRIGHTED ©

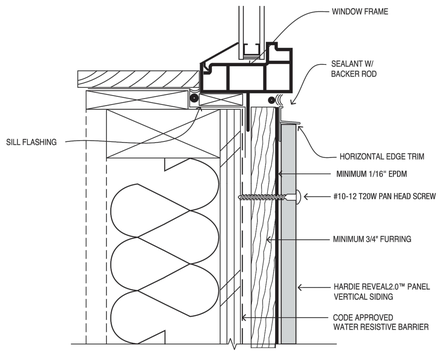

12 **WINDOW SILL**
NTS

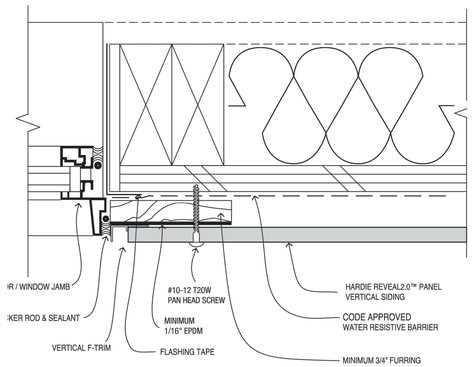

11 **WINDOW JAMB, NO TRIM**
NTS

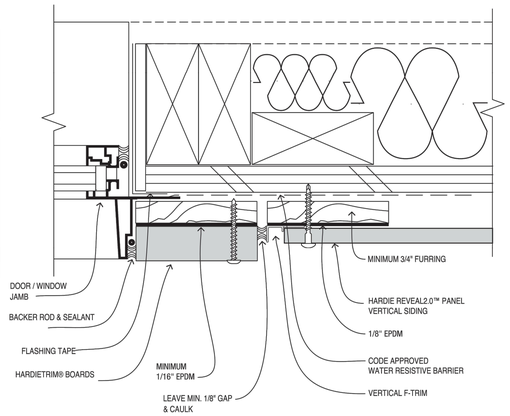

10 **WINDOW JAMB, WITH TRIM**
NTS

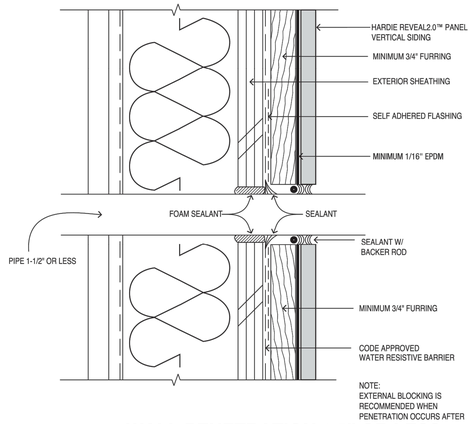

9 **WALL PENETRATION 1.5" OR LESS**
NTS

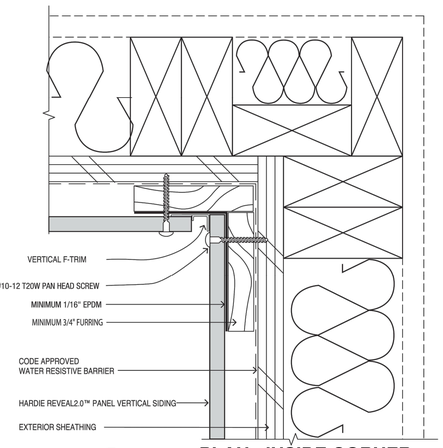

8 **PLAN - INSIDE CORNER**
NTS

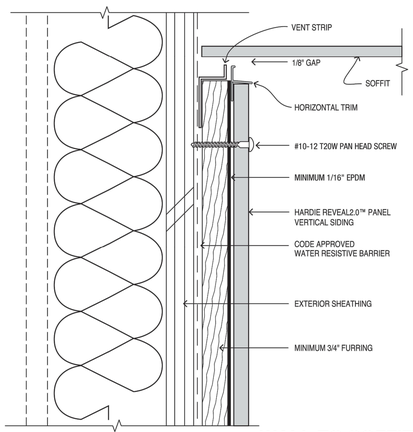

7 **WALL TO SOFFIT**
NTS

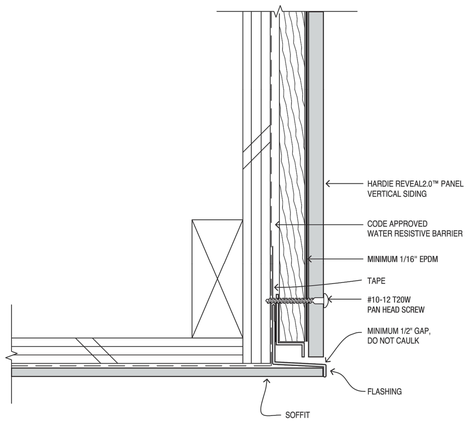

6 **SOFFIT TO OUTSIDE CORNER**
NTS

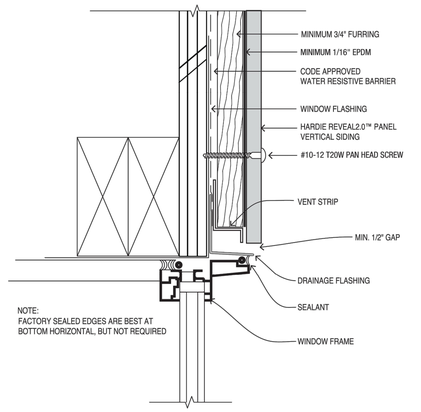

5 **WINDOW HEAD, DOOR SIM.**
NTS

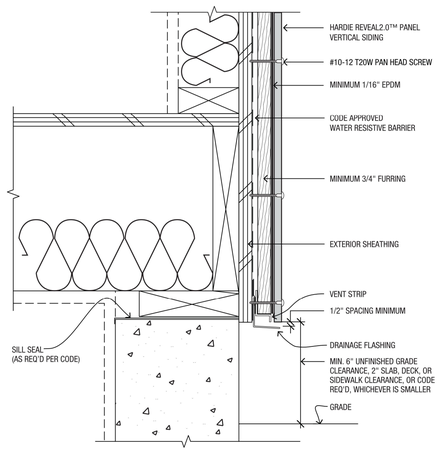

4 **SECTION - AT GRADE**
NTS

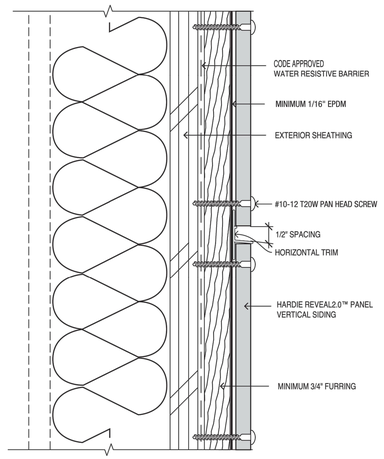

3 **SECTION - HORIZ REVEAL**
NTS

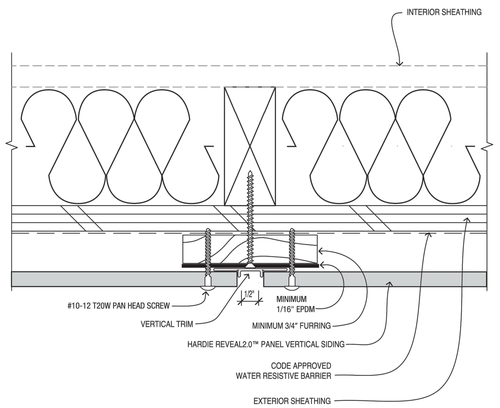

2 **PLAN - VERTICAL REVEAL**
NTS

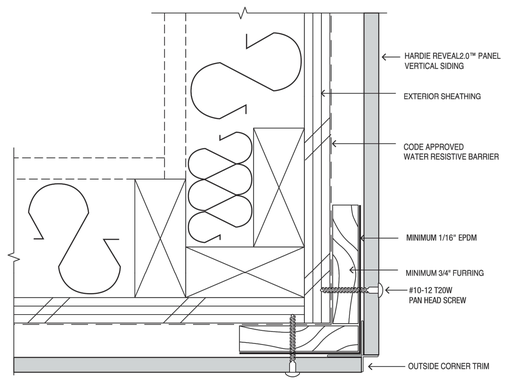

1 **PLAN - OUTSIDE CORNER**
NTS

Wichita-Sedgwick County
Metropolitan Area Building
and Construction Department

REVIEWED FOR CODE COMPLIANCE

CORRECTIONS OR COMMENTS MADE ON THESE DRAWINGS AND THIS DOCUMENT DURING THIS REVIEW DO NOT RELIEVE CONTRACTOR FROM COMPLIANCE WITH ALL REQUIREMENTS OF THE CODE OF THE MABCD, THE CITY OF WICHITA OR SEDGWICK COUNTY. THIS REVIEW IS ONLY FOR GENERAL CONFORMANCE OF THE CODE. THE CONTRACTOR IS RESPONSIBLE FOR CONFORMING AND CORRELATING ALL TECHNIQUES OF CONSTRUCTION. THIS APPROVAL IS SUBJECT TO PROVISIONS OF SECTION 107.4 OF THE 2012 INTERNATIONAL BUILDING CODE.

DATE: 02/19/25 BY: William Jerauld Jr

HARDIE REVEAL PANEL SYSTEM
Manufacturers Installation Details, Install as indicated, Actual Conditions May Vary
DETAILS ARE NOT TO SCALE

JonesGillamRenz
730 N. Ninth 1881 Main Street, Suite 301
Salina, KS 67401 Kansas City, MO 64108
785.827.0386 jgr@jgrarchitects.com

THE RESIDENCE AT HERITAGE WEST
NEW SENIOR-LIVING FACILITY
ANDOVER, KANSAS

CHRISTOPHER R. GILLAM
REGISTERED
6979
1/3/2025
KANSAS
ARCHITECT

REVISION:	
DATE:	1-3-2025
JOB:	24-3379
SHEET NO.:	

A6.6

COPYRIGHTED©

Wichita-Sedgwick County
Metropolitan Area Building
and Construction Department

REVIEWED FOR CODE COMPLIANCE

CORRECTIONS OR COMMENTS MADE ON THESE DRAWINGS AND THIS DOCUMENT DURING THIS REVIEW DO NOT RELIEVE CONTRACTOR FROM COMPLIANCE WITH ALL REQUIREMENTS OF THE CODE OF THE MABCD, THE CITY OF WICHITA OR SEDGWICK COUNTY. THIS REVIEW IS ONLY FOR GENERAL CONFORMANCE OF THE CODE. THE CONTRACTOR IS RESPONSIBLE FOR CONFORMING AND CORRELATING ALL TECHNIQUES OF CONSTRUCTION. THIS APPROVAL IS SUBJECT TO PROVISIONS OF SECTION 107.4 OF THE 2012 INTERNATIONAL BUILDING CODE.

DATE: 02/19/25 BY: William Jerauld Jr

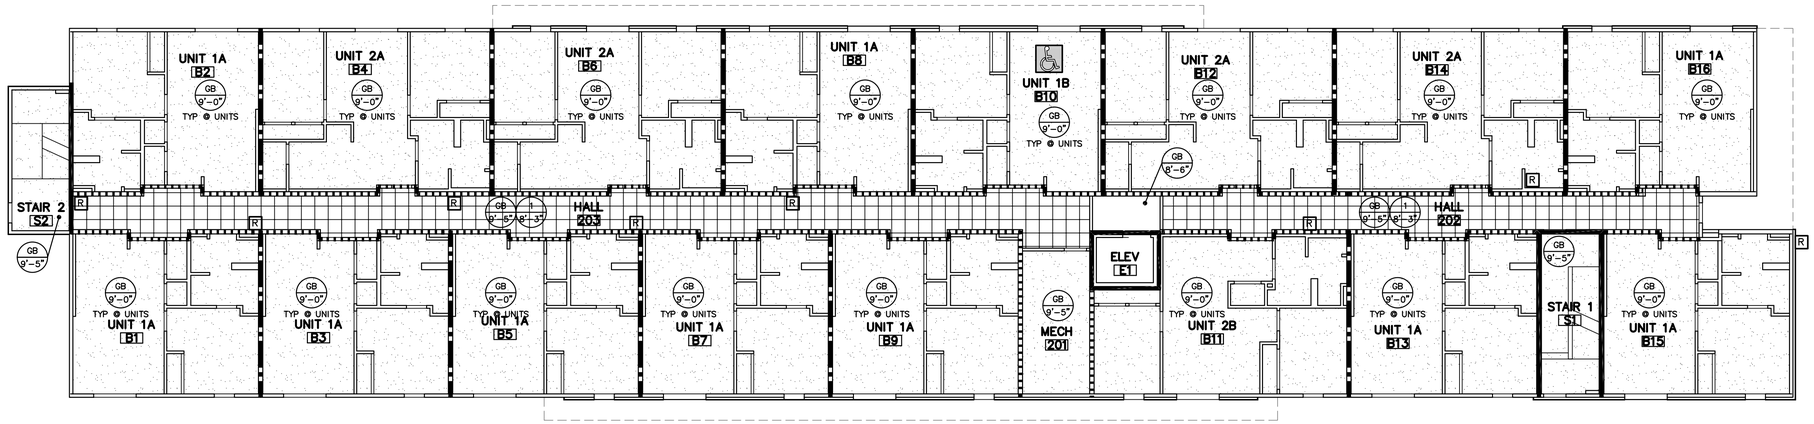

B **SECOND FLOOR PLAN**
3/32"=1'-0"

REFLECTED CEILING PLAN NOTES

1. CONTRACTOR SHALL COORDINATE CEILING LAYOUT WITH MECHANICAL AND ELECTRICAL FIXTURE LOCATIONS. NOTIFY ARCHITECT IMMEDIATELY OF ANY CONFLICT OR DISCREPANCY.
2. MECHANICAL/ELECTRICAL. FIXTURES @ RATED CEILINGS SHALL BE HUNG IN CONFORMANCE TO U.L. SYSTEM REQUIREMENTS.
3. CEILING MOUNTED MECHANICAL EQUIPMENT AND SUSPENDED MECHANICAL EQUIPMENT MUST BE SUSPENDED DIRECTLY FROM THE STRUCTURE.
4. WHERE SUSPENSION DEVICES, WIRES, RODS, ETC. PENETRATE CEILING GRID AND/OR TILE OR G.B. PENETRATIONS SHALL BE NEAT AND CLEANLY CUT. PENETRATION OPENING SHALL BE AS SMALL AS POSSIBLE. SEAL AT G.B.

NON-RATED WALLS
– EXTEND TO BOTTOM OF FLOOR TRUSSES
1 HOUR LOAD BEARING WALLS
– EXTEND TO DECK

1/2 HOUR FIRE PARTITION; CORRIDOR

2 HOUR CONSTRUCTION; SHAFT WALLS

1 HOUR FIRE PARTITION; BETWEEN DWELLING UNITS

SEAL VOIDS AT TOPS OF WALLS AND PENETRATIONS WITH U.L. LISTED FIRE BATT INSULATION, PILLOWS, AND/OR FIRE SEALANT AS REQUIRED BY CONDITION. AT RATED WALLS.

CEILING TYPES
REFER SPECIFICATIONS

1	2x2 ACOUSTIC LAY-IN TILES & GRID
GB	GYP BD (PAINTED)
WD	WOOD SLATS CEILING SYSTEM
M	PREFIN. MTL SOFFIT PANEL

1 9'-8" — CLG. TYPE / CLG. HEIGHT

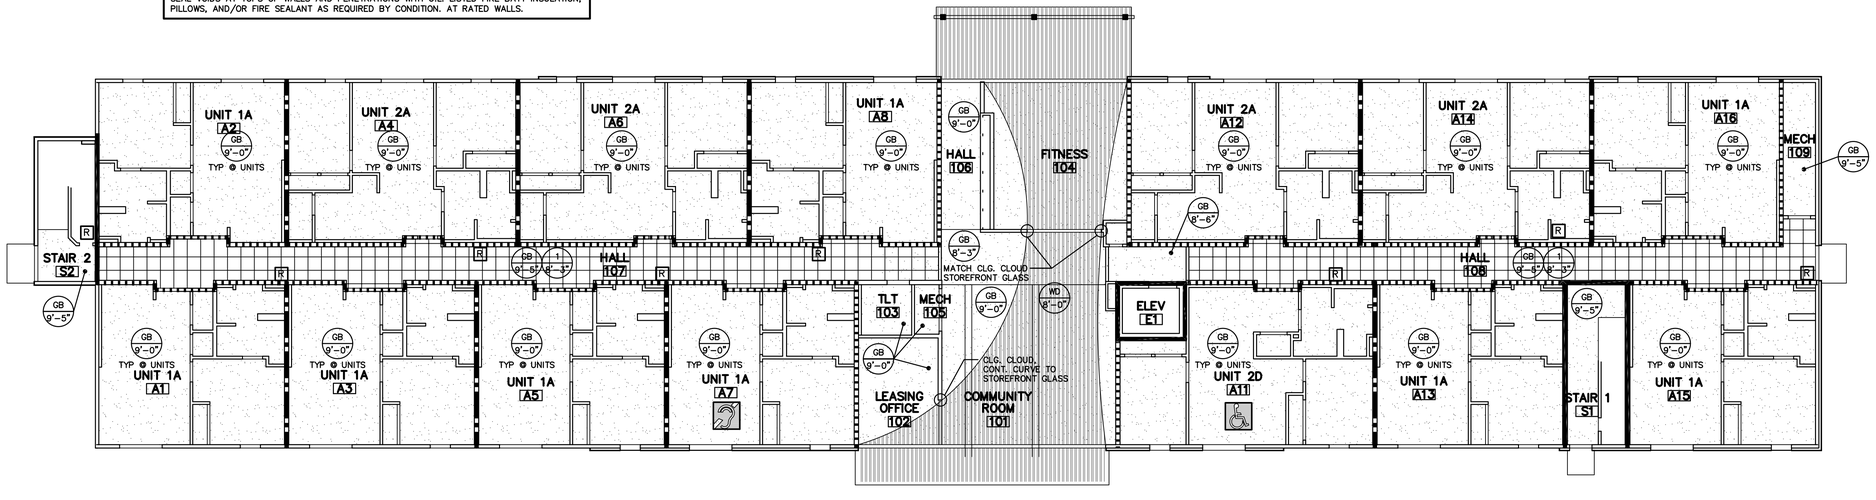

A **FIRST FLOOR PLAN**
3/32"=1'-0"

JonesGillamRenz
730 N. Ninth
Salina, KS 67401
1881 Main Street, Suite 301
Kansas City, MO 64108
785.827.0386
jgr@jgrarchitects.com

THE RESIDENCE AT HERITAGE WEST

NEW SENIOR-LIVING FACILITY

ANDOVER, KANSAS

CHRISTOPHER R. GILLAM
CONSULTANT CERTIFICATE
6979
1/3/2025
KANSAS
ARCHITECT

REVISION:

DATE: 1-3-2025
JOB: 24-3379
SHEET NO.:

A7.1

COPYRIGHTED©

Wichita-Sedgwick County
Metropolitan Area Building
and Construction Department

REVIEWED FOR CODE COMPLIANCE

CORRECTIONS OR COMMENTS MADE ON THESE DRAWINGS AND THIS DOCUMENT DURING THIS REVIEW DO NOT RELIEVE CONTRACTOR FROM COMPLIANCE WITH ALL REQUIREMENTS OF THE CODE OF THE MABCD, THE CITY OF WICHITA OR SEDGWICK COUNTY. THIS REVIEW IS ONLY FOR GENERAL CONFORMANCE OF THE CODE. THE CONTRACTOR IS RESPONSIBLE FOR CONFORMING AND CORRELATING ALL TECHNIQUES OF CONSTRUCTION. THIS APPROVAL IS SUBJECT TO PROVISIONS OF SECTION 107.4 OF THE 2012 INTERNATIONAL BUILDING CODE.

DATE: 02/19/25 BY: William Jerauld Jr

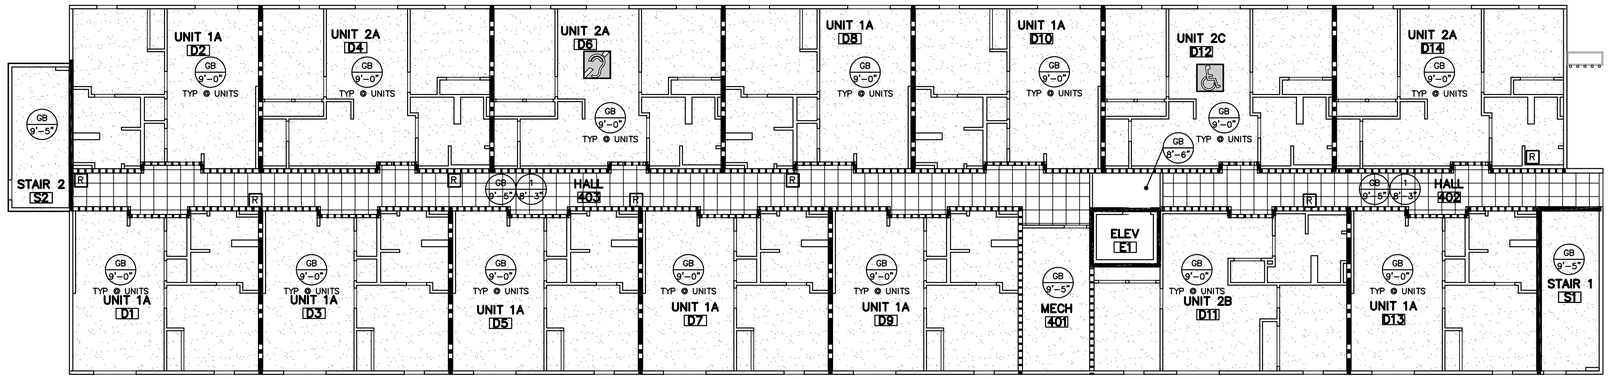

REFLECTED CEILING PLAN NOTES

1. CONTRACTOR SHALL COORDINATE CEILING LAYOUT WITH MECHANICAL AND ELECTRICAL FIXTURE LOCATIONS. NOTIFY ARCHITECT IMMEDIATELY OF ANY CONFLICT OR DISCREPANCY.
2. MECHANICAL/ELECTRICAL. FIXTURES @ RATED CEILINGS SHALL BE HUNG IN CONFORMANCE TO U.L. SYSTEM REQUIREMENTS.
3. CEILING MOUNTED MECHANICAL EQUIPMENT AND SUSPENDED MECHANICAL EQUIPMENT MUST BE SUSPENDED DIRECTLY FROM THE STRUCTURE.
4. WHERE SUSPENSION DEVICES, WIRES, RODS, ETC. PENETRATE CEILING GRID AND/OR TILE OR G.B. PENETRATIONS SHALL BE NEAT AND CLEANLY CUT. PENETRATION OPENING SHALL BE AS SMALL AS POSSIBLE. SEAL AT G.B.

NON-RATED WALLS
– EXTEND TO BOTTOM OF FLOOR TRUSSES
1 HOUR LOAD BEARING WALLS
– EXTEND TO DECK

1/2 HOUR FIRE PARTITION; CORRIDOR

2 HOUR CONSTRUCTION; SHAFT WALLS

1 HOUR FIRE PARTITION; BETWEEN DWELLING UNITS

SEAL VOIDS AT TOPS OF WALLS AND PENETRATIONS WITH U.L. LISTED FIRE BATT INSULATION, PILLOWS, AND/OR FIRE SEALANT AS REQUIRED BY CONDITION. AT RATED WALLS.

CEILING TYPES	
REFER SPECIFICATIONS	
1	2x2 ACOUSTIC LAY-IN TILES & GRID
GB	GYP BD (PAINTED)
EGB	EXTERIOR GYP BD (PAINTED)
FCP	FIBER CEMENT PANELS
WD	"WOOD LOOK" CEILING SYSTEM
N	NICHIHA PANEL AWP SOFFIT
M	PREFIN. MTL SOFFIT PANEL

1 / 8'-8" — CLG. TYPE / CLG. HEIGHT

B FOURTH FLOOR PLAN
3/32"=1'-0"

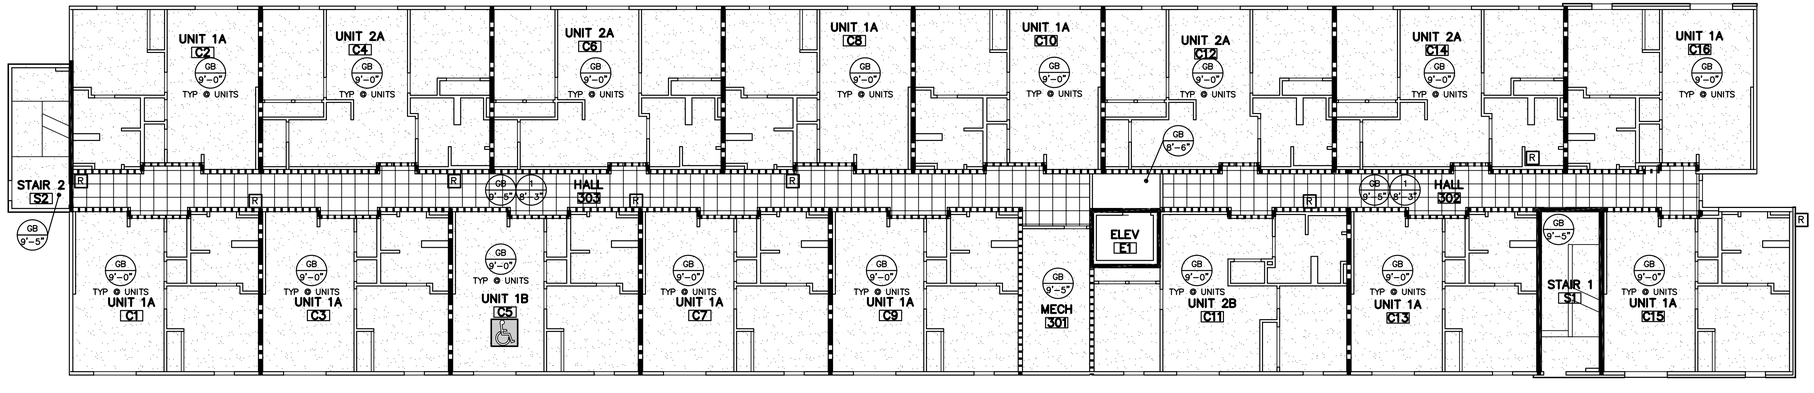

A THIRD FLOOR PLAN
3/32"=1'-0"

JonesGillamRenz
730 N. Ninth
Salina, KS 67401
785.827.0386
1881 Main Street, Suite 301
Kansas City, MO 64108
jgr@jgrarchitects.com

THE RESIDENCE AT HERITAGE WEST

NEW SENIOR-LIVING FACILITY

ANDOVER, KANSAS

CHRISTOPHER R. GILLAM
REGISTERED ARCHITECT
6979
1/3/2025
KANSAS ARCHITECT

REVISION:

DATE: 1-3-2025
JOB: 24-3379
SHEET NO.:

A7.2

COPYRIGHTED©

Wichita-Sedgwick County
Metropolitan Area Building
and Construction Department

REVIEWED FOR CODE COMPLIANCE

CORRECTIONS OR COMMENTS MADE ON THESE DRAWINGS AND THIS DOCUMENT DURING THIS REVIEW DO NOT RELIEVE CONTRACTOR FROM COMPLIANCE WITH ALL REQUIREMENTS OF THE CODE OF THE MABCD, THE CITY OF WICHITA OR SEDGWICK COUNTY. THIS REVIEW IS ONLY FOR GENERAL CONFORMANCE OF THE CODE. THE CONTRACTOR IS RESPONSIBLE FOR CONFORMING AND CORRELATING ALL TECHNIQUES OF CONSTRUCTION. THIS APPROVAL IS SUBJECT TO PROVISIONS OF SECTION 107.4 OF THE 2012 INTERNATIONAL BUILDING CODE.

DATE: 02/19/25 BY: William Jerauld Jr

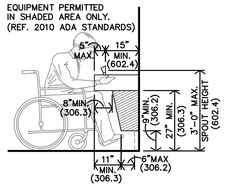

P DRINKING FOUNTAIN DETAIL
3/8"=1'-0" FOR HC HEIGHTS & LOCATION ONLY

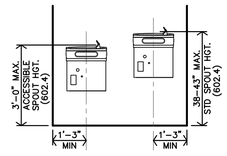

N DRINKING FOUNTAIN ELEVATION
3/8"=1'-0" FOR HC HEIGHTS & LOCATION ONLY

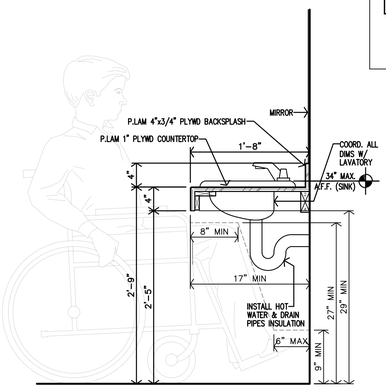

L VANITY DETAIL
1"=1'-0"

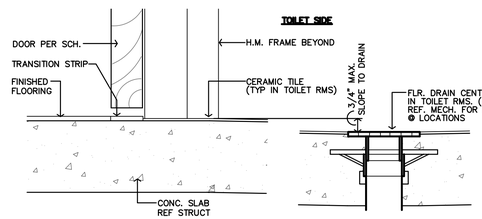

Q FLOOR DRAIN DETAIL
3"=1'-0"

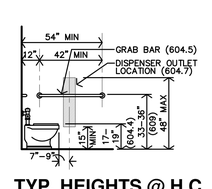

O TYP. HEIGHTS @ H.C. TOILET SIDE WALL
1/4"=1'-0" FOR HC HEIGHTS & LOCATION ONLY

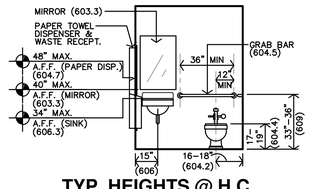

M TYP. HEIGHTS @ H.C. TOILET BACK WALL
1/4"=1'-0" FOR HC HEIGHTS & LOCATION ONLY

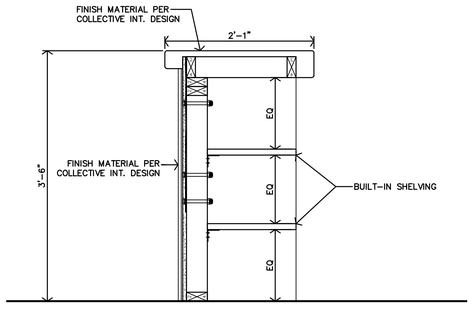

K COMMUNITY ROOM TABLE DETAIL
1"=1'-0"

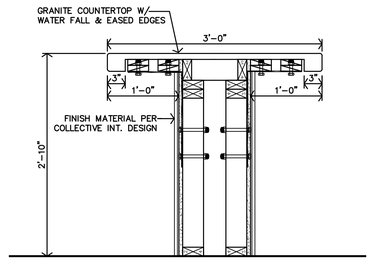

J COMMUNITY ROOM TABLE DETAIL
1"=1'-0"

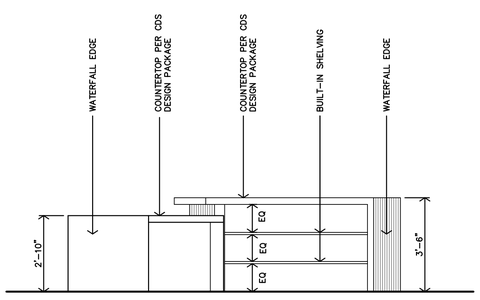

H COMMUNITY ROOM TABLE ELEVATION
3/8"=1'-0"

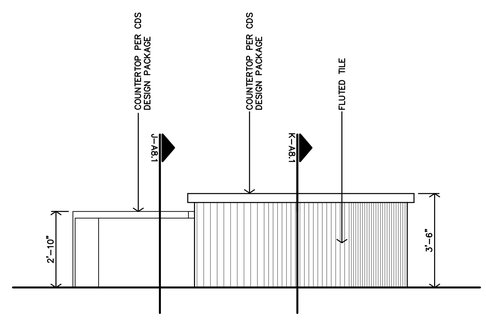

G COMMUNITY ROOM TABLE ELEVATION
3/8"=1'-0"

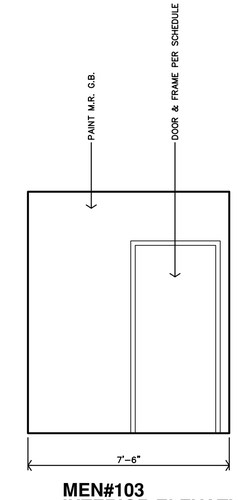

F MEN#103 INTERIOR ELEVATION
3/8"=1'-0"

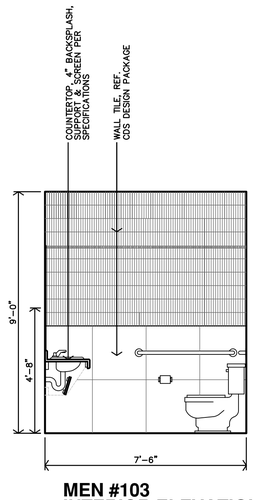

E MEN #103 INTERIOR ELEVATION
3/8"=1'-0"

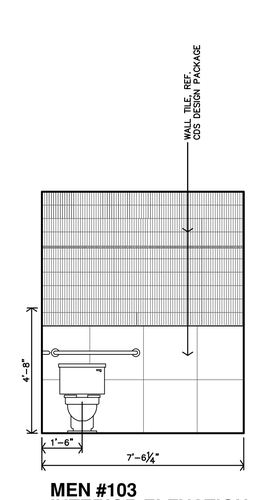

D MEN #103 INTERIOR ELEVATION
3/8"=1'-0"

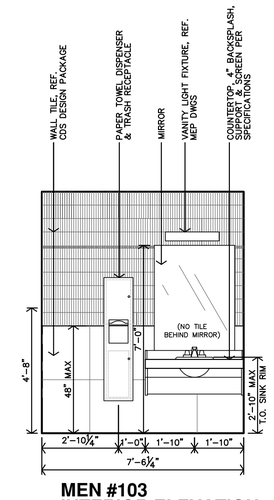

C MEN #103 INTERIOR ELEVATION
3/8"=1'-0"

REFER TO CDS INTERIOR DESIGN PACKAGE.
*ALL DRAWINGS SHOWING BASIC DESIGN INTENT, CONTRACTOR TO REVIEW AND PROVIDE ALL FINISHES, MATERIALS, AND PRODUCTS AS SPECIFIED.

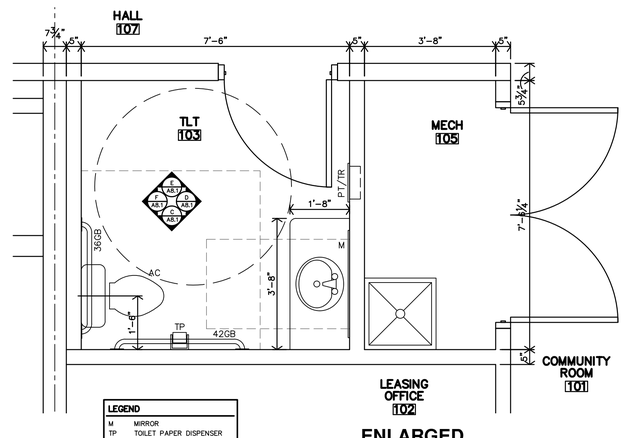

A ENLARGED TOILET #103 PLAN
1/4"=1'-0"

JonesGillamRenz
730 N. Ninth 1881 Main Street, Suite 301
Salina, KS 67401 Kansas City, MO 64108
785.827.0386 jgr@jgrarchitects.com

THE RESIDENCE AT HERITAGE WEST

NEW SENIOR-LIVING FACILITY

ANDOVER, KANSAS

CHRISTOPHER R. GILLAM
6979
1/3/2025
KANSAS ARCHITECT

REVISION:

DATE: 1-3-2025
JOB: 24-3379
SHEET NO.:

A8.1

COPYRIGHTED ©

Wichita-Sedgwick County
Metropolitan Area Building
and Construction Department

REVIEWED FOR CODE COMPLIANCE

CORRECTIONS OR COMMENTS MADE ON THESE DRAWINGS AND THIS DOCUMENT DURING THIS REVIEW DO NOT RELIEVE CONTRACTOR FROM COMPLIANCE WITH ALL REQUIREMENTS OF THE CODE OF THE MABCD, THE CITY OF WICHITA OR SEDGWICK COUNTY. THIS REVIEW IS ONLY FOR GENERAL CONFORMANCE OF THE CODE. THE CONTRACTOR IS RESPONSIBLE FOR CONFORMING AND CORRELATING ALL TECHNIQUES OF CONSTRUCTION. THIS APPROVAL IS SUBJECT TO PROVISIONS OF SECTION 107.4 OF THE 2012 INTERNATIONAL BUILDING CODE.

DATE: 02/19/25 BY: William Jerauld Jr

REFER TO CDS INTERIOR DESIGN PACKAGE.
*ALL DRAWINGS SHOWING BASIC DESIGN INTENT, CONTRACTOR TO REVIEW AND PROVIDE ALL FINISHES, MATERIALS, AND PRODUCTS AS SPECIFIED.

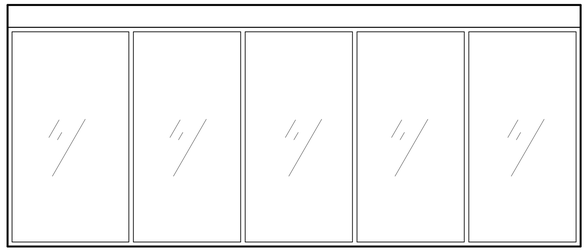

F FITNESS #104
INTERIOR ELEVATION
3/8"=1'-0"

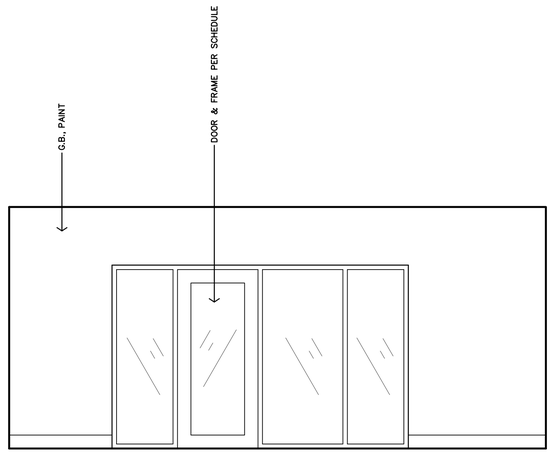

E FITNESS #104
INTERIOR ELEVATION
3/8"=1'-0"

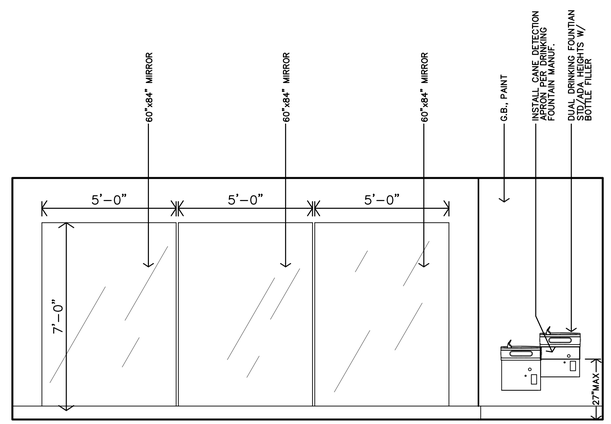

D FITNESS #104
INTERIOR ELEVATION
3/8"=1'-0"

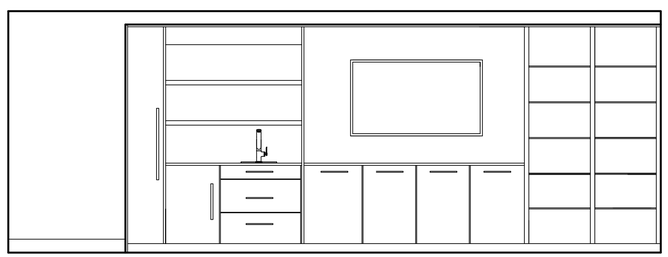

C COMMUNITY ROOM #101
INTERIOR ELEVATION
3/8"=1'-0"

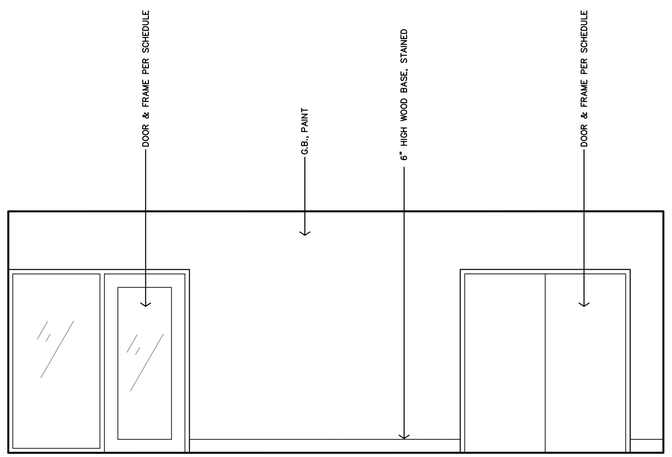

B COMMUNITY ROOM #101
INTERIOR ELEVATION
3/8"=1'-0"

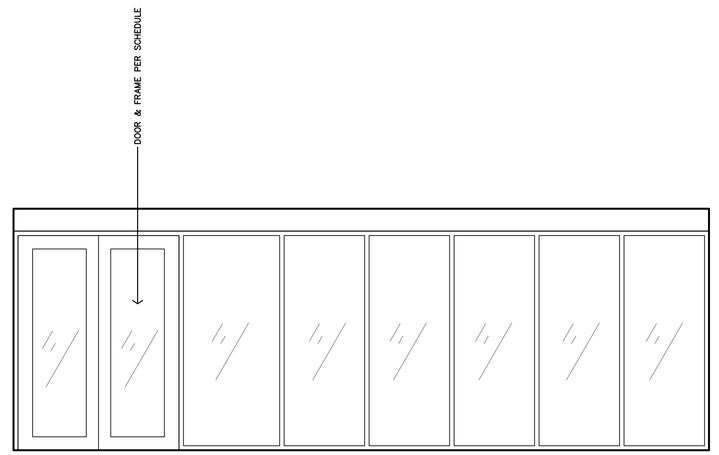

A COMMUNITY ROOM #101
INTERIOR ELEVATION
3/8"=1'-0"

JonesGillamRenz
730 N. Ninth 1881 Main Street, Suite 301
Salina, KS 67401 Kansas City, MO 64108
785.827.0386 jgr@jgrarchitects.com

THE RESIDENCE AT HERITAGE WEST

NEW SENIOR-LIVING FACILITY

ANDOVER, KANSAS

CHRISTOPHER R. GILLAM
REGISTERED ARCHITECT
6979
1/3/2025
KANSAS ARCHITECT

REVISION:

DATE: 1-3-2025
JOB: 24-3379
SHEET NO.:

A8.2

COPYRIGHTED ©

Wichita-Sedgwick County
Metropolitan Area Building
and Construction Department

REVIEWED FOR CODE COMPLIANCE

CORRECTIONS OR COMMENTS MADE ON THESE DRAWINGS AND THIS DOCUMENT DURING THIS REVIEW DO NOT RELIEVE CONTRACTOR FROM COMPLIANCE WITH ALL REQUIREMENTS OF THE CODE OF THE MABCD, THE CITY OF WICHITA OR SEDGWICK COUNTY. THIS REVIEW IS ONLY FOR GENERAL CONFORMANCE OF THE CODE. THE CONTRACTOR IS RESPONSIBLE FOR CONFORMING AND CORRELATING ALL TECHNIQUES OF CONSTRUCTION. THIS APPROVAL IS SUBJECT TO PROVISIONS OF SECTION 107.4 OF THE 2012 INTERNATIONAL BUILDING CODE.

DATE: 02/19/25 BY: William Jerauld Jr

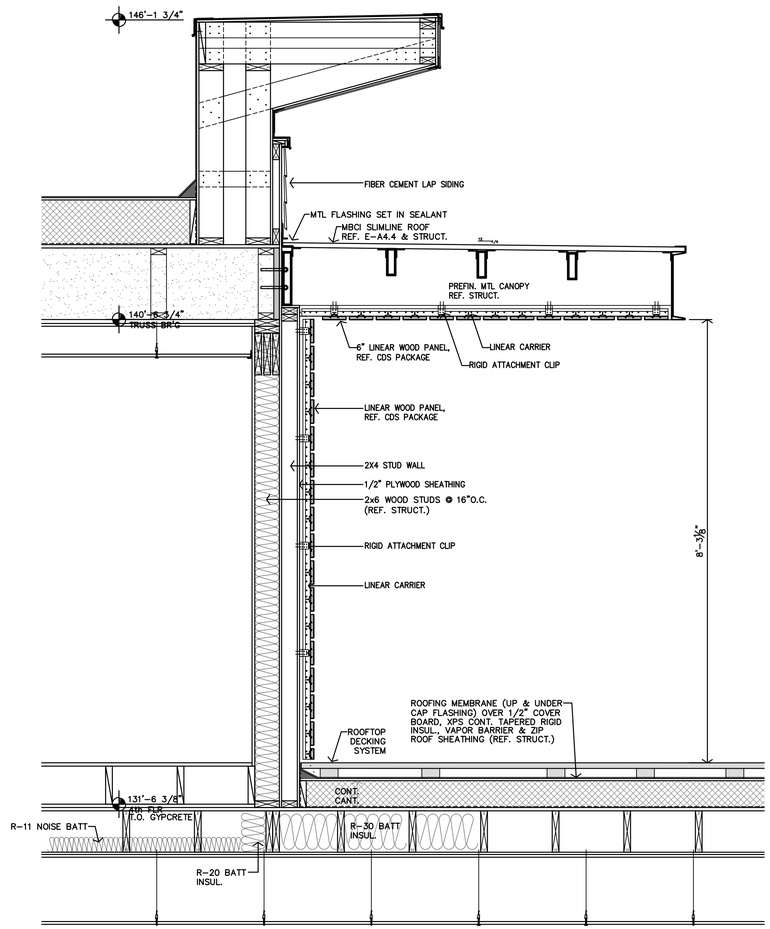

B ROOFTOP DECK WALL SECTION
3/4"=1'-0"

REFER TO CDS INTERIOR DESIGN PACKAGE.
*ALL DRAWINGS SHOWING BASIC DESIGN INTENT, CONTRACTOR TO REVIEW AND PROVIDE ALL FINISHES, MATERIALS, AND PRODUCTS AS SPECIFIED.

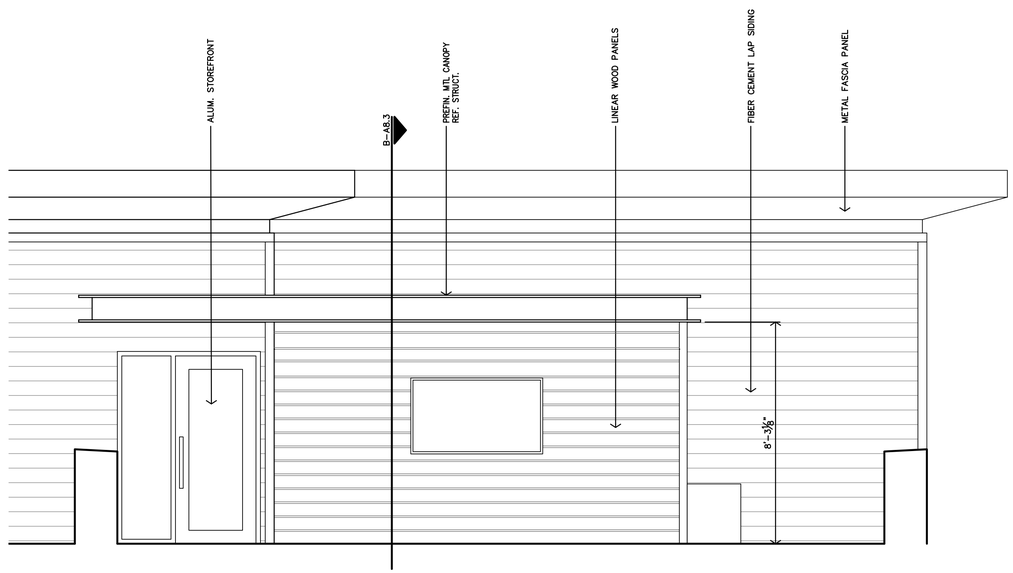

A ROOFTOP DECK ELEVATION
3/8"=1'-0"

JonesGillamRenz
730 N. Ninth 1881 Main Street, Suite 301
Salina, KS 67401 Kansas City, MO 64108
785.827.0386 jgr@jgrarchitects.com

THE RESIDENCE AT HERITAGE WEST

NEW SENIOR-LIVING FACILITY

ANDOVER, KANSAS

CHRISTOPHER R. GILLAM
REGISTERED ARCHITECT
6979
1/3/2025
KANSAS

REVISION:

DATE: 1-3-2025
JOB: 24-3379
SHEET NO.:

A8.3

COPYRIGHTED©

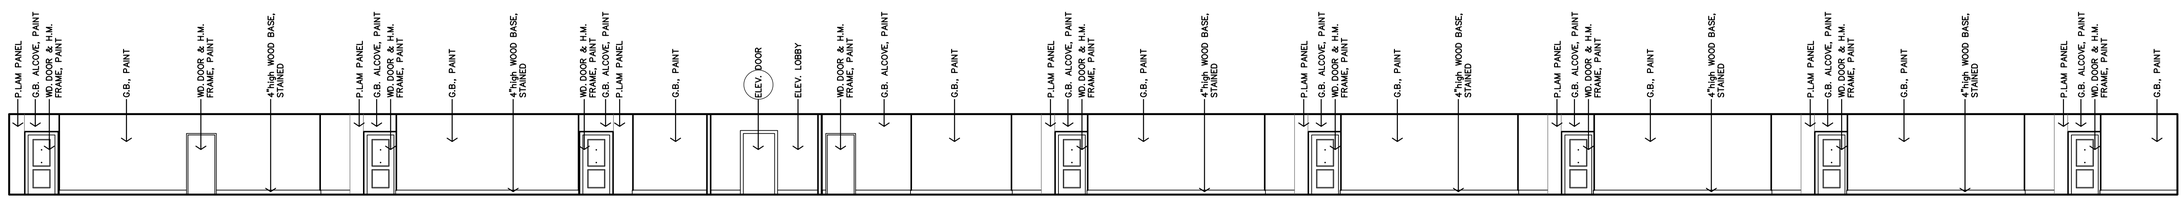

F **HALL #202 & #203 INTERIOR ELEVATION**
1/8"=1'-0" HALLS #302 & #303 SIM.

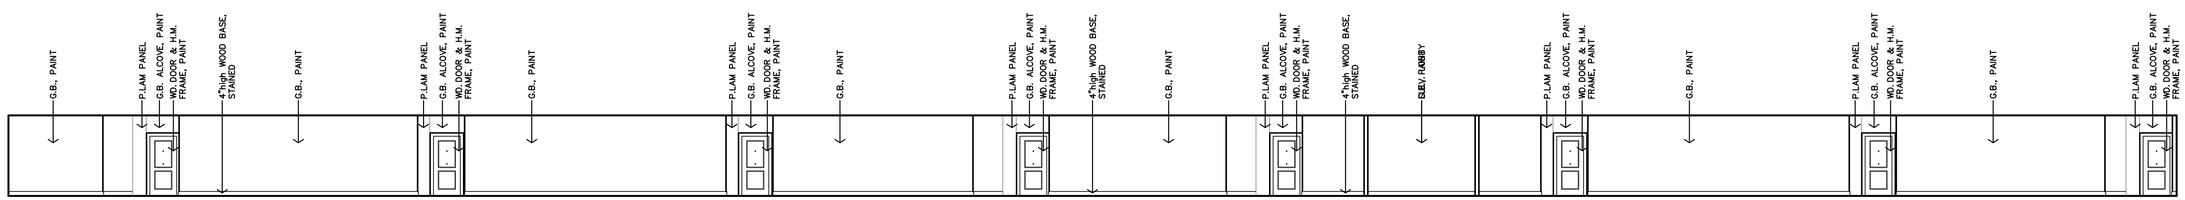

E **HALL #202 & #203 INTERIOR ELEVATION**
1/8"=1'-0" HALLS #302 & #303 SIM.

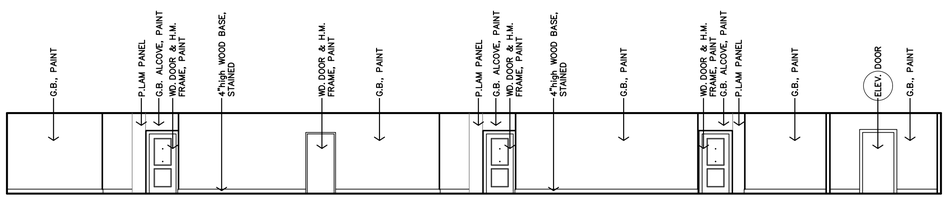

D **HALL #108 INTERIOR ELEVATION**
1/8"=1'-0"

REFER TO CDS INTERIOR DESIGN PACKAGE.
*ALL DRAWINGS SHOWING BASIC DESIGN INTENT, CONTRACTOR TO REVIEW AND PROVIDE ALL FINISHES, MATERIALS, AND PRODUCTS AS SPECIFIED.

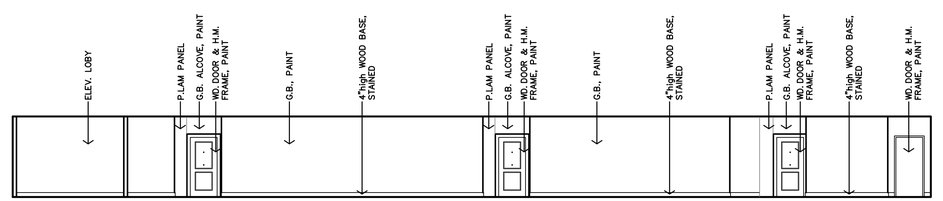

C **HALL #108 INTERIOR ELEVATION**
1/8"=1'-0"

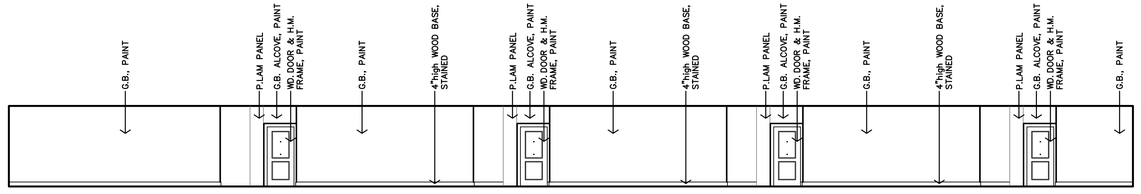

B **HALL #107 INTERIOR ELEVATION**
1/8"=1'-0"

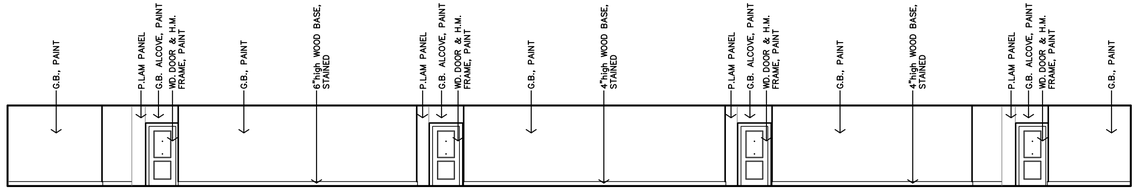

A **HALL #107 INTERIOR ELEVATION**
1/8"=1'-0"

Wichita-Sedgwick County
Metropolitan Area Building
and Construction Department

REVIEWED FOR CODE COMPLIANCE

CORRECTIONS OR COMMENTS MADE ON THESE DRAWINGS AND THIS DOCUMENT DURING THIS REVIEW DO NOT RELIEVE CONTRACTOR FROM COMPLIANCE WITH ALL REQUIREMENTS OF THE CODE OF THE MARCH, THE CITY OF WICHITA OR SEDGWICK COUNTY. THIS REVIEW IS ONLY FOR GENERAL CONFORMANCE OF THE CODE. THE CONTRACTOR IS RESPONSIBLE FOR CONFORMING AND CORRELATING ALL TECHNIQUES OF CONSTRUCTION. THIS APPROVAL IS SUBJECT TO PROVISIONS OF SECTION 107.4 OF THE 2012 INTERNATIONAL BUILDING CODE.

DATE: 02/19/25 BY: William Jerauld Jr

JonesGillamRenz
730 N. Ninth 1881 Main Street, Suite 301
Salina, KS 67401 Kansas City, MO 64108
785.827.0386 jgr@jgrarchitects.com

THE RESIDENCE AT HERITAGE WEST

NEW SENIOR-LIVING FACILITY

ANDOVER, KANSAS

CHRISTOPHER R. GILLAM
REGISTERED ARCHITECT
6979
1/3/2025
KANSAS
ARCHITECT

REVISION:

DATE: 1-3-2025
JOB: 24-3379
SHEET NO.:

A8.4

COPYRIGHTED©

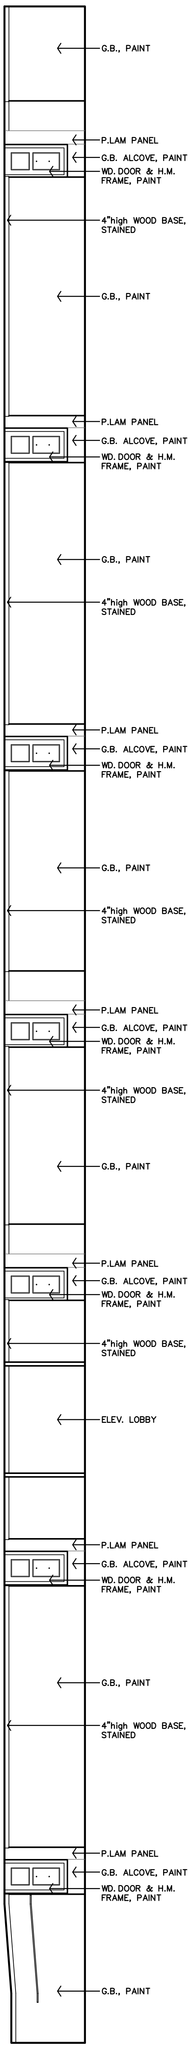

A HALL #403 & #404 INTERIOR ELEVATION
1/8"=1'-0" HALLS #402 & #303 SIM.

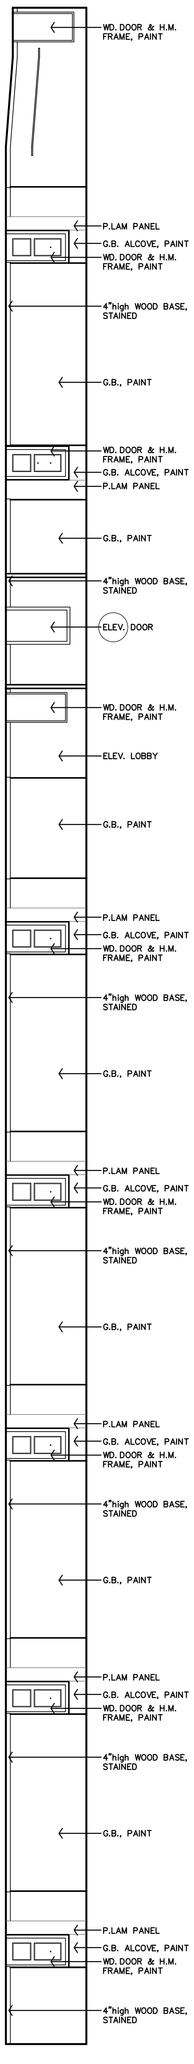

B HALL #403 & #404 INTERIOR ELEVATION
1/8"=1'-0" HALLS #402 & #303 SIM.

REFER TO CDS INTERIOR DESIGN PACKAGE. CONTRACTOR TO REVIEW AND PROVIDE ALL FINISHES, MATERIALS, AND PRODUCTS AS SPECIFIED.

Wichita-Sedgwick County
Metropolitan Area Building
and Construction Department

REVIEWED FOR CODE COMPLIANCE




JonesGillamRenz
730 N. Ninth
Salina, KS 67401
785.827.0386
1881 Main Street, Suite 301
Kansas City, MO 64108
jgr@jgrarchitects.com

THE RESIDENCE AT HERITAGE WEST

NEW SENIOR-LIVING FACILITY

ANDOVER, KANSAS

REGISTERED ARCHITECT
1/6/2025

DATE: 1-3-2025
JOB: 24-3379
SHEET NO.: **A8.5**
REVISION:

COPYRIGHTED ©

Wichita-Sedgwick County
Metropolitan Area Building
and Construction Department

REVIEWED FOR CODE COMPLIANCE

CORRECTIONS OR COMMENTS MADE ON THESE DRAWINGS AND THIS DOCUMENT DURING THIS REVIEW DO NOT RELIEVE CONTRACTOR FROM COMPLIANCE WITH ALL REQUIREMENTS OF THE CODE OF THE MABCD, THE CITY OF WICHITA OR SEDGWICK COUNTY. THIS REVIEW IS ONLY FOR GENERAL CONFORMANCE OF THE CODE. THE CONTRACTOR IS RESPONSIBLE FOR CONFORMING AND CORRELATING ALL TECHNIQUES OF CONSTRUCTION. THIS APPROVAL IS SUBJECT TO PROVISIONS OF SECTION 107.4 OF THE 2012 INTERNATIONAL BUILDING CODE.

DATE: 02/19/25 BY: William Jerauld Jr

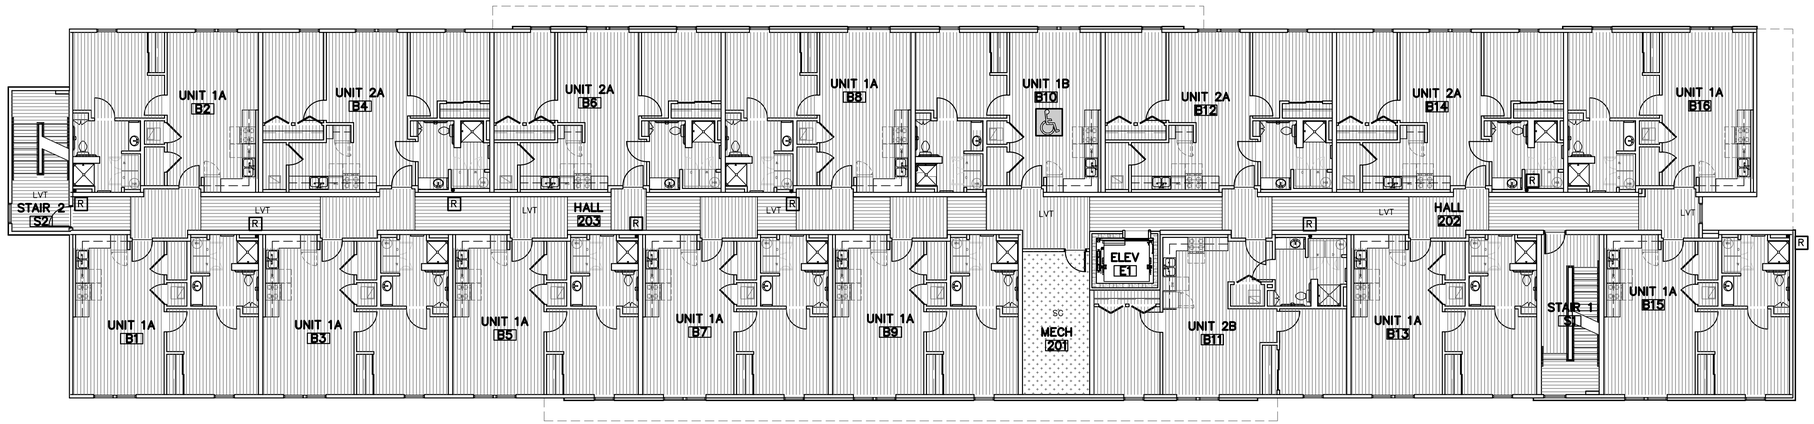

B **SECOND FLOOR PLAN**
3/32"=1'-0"

FLOORING GENERAL NOTES

1. FLOORING CONTRACTOR SHALL VERIFY THAT SUBFLOOR IS LEVEL AND PROPERLY PREPPED PRIOR TO INSTALLATION OF ANY FLOORING MATERIALS.
2. CONTRACTOR SHALL VERIFY THAT FLOORS ARE PREPPED/"FLOORSTONED" FOR LEVEL TRANSITION BETWEEN DIFFERING MATERIALS.
3. CONTRACTOR SHALL COORDINATE WITH INTERIOR ELEVATIONS, FLOOR PLANS AND MISCELLANEOUS DETAILS TO VERIFY ALL AESTHETIC ACCENTS AND DETAILS
4. CUT TILE TIGHT AROUND DOOR FRAMES, AT VCT FLOORS INSTALL CLEAR SILICONE SEALANT AT THE FLOOR/FRAME TRANSITION.
5. INSTALL METAL SCHLUTER TRANSITION BETWEEN FLOOR & WALL MATERIAL TRANSITIONS UNLESS BULLNOSE OR WOOD TRIM IS INDICATED.
6. ADD REDUCER STRIP AT ALL FLOORING TRANSITIONS
7. UNIT KITCHEN & BATH: AT REMOVABLE CABINET FRONTS. WALLS TO BE FINISHED & FLOORING CONTINUOUS UNDERNEATH. NO PLUMBING MODIFICATIONS ALLOWED AFTER CABINET FRONT IS REMOVED.
8. VINYL TILE: PATCH, FILL VOIDS AND ENSURE FLOOR IS LEVEL & READY FOR NEW. INSTALLATION APPROVED BY THE FLOOR MANUFACTURER.
9. CARPET: PATCH, FILL VOIDS, SAND AND LEVEL, BEFORE INSTALLING

FLOORING LEGEND

- SC — SEALED CONCRETE
- CT — CERAMIC TILE
- LVT — LUXURY VINYL TILE
- CONCRETE PAVERS

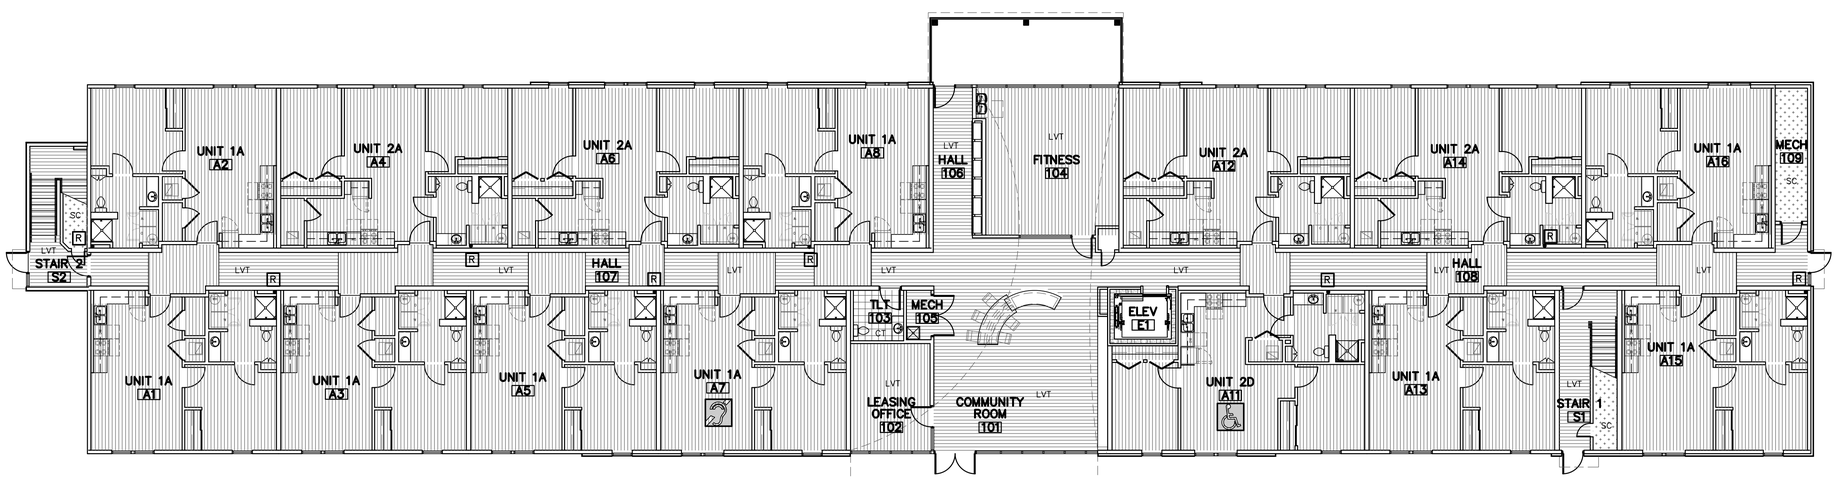

A **FIRST FLOOR PLAN**
3/32"=1'-0"

JonesGillamRenz
730 N. Ninth
Salina, KS 67401
785.827.0386
1881 Main Street, Suite 301
Kansas City, MO 64108
jgr@jgrarchitects.com

THE RESIDENCE AT HERITAGE WEST

NEW SENIOR-LIVING FACILITY

ANDOVER, KANSAS

CHRISTOPHER R. GILLAM
ARCHITECT LICENSED
6979
1/3/2025
KANSAS
ARCHITECT

REVISION:

DATE: 1-3-2025
JOB: 24-3379
SHEET NO.:

A9.1

COPYRIGHTED ©

Wichita-Sedgwick County
Metropolitan Area Building
and Construction Department

REVIEWED FOR CODE COMPLIANCE

CORRECTIONS OR COMMENTS MADE ON THESE DRAWINGS AND THIS DOCUMENT DURING THIS REVIEW DO NOT RELIEVE CONTRACTOR FROM COMPLIANCE WITH ALL REQUIREMENTS OF THE CODE OF THE MABCD, THE CITY OF WICHITA OR SEDGWICK COUNTY. THIS REVIEW IS ONLY FOR GENERAL CONFORMANCE OF THE CODE. THE CONTRACTOR IS RESPONSIBLE FOR CONFORMING AND CORRELATING ALL TECHNIQUES OF CONSTRUCTION. THIS APPROVAL IS SUBJECT TO PROVISIONS OF SECTION 107.4 OF THE 2012 INTERNATIONAL BUILDING CODE.

DATE: 02/19/25 BY: William Jerauld Jr

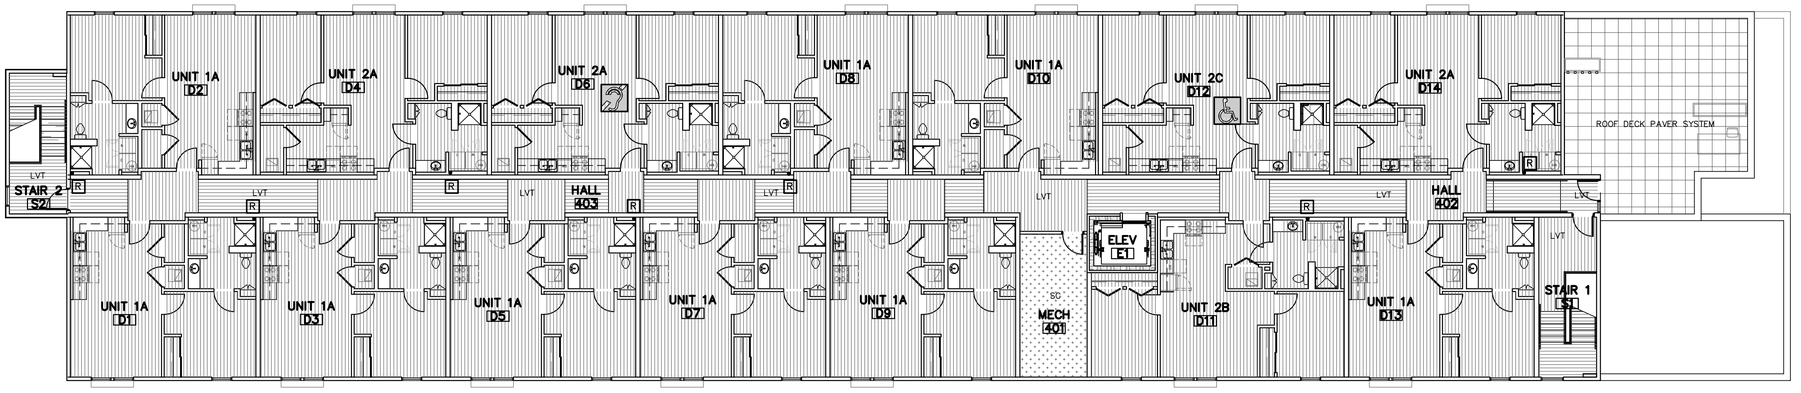

FLOORING GENERAL NOTES

1. FLOORING CONTRACTOR SHALL VERIFY THAT SUBFLOOR IS LEVEL AND PROPERLY PREPPED PRIOR TO INSTALLATION OF ANY FLOORING MATERIALS.
2. CONTRACTOR SHALL VERIFY THAT FLOORS ARE PREPPED/"FLOORSTONED" FOR LEVEL TRANSITION BETWEEN DIFFERING MATERIALS.
3. CONTRACTOR SHALL COORDINATE WITH INTERIOR ELEVATIONS, FLOOR PLANS AND MISCELLANEOUS DETAILS TO VERIFY ALL AESTHETIC ACCENTS AND DETAILS
4. CUT TILE TIGHT AROUND DOOR FRAMES, AT VCT FLOORS INSTALL CLEAR SILICONE SEALANT AT THE FLOOR/FRAME TRANSITION.
5. INSTALL METAL SCHLUTER TRANSITION BETWEEN FLOOR & WALL MATERIAL TRANSITIONS UNLESS BULLNOSE OR WOOD TRIM IS INDICATED.
6. ADD REDUCER STRIP AT ALL FLOORING TRANSITIONS
7. UNIT KITCHEN & BATH: AT REMOVABLE CABINET FRONTS. WALLS TO BE FINISHED & FLOORING CONTINUOUS UNDERNEATH. NO PLUMBING MODIFICATIONS ALLOWED AFTER CABINET FRONT IS REMOVED.
8. VINYL TILE: PATCH, FILL VOIDS AND ENSURE FLOOR IS LEVEL & READY FOR NEW. INSTALLATION APPROVED BY THE FLOOR MANUFACTURER.
9. CARPET: PATCH, FILL VOIDS, SAND AND LEVEL, BEFORE INSTALLING

FLOORING LEGEND

SC	SEALED CONCRETE	CT	CERAMIC TILE
LVT	LUXURY VINYL TILE		CONCRETE PAVERS

B FOURTH FLOOR PLAN
3/32"=1'-0"

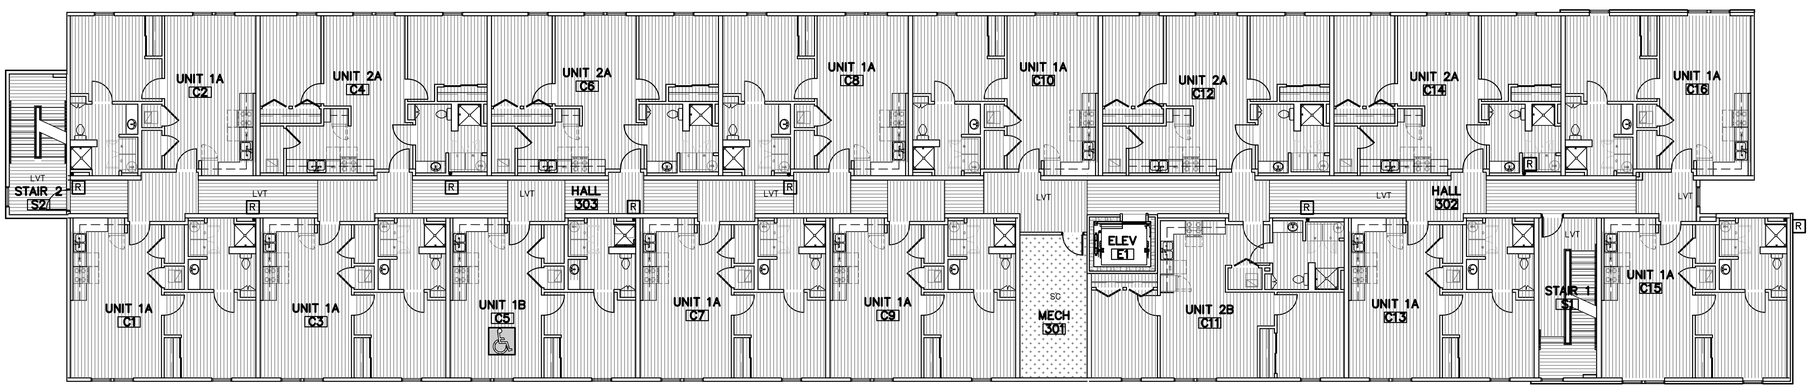

A THIRD FLOOR PLAN
3/32"=1'-0"

JonesGillamRenz
730 N. Ninth
Salina, KS 67401
1881 Main Street, Suite 301
Kansas City, MO 64108
785.827.0386
jgr@jgrarchitects.com

THE RESIDENCE AT HERITAGE WEST

NEW SENIOR-LIVING FACILITY

ANDOVER, KANSAS

CHRISTOPHER R. GILLAM
ARCHITECT LICENSE
6979
1/3/2025
KANSAS
ARCHITECT

REVISION:

DATE: 1-3-2025
JOB: 24-3379
SHEET NO.:

A9.2

COPYRIGHTED ©

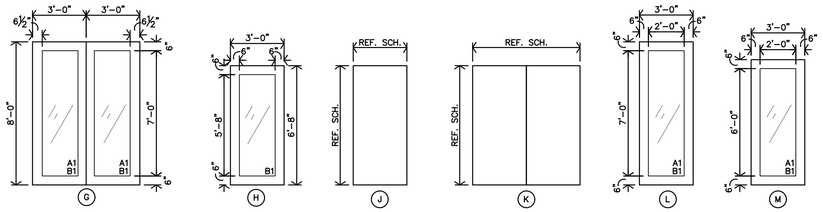

A PUBLIC DOOR TYPES

1/4"=1'-0"

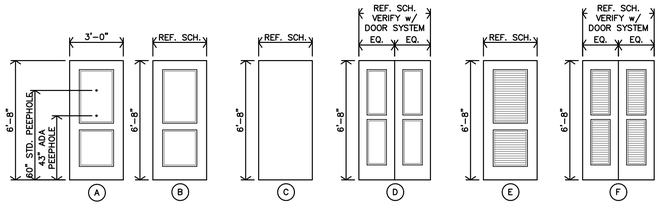

B UNIT DOOR TYPES

1/4"=1'-0"

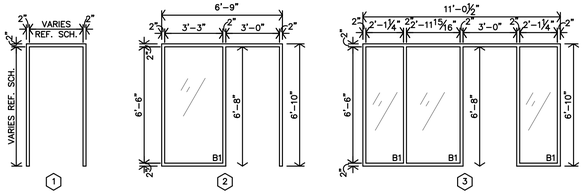

C DOOR FRAME TYPES

1/4"=1'-0"

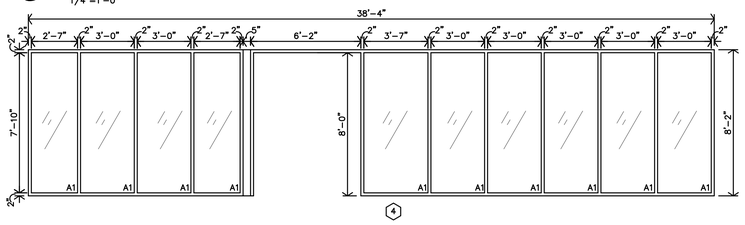

D DOOR FRAME TYPES

1/4"=1'-0"

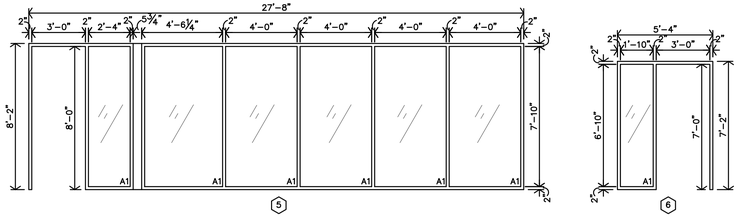

E DOOR FRAME TYPES

1/4"=1'-0"

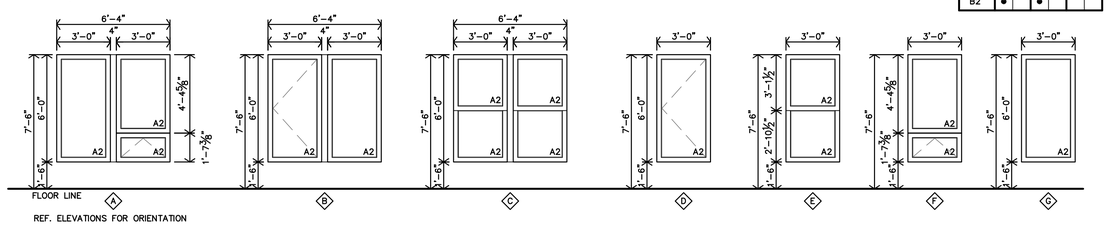

F WINDOW TYPES

1/4"=1'-0"

PUBLIC DOOR SCHEDULE

MARK	DOOR SIZE W	DOOR SIZE H	DOOR SIZE T	DOOR MATERIAL: ALUMINUM	DOOR MATERIAL: HOLLOW METAL	DOOR MATERIAL: S.C. WOOD	DOOR TYPE	DOOR FINISH: PREFINISHED	DOOR FINISH: PAINT	FRAME MATERIAL: ALUMINUM	FRAME MATERIAL: HOLLOW METAL	FRAME TYPE	FRAME FINISH: PREFINISHED	FRAME FINISH: PAINT	RATING	DETAILS	REMARKS
FIRST FLOOR																	
101	PR3'-0"	8'-0"		●			G	●		●			4	●			PANIC HARDWARE
102	3'-0"	6'-8"		●			H	●		●			2	●			
103	3'-0"	6'-8"	1 3/4"			●	J		●	●			1		●		
104	3'-0"	7'-0"	1 3/4"	●			H	●		●			3	●			
105	PR3'-0"	6'-8"	1 3/4"			●	K		●	●			1		●		
106	3'-0"	6'-0"	1 3/4"	●			L	●		●			5	●			
107	3'-0"	7'-0"	1 3/4"		●		J		●		●		1		●	90min	PANIC HARDWARE
108	3'-0"	7'-0"	1 3/4"	●			M	●		●			6		●		PANIC HARDWARE
109	3'-0"	6'-8"	1 3/4"			●	J		●		●		1		●		
111	3'-0"	7'-0"	1 3/4"	●			M	●		●			6		●		PANIC HARDWARE
112	3'-0"	7'-0"	1 3/4"		●		J		●		●		1		●	90min	PANIC HARDWARE
113	3'-0"	7'-0"	1 3/4"	●			M	●		●			6		●		PANIC HARDWARE
114	2'-0"	7'-0"	1 3/4"			●	J		●		●		1		●		
115	2'-0"	7'-0"	1 3/4"			●	J		●		●		1		●		
116	2'-0"	7'-0"	1 3/4"			●	J		●		●		1		●		
SECOND FLOOR																	
201	3'-0"	6'-8"	1 3/4"			●	J		●		●		1		●		
202	3'-0"	7'-0"	1 3/4"		●		J		●		●		1		●	90min	PANIC HARDWARE
203	3'-0"	7'-0"	1 3/4"		●		J		●		●		1		●	90min	PANIC HARDWARE
THIRD FLOOR																	
301	3'-0"	6'-8"	1 3/4"			●	J		●		●		1		●		
302	3'-0"	7'-0"	1 3/4"		●		J		●		●		1		●	90min	PANIC HARDWARE
303	3'-0"	7'-0"	1 3/4"		●		J		●		●		1		●	90min	PANIC HARDWARE
FOURTH FLOOR																	
401	3'-0"	6'-8"	1 3/4"			●	J		●		●		1		●		
402	3'-0"	7'-0"	1 3/4"		●		J		●		●		1		●	90min	PANIC HARDWARE
403	3'-0"	7'-0"	1 3/4"		●		J		●		●		1		●	90min	PANIC HARDWARE
404	3'-0"	6'-8"	1 3/4"	●			M	●		●			6		●		
ELEVATOR																	
E1	3'-6"	7'-0"			●			●			●			●		90min	REF. SHT. A6.4
E2	3'-6"	7'-0"			●			●			●			●		90min	REF. SHT. A6.4
E3	3'-6"	7'-0"			●			●			●			●		90min	REF. SHT. A6.4
E4	3'-6"	7'-0"			●			●			●			●		90min	REF. SHT. A6.4

NOTES:
1. ALL EXPOSED LINTELS TO BE PAINTED AT INTERIOR AND EXTERIOR.
2. CONTRACTOR MUST INSTALL MTL. FLASHINGS & CONT. CAULK FOR A WEATHER & WATERTIGHT CONDITIONS @ ALL EXTERIOR DOORS & DOOR FRAMES/UNITS.
3. ALUMINUM THRESHOLD EXPANSION JOINT COVER BETWEEN CONCRETE AND WOOD FLOOR.

UNIT DOOR SCHEDULE - 60 UNITS - REF. SHEETS A2.4-A2.8

MARK	DOOR SIZE W	DOOR SIZE H	DOOR SIZE T	DOOR MATERIAL: S.C. WOOD, PANEL	DOOR MATERIAL: H.C. WOOD, PANEL	DOOR MATERIAL: H.C. WOOD, LOUVER	DOOR TYPE	DOOR FINISH: BI-FOLD	DOOR FINISH: BI-PASS	DOOR FINISH: POCKET	DOOR FINISH: PREFINISHED	FRAME MATERIAL: PAINT	FRAME MATERIAL: WOOD	FRAME MATERIAL: METAL	FRAME TYPE	FRAME FINISH: PAINT	RATING	DETAILS	REMARKS	LOCATION
1	3'-0"	6'-8"	1 3/4"	●			A				●	●		●	1	●	20min		2, 3, 4	ENTRY
2	3'-0"	6'-8"	1 3/4"	●			B				●	●			1	●			1	BEDROOM
3	PR3'-0"	6'-8"	1 3/4"		●		C		●		●	●			1	●			6	CLOSET
4	(2)2'-0"	6'-8"	1 3/4"		●		D	●			●	●			1	●				CLOSET
5	3'-0"	6'-8"	1 3/4"			●	E				●	●			1	●				MECH./STOR.
6	(2)2'-0"	6'-8"	1 3/4"			●	F	●			●	●			1	●				MECH./STOR.

GENERAL NOTES:
A. ALL DOOR HARDWARE SHALL BE LEVER TYPE LATCH SETS UNLESS NOTED OTHERWISE.PROVIDED & INSTALLED PER SPECIFICATIONS SECTION 8710
B. COORDINATE W/ MFR. FOR ADA INSTALLATION REQUIREMENTS. COORDINATE KEYING REQUIREMENTS WITH OWNER.
C. UNDERCUT DOORS PER MECH DWGS.
D. CONTRACTOR TO REVIEW AND ENSURE THE FOLLOWING ITEMS AND STATUTES HAVE BEEN MET AS WELL.
http://codes.lp.findlaw.com/txstatutes/PR/8/92/D/92.153

SPECIFIC NOTES:
1. BEDROOM & BATH DOOR – HARDWARE TO BE PRIVACY LEVER TYPE LATCH SET.
2. ENTRY DOOR – HARDWARE TO BE LEVER TYPE LATCH SETS, KEYED OUTSIDE, RELEASE INSIDE AND DEADBOLT W/ THUMB TURN INSIDE, NO KEY OUTSIDE W/ 1" MIN THROW. COORDINATE W/ MFR. FOR ADA INSTALLATION REQUIREMENTS. COORDINATE KEYING REQUIREMENTS WITH OWNER.
3. ENTRY DOOR – 180° PEEP HOLES at ADAPTABLE UNITS: (1) PEEP HOLE TO BE INSTALLED @ 60"AFF.
4. ENTRY DOOR – 180° PEEP HOLES at ACCESSIBLE UNITS: (2) PEEP HOLES TO BE INSTALLED @ 43"AFF & 60"AFF.
5. BI-PASS/BI-FOLD DOORS – VERIFY OPENING w/ SIZE OF DOOR HARDWARE.

GLAZING SCHEDULE

MARK	INTERIOR	EXTERIOR	1/4"	3/4" INSULATED	TINTED	TEMPERED
A1		●		●	●	●
A2		●		●	●	
B1	●		●			●
B2	●		●			

WINDOW SCHEDULE

MARK	WIDTH	HEIGHT	STYLE	QUANTITY	INTERIOR	EXTERIOR	DETAILS
A	6'-4"	6'-0"	VINYL – FIXED & AWNING VENT			●	
B	6'-4"	6'-0"	VINYL – CASEMENT & FIXED			●	
C	6'-4"	6'-0"	VINYL – (2)SINGLE HUNG			●	
D	3'-0"	6'-0"	VINYL – CASEMENT			●	
E	3'-0"	6'-0"	VINYL – SINGLE HUNG			●	
F	3'-0"	6'-0"	VINYL – AWNING VENT			●	
G	3'-0"	6'-0"	VINYL – FIXED			●	

NOTES:
1. CONTRACTOR MUST INSTALL MTL. FLASHINGS & CONT. CAULK FOR A WEATHER & WATERTIGHT CONDITIONS @ ALL EXTERIOR WINDOW UNITS.
2. CONTRACTOR MUST INSTALL 1/4" INSUL. OR THERMAL BREAK. CONTINUOUS AROUND WINDOW.
3. CONTRACTOR TO PROVIDE & INSTALL MANUFACTURERS COORDINATING PANNING SYSTEM FOR ALUM. WINDOWS.
4. ALL SECOND FLOOR WINDOWS AND OPERABLE WINDOWS W/ THE SILL 6'-0" ABOVE GRADE, SHALL BE PROVIDE W/ WINDOW OPENING CONTROL DEVICE PER ASTM 2090 & 2012
5. IBC SEC. 1015.8.1
6. PROVIDE & INSTALL SAFETY GLASS AT HAZARDOUS LOCATIONS, PER 2018 IBC CODE 2406. IN DOORS, ADJACENT & WITHIN 24" TO DOORS, LESS THAN 18" ABV FLOOR, IN GUARDS & HANDRAILS, ADJACENT TO STAIRS AND RAMPS, STAIRS AND RAMPS.
7. EMERGENCY ESCAPE & RESCUE: PER 2012 IBC SEC. 1030. 20"w X 24"h MIN. OPENINGS, 5.7sf MIN. AREA (ALSO REF. 1030.4)

Wichita-Sedgwick County
Metropolitan Area Building
and Construction Department

REVIEWED FOR CODE COMPLIANCE

CORRECTIONS OR COMMENTS MADE ON THESE DRAWINGS AND THIS DOCUMENT DURING THIS REVIEW DO NOT RELIEVE CONTRACTOR FROM COMPLIANCE WITH ALL REQUIREMENTS OF THE CODE OF THE MARCH. THE CITY OF WICHITA OR SEDGWICK COUNTY. THIS REVIEW IS ONLY FOR GENERAL CONFORMANCE OF THE CODE. THE CONTRACTOR IS RESPONSIBLE FOR CONFORMING AND CORRELATING ALL TECHNIQUES OF CONSTRUCTION. THIS APPROVAL IS SUBJECT TO PROVISIONS OF SECTION 107.4 OF THE 2012 INTERNATIONAL BUILDING CODE.

DATE: 02/19/25 BY: William Jerauld Jr

PUBLIC FINISH SCHEDULE

REF. INTERIOR DESIGN PACKAGE

NO.	DESCRIPTION	FLOOR	BASE	N.WALL	E.WALL	S.WALL	W.WALL	CEILING	REMARKS
FIRST FLOOR									
101	COMMUNITY ROOM								
102	LEASING OFFICE								
103	TOILET								
104	FITNESS								
105	MECH								
106	HALL								
107	HALL								
108	HALL								
109	MECH								
SECOND FLOOR									
201	MECH								
202	HALL								
203	HALL								
THIRD FLOOR									
301	MECH								
302	HALL								
303	HALL								
FOURTH FLOOR									
401	MECH								
402	HALL								
403	HALL								
STAIR & ELEVATOR									
E1	ELEVATOR								
S1	STAIR								
S2	STAIR								

PUBLIC FINISH SCHEDULE - REF. INTERIOR DESIGN PACKAGE

FINISH SCHEDULE NOTES

GENERAL NOTES:
A. INSTALL VINYL, RUBBER, OR ALUMINUM TRANSITION STRIP BETWEEN FLOOR MATERIAL OF DIFFERING HEIGHTS, INCLUDING BUT NOT LIMITED TO CONCRETE/VCT TRANSITIONS.
B. ALL GYPSUM BOARD AREAS WHICH ARE ACCESSORIES TO THE ROOM INCLUDING BUT NOT LIMITED TO SOFFITS, BULKHEADS, TRIM, ETC. SHALL BE PAINTED REGARDLESS OF WHETHER IT IS SPECIFICALLY INDICATED PER SCHEDULE.
C. ALL G.B. WALLS & PERMANENT PARTITIONS SHALL RECEIVE RUBBER BASE UNLESS NOTED OTHERWISE.
D. WALL TYPE SHOWN FOR GENERAL INFORMATION ONLY. CONTRACTOR SHALL COORDINATE WALL MATERIAL W/ DRAWINGS AND FIELD CONDITIONS. ALL AREAS INDICATED TO RECEIVE NEW FINISH SHALL RECEIVE COMPLETE FINISH AS SCHEDULED AT ENTIRE ROOM. CONTRACTOR SHALL COORDINATE FINISHES AND ACCENTS WITH DETAILS AND INTERIOR ELEVATIONS.
E. FLOORING CONTRACTOR SHALL VERIFY THAT SUBFLOOR IS LEVEL AND PROPERLY PREPPED PRIOR TO INSTALLATION OF ANY FLOORING MATERIALS.
F. CONTRACTOR SHALL VERIFY THAT FLOORS ARE PREPPED/"FLOORSTONED" FOR LEVEL TRANSITION BETWEEN DIFFERING MATERIALS.
G. INSTALL PAINTABLE SILICONE SEALANT AT ALL G.B. TO CMU AND G.B. TO CONCRETE WALL TRANSITIONS.
H. ALL CONTROL JOINTS AT EXPOSED CONCRETE FLOORS SHALL RECEIVE SEALANT COMPATIBLE W/ FLOOR SEALER.
I. ALL H.M. DOORS & FRAMES TO BE PAINTED W/ INDUSTRIAL ENAMEL UNLESS NOTED OTHERWISE. H.M. DOORS AND FRAMES SHALL BE SANDED SMOOTH PRIOR TO PAINTING. SPRAY FINISH ONLY – NO BRUSH FINISH. CONTRACTOR SHALL
J. COORDINATE WITH INTERIOR ELEVATIONS, FLOOR PLANS AND MISCELLANEOUS DETAILS TO VERIFY ALL AESTHETIC ACCENTS AND DETAILS.
K. REFERENCE INTERIOR ELEVATIONS, WALL SECTIONS AND DETAILS FOR WOOD BASE AND TRIM LOCATIONS.

SPECIFIC NOTES:
1. REFERENCE REFLECTED CEILING PLAN, COORDINATE LOCATION OF CEILING ACCENTS.
2. CARPET AT ALL LANDINGS. INSTALL RUBBER STAIR NOSING AT EACH RISER. EXTEND CARPET UP THE RISER BEHIND THE NOSING.
3. INSTALL FRP PANEL TO 4'-0" ABOVE MOP SINK AND EXTEND 1'-0" MINIMUM BEYOND EDGES OF SINK; CLASS "A" FIRE RESISTIVE MATERIAL.
4. LEVEL 4 FINISH WITH ORANGE PEEL TEXTURE AT ALL CEILINGS.
5. MULTIPLE WALL PAINT COLORS.
6. CERAMIC WALL TILE BEHIND DRINKING FOUNTAINS. REFERENCE INTERIOR ELEVATIONS.

UNIT FINISH SCHEDULE - 60 UNITS - REF. SHTS. A2.4-A2.5

REF. INTERIOR DESIGN PACKAGE

NO.	DESCRIPTION	FLOOR: CARPET	FLOOR: VINYL PLANK FLR'G TILE	FLOOR: SEALED CONCRETE	FLOOR: WOOD	BASE	N.WALL	E.WALL	S.WALL	W.WALL	CEILING	REMARKS
01	KITCHEN		VP		P		P		P		P	
02	LIVING ROOM		VP		P		P		P		P	
03	BATH		VP		P		P		P		P	
04	LAUNDRY		VP		P		P		P		P	
05	BEDROOM		VP		P		P		P		P	
06	CLOSET		VP		P		P		P		P	
07	BEDROOM		VP		P		P		P		P	
08	CLOSET		VP		P		P		P		P	
09	MECH		VP		P		P		P		P	
10	STORAGE		VP		P		P		P		P	

JonesGillamRenz
730 N. Ninth
Salina, KS 67401
1881 Main Street, Suite 301
Kansas City, MO 64108
785.827.0386
jgr@jgrarchitects.com

THE RESIDENCE AT HERITAGE WEST

NEW SENIOR-LIVING FACILITY

ANDOVER, KANSAS

CHRISTOPHER R. CLINKENBEARD
6979
1/3/2025
KANSAS
ARCHITECT

REVISION:

DATE: 1-3-2025
JOB: 24-3379
SHEET NO.:

A10.1

COPYRIGHTED ©

GENERAL NOTES - STRUCTURAL

1. The contractor shall verify dimensions and conditions before construction and notify the engineer of any discrepancies, inconsistencies, or difficulties affecting the work before proceeding.
2. The contractor shall coordinate all disciplines, verifying size and location of all openings, whether shown on structural drawings or not, as called for on architectural, mechanical, or electrical drawings. All conflicts, inconsistencies, or other difficulties affecting structural work shall be called to the architect or engineer's attention for direction before proceeding.
3. All design and construction work for this project shall conform to the requirements of the 2018 International Building Code, as amended by the City of Andover, Kansas.
4. These drawings are for this specific project and no other use is authorized.

5. Structural Design Load Criteria:
   - A. Dead Load:
     - Roofs = 20 psf
     - Rooftop Patio = 100 psf
   - B. Live Load:
     - Roofs = 25 psf
     - Floors = 40 psf
     - Maintenance Platform = 40 psf
     - Public = 100 psf
   - C. Snow:
     - Pg = 20 psf, Ce = 1.0
     - Pf = 14 psf, Ps = 14 psf, Pm = 20 sf
     - Is = 1.0, Ce = 1.0, CL = 1.0
     - Drift & unbalanced snow loads per ASCE/SEI 7-10
   - D. Lateral Loads:
     1.) Wind V = 115 mph, exposure B. GCpi = +/- 1.0B
     Design wind pressures to be used for the deisgn of exterior components and cladding materials on the designated zones of walls and roof structures shall be per Section 30.1 and Table 30.1-2 of ASCE/SEI 7-10. Tabulated pressures shall be multiplied by effective are reduction factors, exposure adjustment factors, and topographic factors where applicable.
     2.) Seismic - Ss = 0.105, S1 = 0.034, IE = 1.0
     Site Classification D (Assumed).
     Seismic Design Category B.
     Basic Seismic Force-Resisting System:
     A.) T- Light-Framed Walls with Shear Panels of All Other Materials
     R=2, Omega = 2 1/2, Cd = 2, V= 1.009W
   - E. This project is designed to resist the most critical effects resulting from the load combinations of section 1605.3 of the 2018 International Building Code.

6. Concrete:
   - A. All concrete for foundations (walls, grade beams, and footings) shall develop minimum ultimate compressive design strength of 3500 psi in 28 days, but not less than 500 pounds of cement shall be used per cubic yard of concrete regardless of strengths obtained, not over 6 gallons of water per 100 pounds of cement and not over 4 inches of slump.
   - B. All concrete for interior flat work shall develop minimum ultimate compressive design strength of 4000 psi in 28 days, but not less than 560 pounds of cement shall be used per cubic yard of concrete regardless of strengths obtained, not over 5 gallons of water per 100 pounds of cement and not over 4 inches of slump.
   - C. Concrete for exterior flatwork shall have a minimum design compressive strength of 4500 psi in 28 days, with not less than 560 pounds of cement per cubic yard of concrete, not over 5 gallons of water per 100 pounds of cement, with 6% +/- 1% air entrainment, and a maximum of 4 inches of slump.
   - D. The preceding minimum mix requirements may have water-reducing admixtures conforming to ASTM C494 added to the mix at manufacturer's dosage rates for improved workability.
   - E. The preceding minimum mix requirements may have up to 15% maximum of the cement content replaced with an approved ASTM C618 Class C fly ash, provided the total minimum cementitious content is not reduced.
   - F. All interior concrete slabs on grade shall be placed over 15 mil, Class A Vapor Barrier per ASTM E1745 with less than 0.01 perms, tested after mandatory conditioning. All joints shall be lapped and sealed per manufacturer's recommendations. All penetrations, as well as damaged vapor barrier material shall also be sealed per manufacturer's recommendation prior to concrete placement. Install barrier per manufacturer recommended details at all discontinuous edges (at interior columns, exterior edge of slab, etc.) to ensure terms of warranty are followed. The vapor barrier shall be placed over free-draining granular material as prescribed by the project soils report.
   - G. All concrete is reinforced concrete unless specifically called out as unreinforced. Reinforce all concrete not otherwise shown with same steel as in similar sections or areas. Any details not shown shall be detailed per ACI 315 and meet requirements of ACI 318, current editions.
   - H. Contractor shall verify that all concrete inserts, reinforcing and embedded items are correctly located and rigidly secured prior to concrete placement.
   - I. Construction joints in beams, slabs, and grade beams shall occur at midspan (middle third) unless noted otherwise. Provide 2 x 4 horizontal keys at construction joints for shear transfer.
   - J. No aluminum items shall be embedded in any concrete.

7. Reinforcing Steel:
   - A. All reinforcing steel shall conform to the requirements of ASTM A615 or A706 grade 60 steel. Welded plain wire fabric shall be supplied in sheets and conform to the requirements of ASTM A185.
   - B. Clear minimum coverage of concrete over reinforcing steel shall be as follows:
     - Concrete placed against earth 3"
     - Formed concrete against earth 2"
     - Slabs 1"
     - Other 2"

     All coverage shall be nominal bar diameter minimum.
   - C. All dowels shall be the same size and spacing as adjoining main bars (splice lap 48 bar diameters or 30" minimum unless noted otherwise).
   - D. At corners of all walls, beams, and grade beams supply corner bars (minimum 2'-6" in each direction or 48 bar diameters) in outside face of wall, matching size and spacing of horizontal bars. Where there are no vertical bars in outside face of wall, supply 3 - #4 vertical support bars for corner bars.
   - E. Bars marked continuous shall be lapped 48 bar diameters (3'-0" minimum) at splices and embedments, unless shown otherwise. Splice top bars near midspan and splice bottom bars over supports, unless noted otherwise.
   - F. Accessories shall be as specified in latest edition of the ACI Detailing Handbook and the concrete Reinforcing Steel Institute Design Handbook. Maximum accessory spacing shall be 4'-0" on center, and all accessories on exposed surfaces are to have plastic coated feet.
   - G. All slabs and stairs not shown otherwise shall be 6" thick with #4 bars at 12" on center each way.

8. Structural Steel:
   - A. All structural steel beams and columns shall be ASTM A992, grade 50 steel and all miscellaneous steel shall be ASTM A36 grade steel. Hollow Structural Sections (HSS) shall be ASTM A500, grade B. Fabrication and erection shall be in accordance with AISC 303-05 "Code of Standard Practice for Steel Buildings and Bridges" in the 13th Edition of the AISC Steel Construction Manual.
   - B. All welding shall conform to the recommendations of the AWS.
   - C. All bolts not otherwise specified shall be 3/4" diameter high strength (ASTM A325-N). All bolts shall be fully pretensioned. All beam connections shall be designed per the AISC Manual of Steel Construction "Framed Beam Connections" for 40 kip reactions, and, shall account for eccentricity when the bolt line is more than 2" from the center of the support. All connections must be two bolt minimum.
   - D. All anchor bolts shall be 3/4" diameter, ASTM F1554, Grade 36 unless noted otherwise.

9. Foundations:
   - A. The soil investigation was prepared by Terracon, the report number is 01245160 and their telephone number is 913-492-7777.
   - B. Spread footings and continuous wall footings are designed to bear on soil capable of safely sustaining 2500 psf.
   - C. Contractor shall provide for dewatering at excavations from either surface water or seepage.
   - D. All foundation excavations shall be inspected by a qualified soil engineer, approved by the architect and/or structural engineer, prior to placement of steel or concrete. This inspection shall be at the owner's expense.
   - E. Moisture content in soils beneath building locations should not be allowed to change after footing excavations and after grading for slabs on grade are completed. If subgrade materials become desiccated or softened by water or other conditions, recompact materials to the density and water content specified for engineered fill. Do not place concrete on frozen ground.

10. Concrete Block Masonry
    - A. Concrete block used in exterior walls or load bearing walls shall meet the requirements of ASTM C90 and have a minimum net compressive strength of 2150 psi and laid up using type N mortar such that f'm equals 1500 psi. Mortar shall be volume proportion based cement lime mortar. Proportioning shall be completed by box measure. Any block in contact with earth shall be normal weight units, laid using type "S" mortar and grouted solid.
    - B. The contractor shall provide adequate temporary bracing for all masonry walls during construction.
    - C. All concrete block shall have 9 gage (or larger) horizontal joint reinforcing (ladder or truss) per architectural drawings and specifications (16" maximum vertical spacing).
    - D. Concrete block shall be reinforced as follows in 8" walls unless noted otherwise:
      - 1.) Vertical reinforcing shall be a minimum of 1 - #4 bar in 8" walls at 4'-0" on center, at each corner, at each door and window jamb, each side of control joints and in the end void of each length of wall. Lap splices for masonry vertical reinforcing shall be 48 bar diameters or 24" minimum.
      - 2.) Horizontal reinforcing:
        - A) Horizontal joint reinforcing as noted above.
        - B) Continuous horizontal bars shall be included per section or detail in bond beam or optional running bond beam where noted. Where bond beams are continuous at corners of walls, supply corner bars matching size of horizontal bars (minimum 2'-0" or 40 bar diameters in each direction).
    - E. Grout, where noted above, shall have a minimum design ultimate compressive strength of 2500 psi at 28 day test and 3/8" maximum aggregate size.
    - F. Lintels over all openings in walls not otherwise covered shall be an 8" x 8" bond beam with 2 - #6 bars in the bottom of the bond beam.

11. Post-Installed Anchors:
    - A. Post-installed anchors shall be used only where specified on the drawings unless approved in writing by the engineer of record. See drawings for anchor diameter, spacing and embedment. Performance values of the anchors shall be obtained for specified products using appropriate design procedures and/or standards as required by the governing building code. Anchors installed in concrete shall have an ICC-ES Evaluation Service Report. Special inspection is required for all post-installed anchors.
    - B. Mechanical anchors used in cracked and uncracked concrete shall have been tested and qualified for use in accordance with ACI 355.2 and ICC-ES AC193. All anchors shall be installed per the anchor manufacturer's written instructions.
    - C. Adhesive anchors used in cracked and uncracked concrete shall have been tested and qualified for use in accordance with ICC-ES AC308. All anchors shall be installed per the anchor manufacturer's written instructions.

12. Timber and Wood Framing:
    - A. Quality and construction of wood framing members and their fasteners for load supporting purposes not otherwise indicated on the drawings shall be in accordance with the 2018 International Building Code.
    - B. All studs and top and bottom plates shall be Douglas Fir No. 2 grade visually graded lumber, with an allowable fiber stress in bending of 900 psi minimum and an elastic modulus of 1,600,000 psi unless noted otherwise. All joist, truss members and headers to be No. 2 grade (min.) (unless noted otherwise).
    - C. Bridging of stud bearing walls and shear walls shall be solid, matching sheathing joints.
    - D. Joist blocking and bridging shall be solid wood or cross bridging of either wood or metal straps. Spacing, in any case, shall not exceed 8'-0".
    - E. Wood members and sheathing shall be fastened with number and size of fasteners not less than that set forth in Table 2304.9.1 of the 2018 International Building Code. Floor sheathing shall be APA rated tongue and groove Sturd-I-Floor, exposure 1, glued and nailed with 10d nails or #10 screws at 6" on center to supports at edges and 12" on center field. Sheathing of shear walls or roof diaphragms shall be edge nailed with 8d common nails at 6" on center and nailed to intermediate framing and/or blocking members with 8d common nails at 12" on center unless otherwise noted on the drawings.
    - F. Sill plates shall be bolted to concrete slabs with ½" diameter bolts at 32" on center (UNO, Re: shearwall sched). Provide plate washers at sill plate anchors for shearwalls per shearwall sched. Plates in direct contact with concrete or masonry shall be treated lumber.
    - G. All hangers, ties and connections shown are based on Simpson Strong Tie as the basis of design, provide Simpson Strong Tie or an approved equal. Joist hangers shall be equal to "LUS" for wood application and "LB" for steel weld-on application. Roof truss ties shall be equal to "H2.5A" and tie the roof truss to the top plate (provide (2) "H2.5A" Diagonally across from each other when uplift load shown in truss shop submittal exceeds 600lbs). Roof girder ties shall be equal to a "LGT2", "LGT3" or "LGT4" tie (dependent on number of plies) and tie the truss girder to the top plate. Provide "H4" at the top of each stud to top track when the top track has roof truss attached.
    - H. Service condition - dry with moisture content at or below 19% in service.
    - I. Laminated strand lumber (LSL) shall have an allowable flexural stress (Fb) of 1,700 psi (reduced by size factor) and an elastic modulus (E) of 1,300,000 psi.
    - J. Laminated veneer lumber (LVL) shall have an allowable flexural stress (Fb) of 2,600 psi (reduced by size factor) and an elastic modulus (E) of 1,900,000 psi.
    - K. Parallel Strand Lumber (PSL) shall have an allowable flexural stress (Fb) of 2,900 psi (reduced by size factor) and an elastic modulus (E) of 2,000,000 psi. (E) x 2,200,000 psi for members > 18").
    - L. Pre-engineered wood trusses shall be designed in accordance with the Truss Plate Institute's national design standard for metal-plate connected wood truss construction (ANSI/TPI-1 latest edition). Trusses shall be designed and manufactured by an authorized member of the Wood Truss Council of America (WTCA). Truss design shall conform to specified codes, allowable stress increases, deflection limitations and other applicable criteria of the governing code.
    - M. Truss shop drawings showing complete erection and fabrication details and calculations (including connections) shall be submitted to the project architect / engineer for review prior to fabrication and/or erection. Calculations shall bear the seal of a professional engineer, registered in the state of the project location. Shop drawings shall also be submitted to the local government controlling agency when requested by that agency.
    - N. All trusses shall be securely braced both during erection and permanently, as indicated on the approved truss design drawings and in accordance with TPI's commentary and recommendations for handling, installing and bracing metal-plate connected wood trusses (HIB-91, booklet) and the latest edition of ANSI/TPI-1.
    - O. The truss manufacturer shall supply all hardware and fasteners for joining truss members together and fastening truss members to their supports. Metal connector plates shall be manufactured by a member of the Wood Truss Council of America (WTCA) and shall be 20 gauge minimum. Connector plates shall meet or exceed ASTM A653, grade 33, with ASTM A924 galvanized coating designation 060.
    - P. Provide truss space directly above and centered over HVAC closets. Refer to Architectural and MEP drawings for exact locations.
    - Q. Shipment, handling, and erection of trusses shall be by experienced, qualified persons and shall be performed in a manner so as not to endanger life or property. Apparent truss damage shall be reported to the truss manufacturer for evaluation prior to erection. Cutting or alteration of trusses is not permitted.
    - R. Pre-Engineered Floor Trusses Design Criteria:
      - Top Chord Dead Load = 30 psf
      - Top Chord Live Load = Per General Note 5B
      - Bottom Chord Dead Load = 10 psf
      - Live Load Deflection = L/480, ½" max)
      - Total Load Deflection = L/360
      - Refer to Sheet S2.4 for 4th floor roof & exterior deck load criteria.
    - S. Roof Truss Design criteria:
      - Top Chord Dead Load = 10 psf
      - Top Chord Live Load = 25 psf (Plus Rooftop Equipment)
      - Top Chord Snow Load = 20 psf or 14 psf plus Drift
      - Bottom Chord Dead Load = 10 psf
      - Bottom Chord Live Load = 5 psf
      - Live Load Deflection = L/360
      - Total Load Deflection = L/300
      - Refer to Sheet S2.4 for 4th floor roof & exterior deck load criteria.
    - T. Roof trusses shall be designed per IBC 2018 for net uplift resulting from wind loading as calculated using components and cladding loading.
    - U. Construction bracing shall be provided by the contractor as required to keep the building and studs plumb.
    - V. Structural members shall not be cut for pipes, etc., unless specifically detailed. Notching and boring of studs and top of plates shall conform to the provisions of section 2308.9.10 and 2308.9.11 of the IBC. Where top plates or sole plates are cut for pipes, a metal tension tie with minimum 0.058 inches thick and ½" inches wide shall be fastened to each plate across and to each side of the opening with not less than (6) 16d nails, in accordance section 2308.9.8 of the IBC.
    - W. All fasteners for wood to wood connections and wood connectors shall be as indicated in structural drawings or manufacturer literature to achieve full capacity of connector. Alternate fasteners may be submitted as a substitution request. Submittal must show that alternative fasteners will not reduce the capacity of the connection.

13. Shop Drawing Review:
    - A. Bob D. Campbell and Company, Inc. will review the General Contractor's (GC) shop drawings and related submittals (as indicated below) with respect to the ability of the detailed work, when complete, to be a properly functioning integral element of the overall structural system designed by Bob D. Campbell and Company, Inc.
    - B. Prior to submittal of a shop drawing or any related material to Bob D. Campbell and Company, Inc., the GC shall:
      - 1.) Review each submission for conformance with the means, methods, techniques, sequences and operations of construction and safety precautions and programs incidental thereto, all of which are the sole responsibility of the GC.
      - 2.) Review and approve each submission.
      - 3.) Stamp each submission as approved.
    - C. Bob D. Campbell and Company, Inc. shall assume that no submission comprises a variation unless the GC advises Bob D. Campbell and Company, Inc. with written documentation.
    - D. Shop drawings and related material (if any) required are indicated below. Should Bob D. Campbell and Company, Inc. require more than ten (10) working days to perform the review, Bob D. Campbell and Company, Inc. shall so notify the GC.
      - 1.) Concrete mix designs and material certificates including admixtures and compounds applied to the concrete after placement.
      - 2.) Reinforcing steel shop drawings including erection drawings, wall elevations (include all mech. openings) and bending details. Bar list will not be reviewed for correct quantities.
      - 3.) Structural steel shop drawings including erection drawings and piece details. Include connection submittals and miscellaneous framing.
      - 4.) Miscellaneous anchors shown on the structural drawings.
      - 5.) Wood truss design calculations and detailed erection and fabrication drawings. Standard stick framing shop drawings need not be submitted.
      - 6.) Construction and control joint plans and/or elevations.
    - E. Bob D. Campbell and Company, Inc. shall review shop drawings and related materials with comments provided that each submission has met the above requirements. Bob D. Campbell and Company, Inc. shall return without comment unrequired material or submissions without GC approval stamp.

14. Structural Special Inspection:
    - A. The structural design for this project is based on completion of special inspections during construction in accordance with chapter 17 of the 2018 International Building Code. The owner shall employ one or more qualified special inspectors to provide the required special inspections.
    - B. Special inspections shall be required for the items indicated below. The General Contractor shall provide notification to the inspector when items requiring inspection are ready to be inspected and provide access for those inspections.
      - 1.) Placement of Concrete
      - 2.) Testing of Concrete
      - 3.) Bolts in Concrete
      - 4.) Placement of Reinforcing Steel
      - 5.) Verification of Soil Bearing Capacities
      - 6.) High Strength Bolting
      - 7.) Drill & Epoxy Bolts
      - 8.) Structural Welding
      - 9.) Shear wall installation
      - 10.) Post-Installed Anchors
      - 11.) Wood shear walls and holdowns
      - 12.) Wood gravity framing and placement
    - C. The special inspector shall furnish inspection reports to the building official, owner, architect and structural engineer, and any other designated person.
    - D. All discrepancies shall be brought to the immediate attention of the contractor for correction, then, if incorrected, to the proper design authority, building official and structural engineer.
    - E. The special inspector shall submit a final signed report stating that the work requiring special inspection was, to the best of the inspector's knowledge, in conformance with the approved plans and specifications and the applicable workmanship provisions of the building code.

15. Copyright and Disclaimer:
    - A. All drawings in the structural set (S-series drawings) are the copyrighted work of Bob D. Campbell and company, Inc. These drawings may not be photographed, traced, or copies in any manner without the written permission of Bob D. Campbell and Company, Inc. Exception: Original drawings may be printed for distribution to the owner, architect, and general contractor for coordination, bidding, and construction. Subcontractors may not reproduce these drawings for any purpose or in any manner.
    - B. I, Michael J. Faltee, P.E., registered engineer and a representative of Bob D. Campbell and Company, Inc., do hereby accept professional responsibility as required by the professional registration laws of this state for the structural design drawings consisting of S-series drawings. I hereby disclaim responsibility for all other drawings in the construction document package, they being the responsibility of other design professionals whose seals and signed statements may appear elsewhere in the construction document package.

Wichita-Sedgwick County
Metropolitan Area Building
and Construction Department

REVIEWED FOR CODE COMPLIANCE

CORRECTIONS OR COMMENTS MADE ON THESE DRAWINGS AND THIS DOCUMENT DURING THIS REVIEW DO NOT RELIEVE CONTRACTOR FROM COMPLIANCE WITH ALL REQUIREMENTS OF THE CODE OF THE MARCH. THE CITY OF WICHITA OR SEDGWICK COUNTY. THIS REVIEW IS ONLY FOR GENERAL CONFORMANCE OF THE CODE. THE CONTRACTOR IS RESPONSIBLE FOR CONFORMING AND CORRELATING ALL TECHNIQUES OF CONSTRUCTION. THIS APPROVAL IS SUBJECT TO PROVISIONS OF SECTION 107.4 OF THE 2012 INTERNATIONAL BUILDING CODE.

DATE: 02/19/25 BY: William Jerauld Jr

NAILING SCHEDULE (REFER TO NOTES #1 and #2)

	CONNECTION	ATTACHMENTS (REF NOTE #3 and #4)	
1	JOIST TO SILL OR GIRDER	3- 3" x 0.131" NAILS-TOENAIL	3-8d NAILS-TOENAIL
2	BRIDGING TO JOIST	2- 3" x 0.131" NAILS-TOENAIL EACH END	2-8d NAILS-TOENAIL EACH END
3	SOLE PLATE TO JOIST OR BLOCKING & TRUSS TO TOP 'P.	3" x 0.131" NAILS AT 8"o.c.-TYPICAL FACE NAIL 4-3" x 0.131" NAILS AT 16"o.c.-BRACED WALL PANELS	16d BOX NAILS AT 16"o.c. MAX. FACE NAILING 3-16d BOX NAILS AT 16'o.c. BRACED WALL PANEL
4	TOP PLATE TO STUD	3- 3" x 0.131" NAILS-END NAIL	2-16d NAILS-END NAIL
5	STUD TO SOLE PLATE	4- 3" x 0.131" NAILS-TOENAIL OR 3- 3" x 0.131" NAILS-END NAIL	4-8d NAILS-TOENAIL OR 2-16d NAILS-END NAIL
6	DOUBLE STUDS	3" x 0.131" NAILS AT 8"o.c.-FACE NAIL	16d BOX NAILS AT 24"o.c. MAX. FACE NAIL
7	DOUBLED TOP PLATES	3" x 0.131" NAILS AT 12"o.c.-FACE NAIL	16d BOX NAILS AT 16"o.c. MAX. FACE NAIL
8	DOUBLE TOP PLATE LAPS AND INTERSECTIONS	12-3" x 0.131" NAILS	8-16d NAILS
9	BLOCKING BETWEEN JOISTS OR RAFTERS TO TOP PLATE	3-3" x 0.131" NAILS -TOENAIL	3-8d NAILS-TOENAIL
10	RIM JOIST TO TOP PLATE	3" x 0.131" NAILS AT 6"o.c.-TOENAIL	10d NAILS AT 6"o.c. MAX.-TOENAIL
11	TOP PLATE LAPS AND INTERSECTIONS	3- 3" x 0.131" NAILS-FACE NAIL	2-16d NAILS-FACE NAIL
12	CONTINUOUS HEADER, TWO PIECES	3" x 0.131" NAILS AT 10"o.c. ALONG EACH EDGE	16d NAILS AT 16"o.c. MAX. ALONG EACH EDGE-TOENAIL
13	CEILING JOISTS TO PLATE	5- 3" x 0.131" NAILS-TOENAIL	3-8d NAILS-TOENAIL
14	CONTINUOUS HEADER TO STUD	4- 3" x 0.131" NAILS-TOENAIL	4-8d NAILS-TOENAIL
15	CEILING JOISTS, LAPS OVER PARTITIONS	4- 3" x 0.131" NAILS-FACE NAIL	3-16d NAILS-FACE NAIL
16	CEILING JOISTS TO PARALLEL RAFTERS	4- 3" x 0.131" NAILS-FACE NAIL	3-16d NAILS-FACE NAIL
17	RAFTER TO PLATE	3- 3" x 0.131" NAILS-TOENAIL	3-8d NAILS-TOENAIL
18	1" BRACE TO EACH STUD AND PLATE	2- 3" x 0.131" NAILS-FACE NAIL	2-8d NAILS-FACE NAIL
19	BUILT-UP CORNER AND MULTIPLE STUDS	3" x 0.131" NAILS AT 16"o.c.	16d NAILS AT 24"o.c. MAX.
20	BUILT-UP GIRDER AND BEAMS	3" x 0.131" NAILS AT 24"o.c. FACE NAILED TOP AND BOTTOM STAGGERED ON OPPISITE SIDES 3- 3" x 0.131" NAILS AT ENDS AND EACH SPLICE	20d NAILS AT 32"o.c. MAX. TOP AND BOTTOM, STAGGERED ON OPPSITE SIDES. 2-20d NAILS AT ENDS AND EACH SPLICE
21	BUILT-UP LAMINATED VENEER LUMBER BEAMS	3" x 0.131" NAILS AT 6"o.c. TOP AND BOTTOM ALONG EDGE	16d NAILS AT 12"o.c. TOP AND BOTTOM ALONG EDGE
22	2" PLANKING	4- 3" x 0.131" NAILS AT EACH SUPPORT	16d NAILS AT EACH SUPPORT
23	RIM BOARD TO TRUSS	2 - 3" x 0.131" FACE NAILS (1T/1B @ EA TRUSS)	2-10d NAILS - FACE NAILS (1T/1B @ EA TRUSS)
24	BUILT-UP STUD PACK COLUMNS	REFER TO DETAIL 6/S1.1	REFER TO DETAIL 6/S1.1

NOTES:
1.) ALL NAILS SHALL BE AS NOTED UNLESS OTHERWISE SPECIFIED ON STRUCTURAL DRAWINGS OR ALTERNATE PROVIDED BY ENGINEER IN WRITING.
2.) CONDITIONS NOT SPECIFIED SHALL BE IN ACCORDANCE WITH CURRENT INTERNATIONAL BUILDING CODE.
3.) NAILING DESIGNATION:
4- 3" x 0.131" NAILS
- 4 = QUANTITY
- 3" = NAIL LENGTH
- 0.131" = DIAMETER IN INCHES

4.) ALL NAILS NOTED AS 8d, 10d, 16d, ETC. SHALL BE COMMON NAILS UNLESS NOTED BOX.
5.) REFER TO SHEARWALL SCHEDULE FOR ADDT'L NAILING REQUIREMENTS

TYPICAL SYMBOL LEGEND:
- (A) - BEAM OR HEADER PER SCHED ON S1.1
- (A-U) - UPSET BEAM OR HEADER PER SCHED ON S1.1
- (#) - FOOTING TYPE PER SCHED ON S1.1
- * - SHEARWALL HOLDDOWN TYPE PER SCHED ON S1.2
- SW - SHEARWALL PER SCHED ON S1.2
- CJ - CONSTRUCTION JOINT PER 2/S3.1
- SJ - SAW JOINT PER 1/S3.1
- ——→ - SPAN DIRECTION

BOB D. CAMPBELL & CO.
Structural Engineers Since 1957
4338 Belleview Ave. 816.531.4144
Kansas City, MO 64111 www.bdc-engrs.com

JonesGillamRenz
730 N. Ninth 1881 Main Street, Suite 301
Salina, KS 67401 Kansas City, MO 64108
785.827.0386 jgr@jgrarchitects.com

ANDOVER SENIOR LIVING
NEW APARTMENTS
ANDOVER, KANSAS

MICHAEL J. FALTEE
LICENSED
10296
1-3-2025
KANSAS
PROFESSIONAL ENGINEER

REVISION:

DATE: 1-03-2025
JOB: 24-3385
SHEET NO.:

S1.0

COPYRIGHTED ©

HEADER SCHEDULE

MARK	HEADER	JAMB STUDS	NOTES
A	(2) 2x10 w/ ½" PLYWOOD SPACER PL	2 JACK / 1 KING (2 KING BELOW 2nd FLR)	
B	(3) 2x10 w/ (2) ½" PLYWOOD SPACER PLs	1 JACK / 1 KING	
C	(3) 2x10 w/ (2) ½" PLYWOOD SPACER PLs	1 JACK / 2 KING	
D	(3) 2x10 w/ (2) ½" PLYWOOD SPACER PLs	1 JACK / 3 KING	
E	(2) 2x10 UPSET	1 JACK, 1 KING	
F	(3) 2x12 UPSET	1 JACK / 1 KING	
G	(3) 1¾" x 9¼" LVLs	4 JACK	
H	(3) 1¾" x 11¼" LVLs	2 JACK / 1 KING	

NOTES:
1. JAMB STUDS SHALL MATCH SIZE & GRADE OF WALL STUDS UNO.
2. WHERE BEAM IS NOTED "UPSET", ALL JAMB STUDS NOTED WILL EXTEND TO DOUBLE TOP PLATE.
3. ALL EXTERIOR LUMBER TO BE TREATED.
4. PROVIDE SQUASH BLOCKS AT TRUSSES & BLOCKING FRAMING WHERE JAMBS OR STUD PACKS ARE DISCONT. QUANTITY TO MATCH JAMB OR STUD PACK ABOVE.
5. PROVIDE ½" PLYWOOD SPACER PLs AT HEADERS CONSTRUCTED WITH 2x LUMBER.
6. AT CONTRACTOR'S OPTION-PROVIDE GLULAM IN LIEU OF PSLs.
7. REFER TO DTL 5/S1.1 FOR MULTI-PLY MEMBER CONNECTION REQUIREMENTS.
8. ATTACH JAMB AND KING STUDS TOGETHER PER CONNECTION TYPE 24 IN NAILING SCHEDULE ON SHEET S1.0.
9. REFER TO DETAILS 7/S1.1 FOR TYPICAL HEADER CONDITIONS.

STUD BEARING WALL & SHEATHING SCHEDULE

LOCATION	STUD SIZE AND SPACING
(TYP.) EXTERIOR WALL	2x6 @ 16"oc STUDS
INTERIOR WALL (EXCEPT AT NON TRUSS BRG CORRIDORS)	REFER TO SECTIONS ON SHEET S3.2
INTERIOR WALL (AT NON TRUSS BRG CORRIDORS)	REFER TO SECTIONS ON SHEET S3.2

NOTES:
1. PROVIDE 2x BLOCKING @ MID HEIGHT (5'-0" MAX) @ ALL LOAD BEARING WALLS NOT SHEATHED ON BOTH SIDES AND ALL 2x8 WALLS.
2. ALL STUDS TO BE No. 2 GRADE U.N.O.
3. RE: 6/S1.1 FOR NAILING OF MULTIPLE STUDS.
4. REFER TO ARCH/MEP DRAWING FOR LOCATIONS OF FURRED OUT WALLS TO ACCOMMODATE PLUMBING OR MEP ITEMS.

STRUCTURAL DECK & SLAB SCHEDULE

MARK	DESCRIPTION
SOG-1	4" CONC. SLAB ATOP 15 MIL VAPOR BARRIER ATOP 4" GRAVEL ATOP 20" LOW VOLUME CHANGE MATERIALAS REQ'D BY PROJECT GEOTECH. REPORT. REINF. SLAB w/ 6x6-6/6 WWF. EL. T/C = 100'-0.
FD-1	3/4" PLYWOOD SHEATHING ATTACH w/ 8d NAILS @ 6"oc AT EDGES AND 12"oc AT FIELD.
RD-1	5/8" ZIP STRIP ROOF SHEATHING ATTACH w/ 8d NAILS @ 6"oc AT EDGES AND 12"oc AT FIELD.

NOTES:
1. SOG = SLAB-ON-GRADE TYPE
2. FD = FLOOR DECK TYPE
3. RD = ROOF DECK TYPE

SPREAD FOOTING SCHEDULE

MARK	SIZE	REINFORCING
4	4'-0"x4'-0"x1'-2" Dp	#4 @ 6"oc EACH WAY, BOTTOM
4A	4'-0"x4'-0"x3'-0" Dp	#5 @ 12"oc EACH WAY, BOTTOM
5	5'-0"x5'-0"x1'-4" Dp	#4 @ 6"oc EACH WAY, BOTTOM
5A	5'-0"x5'-0"x3'-0" Dp	#5 @ 12"oc EACH WAY, BOTTOM
6	6'-0"x6'-0"x1'-6" Dp	#4 @ 6"oc EACH WAY, BOTTOM

NOTES:
1. SPREAD FOOTINGS LOCATED AT INTERIOR SHALL BE POURED MONOLITHIC WITH THE SLAB AS A THICKENED PORTION OF SLAB UNLESS THEY HAVE A STEEL COLUMN BEARING ATOP.
2. SPREAD FOOTINGS LOCATED AT INTERIOR WITH STEEL COLUMNS BEARING ATOP SHALL BE LOCATED AT 99'-2".
3. SPREAD FOOTINGS LOCATED AT PERIMETER (EXTERIOR) OF BUILDING SHALL BE POURED MONOLITHIC WITH GRADE BEAMS

Wichita-Sedgwick County
Metropolitan Area Building
and Construction Department

REVIEWED FOR CODE COMPLIANCE

CORRECTIONS OR COMMENTS MADE ON THESE DRAWINGS AND THIS DOCUMENT DURING THIS REVIEW DO NOT RELIEVE CONTRACTOR FROM COMPLIANCE WITH ALL REQUIREMENTS OF THE CODE OF THE MABCD, THE CITY OF WICHITA OR SEDGWICK COUNTY. THIS REVIEW IS ONLY FOR GENERAL CONFORMANCE OF THE CODE. THE CONTRACTOR IS RESPONSIBLE FOR CONFORMING AND CORRELATING ALL TECHNIQUES OF CONSTRUCTION. THIS APPROVAL IS SUBJECT TO PROVISIONS OF SECTION 107.4 OF THE 2012 INTERNATIONAL BUILDING CODE.

DATE: 02/19/25 BY: William Jerauld Jr

COLUMN SCHEDULE

TYPE	SIZE	BASE PL	SHAPE	ANCHOR BOLTS
C1	HSS3½x3½x5/16	1/2"x10"x10"	A	(2) ¾"Φ x 2'-0"Lg
C2	HSS5x5x¼	1/2"x5½"x13"	B	(4) ¾"Φ x 2'-0"Lg

NOTES:
1. SEE PLAN FOR ORIENTATION OF COLUMNS.
2. ALL COLUMNS SHALL BE CONTINUOUS WITH NO SPLICES.
3. AB LENGTH INCLUDES 4" HK & 4" PROJECTION U.N.O.
4. U.N.O. SET COLUMN BASE PLATES ON 1" GROUT TYPICAL.
5. EACH AB SHALL HAVE A 3"x3"x¾" PLATE WASHER BOT. (IN LIEU OF HK) @ 4" PROJ. ATOP WHERE NOTED IN THE SCHED. (4"x4"x¾" PLATE WASHER @ BOLTS 1"Φ AND LARGER).
6. ¾"Φ ANCHOR BOLTS SHALL HAVE A 2"x2"x¼" PLATE WASHER @ TOP & 1"Φ ANCHOR BOLTS SHALL HAVE A 3"x3"x⅜" PLATE WASHER. WELD WASHER TO COLUMN BASE PLATE WITH ⅛" FILLET WELD @ 4- SIDES.
7. ALL ANCHOR BOLTS SHALL BE ASTM F1554, GRADE 36 U.N.O.

SHAPE (NOT TO SCALE)

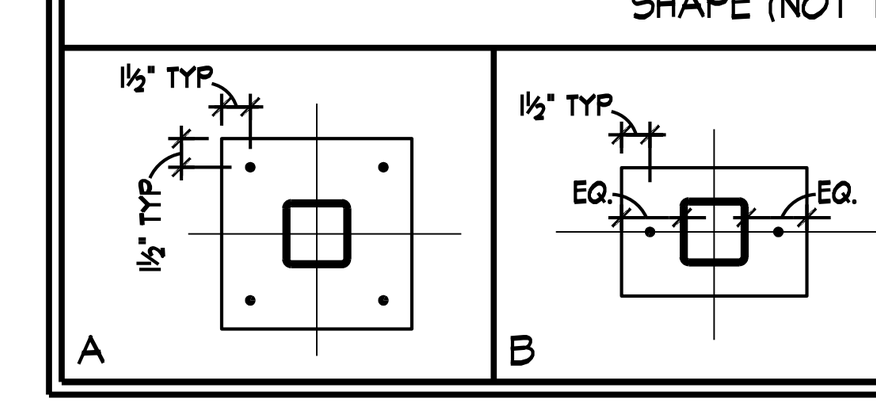

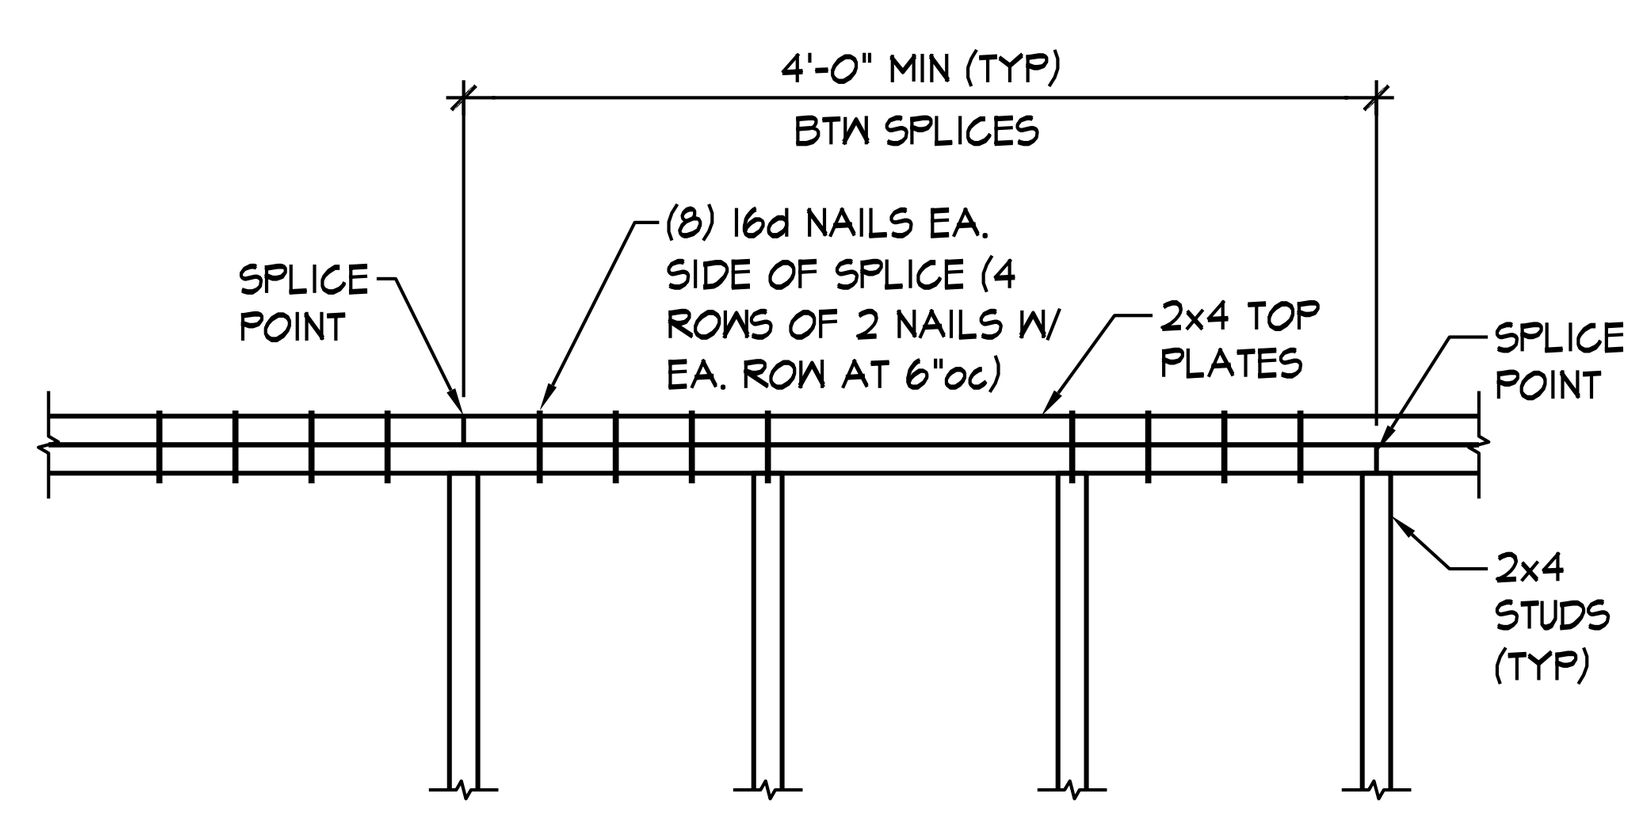

(TYP) TOP PLATE SLPICE 1/S1.1
¾" = 1'-0"

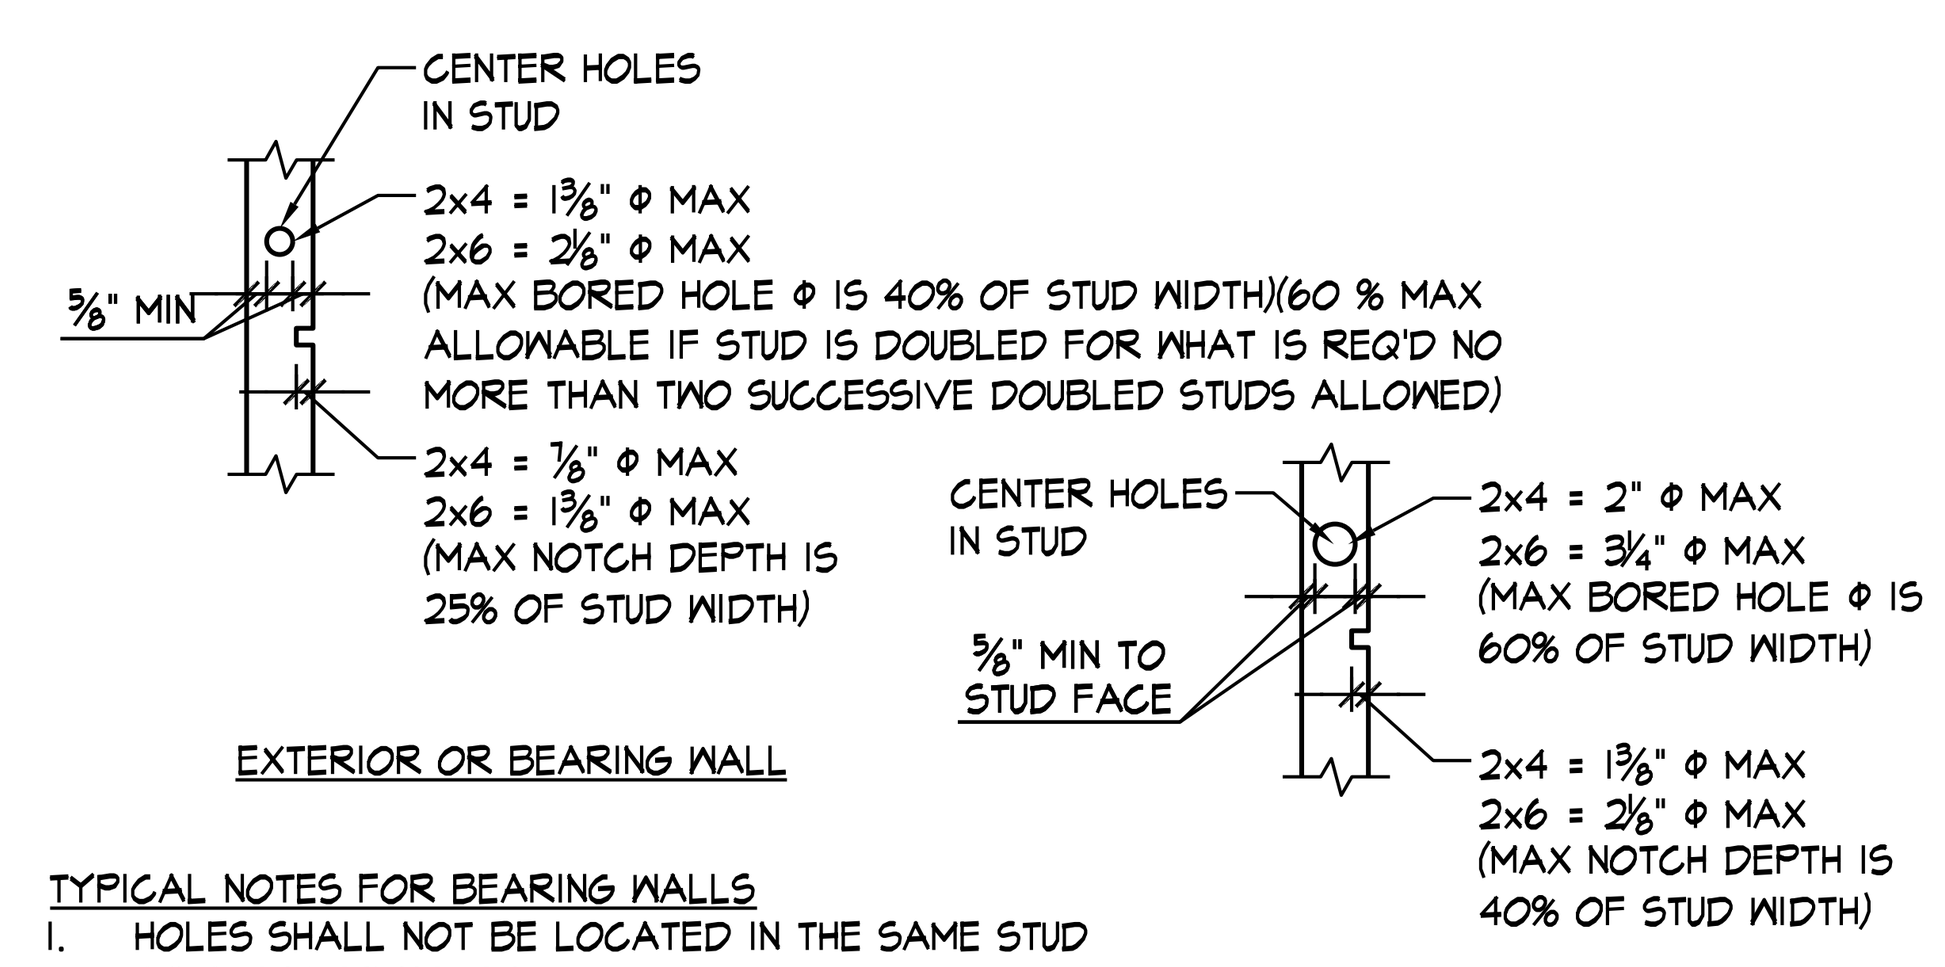

TYPICAL NOTES FOR BEARING WALLS
1. HOLES SHALL NOT BE LOCATED IN THE SAME STUD AS A CUT OR NOTCH
2. CONTACT ENGINEER PRIOR TO CUTTING OR NOTCHING TO VERIFY SIZE AND LOCATION IF HOLES GREATER THAN 20% STUD WIDTH OR NOTCHES GREATER THAN 10% STUD WIDTH ARE REQUIRED IN TWO OR MORE CONSECUTIVE STUDS
3. NOTCHES OR HOLES NOT PERMITTED IN JAMBS, STUD PACKS AND AT ENDS OF SHEARWALLS

SECTION 2/S1.1
¾" = 1'-0"

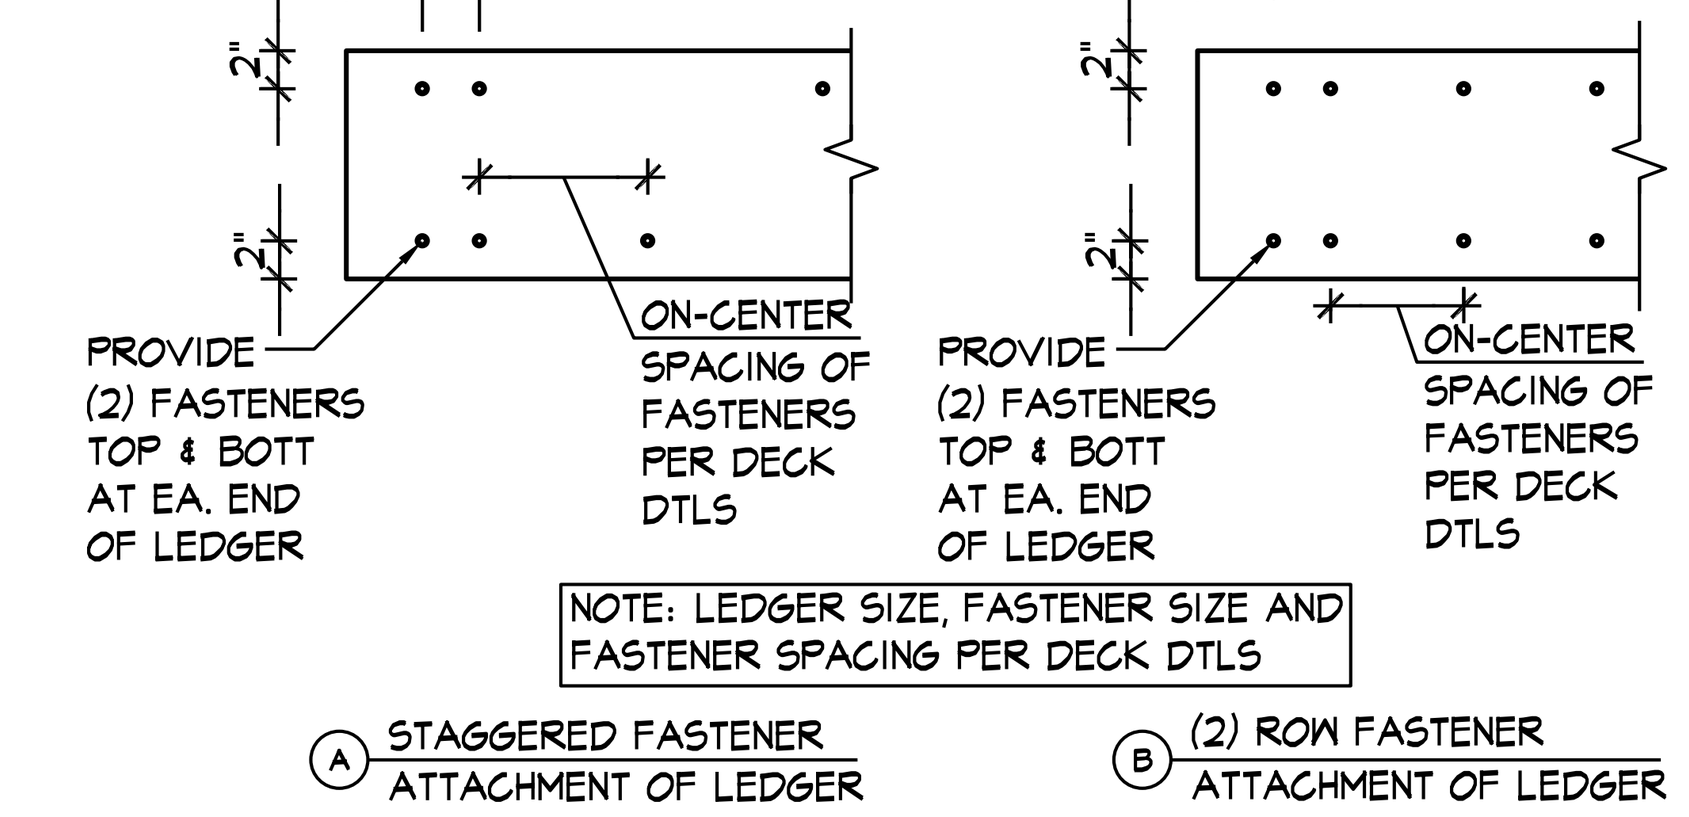

TYPICAL LEDGER CONNECTION 3/S1.1
¾" = 1'-0"

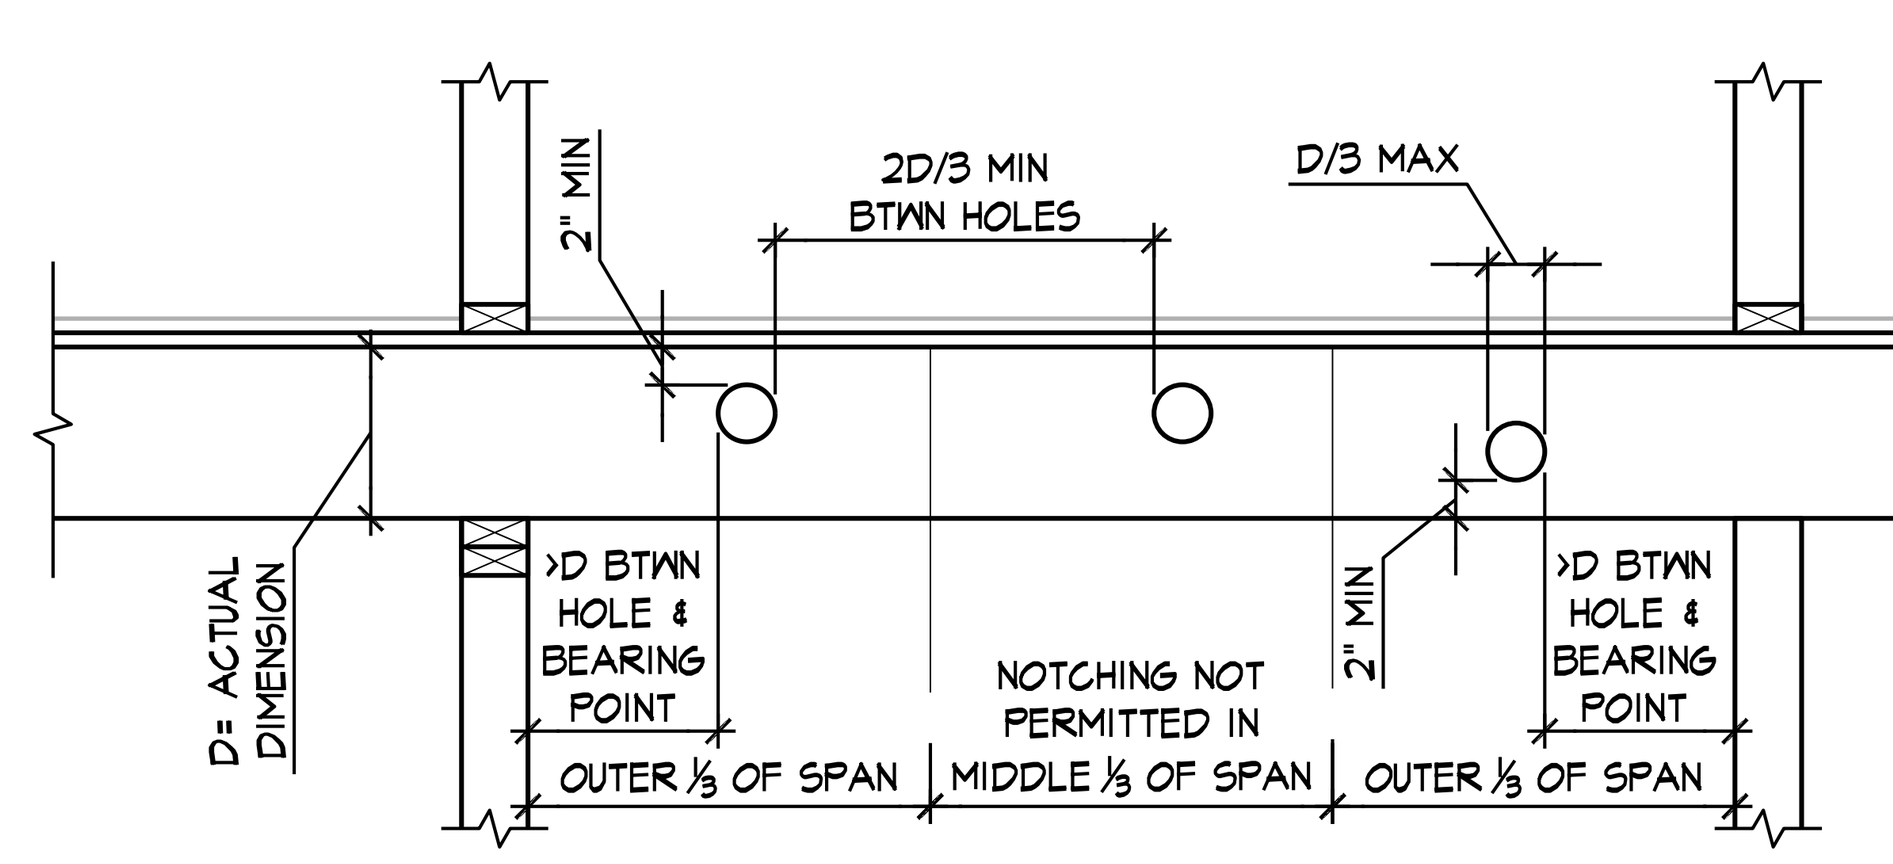

NOTE:
1. CONTACT ARCHITECT PRIOR TO CUTTING JOISTS TO VERIFY SIZE AND LOCATION
2. DETAIL APPLIES TO 2x FRAMING ONLY. REFER TO ENGINEERED OR COMPOSITE LUMBER MANUNFACTURER'S RECOMMENDATIONS AT PSLs, LVLs, LSLs & GLULAM

SECTION 4/S1.1
¾" = 1'-0"

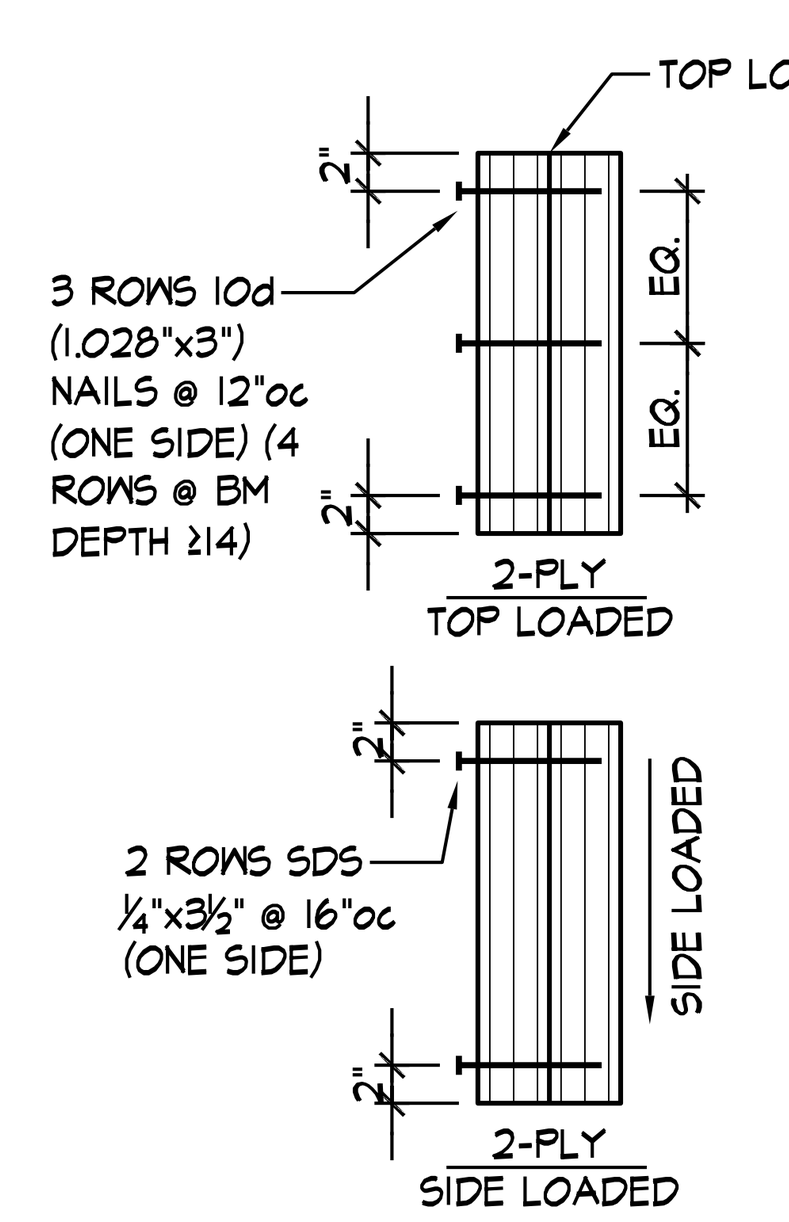

TYPICAL MULTI-PLY BEAM CONNECTION 5/S1.1
¾" = 1'-0"

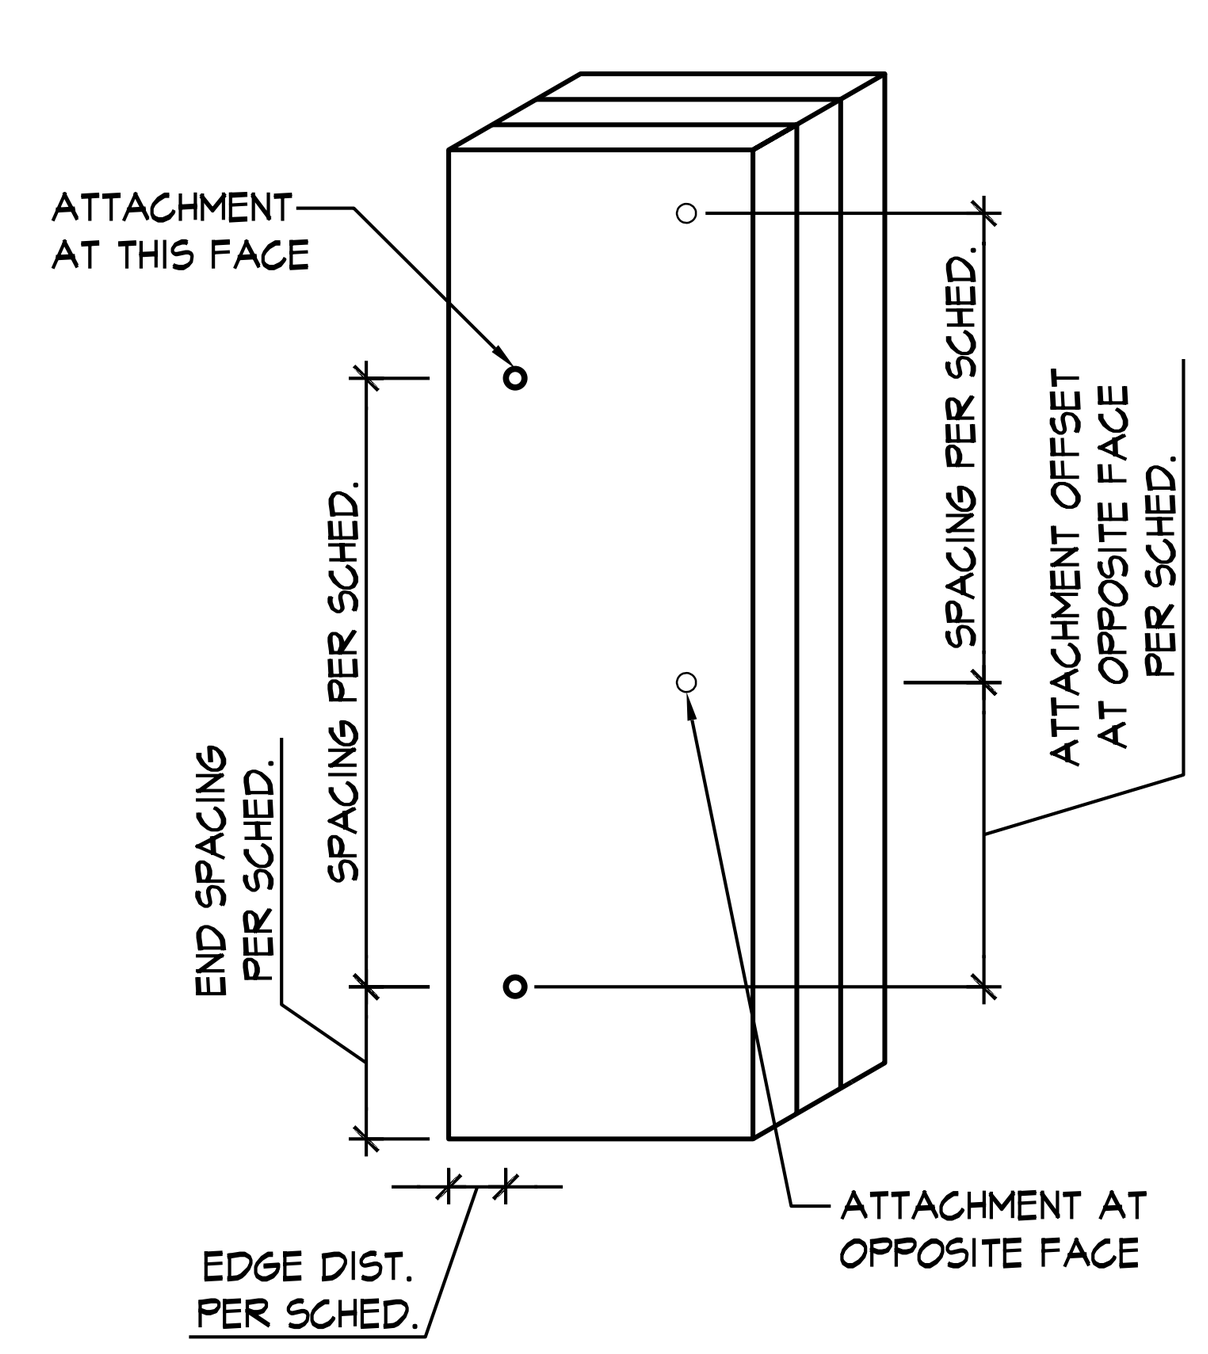

TYPICAL MULTI-PLY STUD CONNECTION 6/S1.1
1½" = 1'-0"

BUILT-UP STUD PACK COLUMN ATTACHMENT SCHEDULE

NUMBER OF PLIES	ATTACHMENT AT COLUMN STUD PACKS SUPPORTING BEAMS	ATTACHMENT AT WALL STUD PACKS SUPPORTING TRUSSES
2-PLY MEMBERS	8d NAILS AT 12"oc, 1" FROM EDGE, W/ OPPOSITE EDGE NAILED FROM OPPOSITE SIDE OFFSET 6", @ 12"oc W/ FIRST NAIL 2" FROM EA. END	8d NAILS AT 12"oc, 1" FROM EDGE, W/ OPPOSITE EDGE NAILED FROM OPPOSITE SIDE OFFSET 6", @ 12"oc W/ FIRST NAIL 2" FROM EA. END
3-PLY MEMBERS	20d NAILS AT 16"oc, 1 1/2" FROM EDGE W/ OPPOSITE EDGE NAILED FROM OPPOSITE SIDE OFFSET 8", @ 16"oc W/ FIRST NAIL 3" FROM EA. END	8d NAILS AT 12"oc, 1" FROM EDGE, W/ OPPOSITE EDGE NAILED FROM OPPOSITE SIDE OFFSET 6", @ 12"oc W/ FIRST NAIL 2" FROM EA. END
4-PLY MEMBERS	1/4"Φx5" SIMPSON SDS SCREWS AT 16"oc, 1 1/2" FROM EDGE W/ OPPOSITE EDGE SCREWED FROM OPPOSITE SIDE OFFSET 8", @ 16"oc W/ FIRST SCREW 4" FROM EA. END	3 PLIES ATTACHED PER 3-PLY ATTACHMENT WITH 4TH PLY ATTACHED WITH 8d NAILS AT 12"oc IN 2 ROWS, 1 1/2" FROM EDGE, OFFSET ROWS 6"
5-PLY MEMBERS	1/4"Φx6" SIMPSON SDS SCREWS AT 12"oc, 1 1/2" FROM EDGE W/ OPPOSITE EDGE SCREWED FROM OPPOSITE SIDE OFFSET 6", @ 12"oc W/ FIRST SCREW 4" FROM EA. END	3 PLIES ATTACHED PER 3-PLY ATTACHMENT WITH 4TH & 5TH PLY ATTACHED AT OPPOSITE SIDES WITH 8d NAILS AT 12"oc IN 2 ROWS, 1 1/2" FROM EDGE, OFFSET ROWS 6"
6-PLY MEMBERS	1/4"Φx8" SIMPSON SDS SCREWS AT 12"oc, 1 1/2" FROM EDGE W/ OPPOSITE EDGE SCREWED FROM OPPOSITE SIDE OFFSET 6", @ 12"oc W/ FIRST SCREW 4" FROM EA. END	3-PLIES ATTACHED PER 3-PLY ATTACHMENT WITH 4TH PLY ATTACHED WITH 8d NAILS AT 12"oc IN 2 ROWS, 1 1/2" FROM EDGE, OFFSET ROWS 6" AND 5TH AND 6TH PLIES ATTACHED WITH 1/4"Φx5" SIMPSON SDS SCREWS AT 12"oc IN 2 ROWS, 1 1/2" FROM EDGE, OFFSET ROWS 6"oc W/ FIRST SCREW 4" FROM EA. END

NOTES:
1. ALL BUILT-UP STUD PACKS MUST ALIGN FLOOR-TO-FLOOR WITH SOLID BLOCKING (SQUASH BLOCKS) AT FLOOR CAVITIES.
2. EXTEND ALL STUD PACKS TO COLUMNS UNLESS NOTED OTHERWISE.
3. ALL NAILS ARE COMMON NAILS UNLESS NOTED OTHERWISE.

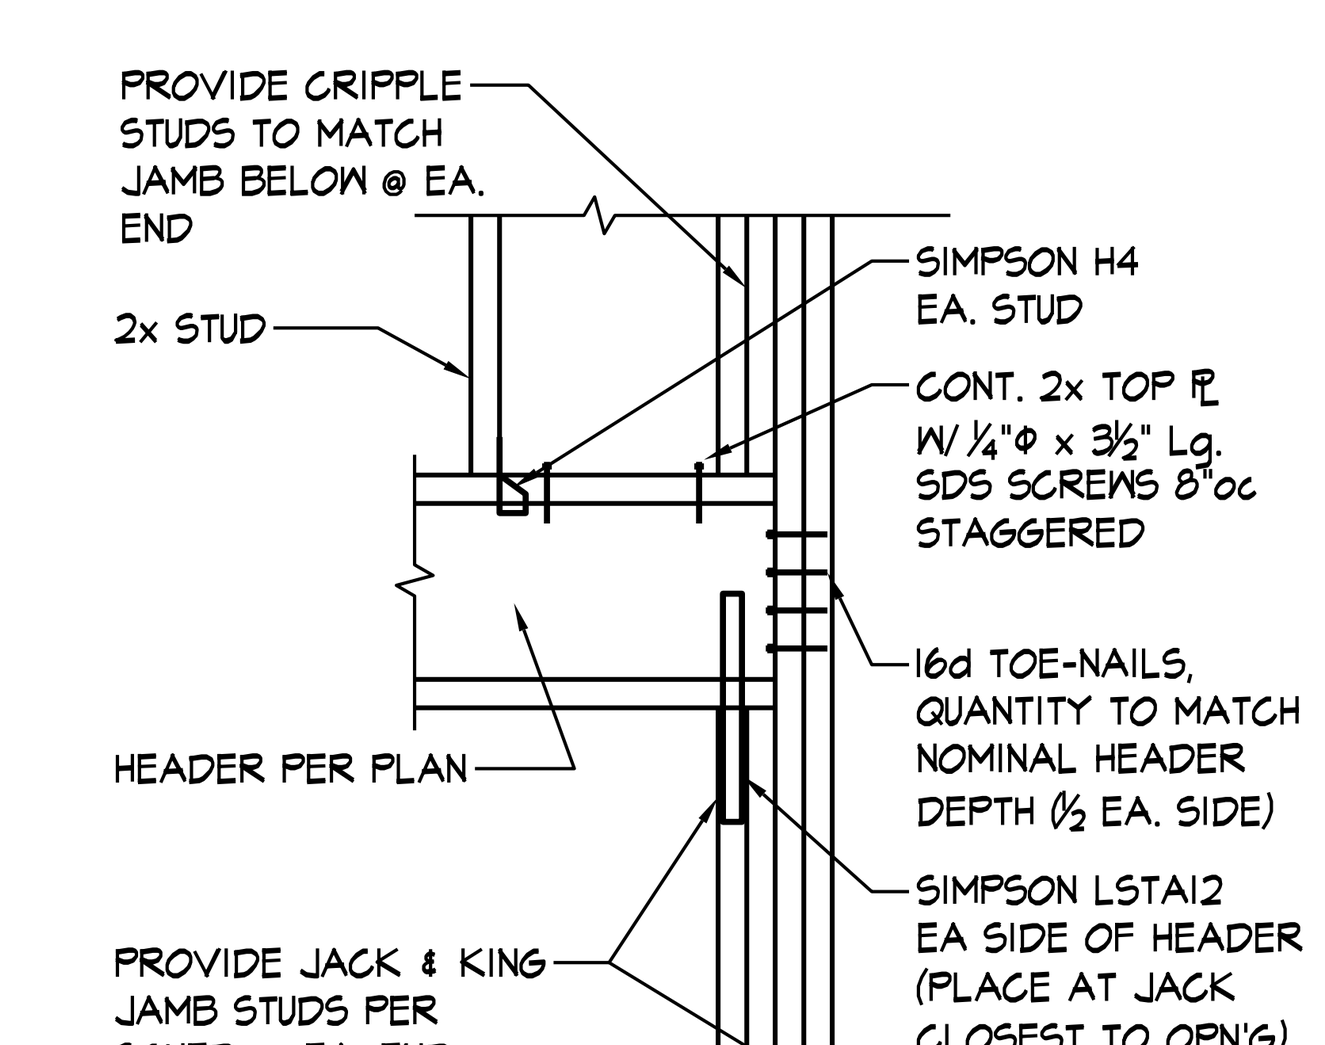

TYP. HEADER DETAIL @ ROOF TRUSS BEARING LOCATIONS

SECTION 7/S1.1
¾" = 1'-0"

BOB D. CAMPBELL & CO.
Structural Engineers Since 1957
4338 Belleview Ave. 816.531.4144
Kansas City, MO 64111 www.bdc-engrs.com

JonesGillamRenz
730 N. Ninth 1881 Main Street, Suite 301
Salina, KS 67401 Kansas City, MO 64108
785.827.0386 jgr@jgrarchitects.com

ANDOVER SENIOR LIVING

NEW APARTMENTS

ANDOVER, KANSAS

MICHAEL J. FALBE LICENSED 10296 1·3·2025 KANSAS PROFESSIONAL ENGINEER

REVISION:

DATE: 1-03-2025
JOB: 24-3385
SHEET NO.:

S1.1

COPYRIGHTED ©

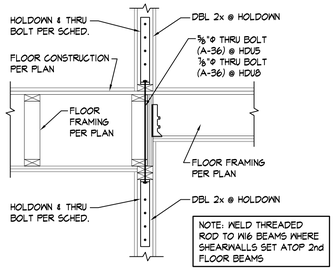

TYP HOLDOWN DETAIL

SECTION ¾" = 1'-0" 2 / S1.2

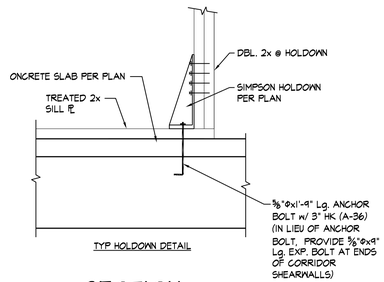

TYP HOLDOWN DETAIL

SECTION ¾" = 1'-0" 3 / S1.2

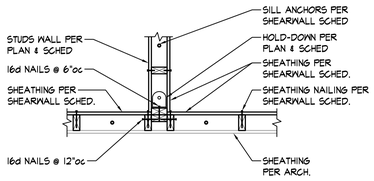

TYPICAL @ DISCONTINUOUS SHEARWALL SHEATHING

SECTION ¾" = 1'-0" 4A / S1.2

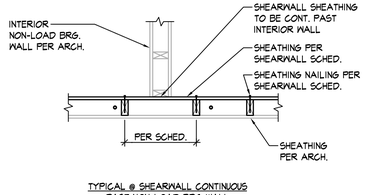

TYPICAL @ SHEARWALL CONTINUOUS PAST NON-LOAD BRG WALL

SECTION ¾" = 1'-0" 4B / S1.2

PROVIDE UNIT UPLIFT HOLDOWNS @ 48"oc MAX @ LOAD BEARING INTERIOR WALLS SUPPORTING ROOF TRUSSES. HOLDOWNS SHALL BE PROVIDED WITHIN 6" OF JAMBS OF ALL INTERIOR LOAD BEARING ROOF HEADERS & GIRDER TRUSS BEARING AND WITHIN 48" OF SHEARWALL HOLDOWNS

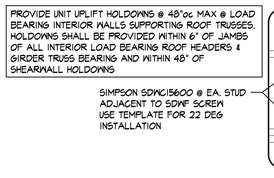

TYP SIDE VIEW @ DBL STUD SCREWS @ HOLDOWN

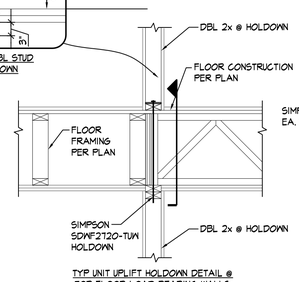

TYP UNIT UPLIFT HOLDOWN DETAIL @ TOP FLOOR LOAD BEARING WALLS

SECTION ¾" = 1'-0" 5A / S1.2

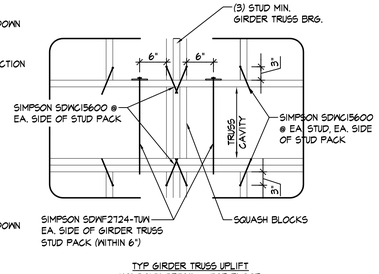

TYP GIRDER TRUSS UPLIFT HOLDOWN DETAIL @ TOP FLOOR

SECTION ¾" = 1'-0" 5B / S1.2

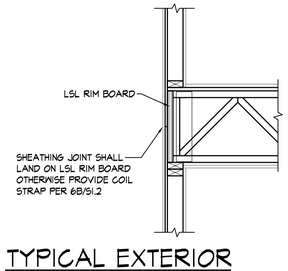

TYPICAL EXTERIOR SHEATHING JOINT

¾" = 1'-0" 6A / S1.2

HOLDOWN SCHEDULE

MARK	FLOOR LEVEL (W/ APPLICABLE HOLDOWN TYPE PER FLOOR)		
	1st FLOOR	2nd FLOOR	3rd FLOOR
*	HDU8-SDS2.5	HDU8-SDS2.5	HDU5-SDS2.5
**	HDU5-SDS2.5	HDU5-SDS2.5	HDU5-SDS2.5

NOTES:
1. HOLDOWN TYPES ARE BASED UPON MANUFACTURER SIMPSON STRONG-TIE.
2. REFER TO SECTION DETAILS ON S1.2 FOR TYPICAL HOLDOWN DETAILS.
3. WHERE THE ENDS OF PERPENDICULAR SHEAR WALLS INTERSECT AND ONLY ONE HOLDOWN SHOWN ON PLAN, FASTEN ALL STUDS TOGETHER PER SCHEDULE AND USE LARGER OF THE TWO HOLDOWNS SHOWN ON THE SHEAR WALL SCHEDULE.
4. ALL HOLDOWN POSTS TO BE (2) 2x's (MIN.) (U.N.O.) TO MATCH STUD SIZE & GRADE NOTED IN WALL SCHEDULE. PROVIDE ADDITIONAL STUDS AS REQ'D TO MEET QUANTITY NOTED IN SCHED.
5. REFER TO SECTIONS 2/S1.2, 3/S1.2, 4A/S1.2 & 4B/S1.2 FOR HOLDOWN ANCHOR REQUIREMENTS.

SHEARWALL SCHEDULE

SHEARWALL LOCATION	SHEARWALL TYPE		FLOOR		SILL PLATE CONNECTION (RE: NOTES 6 & 7)	NUMBER OF WALL STUDS AT HOLD-DOWN (RE: NOTE 4)
			1st FLOOR WALLS	2nd & 3rd FLOOR WALLS		
AT DEMISING WALLS	SW	MATERIAL & THICKNESS	7/16" OSB SHEATHING ONE SIDE, w/ EDGES BLOCKED	7/16" OSB SHEATHING ONE SIDE, w/ EDGES BLOCKED		
		NAIL SIZE & SPACING	8d NAILS 4/12	8d NAILS 6/12		
AT CORRIDOR WALLS	SW	MATERIAL & THICKNESS	7/16" OSB SHEATHING ONE SIDE, w/ EDGES BLOCKED	7/16" OSB SHEATHING ONE SIDE, w/ EDGES BLOCKED		
		NAIL SIZE & SPACING	8d NAILS 4/12	8d NAILS 6/12		

NOTES:
1. NAILING SHALL BE TO ALL STUDS, TOP & BOTTOM PLATES, AND BLOCKING WHERE INDICATED.
2. HOLDOWNS PER PLAN & SCHEDULE.
3. WHERE THE ENDS OF PERPENDICULAR SHEAR WALLS INTERSECT AND ONLY ONE HOLDDOWN SHOWN ON PLAN, FASTEN ALL STUDS TOGETHER PER SCHEDULEA AND USE LARGE OF THE TWO HOLDDOWNS SHOWN IN THE SHEARWALL SCHEDULE. REFERENCE DETAILS 4A, 4B, 4C, AND 4D ON SHEET S1.2 FOR SHEATHING AND HOLDOWN ATTACHMENT AT PERPENDICULAR WALLS AND STUD WALL SIZE TRANSITIONS.
4. PROVIDE 2 WALL STUDS AT EACH HOLDDOWN UNLESS NOTED OTHERWISE IN SCHEDULE. AT LOCATIONS WHERE A SHEARWALL TERMINATES AT A OPENING JAMB, PROVIDE NUMBER OF STUDS PER JAMB SCHEDULE PLUS AN ADDITIONAL STUD FOR THE SHEARWALL. ATTACH ALL STUDS TOGETHER PER 6/S1.1.
5. NAIL SPACING SHOWN AS (#/#) INDICATES FASTENERS SPACING IN INCHES AT THE EDGES/FIELD WHERE FIELD IS THE INTERMEDIATE MEMBERS.
6. TYPICAL SILL PLATE TO WOOD SHALL BE 20d COMMON NAILS (1.092x4") AT 12"oc UNLESS NOTED OTHERWISE IN SCHEDULE.
7. TYPICAL SILL PLATE TO CONCRETE SHALL BE ½"ø ANCHORS:
   AT 2x4 WALLS SPACE AT 24"oc MAX WITH ¼"x2½"x2½" PLATE WASHER OR SIMPSON BPS ½ - 3 @ CONTRACTORS OPTION
   PLATE WASHERS TO MAINTAIN MAX OF ½" BETWEEN EDGE OF SILL PLATE AND EDGE OF PLATE WASHER
8. SHEARWALL SHEATHING CALLED OUT AT CORRIDOR WALLS SHALL BE LOCATED AT UNIT SIDE OF WALL
9. AT GYPSUM SHEARWALLS NO. 6 x 1¼" TYPE S OR W SCREWS CAN BE UTILIZED AS THE SAME SPACING AS SPECIFIED 6d NAILS.
10. NAILS @ WOOD STRUCTURE PANEL SHEAR WALLS SHALL BE GALVANIZED COMMON OF TYPE INDICATED IN SCHED.

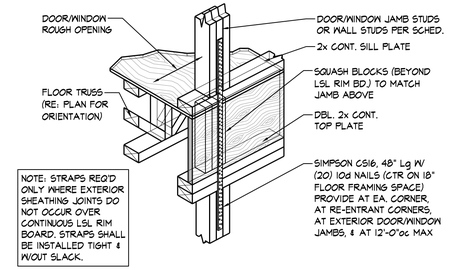

TYPICAL COIL STRAP @ EXTERIOR JAMBS SUPPORTING ROOF FRAMING AT FLOOR DIRECTLY BELOW ROOF

DETAIL ¾" = 1'-0" 6B / S1.2

Wichita-Sedgwick County
Metropolitan Area Building
and Construction Department

REVIEWED FOR CODE COMPLIANCE

CORRECTIONS OR COMMENTS MADE ON THESE DRAWINGS AND THIS DOCUMENT DURING THIS REVIEW DO NOT RELIEVE CONTRACTOR FROM COMPLIANCE WITH ALL REQUIREMENTS OF THE CODE OF THE MABCD, THE CITY OF WICHITA OR SEDGWICK COUNTY. THIS REVIEW IS ONLY FOR GENERAL CONFORMANCE OF THE CODE. THE CONTRACTOR IS RESPONSIBLE FOR CONFORMING AND CORRELATING ALL TECHNIQUES OF CONSTRUCTION. THIS APPROVAL IS SUBJECT TO PROVISIONS OF SECTION 107.4 OF THE 2012 INTERNATIONAL BUILDING CODE.

DATE: 02/19/25 BY: William Jerauld Jr

JonesGillamRenz
730 N. Ninth 1881 Main Street, Suite 301
Salina, KS 67401 Kansas City, MO 64108
785.827.0386 jgr@jgrarchitects.com

ANDOVER SENIOR LIVING
NEW APARTMENTS
ANDOVER, KANSAS

MICHAEL J. FALEN LICENSED 10296 1-3-2025 KANSAS PROFESSIONAL ENGINEER

REVISION:

DATE: 1-03-2025
JOB: 24-3385
SHEET NO.:

S1.2

BOB D. CAMPBELL & CO.
Structural Engineers Since 1957
4338 Belleview Ave. 816.531.4144
Kansas City, MO 64111 www.bdc-engrs.com

COPYRIGHTED©

Wichita-Sedgwick County
Metropolitan Area Building
and Construction Department

REVIEWED FOR CODE COMPLIANCE

CORRECTIONS OR COMMENTS MADE ON THESE DRAWINGS AND THIS DOCUMENT DURING THIS REVIEW DO NOT RELIEVE CONTRACTOR FROM COMPLIANCE WITH ALL REQUIREMENTS OF THE CODE OF THE MARCH, THE CITY OF WICHITA OR SEDGWICK COUNTY. THIS REVIEW IS ONLY FOR GENERAL CONFORMANCE OF THE CODE. THE CONTRACTOR IS RESPONSIBLE FOR CONFORMING AND CORRELATING ALL TECHNIQUES OF CONSTRUCTION. THIS APPROVAL IS SUBJECT TO PROVISIONS OF SECTION 107.4 OF THE 2012 INTERNATIONAL BUILDING CODE.

DATE: 02/19/25 BY: William Jerauld Jr

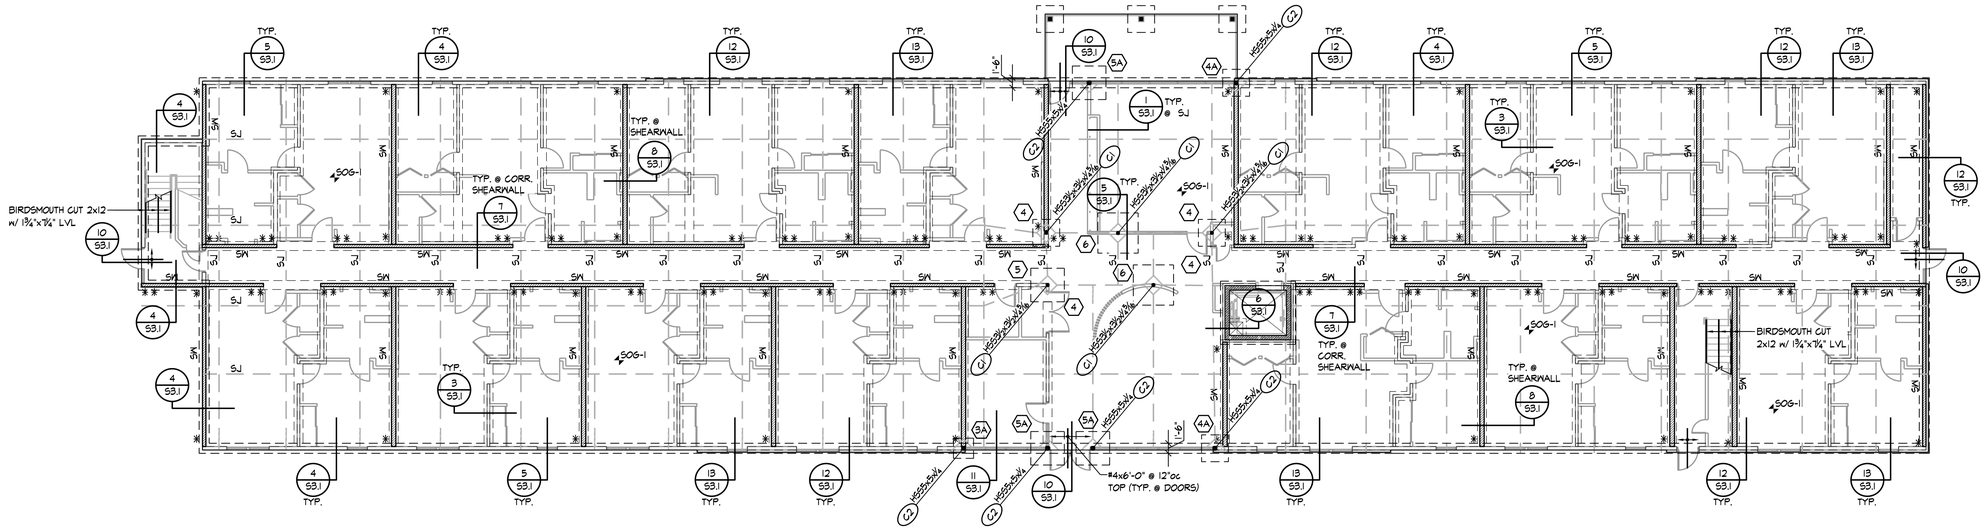

FOUNDATION PLAN

3/32" = 1'-0"

NOTES:

1. REFER TO GENERAL NOTES ON SHEET S1.0
2. REFER TO COLUMN & FOOTING SCHEDULE ON SHEET S1.1
3. T/C EL. 100'-0"
4. T/FTG. EL. 99'-4" U.N.O.
5. REFER TO ARCHITECTURAL DRAWINGS FOR DIMENSIONS NOT SHOWN
6. REFER TO SHEET S2.6 FOR SHEARWALL AND HOLDOWN INFORMATION
7. REFER TO SHEETS S1.1 AND S1.2 FOR TYPICAL NAILING WOOD FRAMING DETAILS

JonesGillamRenz
730 N. Ninth 1881 Main Street, Suite 301
Salina, KS 67401 Kansas City, MO 64108
785.827.0386 jgr@jgrarchitects.com

ANDOVER SENIOR LIVING

NEW APARTMENTS

ANDOVER, KANSAS

MICHAEL J. FALDER LICENSED 10296 1-3-2025 KANSAS PROFESSIONAL ENGINEER

REVISION:

DATE: 1-03-2025
JOB: 24-3385
SHEET NO.:

S2.1

BOB D. CAMPBELL & CO.
Structural Engineers Since 1957
4338 Belleview Ave. 816.531.4144
Kansas City, MO 64111 www.bdc-engrs.com

COPYRIGHTED ©

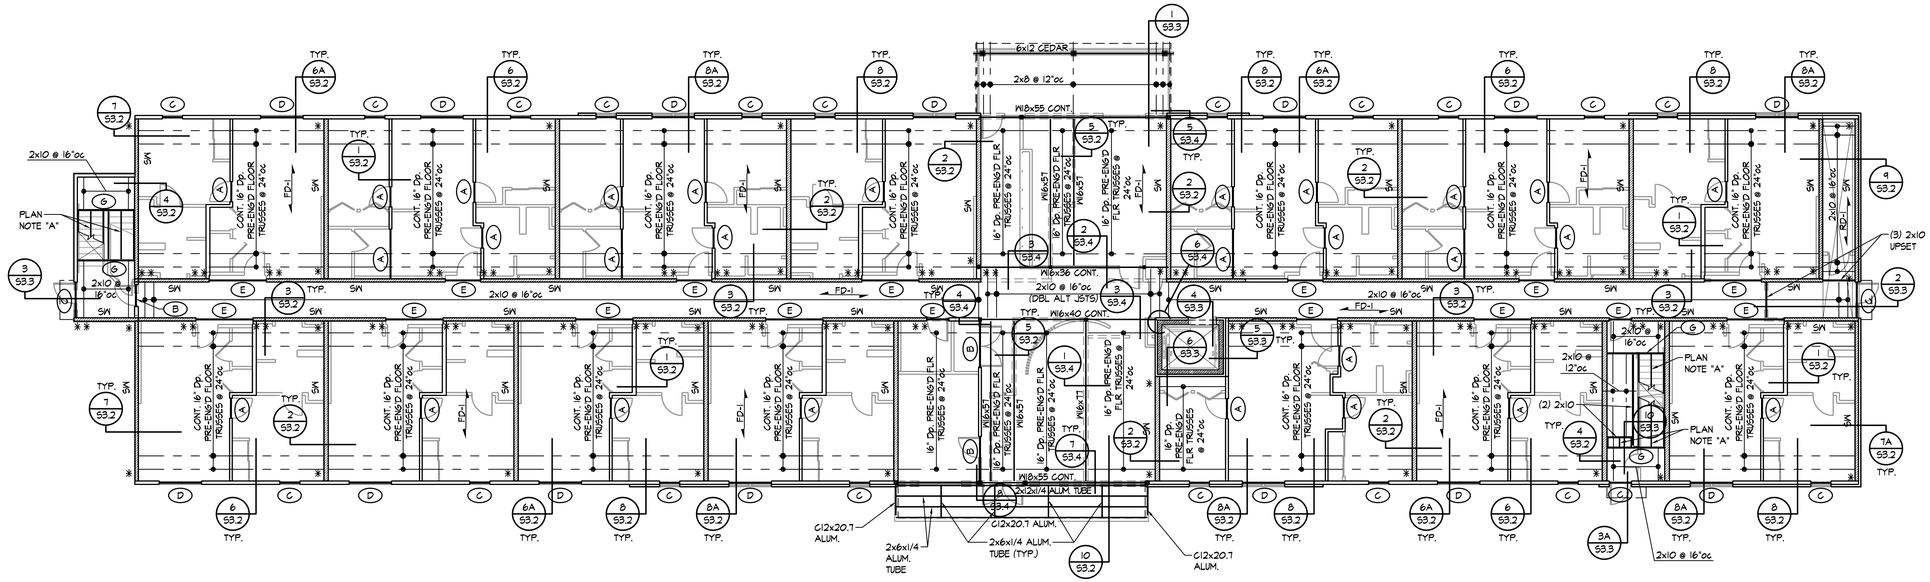

NORTH

SECOND FLOOR FRAMING PLAN

3/32" = 1'-0"

NOTES:

1. REFER TO GENERAL NOTES ON SHEET S1.0
2. REFER TO HEADER SCHEDULE ON SHEET S1.1
3. REFER TO ARCHITECTURAL DRAWINGS FOR DIMENSIONS NOT SHOWN
4. REFER TO SHEET S2.6 FOR SHEARWALL AND HOLDOWN INFORMATION
5. REFER TO SECTIONS 5A, 5B, 6A AND 6B ON SHEET S1.2 FOR HOLDOWN DETAILS AT THE SECOND FLOOR
6. REFER TO SHEETS S1.1 AND S1.2 FOR TYPICAL NAILING WOOD FRAMING DETAILS
7. PLAN NOTE "A" DENOTES BIRDSMOUTH CUT 2x12 w/ 1¾"x11¾" LVL @ EACH STAIR STRINGER

Wichita-Sedgwick County
Metropolitan Area Building
and Construction Department

REVIEWED FOR CODE COMPLIANCE

CORRECTIONS OR COMMENTS MADE ON THESE DRAWINGS AND THIS DOCUMENT DURING THIS REVIEW DO NOT RELIEVE CONTRACTOR FROM COMPLIANCE WITH ALL REQUIREMENTS OF THE CODE OF THE MABCD, THE CITY OF WICHITA OR SEDGWICK COUNTY. THIS REVIEW IS ONLY FOR GENERAL CONFORMANCE OF THE CODE. THE CONTRACTOR IS RESPONSIBLE FOR CONFORMING AND CORRELATING ALL TECHNIQUES OF CONSTRUCTION. THIS APPROVAL IS SUBJECT TO PROVISIONS OF SECTION 107.4 OF THE 2012 INTERNATIONAL BUILDING CODE.

DATE: 02/19/25 BY: William Jerauld Jr

JonesGillamRenz
730 N. Ninth 1881 Main Street, Suite 301
Salina, KS 67401 Kansas City, MO 64108
785.827.0386 jgr@jgrarchitects.com

ANDOVER SENIOR LIVING

NEW APARTMENTS

ANDOVER, KANSAS

MICHAEL J. FALL LICENSED 10290 1-3-2025 KANSAS PROFESSIONAL ENGINEER

REVISION:

DATE: 1-03-2025
JOB: 24-3385
SHEET NO.:

S2.2

BOB D. CAMPBELL & CO.
Structural Engineers Since 1957
4338 Belleview Ave. 816.531.4144
Kansas City, MO 64111 www.bdc-engrs.com

COPYRIGHTED ©

Wichita-Sedgwick County
Metropolitan Area Building
and Construction Department

REVIEWED FOR CODE COMPLIANCE

CORRECTIONS OR COMMENTS MADE ON THESE DRAWINGS AND THIS DOCUMENT DURING THIS REVIEW DO NOT RELIEVE CONTRACTOR FROM COMPLIANCE WITH ALL REQUIREMENTS OF THE CODE OF THE MABCD, THE CITY OF WICHITA OR SEDGWICK COUNTY. THIS REVIEW IS ONLY FOR GENERAL CONFORMANCE OF THE CODE. THE CONTRACTOR IS RESPONSIBLE FOR CONFORMING AND CORRELATING ALL TECHNIQUES OF CONSTRUCTION. THIS APPROVAL IS SUBJECT TO PROVISIONS OF SECTION 107.4 OF THE 2012 INTERNATIONAL BUILDING CODE.

DATE: 02/19/25 BY: William Jerauld Jr

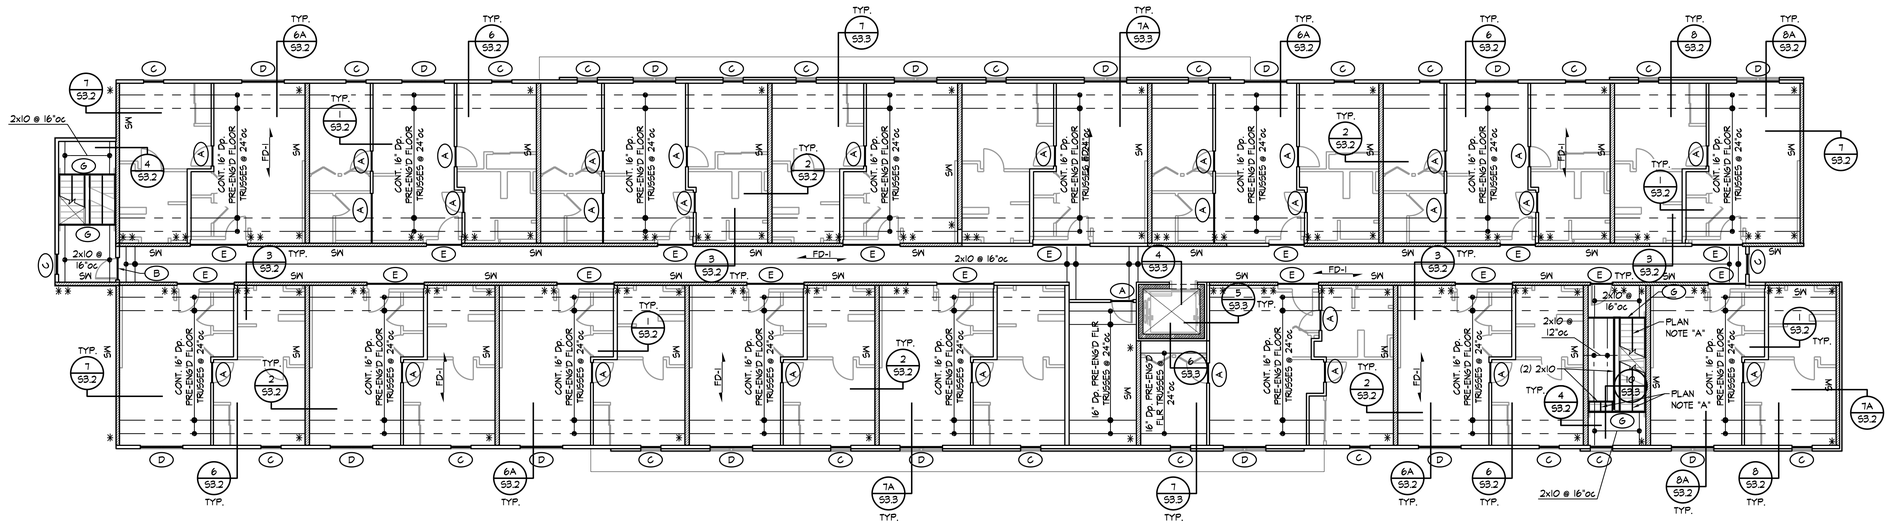

NORTH

THIRD FLOOR FRAMING PLAN

3/32" = 1'-0"

NOTES:

1. REFER TO GENERAL NOTES ON SHEET S1.0
2. REFER TO HEADER SCHEDULE ON SHEET S1.1
3. REFER TO ARCHITECTURAL DRAWINGS FOR DIMENSIONS NOT SHOWN
4. REFER TO SHEET S2.6 FOR SHEARWALL AND HOLDOWN INFORMATION
5. REFER TO SECTIONS 5A, 5B, 6A AND 6B ON SHEET S1.2 FOR HOLDOWN DETAILS AT THE SECOND FLOOR
6. REFER TO SHEETS S1.1 AND S1.2 FOR TYPICAL NAILING WOOD FRAMING DETAILS
7. PLAN NOTE "A" DENOTES BIRDSMOUTH CUT 2x12 w/ 1¾"x7¼" LVL @ EACH STAIR STRINGER

JonesGillamRenz
730 N. Ninth 1881 Main Street, Suite 301
Salina, KS 67401 Kansas City, MO 64108
785.827.0386 jgr@jgrarchitects.com

ANDOVER SENIOR LIVING

NEW APARTMENTS

ANDOVER, KANSAS

MICHAEL J. FALDER LICENSED 10296 1-3-2025 KANSAS PROFESSIONAL ENGINEER

REVISION:

DATE: 1-03-2025
JOB: 24-3385
SHEET NO.:

S2.3

BOB D. CAMPBELL & CO.
Structural Engineers Since 1957
4338 Belleview Ave. 816.531.4144
Kansas City, MO 64111 www.bdc-engrs.com

COPYRIGHTED ©

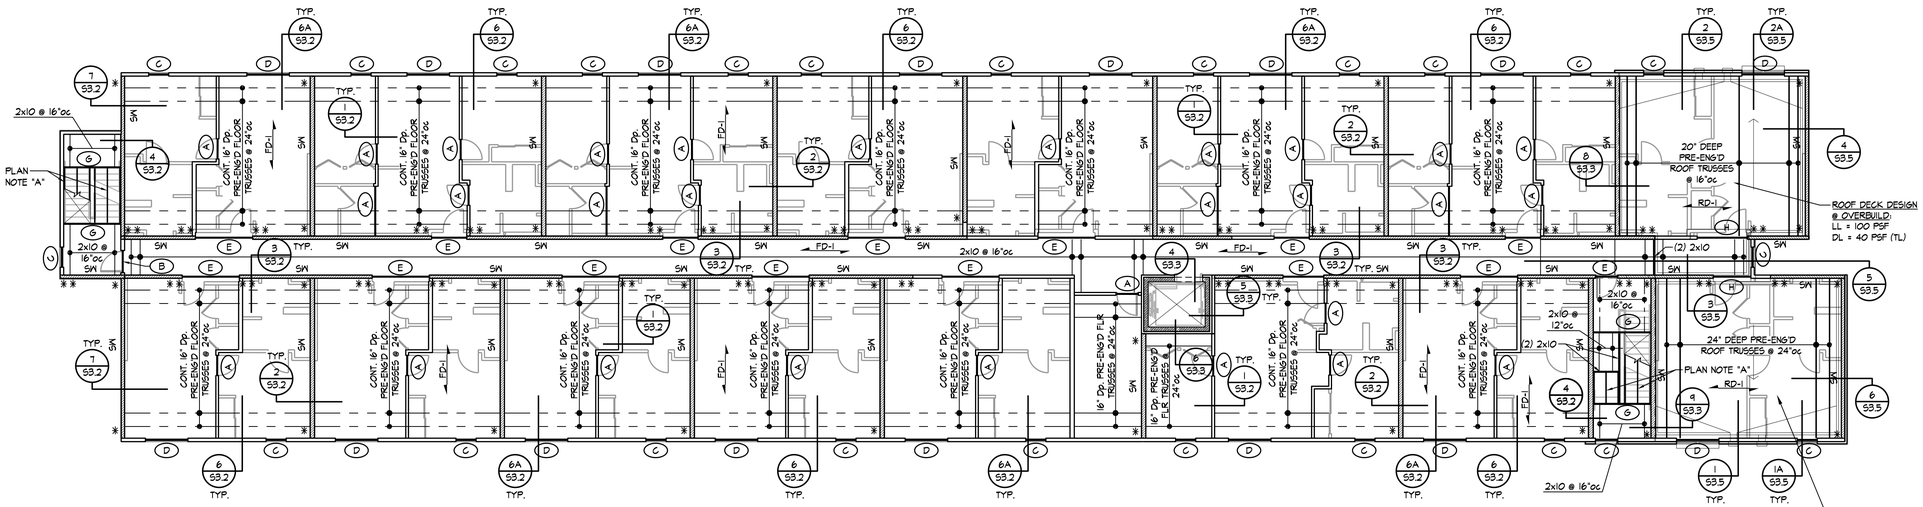

FOURTH FLOOR & LOW ROOF FRAMING PLAN

3/32" = 1'-0"

NOTES:

1. REFER TO GENERAL NOTES ON SHEET S1.0
2. REFER TO HEADER SCHEDULE ON SHEET S1.1
3. REFER TO ARCHITECTURAL DRAWINGS FOR DIMENSIONS NOT SHOWN
4. REFER TO SHEET S2.6 FOR SHEARWALL AND HOLDOWN INFORMATION
5. REFER TO SECTIONS 5A, 5B, 6A AND 6B ON SHEET S1.2 FOR HOLDOWN DETAILS AT THE SECOND FLOOR
6. REFER TO SHEETS S1.1 AND S1.2 FOR TYPICAL NAILING WOOD FRAMING DETAILS
7. PLAN NOTE "A" DENOTES BIRDSMOUTH CUT 2x12 W/ 1¾"x11¼" LVL @ EACH STAIR STRINGER
8. ALL EXTERIOR DECK FRAMING TO BE TREATED LUMBER AT EXTERIOR ROOF DECK

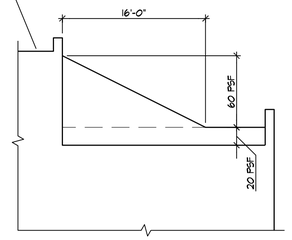

DESIGN SNOW DRIFT AT LOW ROOF

Wichita-Sedgwick County
Metropolitan Area Building
and Construction Department

REVIEWED FOR CODE COMPLIANCE

CORRECTIONS OR COMMENTS MADE ON THESE DRAWINGS AND THIS DOCUMENT DURING THIS REVIEW DO NOT RELIEVE CONTRACTOR FROM COMPLIANCE WITH ALL REQUIREMENTS OF THE CODE OF THE MABCD, THE CITY OF WICHITA OR SEDGWICK COUNTY. THIS REVIEW IS ONLY FOR GENERAL CONFORMANCE OF THE CODE. THE CONTRACTOR IS RESPONSIBLE FOR CONFORMING AND CORRELATING ALL TECHNIQUES OF CONSTRUCTION. THIS APPROVAL IS SUBJECT TO PROVISIONS OF SECTION 107.4 OF THE 2012 INTERNATIONAL BUILDING CODE.

DATE: 02/19/25 BY: William Jerauld Jr

JonesGillamRenz
730 N. Ninth 1881 Main Street, Suite 301
Salina, KS 67401 Kansas City, MO 64108
785.827.0386 jgr@jgrarchitects.com

ANDOVER SENIOR LIVING

NEW APARTMENTS

ANDOVER, KANSAS

MICHAEL J. FALK
10298
1-3-2025
KANSAS
PROFESSIONAL ENGINEER

REVISION:

DATE: 1-03-2025
JOB: 24-3385
SHEET NO.:

S2.4

BOB D. CAMPBELL & CO.
Structural Engineers Since 1957
4338 Belleview Ave. 816.531.4144
Kansas City, MO 64111 www.bdc-engrs.com

COPYRIGHTED©

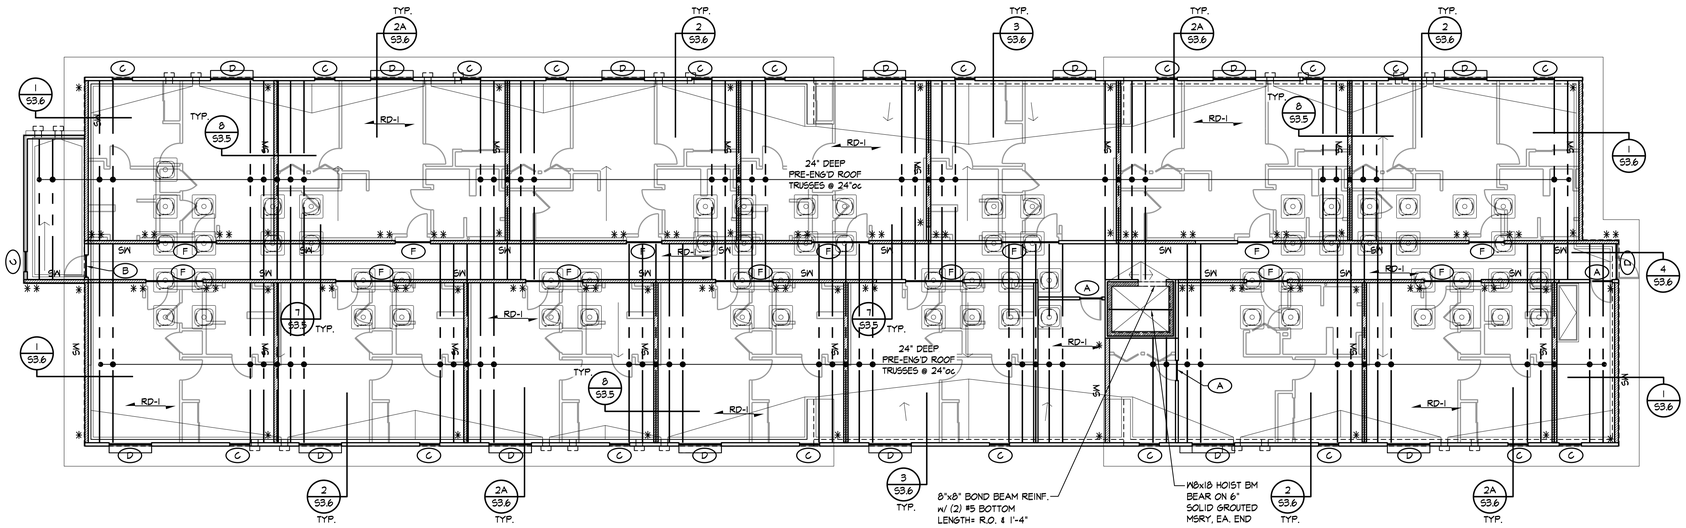

NORTH

ROOF FRAMING PLAN

3/32" = 1'-0"

NOTES:

1. REFER TO GENERAL NOTES ON SHEET S1.0
2. REFER TO HEADER SCHEDULE ON SHEET S1.1
3. REFER TO ARCHITECTURAL DRAWINGS FOR DIMENSIONS NOT SHOWN
4. PROVIDE TRIPLE 2x6 OR QUADRUPLE 2x4 STUDS AT ALL PRE-ENG. TRUSS GIRDERS (EXTEND TO FOUNDATION)
5. REFER TO SHEETS S1.1 AND S1.2 FOR TYPICAL NAILING WOOD FRAMING DETAILS

Wichita-Sedgwick County
Metropolitan Area Building
and Construction Department

REVIEWED FOR CODE COMPLIANCE

CORRECTIONS OR COMMENTS MADE ON THESE DRAWINGS AND THIS DOCUMENT DURING THIS REVIEW DO NOT RELIEVE CONTRACTOR FROM COMPLIANCE WITH ALL REQUIREMENTS OF THE CODE OF THE MABCD, THE CITY OF WICHITA OR SEDGWICK COUNTY. THIS REVIEW IS ONLY FOR GENERAL CONFORMANCE OF THE CODE. THE CONTRACTOR IS RESPONSIBLE FOR CONFORMING AND CORRELATING ALL TECHNIQUES OF CONSTRUCTION. THIS APPROVAL IS SUBJECT TO PROVISIONS OF SECTION 107.4 OF THE 2012 INTERNATIONAL BUILDING CODE.

DATE: 02/19/25 BY: William Jerauld Jr

JonesGillamRenz
730 N. Ninth 1881 Main Street, Suite 301
Salina, KS 67401 Kansas City, MO 64108
785.827.0386 jgr@jgrarchitects.com

ANDOVER SENIOR LIVING
NEW APARTMENTS
ANDOVER, KANSAS

MICHAEL J. FALK
LICENSED
10296
1-3-2025
KANSAS
PROFESSIONAL ENGINEER

REVISION:

DATE: 1-03-2025
JOB: 24-3385
SHEET NO.:

S2.5

BOB D. CAMPBELL & CO.
Structural Engineers Since 1957
4338 Belleview Ave. 816.531.4144
Kansas City, MO 64111 www.bdc-engrs.com

COPYRIGHTED©

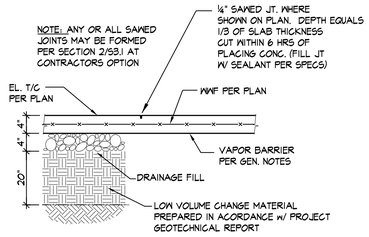

TYPICAL SAW JOINT
NOTED "SJ" ON PLAN

SECTION 1 S3.1
¾" = 1'-0"

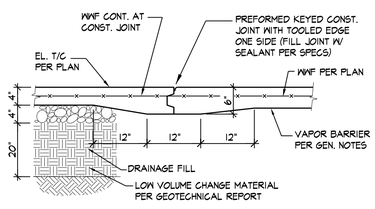

TYP. CONST JT (CJ)
MAY BE SUBSTITUTED FOR SJ AT CONTRACTOR'S OPTION

SECTION 2 S3.1
¾" = 1'-0"

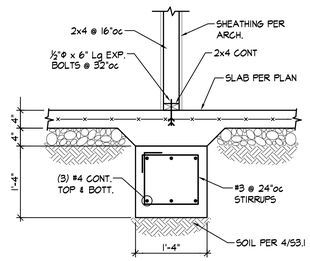

TYP. THICKENED SLAB @ INT. BRG. WALL

SECTION 3 S3.1
¾" = 1'-0"

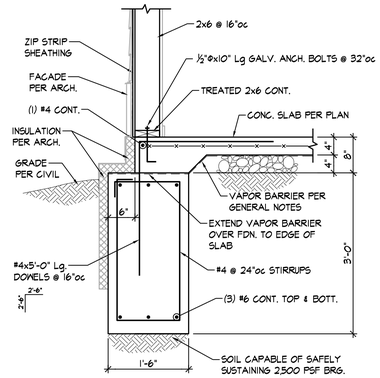

SECTION 4 S3.1
¾" = 1'-0"

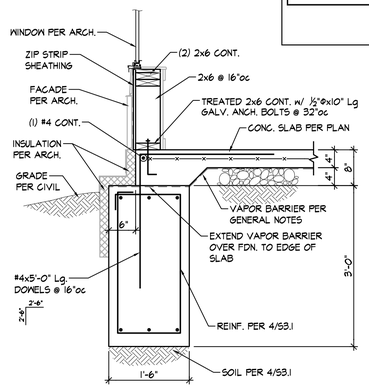

SECTION 5 S3.1
¾" = 1'-0"

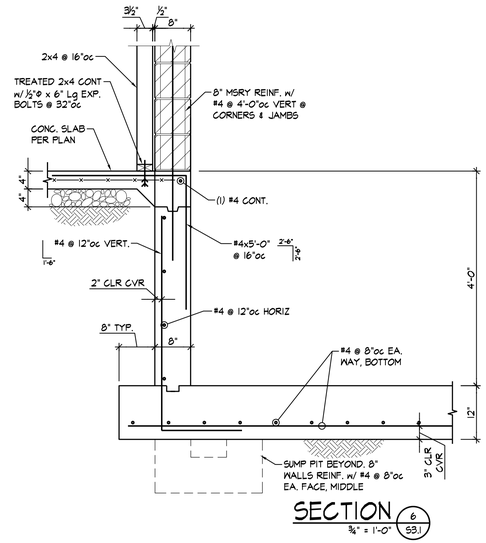

SECTION 6 S3.1
¾" = 1'-0"

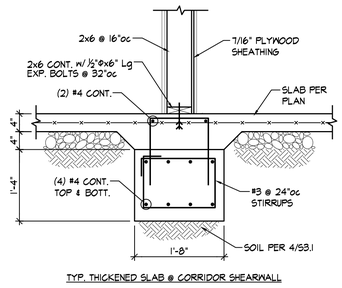

TYP. THICKENED SLAB @ CORRIDOR SHEARWALL

SECTION 7 S3.1
¾" = 1'-0"

NOTE: @ ENDS OF SHEARWALLS, PROVIDE SIMPSON HDS-SDS2.5 HOLDDOWN ANCHOR w/ DBL STUD & ⅝"ø x 1'Lg EXP. BOLT

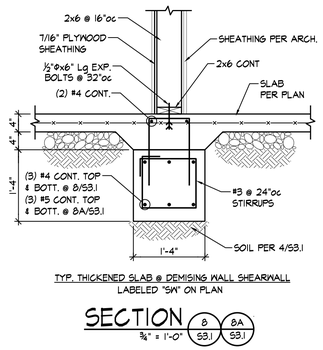

TYP. THICKENED SLAB @ DEMISING WALL SHEARWALL
LABELED "SW" ON PLAN

SECTION 8 8A S3.1
¾" = 1'-0"

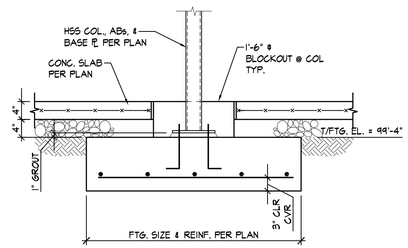

SECTION 9 S3.1
¾" = 1'-0"

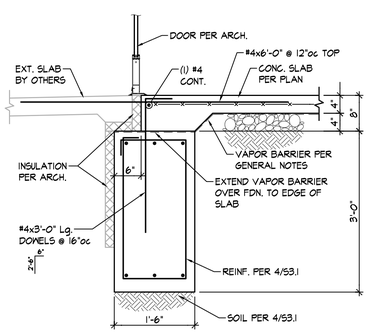

SECTION 10 S3.1
¾" = 1'-0"

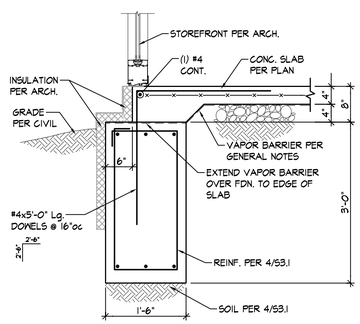

SECTION 11 S3.1
¾" = 1'-0"

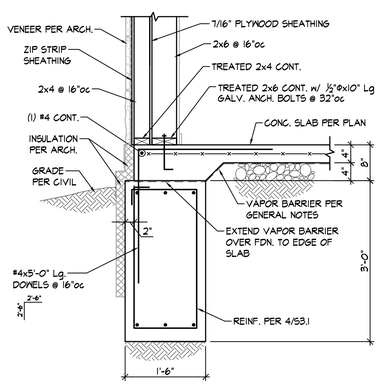

SECTION 12 S3.1
¾" = 1'-0"

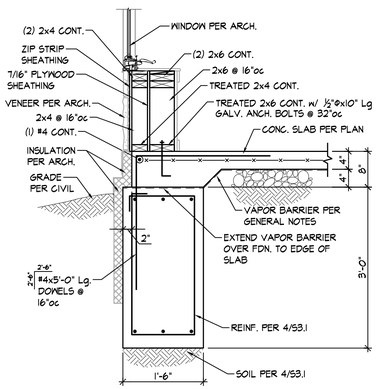

SECTION 13 S3.1
¾" = 1'-0"

Wichita-Sedgwick County
Metropolitan Area Building and Construction Department

REVIEWED FOR CODE COMPLIANCE

CORRECTIONS OR COMMENTS MADE ON THESE DRAWINGS AND THIS DOCUMENT DURING THIS REVIEW DO NOT RELIEVE CONTRACTOR FROM COMPLIANCE WITH ALL REQUIREMENTS OF THE CODE OF THE MARCH, THE CITY OF WICHITA OR SEDGWICK COUNTY. THIS REVIEW IS ONLY FOR GENERAL CONFORMANCE OF THE CODE. THE CONTRACTOR IS RESPONSIBLE FOR CONFORMING AND CORRELATING ALL TECHNIQUES OF CONSTRUCTION. THIS APPROVAL IS SUBJECT TO PROVISIONS OF SECTION 107.4 OF THE 2012 INTERNATIONAL BUILDING CODE.

DATE: 02/19/25 BY: William Jerauld Jr

JonesGillamRenz
730 N. Ninth 1881 Main Street, Suite 301
Salina, KS 67401 Kansas City, MO 64108
785.827.0386 jgr@jgrarchitects.com

JGR

ANDOVER SENIOR LIVING

NEW APARTMENTS

ANDOVER, KANSAS



REVISION:

DATE: 1-03-2025
JOB: 24-3385
SHEET NO.:

S3.1

BOB D. CAMPBELL & CO.
Structural Engineers Since 1957
4338 Belleview Ave. 816.531.4144
Kansas City, MO 64111 www.bdc-engrs.com

COPYRIGHTED©

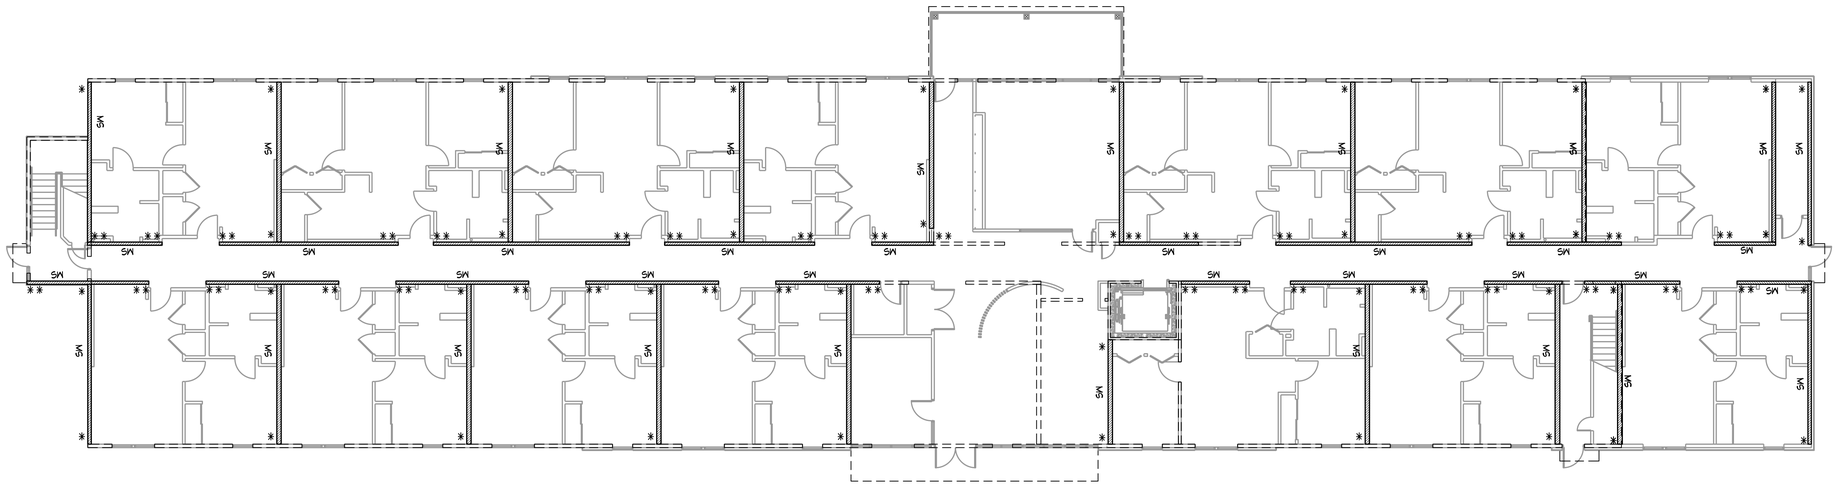

SHEARWALL PLAN

3/32" = 1'-0"

NOTES:

1. REFER TO GENERAL NOTES ON SHEET S1.0
2. REFER TO SHEARWALL & HOLDOWN SCHEDULES ON SHEET S1.2
3. SHEARWALLS/HOLDOWNS DESIGNATED AS FOLLOWS:

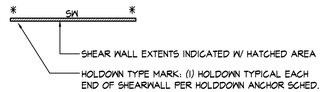

4. REFER TO DETAILS 2/S1.2 & 3/S1.2 FOR HOLDOWNS AT END OF WALL

Wichita-Sedgwick County
Metropolitan Area Building
and Construction Department

REVIEWED FOR CODE COMPLIANCE

CORRECTIONS OR COMMENTS MADE ON THESE DRAWINGS AND THIS DOCUMENT DURING THIS REVIEW DO NOT RELIEVE CONTRACTOR FROM COMPLIANCE WITH ALL REQUIREMENTS OF THE CODE OF THE MABCD, THE CITY OF WICHITA OR SEDGWICK COUNTY. THIS REVIEW IS ONLY FOR GENERAL CONFORMANCE OF THE CODE. THE CONTRACTOR IS RESPONSIBLE FOR CONFORMING AND CORRELATING ALL TECHNIQUES OF CONSTRUCTION. THIS APPROVAL IS SUBJECT TO PROVISIONS OF SECTION 107.4 OF THE 2012 INTERNATIONAL BUILDING CODE.

DATE: 02/19/25 BY: William Jerauld Jr

JonesGillamRenz
730 N. Ninth 1881 Main Street, Suite 301
Salina, KS 67401 Kansas City, MO 64108
785.827.0386 jgr@jgrarchitects.com

ANDOVER SENIOR LIVING

NEW APARTMENTS

ANDOVER, KANSAS

MICHAEL J. FALK LICENSED 10296 1-3-2025 KANSAS PROFESSIONAL ENGINEER

REVISION:

DATE: 1-03-2025

JOB: 24-3385

SHEET NO.:

S2.6

BOB D. CAMPBELL & CO.
Structural Engineers Since 1957
4338 Belleview Ave. 816.531.4144
Kansas City, MO 64111 www.bdc-engrs.com

COPYRIGHTED ©

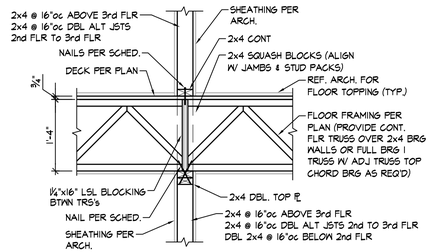

SECTION 1 S3.2
3/4" = 1'-0"

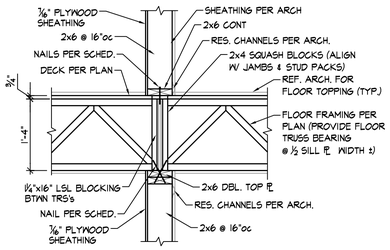

SECTION 2 S3.2
3/4" = 1'-0"

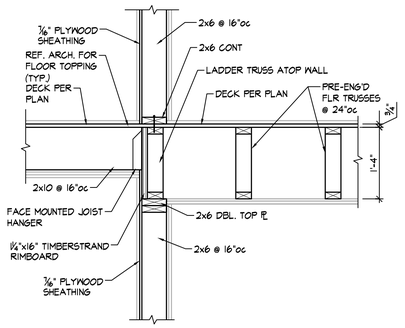

SECTION 3 S3.2
3/4" = 1'-0"

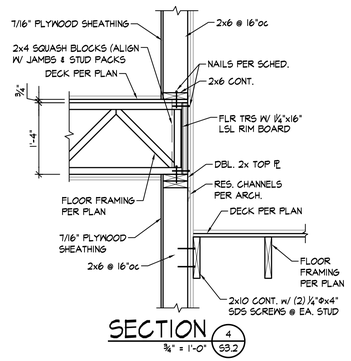

SECTION 4 S3.2
3/4" = 1'-0"

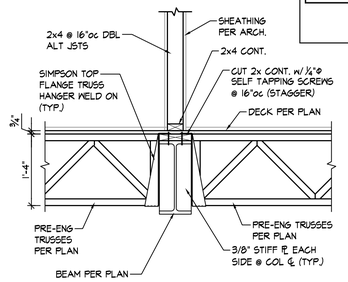

SECTION 5 S3.2
3/4" = 1'-0"

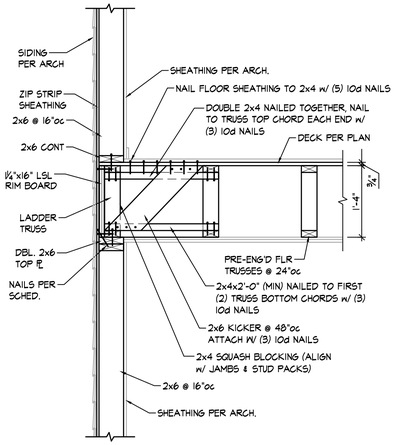

SECTION 6 S3.2
3/4" = 1'-0"

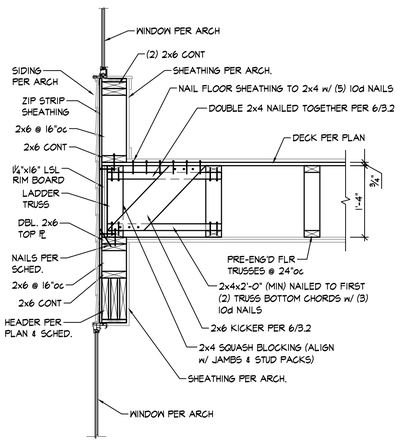

SECTION 6A S3.2
3/4" = 1'-0"

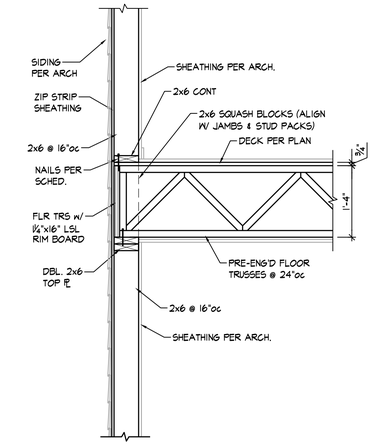

SECTION 7 S3.2
3/4" = 1'-0"

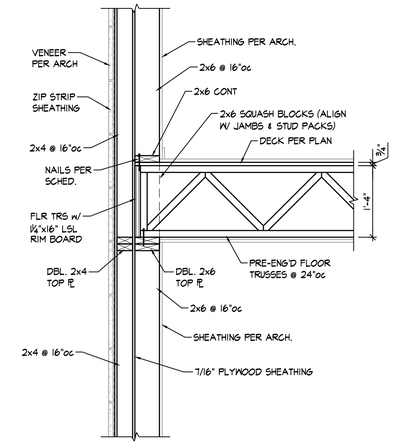

SECTION 7A S3.2
3/4" = 1'-0"

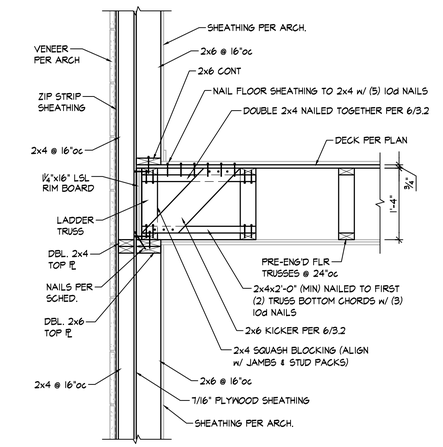

SECTION 8 S3.2
3/4" = 1'-0"

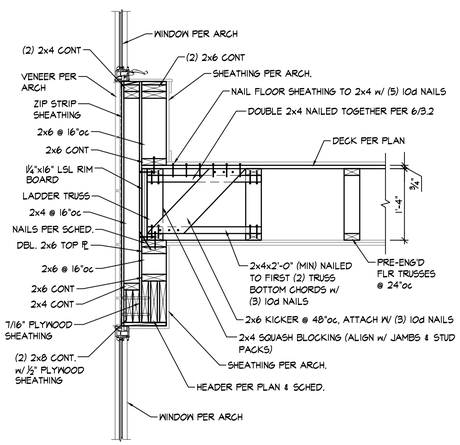

SECTION 8A S3.2
3/4" = 1'-0"

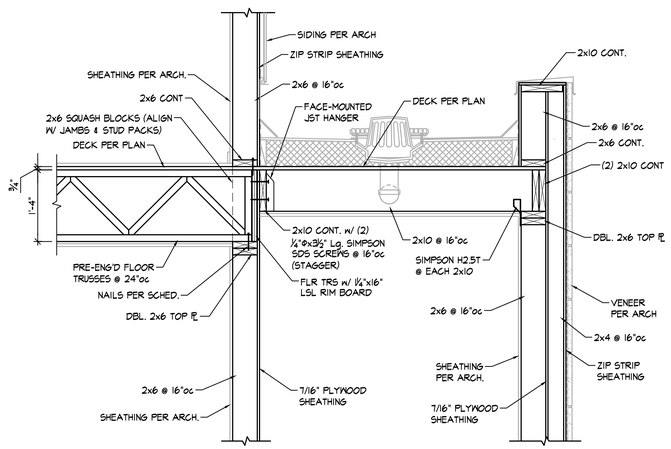

SECTION 9 S3.2
3/4" = 1'-0"

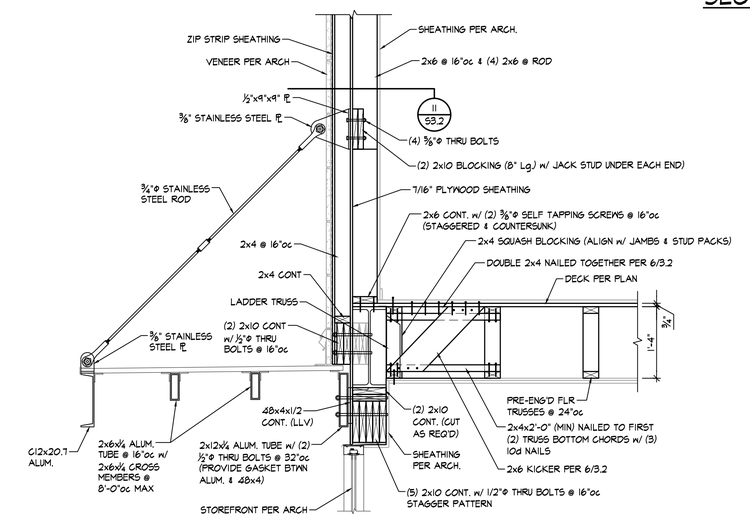

SECTION 10 S3.2
3/4" = 1'-0"

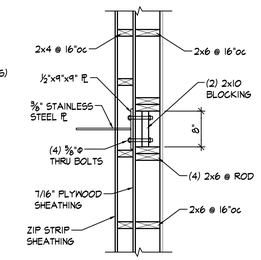

SECTION 11 S3.2
3/4" = 1'-0"

SECTION 8 S3.2
3/4" = 1'-0"

Wichita-Sedgwick County
Metropolitan Area Building
and Construction Department

REVIEWED FOR CODE COMPLIANCE

CORRECTIONS OR COMMENTS MADE ON THESE DRAWINGS AND THIS DOCUMENT DURING THIS REVIEW DO NOT RELIEVE CONTRACTOR FROM COMPLIANCE WITH ALL REQUIREMENTS OF THE CODE OF THE MABCD, THE CITY OF WICHITA OR SEDGWICK COUNTY. THIS REVIEW IS ONLY FOR GENERAL CONFORMANCE OF THE CODE. THE CONTRACTOR IS RESPONSIBLE FOR CONFORMING AND CORRELATING ALL TECHNIQUES OF CONSTRUCTION. THIS APPROVAL IS SUBJECT TO PROVISIONS OF SECTION 107.4 OF THE 2012 INTERNATIONAL BUILDING CODE.

DATE: 02/19/25 BY: William Jerauld Jr

JonesGillamRenz
730 N. Ninth 1881 Main Street, Suite 301
Salina, KS 67401 Kansas City, MO 64108
785.827.0386 jgr@jgrarchitects.com

ANDOVER SENIOR LIVING

NEW APARTMENTS

ANDOVER, KANSAS

MICHAEL J. FALDYN
10299
1-3-25
KANSAS
PROFESSIONAL ENGINEER

REVISION:

DATE: 1-03-2025
JOB: 24-3385
SHEET NO.:

S3.2

BOB D. CAMPBELL & CO.
Structural Engineers Since 1957
4338 Belleview Ave.
Kansas City, MO 64111 816.531.4144
www.bdc-engrs.com

COPYRIGHTED©

Wichita-Sedgwick County
Metropolitan Area Building
and Construction Department

REVIEWED FOR CODE COMPLIANCE

CORRECTIONS OR COMMENTS MADE ON THESE DRAWINGS AND THIS DOCUMENT DURING THIS REVIEW DO NOT RELIEVE CONTRACTOR FROM COMPLIANCE WITH ALL REQUIREMENTS OF THE CODE OF THE MARCH, THE CITY OF WICHITA OR SEDGWICK COUNTY. THIS REVIEW IS ONLY FOR GENERAL CONFORMANCE OF THE CODE. THE CONTRACTOR IS RESPONSIBLE FOR CONFORMING AND CORRELATING ALL TECHNIQUES OF CONSTRUCTION. THIS APPROVAL IS SUBJECT TO PROVISIONS OF SECTION 107.4 OF THE 2012 INTERNATIONAL BUILDING CODE.

DATE: 02/19/25 BY: William Jerauld Jr

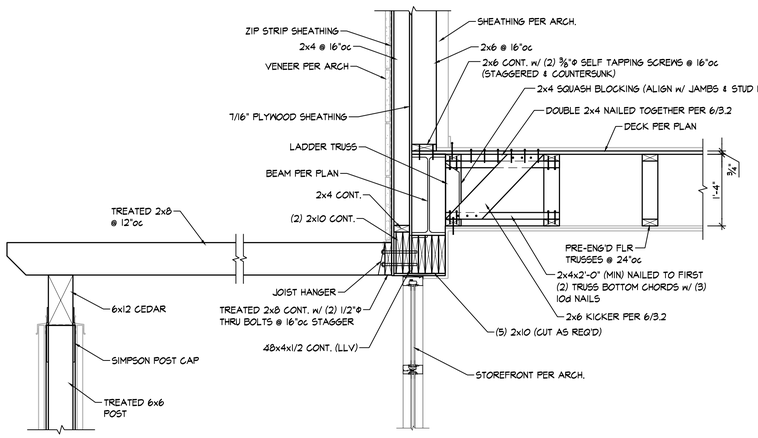

SECTION 1 — 3/4" = 1'-0" — 53.3

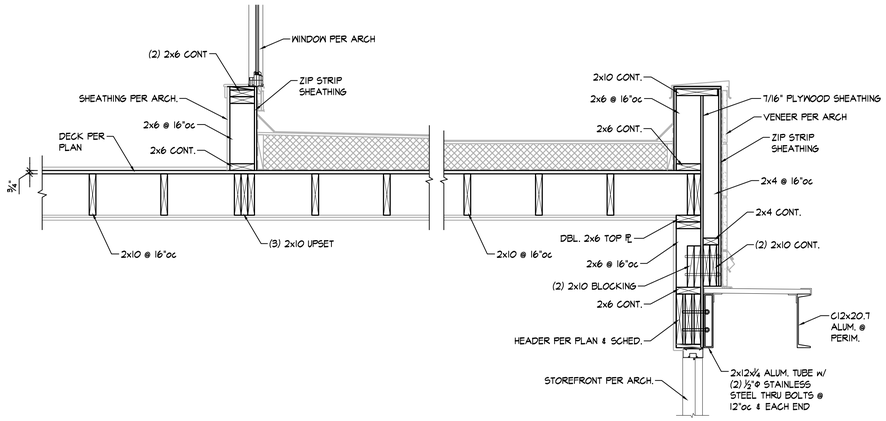

SECTION 2 — 3/4" = 1'-0" — 53.3

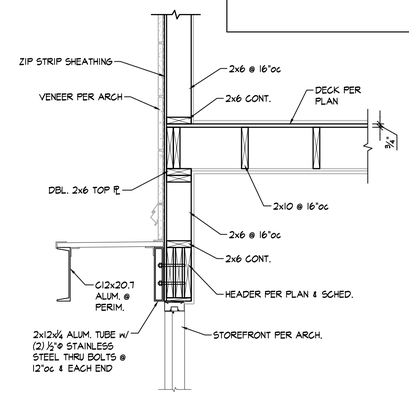

SECTION 3 — 3/4" = 1'-0" — 53.3

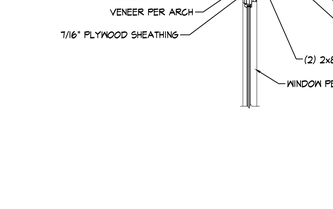

SECTION 3A — 3/4" = 1'-0" — 53.3



SECTION 4 — 3/4" = 1'-0" — 53.3

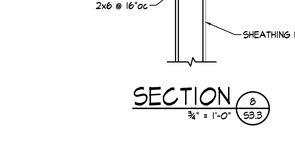

SECTION 5 — 3/4" = 1'-0" — 53.3

SECTION 6 — 3/4" = 1'-0" — 53.3

SECTION 7 — 3/4" = 1'-0" — 53.3

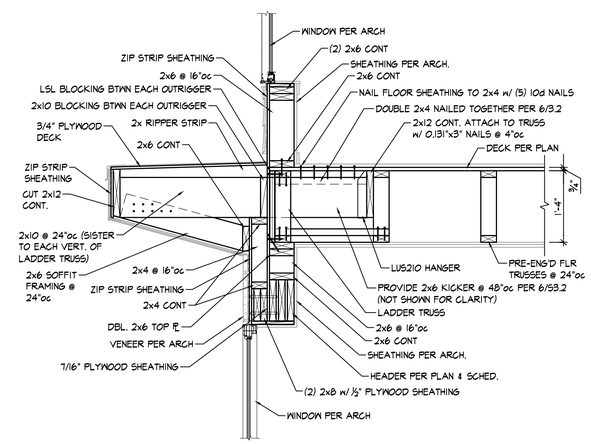

SECTION 7A — 3/4" = 1'-0" — 53.3

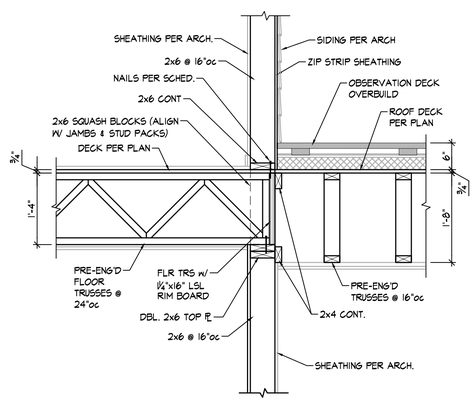

SECTION 8 — 3/4" = 1'-0" — 53.3

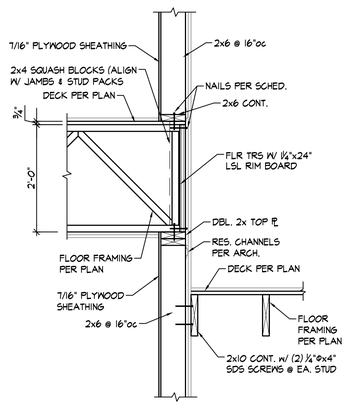

SECTION 9 — 3/4" = 1'-0" — 53.3

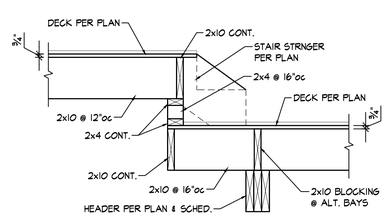

SECTION 10 — 3/4" = 1'-0" — 53.3

JonesGillamRenz
730 N. Ninth 1881 Main Street, Suite 301
Salina, KS 67401 Kansas City, MO 64108
785.827.0386 jgr@jgrarchitects.com

ANDOVER SENIOR LIVING

NEW APARTMENTS

ANDOVER, KANSAS

MICHAEL J. FALDYN LICENSED 10296 1-3-2025 KANSAS PROFESSIONAL ENGINEER

REVISION:

DATE: 1-03-2025
JOB: 24-3385
SHEET NO.:

S3.3

COPYRIGHT©

BOB D. CAMPBELL & CO.
Structural Engineers Since 1957
4338 Belleview Ave. 816.531.4144
Kansas City, MO 64111 www.bdc-engrs.com

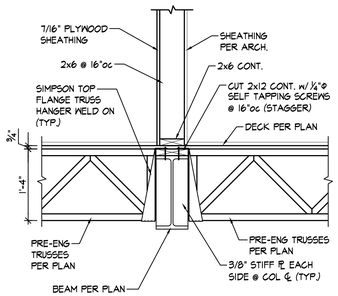

SECTION 1 — ¾" = 1'-0" — 53.4

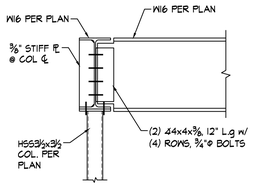

SECTION 2 — ¾" = 1'-0" — 53.4

NOTE: WOOD FRAMING OMITTED FOR CLARITY.

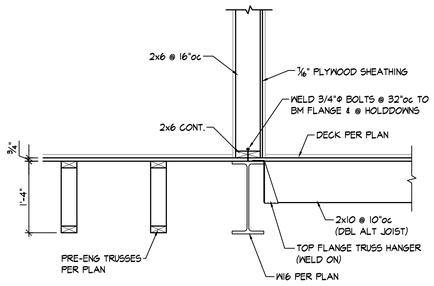

SECTION 3 — ¾" = 1'-0" — 53.4

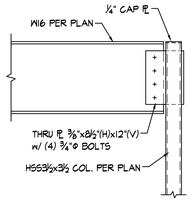

SECTION 4 — ¾" = 1'-0" — 53.4

NOTE: WOOD FRAMING OMITTED FOR CLARITY.

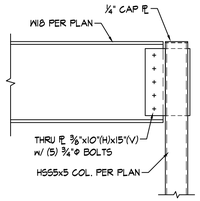

SECTION 5 — ¾" = 1'-0" — 53.4

NOTE: WOOD FRAMING OMITTED FOR CLARITY.

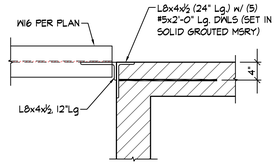

DETAIL 6 — ¾" = 1'-0" — 53.4

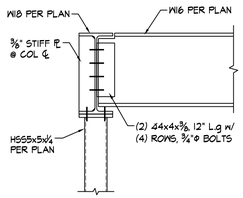

SECTION 7 — ¾" = 1'-0" — 53.4

NOTE: WOOD FRAMING OMITTED FOR CLARITY.

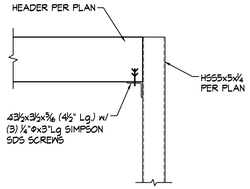

SECTION 8 — ¾" = 1'-0" — 53.4

NOTE: WOOD FRAMING OMITTED FOR CLARITY.

Wichita-Sedgwick County
Metropolitan Area Building
and Construction Department

REVIEWED FOR CODE COMPLIANCE

CORRECTIONS OR COMMENTS MADE ON THESE DRAWINGS AND THIS DOCUMENT DURING THIS REVIEW DO NOT RELIEVE CONTRACTOR FROM COMPLIANCE WITH ALL REQUIREMENTS OF THE CODE OF THE MABCD, THE CITY OF WICHITA OR SEDGWICK COUNTY. THIS REVIEW IS ONLY FOR GENERAL CONFORMANCE OF THE CODE. THE CONTRACTOR IS RESPONSIBLE FOR CONFORMING AND CORRELATING ALL TECHNIQUES OF CONSTRUCTION. THIS APPROVAL IS SUBJECT TO PROVISIONS OF SECTION 107.4 OF THE 2012 INTERNATIONAL BUILDING CODE.

DATE: 02/19/25 BY: William Jerauld Jr

JonesGillamRenz
730 N. Ninth 1881 Main Street, Suite 301
Salina, KS 67401 Kansas City, MO 64108
785.827.0386 jgr@jgrarchitects.com

ANDOVER SENIOR LIVING

NEW APARTMENTS

ANDOVER, KANSAS



REVISION:

DATE: 1-03-2025

JOB: 24-3385

SHEET NO.:

S3.4

BOB D. CAMPBELL & CO.
Structural Engineers Since 1957
4338 Belleview Ave. 816.531.4144
Kansas City, MO 64111 www.bdc-engrs.com

COPYRIGHTED ©

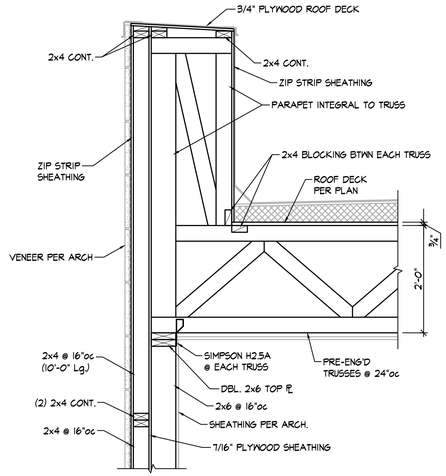

SECTION 1 — 3/4" = 1'-0" — S3.5

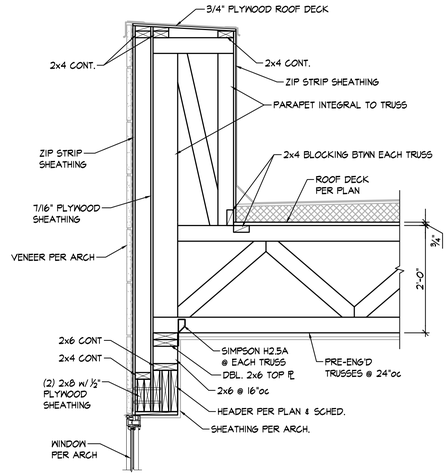

SECTION 1A — 3/4" = 1'-0" — S3.5

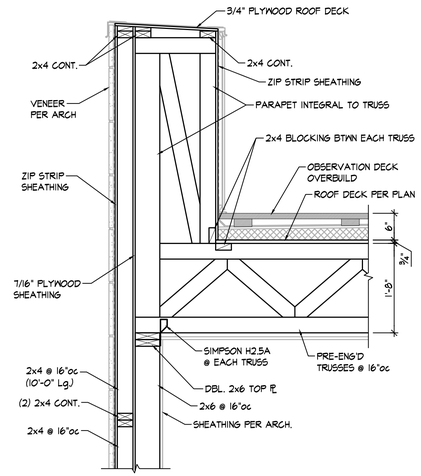

SECTION 2 — 3/4" = 1'-0" — S3.5

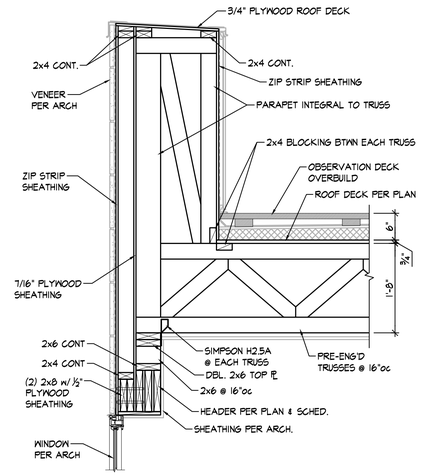

SECTION 2A — 3/4" = 1'-0" — S3.5

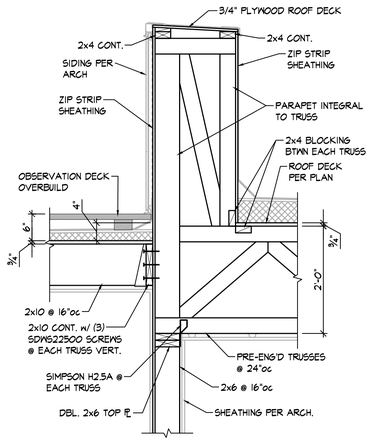

SECTION 3 — 3/4" = 1'-0" — S3.5

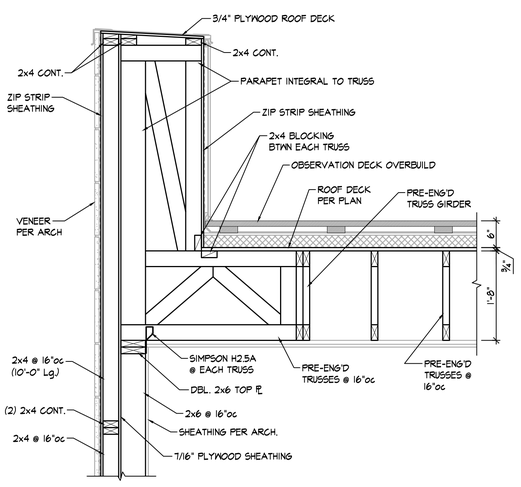

SECTION 4 — 3/4" = 1'-0" — S3.5

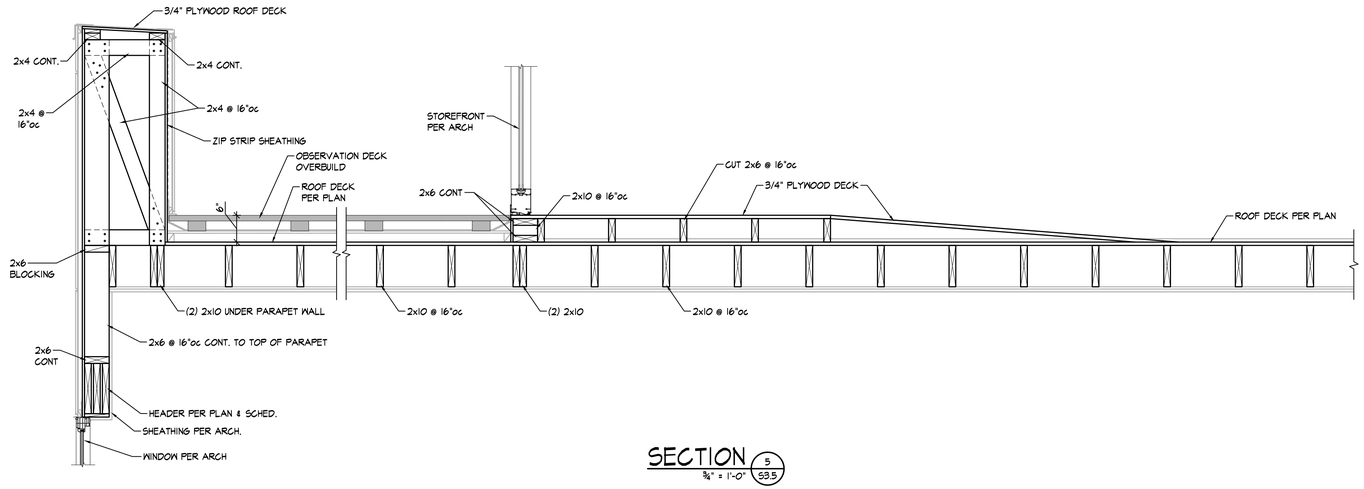

SECTION 5 — 3/4" = 1'-0" — S3.5

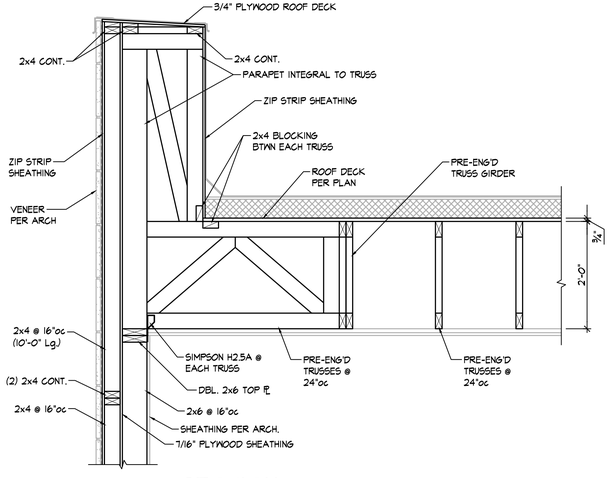

SECTION 6 — 3/4" = 1'-0" — S3.5

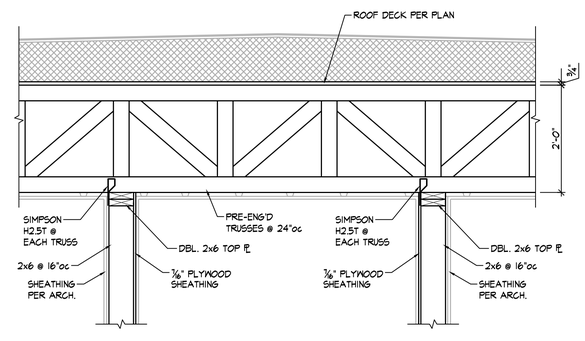

SECTION 7 — 3/4" = 1'-0" — S3.5

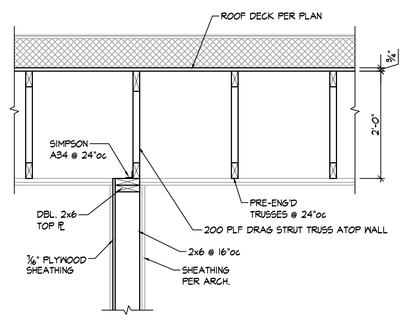

SECTION 8 — 3/4" = 1'-0" — S3.5

Wichita-Sedgwick County
Metropolitan Area Building
and Construction Department

REVIEWED FOR CODE COMPLIANCE

CORRECTIONS OR COMMENTS MADE ON THESE DRAWINGS AND THIS DOCUMENT DURING THIS REVIEW DO NOT RELIEVE CONTRACTOR FROM COMPLIANCE WITH ALL REQUIREMENTS OF THE CODE OF THE MABCD, THE CITY OF WICHITA OR SEDGWICK COUNTY. THIS REVIEW IS ONLY FOR GENERAL CONFORMANCE OF THE CODE. THE CONTRACTOR IS RESPONSIBLE FOR CONFORMING AND CORRELATING ALL TECHNIQUES OF CONSTRUCTION. THIS APPROVAL IS SUBJECT TO PROVISIONS OF SECTION 107.4 OF THE 2012 INTERNATIONAL BUILDING CODE.

DATE: 02/19/25 BY: William Jerauld Jr

JonesGillamRenz
730 N. Ninth 1881 Main Street, Suite 301
Salina, KS 67401 Kansas City, MO 64108
785.827.0386 jgr@jgrarchitects.com

ANDOVER SENIOR LIVING

NEW APARTMENTS

ANDOVER, KANSAS

MICHAEL J. FALZ
LICENSED
10296
1-3-2025
KANSAS
PROFESSIONAL ENGINEER

REVISION:

DATE: 1-03-2025
JOB: 24-3385
SHEET NO.:

S3.5

BOB D. CAMPBELL & CO.
Structural Engineers Since 1957
4338 Belleview Ave. 816.531.4144
Kansas City, MO 64111 www.bdc-engrs.com

COPYRIGHT©

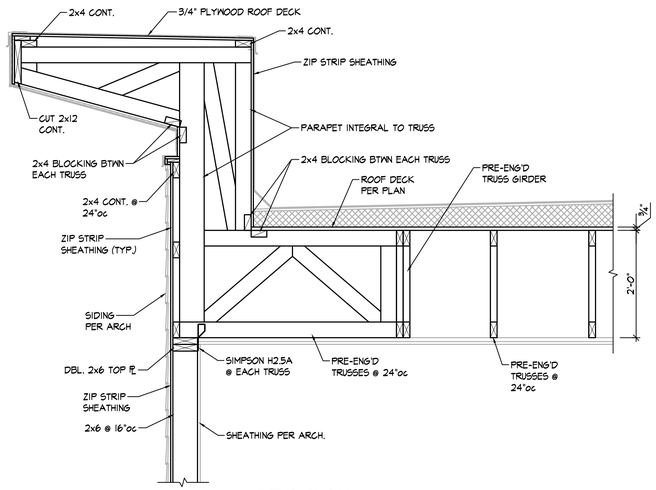

SECTION 1 S3.6
3/4" = 1'-0"

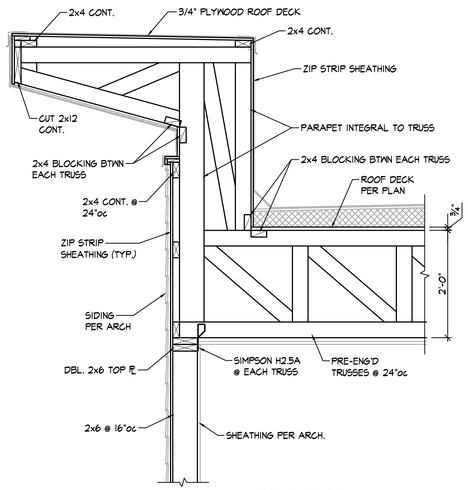

SECTION 2 S3.6
3/4" = 1'-0"

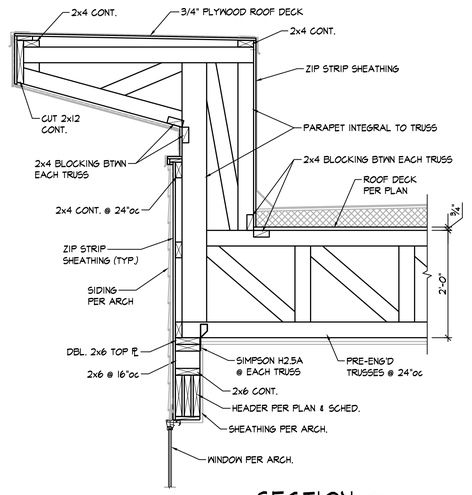

SECTION 2A S3.6
3/4" = 1'-0"

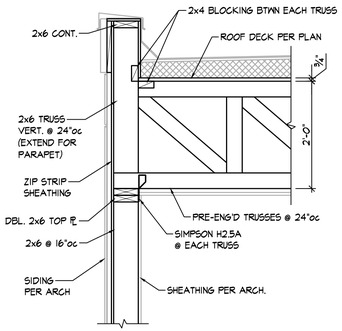

SECTION 3 S3.6
3/4" = 1'-0"

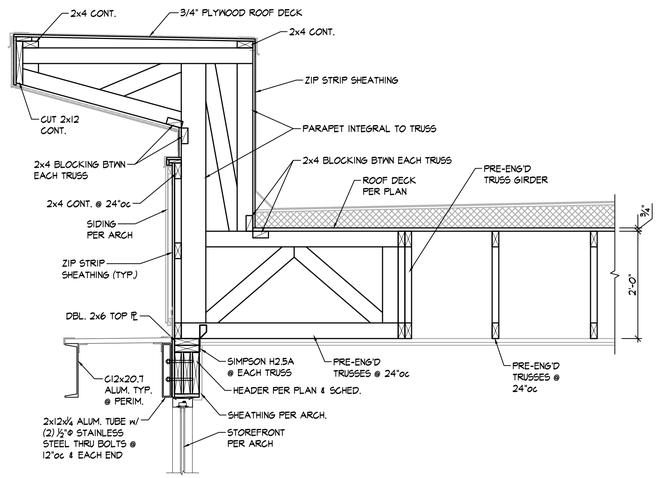

SECTION 4 S3.6
3/4" = 1'-0"

Wichita-Sedgwick County
Metropolitan Area Building
and Construction Department

REVIEWED FOR CODE COMPLIANCE

CORRECTIONS OR COMMENTS MADE ON THESE DRAWINGS AND THIS DOCUMENT DURING THIS REVIEW DO NOT RELIEVE CONTRACTOR FROM COMPLIANCE WITH ALL REQUIREMENTS OF THE CODE OF THE MARCH, THE CITY OF WICHITA OR SEDGWICK COUNTY. THIS REVIEW IS ONLY FOR GENERAL CONFORMANCE OF THE CODE. THE CONTRACTOR IS RESPONSIBLE FOR CONFORMING AND CORRELATING ALL TECHNIQUES OF CONSTRUCTION. THIS APPROVAL IS SUBJECT TO PROVISIONS OF SECTION 107.4 OF THE 2012 INTERNATIONAL BUILDING CODE.

DATE: 02/19/25 BY: William Jerauld Jr

JonesGillamRenz
730 N. Ninth 1881 Main Street, Suite 301
Salina, KS 67401 Kansas City, MO 64108
785.827.0386 jgr@jgrarchitects.com

ANDOVER SENIOR LIVING

NEW APARTMENTS

ANDOVER, KANSAS

MICHAEL J. FALL LICENSED 10290 1-3-2025 KANSAS PROFESSIONAL ENGINEER

REVISION:

DATE: 1-03-2025
JOB: 24-3385
SHEET NO.:

S3.6

BOB D. CAMPBELL & CO.
Structural Engineers Since 1957
4338 Belleview Ave. 816.531.4144
Kansas City, MO 64111 www.bdc-engrs.com

COPYRIGHTED ©

Electrical Abbreviations

1P	1 Pole (2P, 3P, 4P, ETC.)	MCB	Main Circuit Breaker
A, Amp	Ampere	MCC	Motor Control Center
AC	Above Counter	MDC	Main Distribution Center
ACLG	Above Ceiling	MDP	Main Distribution Panel
ADO	Automatic Door Opener	MFR	Manufacturer
AF	Amp Frame	MFS	Main Fused Disconnect Switch
AFF	Above Finished Floor	MH	Manhole
AFG	Above Finished Grade	MIC	Microphone
AFI	Arc Fault Circuit Interrupter	MIN	Minimum
		MISC	Miscellaneous
AHU	Air Handling Unit	MLO	Main Lugs Only
AL	Aluminum	MMS	Manual Motor Starter
ALT	Alternate	MOA	Multioutlet Assembly
AMP	Ampere	MSP	Motor Starter Panelboard
AMPL	Amplifier	MSBD	Main Switchboard
ANNUN	Annunciator	MSS	Motor Starter Switch
APPROX	Approximately	MT	Mount
AQ-STAT	Aquastat	MT.C	Empty Conduit
ARCH	Architect, Architectural	MTS	Manual Transfer Switch
AS	Amp Switch	MTR	Motor, Motorized
AT	Amp Trip	N.C.	Normally Closed
ATS	Automatic Transfer Switch	NEC	National Electrical Code
AUTO	Automatic	NEMA	National Electrical Manufacturer's Association
AUX	Auxiliary		
AV	Audio Visual	NFDS	Non-Fused Safety Disconnect Switch
AWG	American Wire Gauge		
BATT	Battery	NIC	Not In Contract
BD	Board	NL	Night Light
BLDG	Building	N.O.	Normally Open
BMS	Building Management System	NPF	Normal Power Factor
C	Conduit	NTS	Not To Scale
CAB	Cabinet	OC	On Center
CAT	Catalog	OH	Overhead
CATV	Cable Television	OL	Overloads
CB	Circuit Breaker	PA	Public Address
CCTV	Closed Circuit Television	PB	Pull Box Or Pushbutton
CKT	Circuit	PE	Pneumatic Electric
CLG	Ceiling	PED	Pedestal
COMB	Combination	PF	Power Factor
CMPR	Compressor	PH	Phase
CONN	Connection	PIV	Post Indicating Valve
CONST	Construction	PNL	Panel
CONT	Continuation Or Continuous	PP	Power Pole
CONTR	Contractor	PR	Pair
CONV	Convector	PRI	Primary
CP	Circulating Pump	PROJ	Projection
CRT	Cathode-Ray Tube	PRV	Power Roof Ventilator
CT	Current Transformer	PT	Potential Transformer
CTR	Center	PVC	Polyvinyl Chloride (Conduit)
CU	Copper	PWR	Power
DCP	Domestic Water Circulating Pump	QUAN	Quantity
DEPT	Department	RCPT	Receptacle
DET	Detail	REQD	Required
DIA	Diameter	RM	Room
DISC	Disconnect	RSC	Rigid Steel Conduit
DIST	Distribution	RTU	Roof Top Unit
DN	Down	SC	Surface Conduit
DPR	Damper	SEC	Secondary
DS	Safety Disconnect Switch	SHT	Sheet
DT	Double Throw	SIM	Similar
DWG	Drawing	SLD	Single-Line Diagram
EC	Electrical Contractor	S/N	Solid Neutral
ELEC	Electric, Electrical	SPEC	Specification
ELEV	Elevator	SPKR	Speaker
ELU	Emergency Lighting Unit	SP	Spare
EM	Emergency	SPP	Single-Point Power
EMS	Energy Management System	SR	Surface Raceway
EMT	Electrical Metallic Tubing	SS	Stainless Steel
EP	Electric Pneumatic	SSW	Selector Switch
EQUIP	Equipment	S/S	Stop/Start Pushbuttons
EWC	Electric Water Cooler	STA	Station
EXIST	Existing	STD	Standard
EXH	Exhaust	SURF	Surface Mounted
EXP	Explosion Proof	SW	Switch
FA	Fire Alarm	SWBD	Switchboard
FABP	Fire Alarm Booster Power Supply Panel	SYM	Symmetrical
		SYS	System
FACP	Fire Alarm Control Panel	TEL	Telephone
FCU	Fan Coil Unit	TERM	Terminal
FIXT	Fixture	TL	Twist Lock
FLR	Floor	TR	Tamper Resistant
FLUOR	Fluorescent	T-STAT	Thermostat
FU	Fuse	TTC	Telephone Terminal Cabinet
FUDS	Fused Safety Disconnect Switch	TV	Television
GA	Gauge	TVTC	Television Terminal Cabinet
GAL	Gallon	TYP	Typical
GALV	Galvanized	UC	Under Counter
GC	General Contractor	UE	Underground Electrical
GEN	Generator	UG	Underground
GFI	Ground Fault Circuit Interrupter	UH	Unit Heater
GFP	Ground Fault Protector	UT	Underground Telephone
GND	Ground	UTIL	Utility
GRS	Galvanized Rigid Steel (Conduit)	UV	Ultraviolet
GYP BD	Gypsum Board	V	Volt
HOA	Hands-Off-Automatic Switch	VA	Volt-Amperes
HORIZ	Horizontal	VDT	Video Display Terminal
HP	Horsepower	VERT	Vertical
HPF	High Power Factor	VFD	Variable Frequency Drive
HT	Height	VOL	Volume
HTG	Heating	W	Watt
HTR	Heater	W/	With
HV	High Voltage	WG	Wire Guard
HVAC	Heating, Ventilating And Air Conditioning	WH	Water Heater
		W/O	Without
IC	Interrupting Capacity	WP	Weatherproof
IG	Isolated Ground	XFMR	Transformer
IMC	Intermediate Metal Conduit	XFR	Transfer
INCAND	Incandescent		
IR	Infrared		
I/W	Interlock With		
J-BOX	Junction Box	∠	Angle
KV	Kilovolt	@	At
KVA	Kilovolt-Ampere	▲	Delta
KVAR	Kilovolt-Ampere Reactive	'	Feet
KW	Kilowatt	"	Inches
KWH	Kilowatt Hour	#	Number
LOC	Locate Or Location	Ø	Phase
LT	Light	C	Center Line
LTG	Lighting	P	Plate
LTNG	Lightning		
LV	Low Voltage		
MAX	Maximum		
MAG.S	Magnetic Starter		
M/C	Momentary Contact		
MC	Mechanical Contractor		

Electrical Symbol Legend

Lighting Symbols

- Lighting Fixtures, Typical, Rectangular (Various Symbols)
- Lighting Fixtures, Typical, Round (Various Symbols)
  Center dot indicates pendant.
  Chevron indicates wall wash.
- Wall-mounted fixtures, Typical (Various Symbols)
- Strip Fixture
- Directional Light, Track Light, Flood Light
- Linear Light, Tape Light
- Emergency Lighting Unit, Ceiling-Mounted, Integral Battery
- Emergency Lighting Unit, Ceiling-Mounted, Remote Battery
- Emergency Lighting Unit, Wall-Mounted, Integral Battery
- Emergency Lighting Unit, Wall-Mounted, Remote Battery
- Exit Light, Ceiling-Mounted. Shading and arrows indicate faces and directional chevrons.
- Exit Light, Wall-Mounted. Shading and arrows indicate faces and directional chevrons.
- Exit/ELU Combo
- Pole/Area Lights
- Post-Top Area Light
- Bollard Light
- Hatch indicates light on an emergency or life safety circuit.
- Single-Pole Switch
- Two-Pole Switch
- Three-Pole Switch

Switch Modifiers:

3: 3-Way	OS: Occupancy Sensor
4: 4-Way	VS: Vacancy Sensor
K: Keyed	CT: Above-Counter
D: Dimming	LV: Low-Voltage
T: Timer	M: Motor-Rated

- Lighting Contactor
- LC Lighting Control Panel
- OS Occupancy Sensor
- DL Daylight Harvesting Sensor

Lighting Tags

A
MDP:1a

- Top Value: Fixture Type ID (Underlined)
- Bottom Value, Lowercase Letter: Switch ID
- Bottom Value, Number(s): Circuit Number
- Bottom Value, Uppercase Letter(s): Panel

Absence of a switch designation on a lighting fixture indicates fixture is controlled by the only switch in the space. An "x" in place of the switch designation indicates unswitched.

Switch ID indicated by a lowercase letter. Switch IDs are unique per space. A switch with an ID "a" controls all devices within the space in which it is located tagged with "a". A switch without a tagged ID controls all lighting fixtures within a space. ID tags may be used on control devices other than switches, such as occupancy sensors or contactors.

Miscellaneous

- Area Not in Contract
- Note by Symbol
- Callout:
  Top Value: Detail Number on Sheet
  Bottom Value: Sheet Number of Detail
- Room 1 — Room Name and Number

Power Symbols

Wall / Ceiling / Floor

- Simplex Receptacle
- Duplex Receptacle
- 6-30 Quadruplex Receptacle
- Special Receptacle, Type as Indicated

Receptacle Modifiers:
- ##": Height AFF(to center)
- CT: Device Mounted Above Counter Top
- IG: Isolated Ground
- H: Device Mounted Horizontally
- WP: Weatherproof In-Use Cover

- Half shading indicates split (typically switched)
- Outside shading indicates tamperproof device
- Center shading indicates GFI type
- Full shading indicates tamperproof GFI type
- Multioutlet Assembly
  Filled squares indicate 120V outlet
  Open squares indicate with USB
- Cord Reel, Device Varies
- Drop Cord, Device Varies
- Junction Box
- F1 Floor Box, see schedule for type
- Emergency Power Off
- DO Door Opener Push Plate
- M Power Meter
- Safety Switch, Fused
- Safety Switch, Unfused
- Motor Starter
- Combination Starter/Disconnect
- Contactor

Power Device and Equipment Tags

LP1A:1 — Electrical DeviceTags: Uppercase letter(s) indicates Panel ID and circuit number. Lowercase letter indicates designation of controlling switch (where applicable).

XX-1 — Equipment Tags: Equipment ID is indicated by an underlined tag adjacent to the equipment. See the equipment connection schedule for description, electrical requirements, and panel and circuit number. Symbols/graphic appearance of equipment varies.

Wiring

Solid, arced lines connecting equipment, devices, or fixtures indicate unswitched power circuiting. Wires are only intended to indicate to what circuit devices are connected. Actual connections, circuit routing, installtion, junction boxes, etc. shall be field-determined by the contractor.

Dashed, arced lines connecting equipment, devices, or fixtures indicate switched power.

Home run to branch circuit panelboard. The equipment name and circuit number(s) are indicated, separated by a hyphen. Homeruns are only intended to indicate panel and circuit number. Actual homerun location shall be field-determined by the contractor.

Power Distribution Equipment

SB1 MDP HP1A LP1A

Hatched fill indicates distribution panel or switchboard.
Solid fill indicates branch panel or load center.
Dashed box indicates code-required clearance (width and depth).
Door indicates front of recessed panel.

Devices and fixtures are tagged with Panel and circuit number. For example, a device tagged with "A:1" indicates the device is circuited to panel designated "A," circuit number 1.

T1 — Transformer: Typically transformer names begin with or contain the letter "T". See Single-Line Diagram for description and requirements.

Telecom Symbols

Wall / Ceiling / Floor

- Data Outlet
- Telephone Outlet
- Data/Telephone Outlet

Outlet Modifiers:
- ##": Height AFF (to center)
- CT: Mounted Above Counter Top

- Wireless Access Point
- 84" TV Outlet

GENERAL ELECTRICAL NOTES

A. COORDINATE INSTALLATION OF ELECTRICAL WORK ABOVE THE CEILING TO PROVIDE THE GREATEST POSSIBLE CLEARANCE FOR INSTALLATION OF PLUMBING AND MECHANICAL INSTALLATION. CONDUITS SHALL BE ROUTED THROUGH JOIST WEBS WHERE POSSIBLE.
B. VERIFY EXACT PLACEMENT OF ALL LUMINAIRES, DEVICES, AND EQUIPMENT SHOWN ON THE ELECTRICAL CONSTRUCTION DOCUMENTS WITH ARCHITECTURAL, MECHANICAL AND PLUMBING DRAWINGS PRIOR TO FINAL PLACEMENT.
C. ELECTRICAL EQUIPMENT AND DEVICES SHALL BE "LISTED" AND "IDENTIFIED" AS RATED FOR A MINIMUM OF 75°C CONDUCTOR TERMINATION.
D. DEFINITION OF TERMS
   - "SHALL": ACTION THAT IS REQUIRED WITHOUT OPTION OR QUALIFICATION.
   - "FURNISH": CONTRACTOR SHALL BE RESPONSIBLE FOR OBTAINING.
   - "INSTALL": CONTRACTOR SHALL BE RESPONSIBLE FOR LABOR AND CONSTRUCTION EQUIPMENT NECESSARY TO SET IN PLACE, CONNECT, CALIBRATE AND TEST EQUIPMENT FURNISHED BY HIM OR OTHERS.
   - "PROVIDE": CONTRACTOR SHALL FURNISH AND INSTALL.

MOUNTING HEIGHT REQUIREMENTS:

UNLESS SPECIFICALLY INDICATED OTHERWISE, THE FOLLOWING MOUNTING HEIGHTS SHALL APPLY:

• RECEPTACLES	16" TO BOTTOM
• TELECOMMUNICATIONS OUTLETS	16" TO BOTTOM
• LIGHT SWITCHES	48" TO TOP
• THERMOSTATS	48" TO TOP
• HUMIDISTATS	48" TO TOP
• FIRE ALARM PULL STATIONS	48" TO TOP
• FIRE ALARM NOTIFICATION DEVICES	LOWER OF: 88" TO BOTTOM OR TOP AT 6" BELOW CEILING

GENERAL LIGHTING NOTES

A. THE CIRCUITING OF ALL LUMINAIRES HAS BEEN SHOWN ON THE PLANS, AND THE CONTRACTOR SHALL FOLLOW THIS CIRCUITING LAYOUT.
B. CIRCUIT ALL EMERGENCY LIGHTS, NIGHT LIGHTS AND EXIT LIGHTS TO AN UNSWITCHED HOT CONDUCTOR, UPSTREAM OF ALL CONTROLS.
C. DIRECT CURRENT POWER WIRING FROM EXIT SIGNS TO REMOTE EXTERIOR EMERGENCY LIGHTING HEADS SHALL BE (2) #10 IN 1/2" CONDUIT UNLESS NOTED OTHERWISE.
D. IN AREAS WHERE CEILING MOUNTED OCCUPANCY SENSORS ARE USED FOR LIGHTING CONTROL IN CONJUNCTION WITH WALL SWITCHES, OCCUPANCY SENSOR/POWER PACK SHALL SWITCH LEG SHALL BE WIRED IN SERIES WITH WALL SWITCHES TO PROVIDE OVERRIDE "OFF" CONTROL FOR LIGHTS.
E. CONTROL WIRING FOR 0-10 V-dc DIMMING SIGNAL CIRCUITS SHALL BE NEC CLASS 1, ROUTED IN SAME RACEWAY/CABLE WITH LIGHTING CIRCUIT POWER CONDUCTORS. WIRING SHALL CONSIST OF (2) #16 SOLID CU THHN OR TFN CONDUCTORS. CONDUCTOR INSULATION COLOR SHALL BE VIOLET (+ V-dc) AND PINK (- V-dc). WHERE MC-CABLE IS USED FOR FINAL 6' POWER CONNECTION WHIP TO LUMINAIRE, UTILIZE "LUMINARY" TYPE MC-CABLE WITH INTEGRAL CLASS 1 CONTROL WIRING.

GENERAL POWER NOTES

A. THE CIRCUITING OF ALL DEVICES HAS BEEN SHOWN ON THE PLANS, AND THE CONTRACTOR SHALL FOLLOW THIS CIRCUITING LAYOUT.
B. VERIFY EXACT LOCATIONS OF HVAC AND PLUMBING EQUIPMENT WITH THE GENERAL CONTRACTOR AND ASSOCIATED SUBCONTRACTORS. COORDINATE CONDUIT STUB-UP AND POWER CONNECTIONS PRIOR TO COMMENCING ROUGH-IN WORK. ELECTRICAL DEVICES (DISCONNECTS, RECEPTACLES, ETC.) INSTALLED ON EQUIPMENT SHALL BE MOUNTED ON A NON-REMOVABLE PANEL OF THE EQUIPMENT. FIELD COORDINATE EXACT DEVICE MOUNTING LOCATIONS PRIOR TO INSTALLATION.
C. WALL MOUNTED HVAC CONTROL DEVICES (THERMOSTATS, TEMPERATURE SENSORS, HUMIDISTATS, CO_2 SENSORS, ETC) SHALL BE PROVIDED BY MECHANICAL CONTRACTOR. UNLESS NOTED OTHERWISE, ELECTRICAL CONTRACTOR SHALL PROVIDE SINGLE GANG WALL BOX WITH 1/2" CONDUIT STUBBED OUT TO ABOVE ACCESSIBLE CEILING WITH NYLON BUSHINGS AND PULLSTRING IN RACEWAY. REFER TO MECHANICAL DRAWINGS FOR LOCATIONS OF DEVICES.

GENERAL TELECOMMUNICATIONS NOTES

A. PROVIDE THE FOLLOWING RACEWAY ROUGH-IN FOR TELECOMMUNICATIONS OUTLET TYPES INDICATED:
   - WALL PHONE OUTLET: 2"x4"x2-1/8" DEEP DEVICE BOX WITH (1) 3/4" CONDUIT TO ABOVE ACCESSIBLE CEILING.
   - PHONE/DATA OUTLET: 4-11/16" SQUARE x 3-1/4" DEEP BOX (RACO #260 OR EQUAL) WITH 1-GANG DEVICE RING AND 1-1/4" CONDUIT TO ABOVE ACCESSIBLE CEILING.
   - TV OUTLET: 4-11/16" SQUARE x 3-1/4" DEEP BOX (RACO #260 OR EQUAL) WITH 2-GANG DEVICE RING AND (1) 2" CONDUIT TO ABOVE ACCESSIBLE CEILING.
B. PROVIDE NYLON BUSHINGS FOR ALL CONDUIT ENDS NOT CONNECTED TO A BOX OR FITTING TO PROTECT CABLING FROM DAMAGE.
C. CONDUITS FROM EACH OUTLET SHALL BE STUBBED 2" ABOVE THE FINISHED CEILINGS IN AREAS WITH ACCESSIBLE TILES. IN AREAS WITH OPEN CEILINGS, STUB CONDUIT INTO STRUCTURAL JOIST SPACE.
D. PROVIDE BLANK, STAINLESS STEEL COVER PLATES FOR ALL OUTLETS NOT ACTIVATED BY OWNER.
E. PROVIDE SUITABLE PULL STRING IN ALL CONDUITS.

GENERAL FIRE ALARM NOTES

A. FIRE ALARM CABLING SHALL BE INSTALLED IN CONDUIT WHERE EXPOSED, INACCESSIBLE, AND WHERE SUBJECT TO PHYSICAL DAMAGE.
B. AT LOCATION OF SMOKE DAMPERS AND COMBINATION FIRE/SMOKE DAMPERS, PROVIDE DUCT OR AREA SMOKE DETECTOR (AS SHOWN ON PLANS) WITHIN 5' OF DAMPER AND WIRE TO FIRE ALARM CONTROL PANEL. PROVIDE FIRE ALARM RELAY FOR CONTROL OF 120V POWER TO DAMPER ACTUATOR. DAMPER SHALL CLOSE UPON DETECTION OF SMOKE.
C. IN ADDITION TO VALVES INSTALLED ON FIRE SPRINKER SYSTEM RISER, ALL VALVES INSTALLED OUTSIDE THE BUILDING (POST INDICATOR VALVE, TAPPING SLEEVE VALVE, ETC.) SHALL BE SUPERVISED BY THE FIRE ALARM SYSTEM. PROVIDE ADDRESSABLE MONITORING MODULE AND SURGE PROTECTION DEVICE (DITEK #DTK-2MHLP48B) FOR EACH MONITORED VALVE. COORDINATE WITH GC AND SITE WORK CONTACTOR FOR ALL VALVES INSTALLED. MONITORING IS NOT REQUIRED FOR VALVES INSTALLED IN ROADWAY BOXES BY THE MUNICIPALITY/PUBLIC UTILITY.

Wichita-Sedgwick County
Metropolitan Area Building
and Construction Department

REVIEWED FOR CODE COMPLIANCE

CORRECTIONS OR COMMENTS MADE ON THESE DRAWINGS AND THIS DOCUMENT DURING THIS REVIEW DO NOT RELIEVE CONTRACTOR FROM COMPLIANCE WITH ALL REQUIREMENTS OF THE CODE OF THE MABCD, THE CITY OF WICHITA OR SEDGWICK COUNTY. THIS REVIEW IS ONLY FOR GENERAL CONFORMANCE OF THE CODE. THE CONTRACTOR IS RESPONSIBLE FOR CONFORMING AND CORRELATING ALL TECHNIQUES OF CONSTRUCTION. THIS APPROVAL IS SUBJECT TO PROVISIONS OF SECTION 107.4 OF THE 2012 INTERNATIONAL BUILDING CODE.

DATE: 02/19/25 BY: William Jerauld Jr

Electrical Sheet List

E1.1	ELECTRICAL PLANS
E1.2	ELECTRICAL PLANS
E1.3	SPECIAL SYSTEMS PLANS
E1.4	SPECIAL SYSTEMS PLANS
E4.1	ENLARGED ELECTRICAL PLANS
E4.2	ENLARGED ELECTRICAL PLANS
E6.1	ELECTRICAL SCHEDULES AND DETAILS
E6.3	ELECTRICAL SCHEDULES
E0.1	ELECTRICAL TITLE SHEET
E6.2	ELECTRICAL LOAD AND RISER DIAGRAMS

LST Consulting Engineers, PA
Manhattan, Kansas
785.587.8042

Wichita, Kansas
316.285.0696

www.LSTengineers.com
mail@LSTengineers.com

Project 24061

JonesGillamRenz
730 N. Ninth, Salina, KS 67401, 785.827.0386
1881 Main Street, Suite 301, Kansas City, MO 64108, jgr@jgrarchitects.com

THE RESIDENCE AT HERATIGE WEST

NEW SENIOR LIVING FACILITY

ANDOVER, KANSAS

RYAN PATRICK LIES
LICENSED
24155
KANSAS
PROFESSIONAL ENGINEER
2025.01.10
16:38:35-06'00'

REVISIONS:

DATE: 01-10-2025
JOB: 24-3379
SHEET NO.:

E0.1

COPYRIGHTED ©

Wichita-Sedgwick County
Metropolitan Area Building
and Construction Department

REVIEWED FOR CODE COMPLIANCE

CORRECTIONS OR COMMENTS MADE ON THESE DRAWINGS AND THIS DOCUMENT DURING THIS REVIEW DO NOT RELIEVE CONTRACTOR FROM COMPLIANCE WITH ALL REQUIREMENTS OF THE CODE OF THE MABCD, THE CITY OF WICHITA OR SEDGWICK COUNTY. THIS REVIEW IS ONLY FOR GENERAL CONFORMANCE OF THE CODE. THE CONTRACTOR IS RESPONSIBLE FOR CONFORMING AND CORRELATING ALL TECHNIQUES OF CONSTRUCTION. THIS APPROVAL IS SUBJECT TO PROVISIONS OF SECTION 107.4 OF THE 2012 INTERNATIONAL BUILDING CODE.

DATE: 02/19/25 BY: William Jerauld Jr

LST Consulting Engineers, PA
Manhattan, Kansas
785.587.8042

Wichita, Kansas
316.285.0696

www.LSTengineers.com
mail@LSTengineers.com
Project 24061

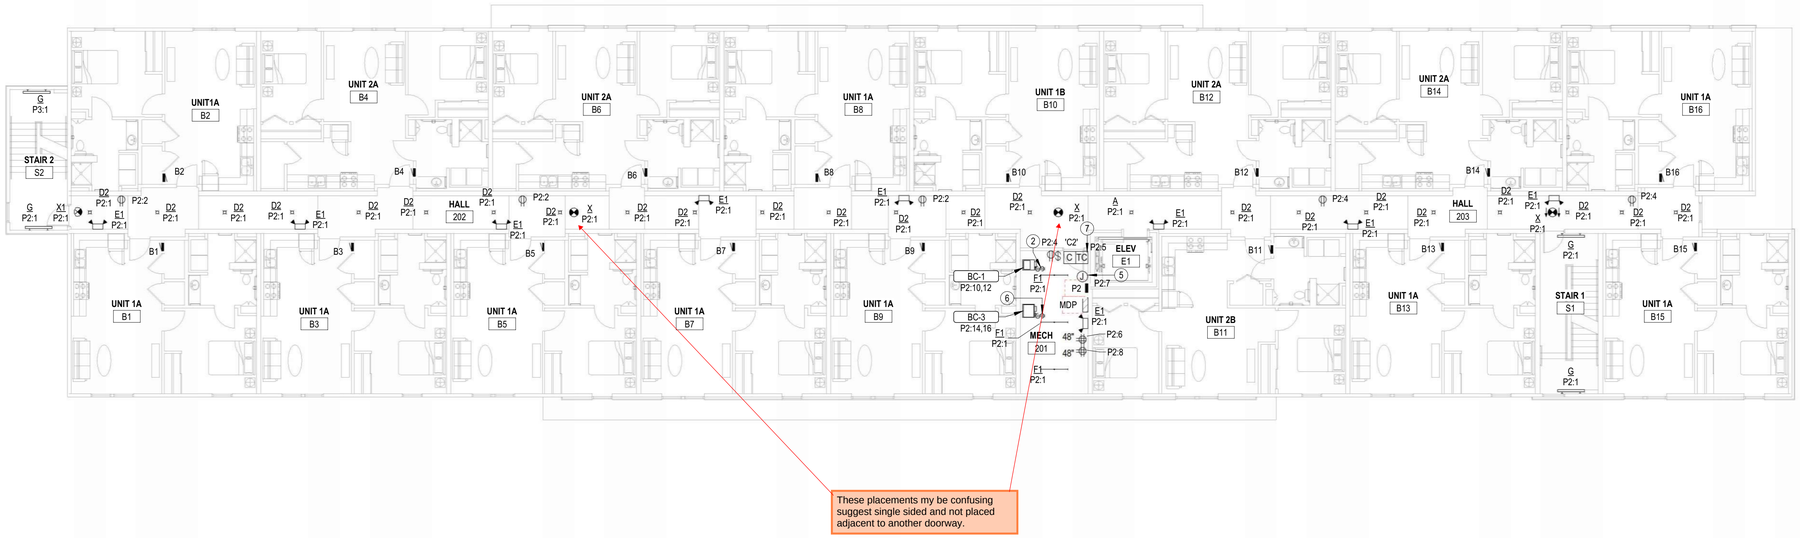

2 E1.1 SECOND FLOOR ELECTRICAL PLAN
3/32" = 1'-0"

NOTES BY SYMBOL

1. ROUTE CIRCUIT THROUGH CONTACTOR INDICATED ON DETAIL 2:E6.1.
2. PROVIDE 30A/2P, SINGLE THROW, MANUAL MOTOR CONTROLLER SNAP SWITCH IN NEMA 1 ENCLOSURE. HUBBELL #HBL7832D OR EQUAL. MAKE FINAL FLEXIBLE CONNECTION TO BLOWER COIL/ELECTRIC HEAT.
3. CONNECT FIXTURE TO LIGHTING INVERTER IN MECH 105 FOR EMERGENCY OPERATION.
4. 120V POWER FOR FIRE SPRINKLER SYSTEM FLOW SWITCH(ES) AND BELL. PROVIDE #8 CU BONDING JUMPER FROM CIRCUIT EQUIPMENT GROUNDING CONDUCTOR TO METAL SPRINKLER SYSTEM PIPING AT AN ACCESSIBLE LOCATION PER NEC 250.104(B). COORDINATE WORK WITH FIRE SPRINKLER SYSTEM INSTALLER.
5. PROVIDE 120V POWER CONNECTION TO ELEVATOR SUMP PUMP ALARM PANEL AND 1" CONDUIT WITH PULL STRING STUBBED INTO ELEVATOR PIT FOR CONTROL CABLING. COORDINATE ALL WORK WITH PLUMBING CONTRACTOR.
6. PROVIDE 50A/2P, SINGLE THROW, MANUAL MOTOR CONTROLLER SNAP SWITCH IN NEMA 1 ENCLOSURE. HUBBELL #HBL7852D OR EQUAL. MAKE FINAL FLEXIBLE CONNECTION TO BLOWER COIL/ELECTRIC HEAT.
7. TIMECLOCK AND CONTACTORS FOR EXTERIOR LIGHTING AND OFFICE RECEPTACLE CONTROL, RE: 2:E6.1.
8. PHOTOCELL FOR CONTROL OF EXTERIOR LIGHTS. SEE 2:E6.1 FOR MORE INFORMATION.

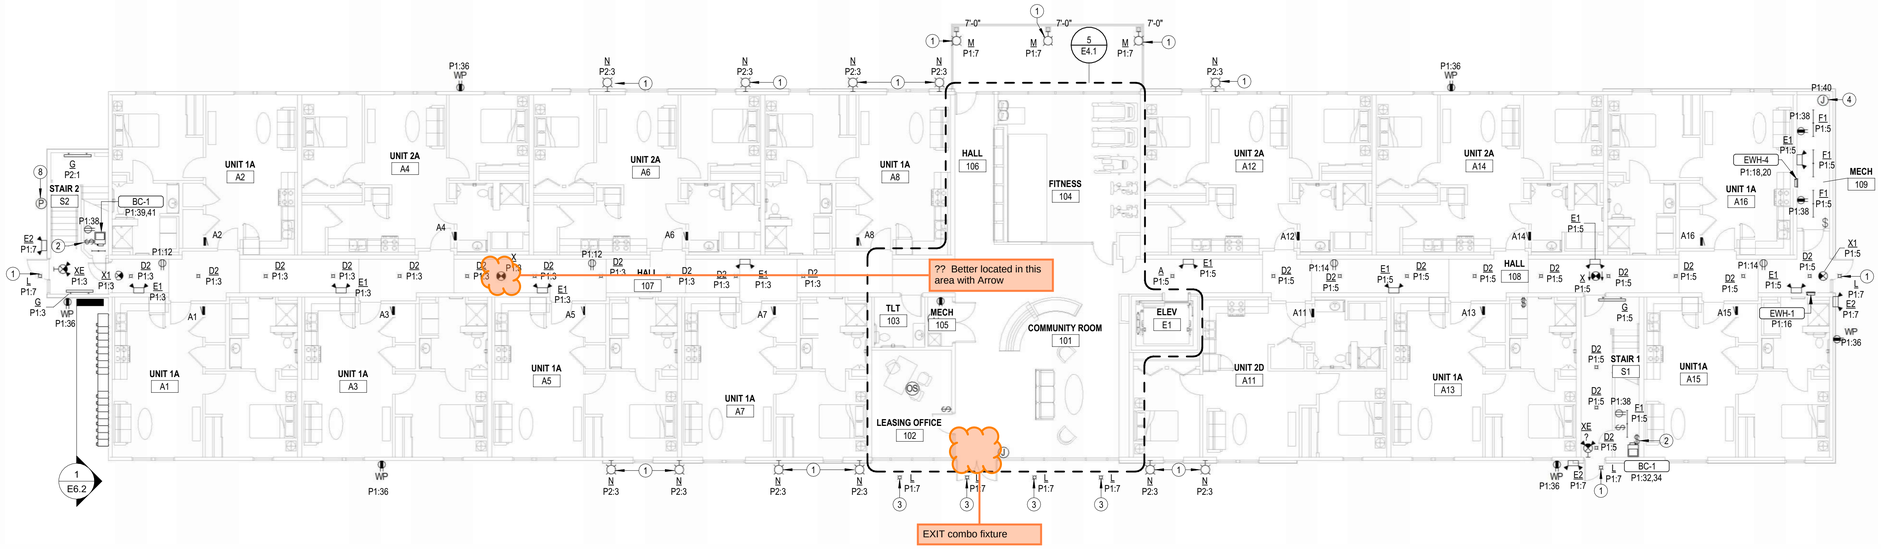

1 E1.1 FIRST FLOOR ELECTRICAL PLAN
3/32" = 1'-0"

JonesGillamRenz
730 N. Ninth
Salina, KS 67401
785.827.0386
1881 Main Street, Suite 301
Kansas City, MO 64108
jgr@jgrarchitects.com

THE RESIDENCE AT HERATIGE WEST

NEW SENIOR LIVING FACILITY

ANDOVER, KANSAS

RYAN PATRICK LIES
LICENSED
24155
KANSAS
PROFESSIONAL ENGINEER
2025-01-10
16:38:55-06'00'

REVISIONS:

DATE: 01-10-2025
JOB: 24-3379
SHEET NO.:

E1.1

COPYRIGHTED ©

Wichita-Sedgwick County
Metropolitan Area Building
and Construction Department

REVIEWED FOR CODE COMPLIANCE

CORRECTIONS OR COMMENTS MADE ON THESE DRAWINGS AND THIS DOCUMENT DURING THIS REVIEW DO NOT RELIEVE CONTRACTOR FROM COMPLIANCE WITH ALL REQUIREMENTS OF THE CODE OF THE MABCD, THE CITY OF WICHITA OR SEDGWICK COUNTY. THIS REVIEW IS ONLY FOR GENERAL CONFORMANCE OF THE CODE. THE CONTRACTOR IS RESPONSIBLE FOR CONFORMING AND CORRELATING ALL TECHNIQUES OF CONSTRUCTION. THIS APPROVAL IS SUBJECT TO PROVISIONS OF SECTION 107.4 OF THE 2012 INTERNATIONAL BUILDING CODE.

DATE: 02/19/25 BY: William Jerauld Jr

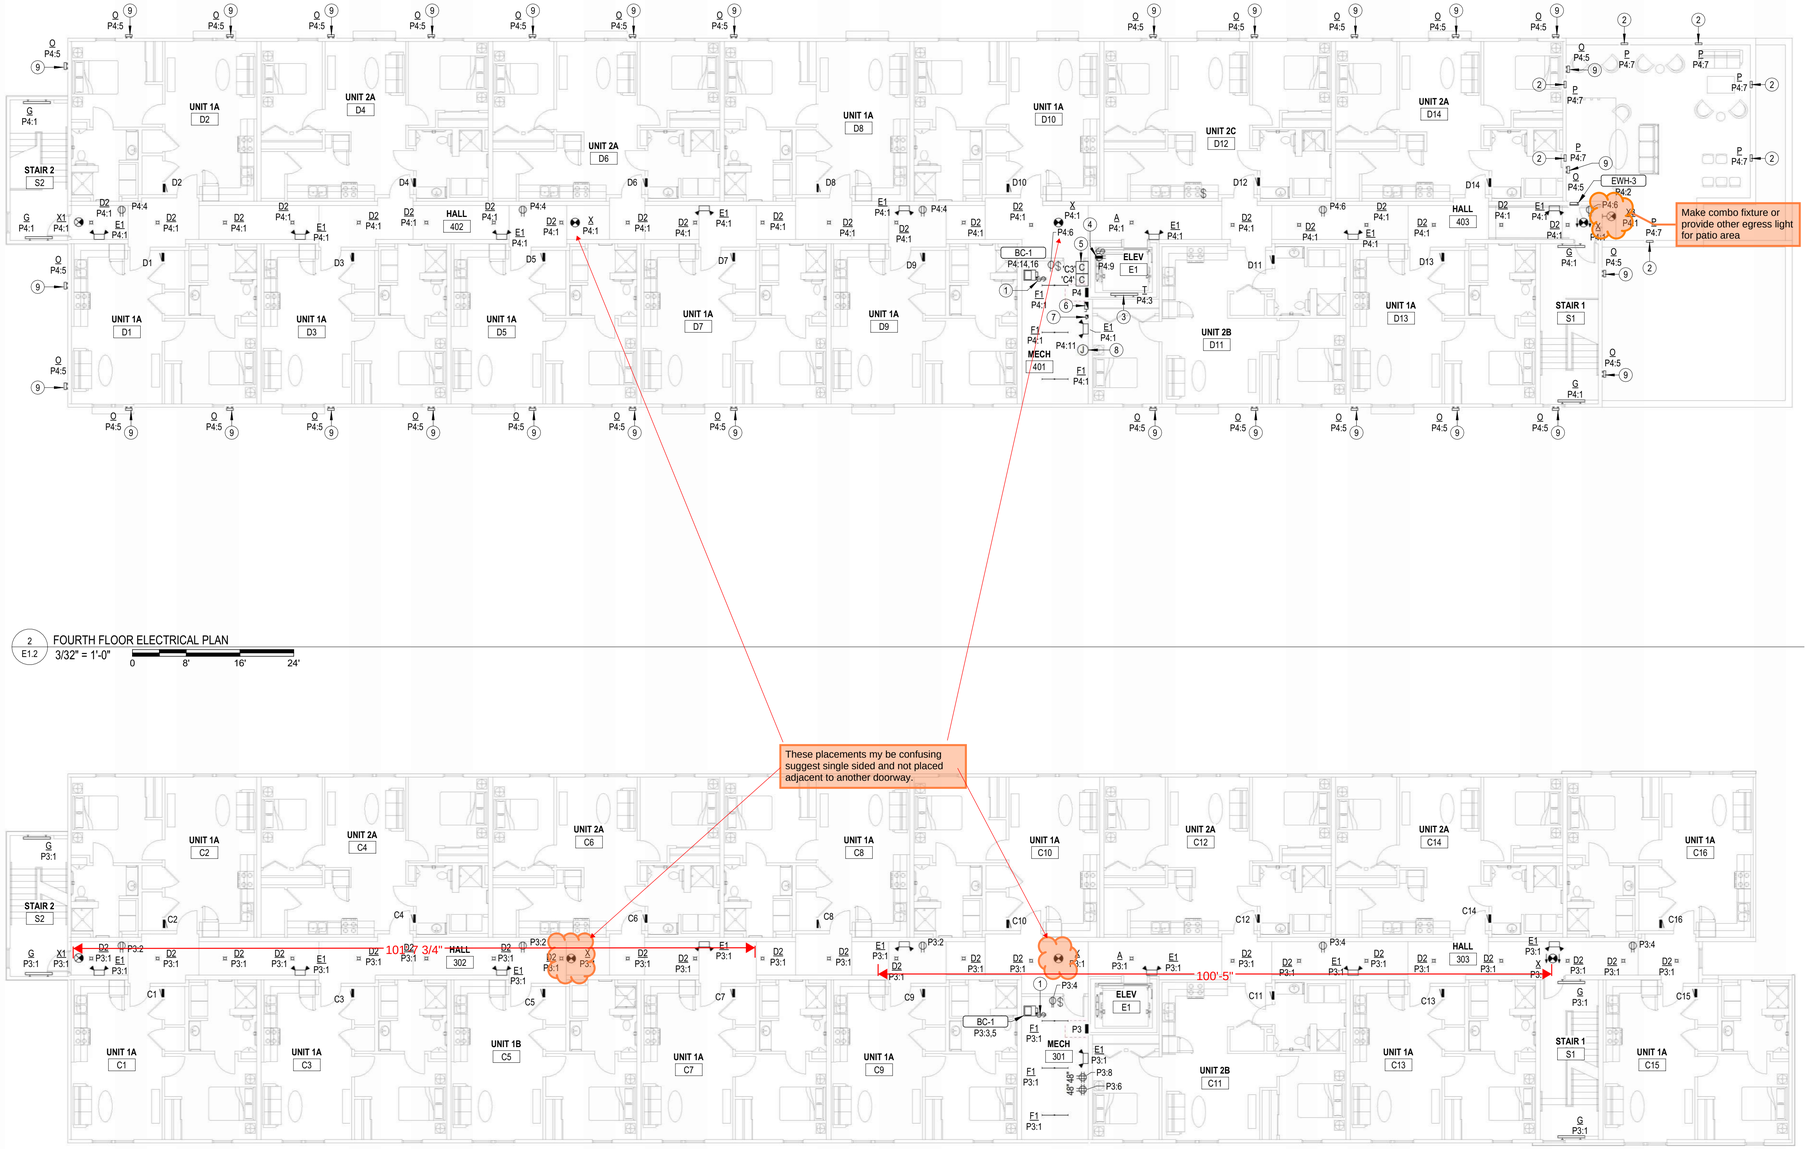

2 E1.2 FOURTH FLOOR ELECTRICAL PLAN
3/32" = 1'-0"
0 8' 16' 24'

1 E1.2 THIRD FLOOR ELECTRICAL PLAN
3/32" = 1'-0"
0 8'-1 3/4" 16' 24'

NOTES BY SYMBOL

1. PROVIDE 30A/2P, SINGLE THROW, MANUAL MOTOR CONTROLLER SNAP SWITCH IN NEMA 1 ENCLOSURE. HUBBELL #HBL7832D OR EQUAL. MAKE FINAL FLEXIBLE CONNECTION TO BLOWER COIL/ELECTRIC HEAT.
2. INSTALL FIXTURE APPROXIMATELY 24" ABOVE ROOFTOP DECKING SYSTEM. COORDINATE EXACT LOCATION WITH PARAPET FRAMING.
3. INSTALL LIGHT FIXTURE, SWITCH, AND RECEPTACLE AT TOP OF HOISTWAY. VERIFY EXACT MOUNTING LOCATION AND REQUIREMENTS WITH ELEVATOR INSTALLER.
4. INSTALL RECEPTACLE ON WALL OF ELEVATOR HOISTWAY. VERIFY EXACT LOCATION WITH ELEVATOR EQUIPMENT INSTALLER.
5. TIMECLOCK AND CONTACTORS FOR EXTERIOR LIGHTING AND OFFICE RECEPTACLE CONTROL. RE: 2:E6.1.
6. ELEVATOR POWER MODULE SWITCH: 60A/208V/3P SWITCH COMPLETE WITH 60A DUAL ELEMENT, TIME DELAY CLASS 'J' FUSES, 120V CONTROL TRANSFORMER, FIRE ALARM SAFETY INTERFACE RELAY, KEY TEST SWITCH, GREEN PILOT LIGHT, AUXILIARY CONTACTS FOR ELEVATOR RECALL, AND FIRE ALARM VOLTAGE MONITORING RELAY. EATON BUSSMAN #PS-6-T20-R1-K-G-B-F1 OR EQUAL. COORDINATE EXACT MOUNTING LOCATION AND REQUIREMENTS WITH ELEVATOR EQUIPMENT INSTALLER, AND PROVIDE FINAL ELECTRICAL CONNECTION TO ELEVATOR CONTROLLER. SEE DETAIL 1:E6.1.
7. 30A DISCONNECT SWITCH, LOCKABLE IN "OFF" POSITION, WITH SOLID NEUTRAL AND (1) 20A DUAL-ELEMENT, TIME DELAY FUSE IN NEMA 1 ENCLOSURE FOR ELEVATOR CAB LIGHTS & EXHAUST. MOUNT AT 6'-0" AFF TO TOP AND LABEL WITH CORRESPONDING ELEVATOR CAR NUMBER AND CIRCUIT NUMBER. COORDINATE EXACT MOUNTING LOCATION AND REQUIREMENTS WITH ELEVATOR EQUIPMENT INSTALLER. PROVIDE FINAL ELECTRICAL CONNECTION TO ELEVATOR CONTROLLER.
8. PROVIDE POWER FOR ELEVATOR SHUNT TRIP CONTROL. SEE 1:E6.1 FOR MORE INFORMATION.
9. ROUTE CIRCUIT THROUGH CONTACTOR INDICATED ON DETAIL 2:E6.1.

LST Consulting Engineers, PA
Manhattan, Kansas
785.587.8042

Wichita, Kansas
316.285.0696

www.LSTengineers.com
mail@LSTengineers.com
Project 24061

JonesGillamRenz
730 N. Ninth
Salina, KS 67401
785.827.0386
1881 Main Street, Suite 301
Kansas City, MO 64108
jgr@jgrarchitects.com

THE RESIDENCE AT HERATIGE WEST

NEW SENIOR LIVING FACILITY

ANDOVER, KANSAS

RYAN PATRICK LIEB LICENSED 24155 KANSAS PROFESSIONAL ENGINEER
2025.01.10 16:39:12-06'00'

REVISIONS:

DATE: 01-10-2025
JOB: 24-3379
SHEET NO.:

E1.2

COPYRIGHTED ©

Wichita-Sedgwick County
Metropolitan Area Building
and Construction Department

REVIEWED FOR CODE COMPLIANCE

CORRECTIONS OR COMMENTS MADE ON THESE DRAWINGS AND THIS DOCUMENT DURING THIS REVIEW DO NOT RELIEVE CONTRACTOR FROM COMPLIANCE WITH ALL REQUIREMENTS OF THE CODE OF THE MABCD, THE CITY OF WICHITA OR SEDGWICK COUNTY. THIS REVIEW IS ONLY FOR GENERAL CONFORMANCE OF THE CODE. THE CONTRACTOR IS RESPONSIBLE FOR CONFORMING AND CORRELATING ALL TECHNIQUES OF CONSTRUCTION. THIS APPROVAL IS SUBJECT TO PROVISIONS OF SECTION 107.4 OF THE 2012 INTERNATIONAL BUILDING CODE.

DATE: 02/19/25 BY: William Jerauld Jr

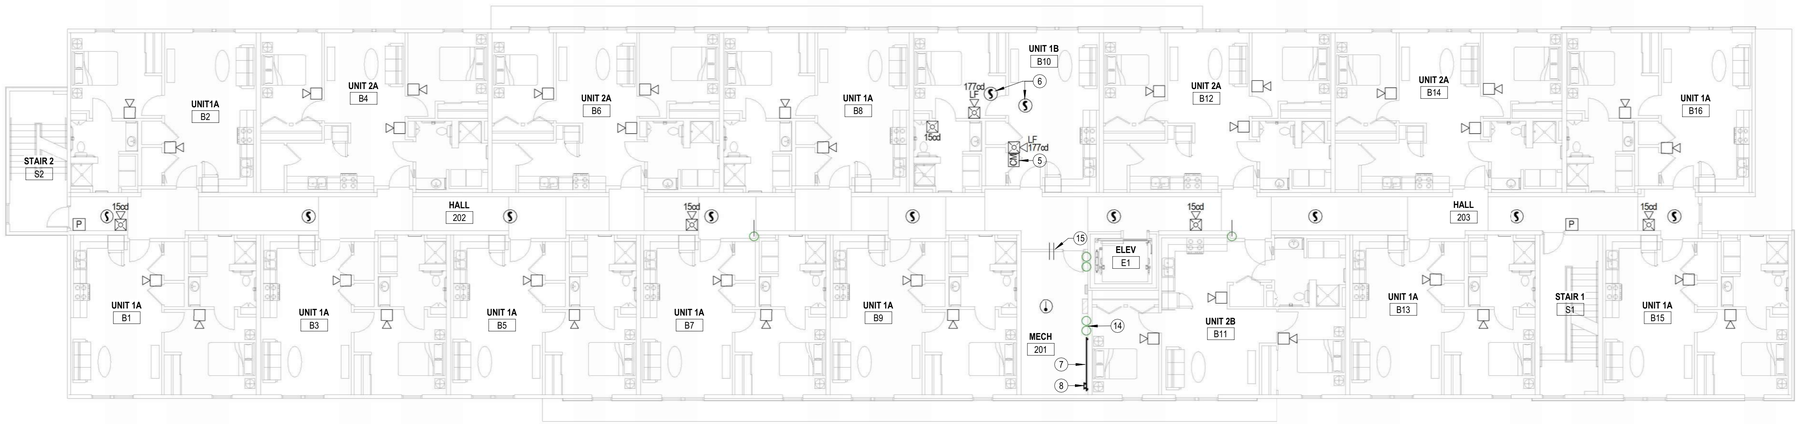

2 / E1.3 SECOND FLOOR SPECIAL SYSTEMS PLAN
3/32" = 1'-0"
0 8' 16' 24'

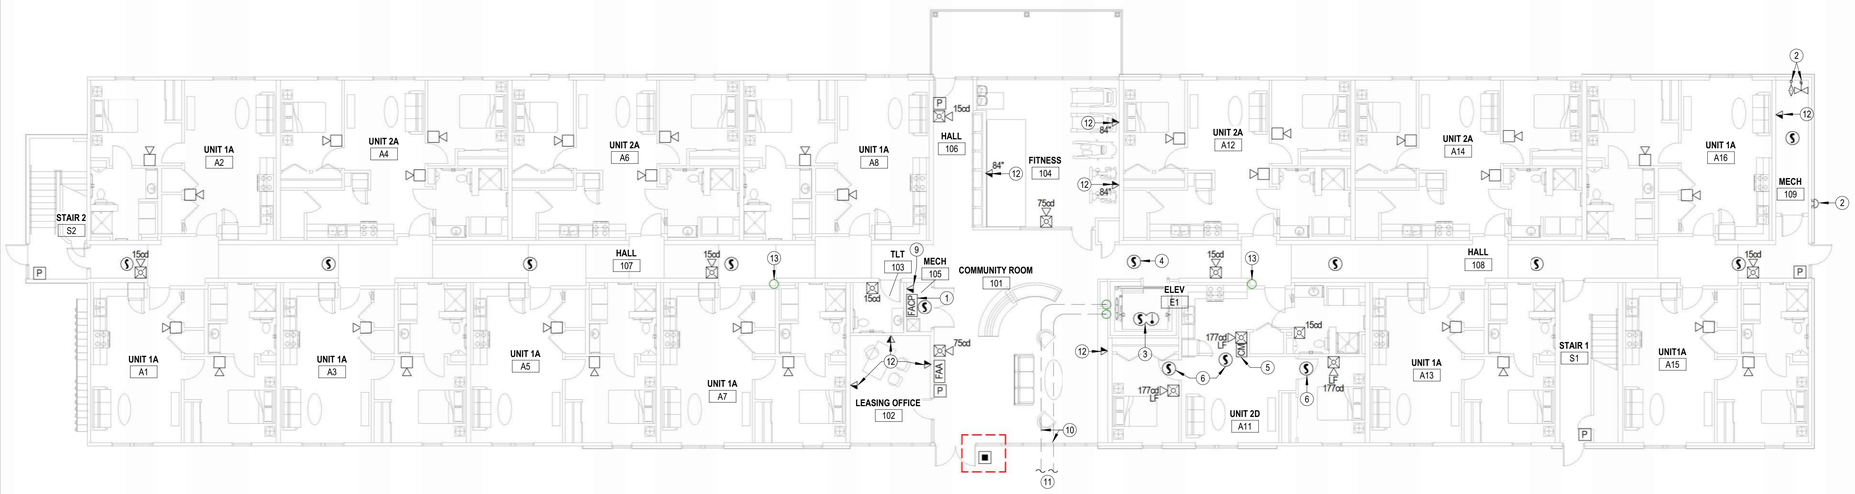

COMMUNICATIONS HOMERUNS FROM APARTMENTS SHALL BE ROUTED TO TELEPHONE TERMINA BOARD IN 'MECH 201'

1 / E1.3 FIRST FLOOR SPECIAL SYSTEMS PLAN
3/32" = 1'-0"
0 8' 16' 24'

NOTES BY SYMBOL

1. PROVIDE (2) CAT 5e UTP, NEC TYPE 'CMP' CABLES (SUPERIOR ESSEX #51-241-48 OR EQUAL) IN 3/4" CONDUIT FROM FACP TO MAIN TELECOM TERMINAL BOARD FOR CONNECTION TO FA SYSTEM DACT FOR REMOTE MONITORING.
2. PROVIDE ADDRESSABLE FIRE ALARM RELAYS AND MONITORING MODULES FOR ALL FIRE SPRINKLER FLOW SWITCHES, TAMPER SWITCHES AND BELL/GONG. COORDINATE QUANTITIES AND LOCATIONS WITH FIRE SPRINKLER CONTRACTOR.
3. SMOKE DETECTOR AND HEAT DETECTOR AT TOP OF ELEVATOR HOISTWAY FOR RECALL AND SHUT-DOWN. SEE DETAIL 1, SHEET E6.1.
4. ELEVATOR LOBBY SMOKE DETECTOR FOR ELEVATOR RECALL. SEE DETAIL 1, SHEET E6.1.
5. FIRE ALARM ADDRESSABLE CONTROL MODULE FOR CONTROL OF APARTMENT UNIT'S NOTIFICATION APPLIANCE CIRCUIT. MODULE SHALL BE PROGRAMMED TO ACTIVATE APARTMENT UNIT'S NOTIFICATION APPLIANCES UPON GENERAL BUILDING FIRE ALARM AND UPON ACTIVATION OF ANY SMOKE DETECTOR OR CO DETECTOR WITHIN APARTMENT UNIT. MOUNT FLUSH IN WALL AT 8'-0" AFF.
6. FIRE ALARM SYSTEM SMOKE DETECTOR.
7. PROVIDE 8' LONG SHEET OF 3/4" ACX FIRE RETARDANT PLYWOOD INSTALLED VERTICALLY WITH BOTTOM AT 6" AFF. WIDTH AS REQUIRED. PLYWOOD SHALL BE PERMANENTLY FASTENED TO THE WALL BY MEANS OF WALL ANCHORS UTILIZING GALVANIZED, ZINC PLATED, OR STAINLESS STEEL HARDWARE WITH A FLAT HEAD. FINISHED INSTALLATION SHALL HAVE FLUSH APPEARANCE WITH COUNTERSUNK SCREW HEADS TO PREVENT SPLITTING OF THE PLYWOOD. DRYWALL SCREWS ARE NOT ACCEPTABLE. PAINT WITH TWO COATS OF LIGHT GRAY FIRE RETARDANT SEALER PRIOR TO INSTALLATION OF ANY EQUIPMENT.
8. TELECOMMUNICATIONS GROUND BAR SHALL BE 13-1/4"W x 2"H x 1/4" THICK ELECTRO-TIN PLATED COPPER BUS BAR, COMPLETE WITH INSULATED STAND-OFFS AND STAINLESS STEEL BRACKETS, ERICO #TGBA14L06PT OR EQUAL. MOUNT AT 18" AFF. ALL CONNECTIONS TO GROUND BAR SHALL BE MADE USING COMPRESSION TYPE LUGS.
9. PROVIDE 1" CONDUIT WITH PULL STRING FROM TELECOM OUTLET TO MAIN TELEPHONE TERMINAL BOARD IN MECH 108.
10. PROVIDE (2) 3" CONDUITS FOR COMMUNICATIONS SERVICES. PROVIDE PULL STRING IN EACH RACEWAY.
11. SEE SITE PLAN FOR CONTINUATION.
12. COORDINATE FINAL LOCATIONS OF ALL CATV AND PHONE OUTLETS WITH OWNER.
13. 4" CONDUIT DOWN FROM SECOND FLOOR. WHERE CONDUIT PENETRATES FIRE RATED ASSEMBLY, PROVIDE WITH FIRESTOPPING FITTINGS (WIREMOLD #FS4R-RED) AT BOTH ENDS. TERMINATE CONDUIT ABOVE ACCESSIBLE CEILING.
14. 4" EMT CONDUIT SLEEVES THROUGH 2ND AND 3RD FLOOR FOR COMMUNICATIONS CABLING. PROVIDE WITH FIRESTOPPING FITTINGS (WIREMOLD #FS4R-RED) AT BOTH ENDS.
15. EMT CONDUIT SLEEVE(S) THROUGH WALL WITH NYLON BUSHINGS FOR COMMUNICATIONS CABLING. QUANTITY AND SIZE AS REQUIRED. INSTALL ABOVE ACCESSIBLE CEILING. WHERE CONDUITS PENETRATE FIRE WALL, PROVIDE WITH FIRESTOPPING FITTINGS (WIREMOLD #FS4R-RED) AT BOTH ENDS.

LST Consulting Engineers, PA
Manhattan, Kansas
785.587.8042

Wichita, Kansas
316.285.0696

www.LSTengineers.com
mail@LSTengineers.com
Project 24061

JonesGillamRenz
730 N. Ninth 1881 Main Street, Suite 301
Salina, KS 67401 Kansas City, MO 64108
785.827.0386 jgr@jgrarchitects.com

THE RESIDENCE AT HERATIGE WEST

NEW SENIOR LIVING FACILITY

ANDOVER, KANSAS

BRYAN PATRICK LYNN LICENSED 24155 PROFESSIONAL ENGINEER KANSAS
2025.01.10 16:39:30-06'00'

REVISIONS:

DATE: 01-10-2025
JOB: 24-3379
SHEET NO.:

E1.3

COPYRIGHTED ©

Wichita-Sedgwick County
Metropolitan Area Building
and Construction Department

REVIEWED FOR CODE COMPLIANCE

CORRECTIONS OR COMMENTS MADE ON THESE DRAWINGS AND THIS DOCUMENT DURING THIS REVIEW DO NOT RELIEVE CONTRACTOR FROM COMPLIANCE WITH ALL REQUIREMENTS OF THE CODE OF THE MABCD, THE CITY OF WICHITA OR SEDGWICK COUNTY. THIS REVIEW IS ONLY FOR GENERAL CONFORMANCE OF THE CODE. THE CONTRACTOR IS RESPONSIBLE FOR CONFORMING AND CORRELATING ALL TECHNIQUES OF CONSTRUCTION. THIS APPROVAL IS SUBJECT TO PROVISIONS OF SECTION 107.4 OF THE 2012 INTERNATIONAL BUILDING CODE.

DATE: 02/19/25 BY: William Jerauld Jr

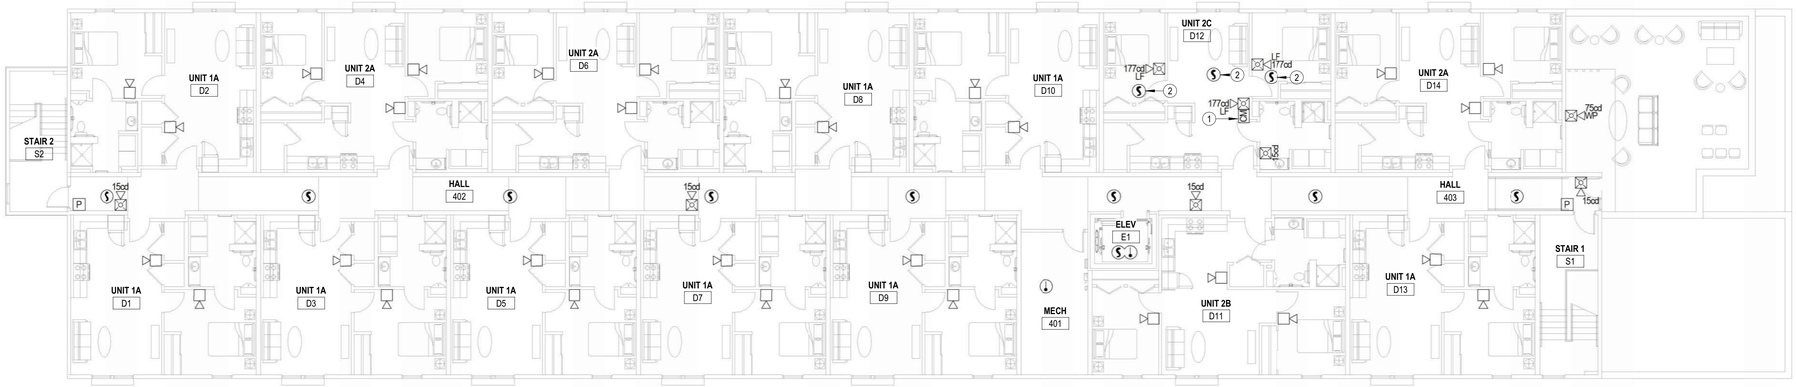

COMMUNICATIONS HOMERUNS FROM APARTMENTS SHALL BE ROUTED TO TELEPHONE TERMINA BOARD IN 'MECH 301'

NOTES BY SYMBOL

1. FIRE ALARM ADDRESSABLE CONTROL MODULE FOR CONTROL OF APARTMENT UNIT'S NOTIFICATION APPLIANCE CIRCUIT. MODULE SHALL BE PROGRAMMED TO ACTIVATE APARTMENT UNIT'S NOTIFICATION APPLIANCES UPON GENERAL BUILDING FIRE ALARM AND UPON ACTIVATION OF ANY SMOKE DETECTOR OR CO DETECTOR WITHIN APARTMENT UNIT. MOUNT FLUSH IN WALL AT 8'-0" AFF.
2. FIRE ALARM SYSTEM SMOKE DETECTOR.
3. TELECOMMUNICATIONS GROUND BAR SHALL BE 13-1/4"W x 2"H x 1/4" THICK ELECTRO-TIN PLATED COPPER BUS BAR. COMPLETE WITH INSULATED STAND-OFFS AND STAINLESS STEEL BRACKETS, ERICO #TGBA14L06PT OR EQUAL. MOUNT AT 18" AFF. ALL CONNECTIONS TO GROUND BAR SHALL BE MADE USING COMPRESSION TYPE LUGS.
4. PROVIDE 8' LONG SHEET OF 3/4" ACX FIRE RETARDANT PLYWOOD INSTALLED VERTICALLY WITH BOTTOM AT 6" AFF. WIDTH AS REQUIRED. PLYWOOD SHALL BE PERMANENTLY FASTENED TO THE WALL BY MEANS OF WALL ANCHORS UTILIZING GALVANIZED, ZINC PLATED, OR STAINLESS STEEL HARDWARE WITH A FLAT HEAD. FINISHED INSTALLATION SHALL HAVE FLUSH APPEARANCE WITH COUNTERSUNK SCREW HEADS TO PREVENT SPLITTING OF THE PLYWOOD. DRYWALL SCREWS ARE NOT ACCEPTABLE. PAINT WITH TWO COATS OF LIGHT GRAY FIRE RETARDANT SEALER PRIOR TO INSTALLATION OF ANY EQUIPMENT.
5. EMT CONDUIT SLEEVE(S) THROUGH WALL WITH NYLON BUSHINGS FOR COMMUNICATIONS CABLING. QUANTITY AND SIZE AS REQUIRED. INSTALL ABOVE ACCESSIBLE CEILING. WHERE CONDUITS PENETRATE FIRE WALL, PROVIDE WITH FIRESTOPPING FITTINGS (WIREMOLD #FS4R-RED) AT BOTH ENDS.
6. 4" EMT CONDUIT SLEEVES THROUGH 2ND AND 3RD FLOOR FOR COMMUNICATIONS CABLING. PROVIDE WITH FIRESTOPPING FITTINGS (WIREMOLD #FS4R-RED) AT BOTH ENDS.

2 E1.4 FOURTH FLOOR SPECAIL SYSTEMS PLAN
3/32" = 1'-0"

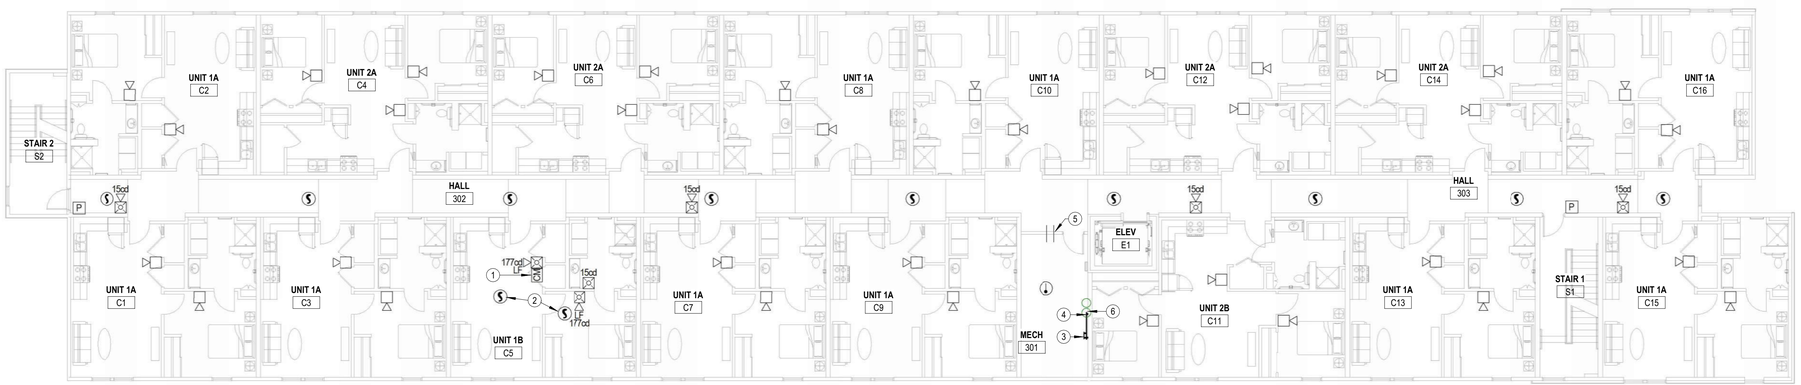

1 E1.4 THIRD FLOOR SPECIAL SYSTEMS PLAN
3/32" = 1'-0"

LST Consulting Engineers, PA
Manhattan, Kansas
785.587.8042

Wichita, Kansas
316.285.0696

www.LSTengineers.com
mail@LSTengineers.com
Project 24061

JonesGillamRenz
730 N. Ninth 1881 Main Street, Suite 301
Salina, KS 67401 Kansas City, MO 64108
785.827.0386 jgr@jgrarchitects.com

THE RESIDENCE AT HERATIGE WEST
NEW SENIOR LIVING FACILITY
ANDOVER, KANSAS

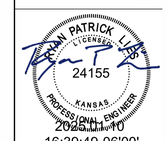

REVISIONS:

DATE: 01-10-2025
JOB: 24-3379
SHEET NO.:

E1.4

COPYRIGHTED ©

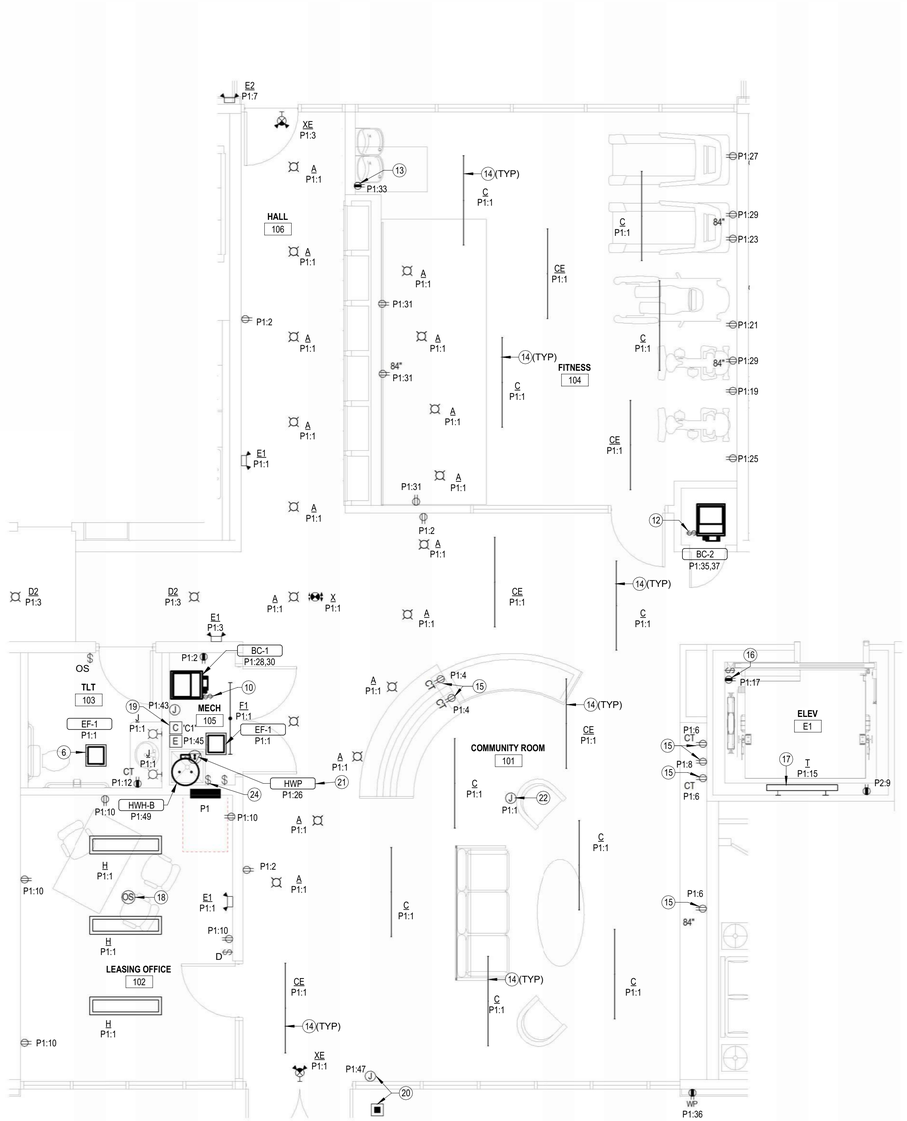

5 COMMON SPACE ENLARGED ELECTRICAL PLAN
E4.1 1/4" = 1'-0"
0 2' 4' 8'

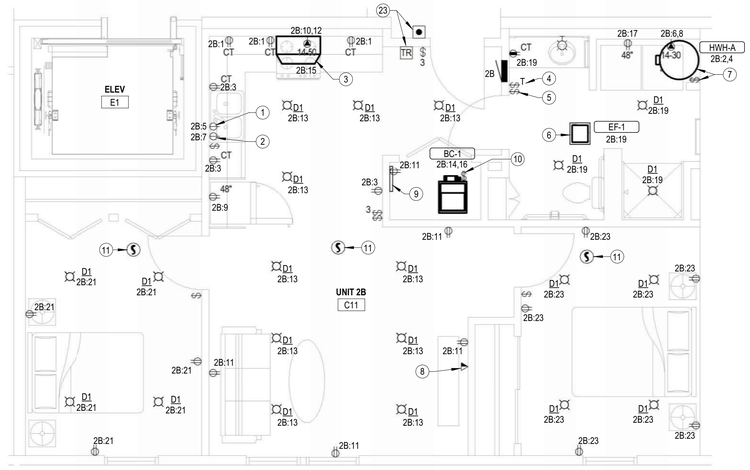

4 2 BEDROOM (UNIT 2B) ENLARGED ELECTRICAL PLAN
E4.1 1/4" = 1'-0"
0 2' 4' 8'

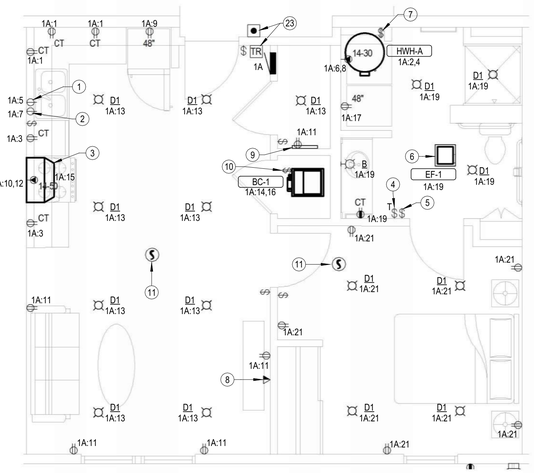

2 1 BEDROOM (UNIT 1A) ENLARGED ELECTRICAL PLAN
E4.1 1/4" = 1'-0"
0 2' 4' 8'

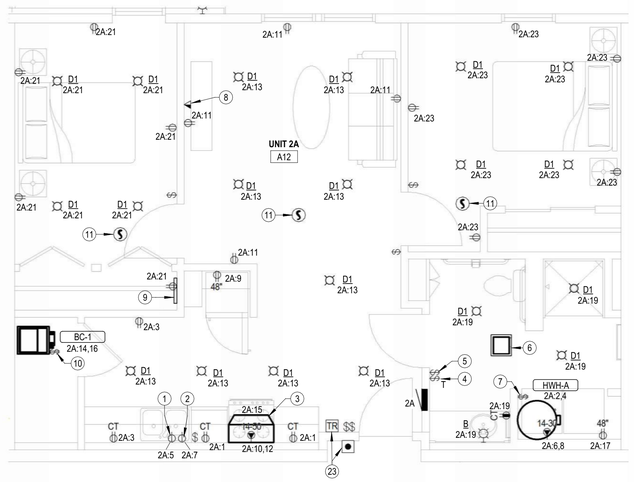

3 2 BEDROOM (UNIT 2A) ENLARGED ELECTRICAL PLAN
E4.1 1/4" = 1'-0"
0 2' 4' 8'

Wichita-Sedgwick County
Metropolitan Area Building
and Construction Department

REVIEWED FOR CODE COMPLIANCE

CORRECTIONS OR COMMENTS MADE ON THESE DRAWINGS AND THIS DOCUMENT DURING THIS REVIEW DO NOT RELIEVE CONTRACTOR FROM COMPLIANCE WITH ALL REQUIREMENTS OF THE CODE OF THE MABCD, THE CITY OF WICHITA OR SEDGWICK COUNTY. THIS REVIEW IS ONLY FOR GENERAL CONFORMANCE OF THE CODE. THE CONTRACTOR IS RESPONSIBLE FOR CONFORMING AND CORRELATING ALL TECHNIQUES OF CONSTRUCTION. THIS APPROVAL IS SUBJECT TO PROVISIONS OF SECTION 107.4 OF THE 2012 INTERNATIONAL BUILDING CODE.

DATE: 02/19/25 BY: William Jerauld Jr

NOTES BY SYMBOL

1 SWITCHED RECEPTACLE BELOW COUNTER FOR GARBAGE DISPOSAL. COORDINATE EXACT LOCATION OF SWITCH WITH ARCHITECT.
2 PROVIDE RECEPTACLE BELOW COUNTER FOR CORD AND PLUG CONNECTION OF DISHWASHER. PROVIDE CORD AND GROUNDING PLUG AS REQUIRED.
3 PROVIDE 120V CONNECTION TO RANGE HOOD/MICROWAVE. STANDARD AND ADAPTABLE UNITS WILL HAVE MICROWAVE ABOVE RANGE. ACCESSIBLE UNITS WILL HAVE RANGE HOOD. COORDINATE EXACT ELECTRICAL ROUGH-IN REQUIREMENTS WITH EQUIPMENT PROVIDED. IF EQUIPMENT IS CORD AND PLUG, PROVIDE RECEPTACLE INSIDE CABINET ABOVE RANGE.
4 PROVIDE TIMER SWITCH EQUAL TO AIR CYCLER 'SMART EXHAUST' FOR CONTROL OF EXHAUST FAN. SET SWITCH PER MANUFACTURER'S INSTRUCTIONS TO OPERATE FAN AS INDICATED BELOW:
1 BEDROOM: 36 MINUTES PER HOUR
2 BEDROOM: 54 MINUTES PER HOUR
NOTE: CONTRACTOR MAY OMIT TIMER SWITCH IN 2 BEDROOM UNITS AND WIRE EXHAUST FAN FOR CONTINUOUS OPERATION.
5 SWITCH CLOSEST TO DOOR SHALL CONTROL ALL LIGHTS IN BATHROOM, AND THE OTHER SWITCH SHALL CONTROL THE EXHAUST FAN.
6 CONNECT EXHAUST FAN/LIGHT PROVIDED BY MECHANICAL CONTRACTOR.
7 PROVIDE 30A/2P SNAP SWITCH AND CONNECT WATER HEATER. INSTALL SWITCH ADJACENT TO WATER HEATER.
8 COORDINATE FINAL LOCATIONS OF ALL CATV AND PHONE OUTLETS WITH OWNER.
9 TELECOM DISTRIBUTION DEVICE APPROXIMATELY 4'-0" AFF. COORDINATE EXACT REQUIREMENTS WITH UTILITY PROVIDER SELECTED BY OWNER.
10 PROVIDE 30A/2P, SINGLE THROW, MANUAL MOTOR CONTROLLER SNAP SWITCH IN NEMA 1 ENCLOSURE. HUBBELL #HBL7832D OR EQUAL. MAKE FINAL FLEXIBLE CONNECTION TO BLOWER COIL/ELECTRIC HEAT.
11 CEILING MOUNTED SMOKE ALARM IN APARTMENTS TO BE 120VAC WITH 9V BATTERY BACKUP, INTERCONNECTED TO OTHERS IN SAME APARTMENT. DEVICE SHALL HAVE CARBON MONOXIDE DETECTOR AND PHOTELECTRIC TYPE SMOKE DETECTOR WITH SOUNDER HORN HAVING AN 85 dB OUTPUT AT 10', SHALL HAVE A SINGLE BUTTON FOR TEST/SILENCE AND LED INDICATOR LIGHTS, AND SHALL BE UL 217 LISTED, BRK #SC7010B OR EQUAL.
12 PROVIDE 40A/2P, SINGLE THROW, MANUAL MOTOR CONTROLLER SNAP SWITCH IN NEMA 1 ENCLOSURE. HUBBELL #HBL7842D OR EQUAL. MAKE FINAL FLEXIBLE CONNECTION TO BLOWER COIL/ELECTRIC HEAT.
13 COORDINATE EXACT MOUNTING LOCATION OF DRINKING FOUNTAIN RECEPTACLE WITH PLUMBING CONTRACTOR.
14 INSTALL LIGHT FIXTURES IN ARCHITECTURAL DROP CEILING. COORDINATE REQUIREMENTS WITH G.C. AND ARCHITECT.
15 COORDINATE ELECTRICAL ROUGH-IN LOCATIONS WITH FINAL CASEWORK DESIGN.
16 INSTALL RECEPTACLE ON WALL OF ELEVATOR PIT. VERIFY EXACT LOCATION WITH ELEVATOR EQUIPMENT INSTALLER.
17 INSTALL LUMINAIRE ON WALL OF ELEVATOR PIT. VERIFY EXACT LOCATION WITH ELEVATOR EQUIPMENT INSTALLER. INSTALL LIGHT SWITCH ADJACENT TO PIT LADDER AT 48" ABOVE FLOOR LANDING.
18 PROVIDE LINE VOLTAGE OCCUPANCY SENSOR FOR CONTROL OF ROOM LIGHTS.
19 TIMECLOCK AND CONTACTORS FOR EXTERIOR LIGHTING AND OFFICE RECEPTACLE CONTROL, RE: 2:E6.1.
20 PROVIDE PUSH BUTTON ROUGH-IN AND PREP DOOR JAM WITH RACEWAY AS INDICATED IN DETAIL 3:M6.1 FOR AUTOMATIC DOOR OPENER. COORDINATE EXACT REQUIREMENTS WITH OWNER.
21 ROUTE 120V CIRCUIT FOR HOT WATER RECIRCULATION PUMP THROUGH ADJACENT AQUASTAT. PROVIDE 20A/1P SNAP SWITCH ADJACENT TO PUMP AND MAKE FINAL FLEXIBLE CONNECTION. COORDINATE WITH PLUMBING CONTRACTOR.
22 ROUGH-IN FOR DECORATIVE LIGHT FIXTURE. FIXTURE TO BE SELECTED BY INTERIOR DESIGNER, PROVIDED BY E.C.
23 INSTALL DOORBELL SYSTEM AS SELECTED BY INTERIOR DESIGNER. CIRCUIT TRANSFORMER TO NEAREST UNSWITCHED LIGHTING CIRCUIT. PROVIDE ALL COMPONENTS REQUIRED FOR COMPLETE INSTALLATION. COORDINATE EXACT REQUIREMENTS WITH ARCHITECT AND G.C.
24 PROVIDE 30A/1P SNAP SWITCH AND CONNECT WATER HEATER. INSTALL SWITCH ADJACENT TO WATER HEATER.

LST Consulting Engineers, PA
Manhattan, Kansas
785.587.8042
Wichita, Kansas
316.285.0696
www.LSTengineers.com
mail@LSTengineers.com
Project 24061

JonesGillamRenz
730 N. Ninth
Salina, KS 67401
1881 Main Street, Suite 301
Kansas City, MO 64108
jgr@jgrarchitects.com
785.827.0386

THE RESIDENCE AT HERATIGE WEST
NEW SENIOR LIVING FACILITY
ANDOVER, KANSAS

KEVIN PATRICK LYNCH LICENSED 24155 KANSAS PROFESSIONAL ENGINEER
2025.01.10 16:40:08-06'00'

REVISIONS:

DATE: 01-10-2025
JOB: 24-3379
SHEET NO.:

E4.1

COPYRIGHTED ©

Designation: 1A

Installed Location: 1 Bedroom Unit (1A)
Voltage: 120/208 1PH 3W-1Ph-3W
Mounting: Flush
Enclosure: NEMA 1

Bus Amps: 100
MCB Amps: MLO
Features & Modifications: PROVIDE SURGE PROTECTION DEVICE

SCCR/AIC: 22.0 kA
Mains FN/Note: -

Ckt	Description	Circuitry	Trip (A)	FN	A		B		FN	Trip (A)	Circuitry	Description	Ckt
1A:1	Counter Top Receptacles	1/2"C,1#12,#12N,#12G	20	GA	4.5 A	21....				30	1/2"C,2#10,#10G	Electric Water Heating	1A:2
1A:3	Counter Top Receptacle	1/2"C,1#12,#12N,#12G	20	GA			3.0 A	21....					1A:4
1A:5	Disposal	1/2"C,1#12,#12N,#12G	20	GA	4.2 A	40....			G	60	3/4"C,2#4,#10G	Clothes Dryer	1A:6
1A:7	Dishwasher	1/2"C,1#12,#12N,#12G	20	GA			4.2 A	40....					1A:8
1A:9	Refrigerator	1/2"C,1#12,#12N,#12G	20	GA	1.5 A	40....			G	60	3/4"C,2#4,#10G	Range	1A:10
1A:11	Living Room Receptacles	1/2"C,1#12,#12N,#12G	20	A			7.5 A	40....					1A:12
1A:13	Kitchen/Living Room Lights	1/2"C,1#12,#12N,#12G	20	A	0.8 A	20....				30	1/2"C,2#10,#10G	Blower Coil	1A:14
1A:15	Hood/Microwave	1/2"C,1#12,#12N,#12G	20	GA			2.1 A	20....					1A:16
1A:17	Clothes Washer Receptacle	1/2"C,1#12,#12N,#12G	20	A	1.5 A	11....				20	1/2"C,2#12,#12G	Heat Pump	1A:18
1A:19	Bathroom	1/2"C,1#12,#12N,#12G	20				2.8 A	11....					1A:20
1A:21	Bedroom 1	1/2"C,1#12,#12N,#12G	20	A	7.9 A	--				--	--	Surge Protection	1A:22
1A:23	Space	--	--				--	--		--	--	Surge Protection	1A:24

Designation: 1B

Installed Location: 1 Bedroom Unit (1B)
Voltage: 120/208 1PH 3W-1Ph-3W
Mounting: Flush
Enclosure: NEMA 1

Bus Amps: 100
MCB Amps: MLO
Features & Modifications: PROVIDE SURGE PROTECTION DEVICE

SCCR/AIC: 22.0 kA
Mains FN/Note: -

Ckt	Description	Circuitry	Trip (A)	FN	A		B		FN	Trip (A)	Circuitry	Description	Ckt
1B:1	Counter Top Receptacles	1/2"C,1#12,#12N,#12G	20	GA	4.5 A	21....				30	1/2"C,2#10,#10G	Electric Water Heating	1B:2
1B:3	Counter Top Receptacles	1/2"C,1#12,#12N,#12G	20	GA			3.0 A	21....					1B:4
1B:5	Disposal	1/2"C,1#12,#12N,#12G	20	GA	4.2 A	40....			G	60	3/4"C,2#4,#10G	Clothes Dryer	1B:6
1B:7	Dishwasher	1/2"C,1#12,#12N,#12G	20	GA			4.2 A	40....					1B:8
1B:9	Refrigerator	1/2"C,1#12,#12N,#12G	20	GA	1.5 A	40....			G	60	3/4"C,2#4,#10G	Range	1B:10
1B:11	Living Room Receptacles	1/2"C,1#12,#12N,#12G	20	A			7.5 A	40....					1B:12
1B:13	Kitchen/Living Room Lights	1/2"C,1#12,#12N,#12G	20	A	0.8 A	20....				30	1/2"C,2#10,#10G	Blower Coil	1B:14
1B:15	Hood/Microwave	1/2"C,1#12,#12N,#12G	20	GA			2.1 A	20....					1B:16
1B:17	Clothes Washer Receptacle	1/2"C,1#12,#12N,#12G	20	A	1.5 A	11....				20	1/2"C,2#12,#12G	Heat Pump	1B:18
1B:19	Bathroom	1/2"C,1#12,#12N,#12G	20				2.8 A	11....					1B:20
1B:21	Bedroom	1/2"C,1#12,#12N,#12G	20	A	7.9 A	--				--	--	Surge Protection	1B:22
1B:23	Space	--	--				--	--		--	--	Surge Protection	1B:24

Designation: 2A

Installed Location: 2 Bedroom Unit (2A)
Voltage: 120/208 1PH 3W-1Ph-3W
Mounting: Flush
Enclosure: NEMA 1

Bus Amps: 100
MCB Amps: MLO
Features & Modifications: PROVIDE SURGE PROTECTION DEVICE

SCCR/AIC: 22.0 kA
Mains FN/Note: -

Ckt	Description	Circuitry	Trip (A)	FN	A		B		FN	Trip (A)	Circuitry	Description	Ckt
2A:1	Counter Top Receptacles	1/2"C,1#12,#12N,#12G	20	GA	3.0 A	21....				30	1/2"C,2#10,#10G	Electric Water Heating	2A:2
2A:3	Counter Top/Kitchen Receptacles	1/2"C,1#12,#12N,#12G	20	GA			3.0 A	21....					2A:4
2A:5	Disposal	1/2"C,1#12,#12N,#12G	20	GA	4.2 A	40....			G	60	3/4"C,2#4,#10G	Clothes Dryer	2A:6
2A:7	Dishwasher	1/2"C,1#12,#12N,#12G	20	GA			4.2 A	40....					2A:8
2A:9	Refrigerator	1/2"C,1#12,#12N,#12G	20	GA	1.5 A	40....			G	60	3/4"C,2#4,#10G	Range	2A:10
2A:11	Living Room Receptacles	1/2"C,1#12,#12N,#12G	20	A			6.0 A	40....					2A:12
2A:13	Kitchen/Living Room Lights	1/2"C,1#12,#12N,#12G	20	A	0.8 A	20....				30	1/2"C,2#10,#10G	Blower Coil	2A:14
2A:15	Hood/Microwave	1/2"C,1#12,#12N,#12G	20	GA			2.1 A	20....					2A:16
2A:17	Clothes Washer Receptacle	1/2"C,1#12,#12N,#12G	20	A	1.5 A	11....				20	1/2"C,2#12,#12G	Heat Pump	2A:18
2A:19	Bathroom	1/2"C,1#12,#12N,#12G	20				2.8 A	11....					2A:20
2A:21	Bedroom 1	1/2"C,1#12,#12N,#12G	20	A	7.9 A	--				--	--	Surge Protection	2A:22
2A:23	Bedroom 2	1/2"C,1#12,#12N,#12G	20	A			7.9 A	--		--	--	Surge Protection	2A:24

Designation: 2B

Installed Location: 2 Bedroom Unit (2B)
Voltage: 120/208 1PH 3W-1Ph-3W
Mounting: Flush
Enclosure: NEMA 1

Bus Amps: 100
MCB Amps: MLO
Features & Modifications: PROVIDE SURGE PROTECTION DEVICE

SCCR/AIC: 22.0 kA
Mains FN/Note: -

Ckt	Description	Circuitry	Trip (A)	FN	A		B		FN	Trip (A)	Circuitry	Description	Ckt
2B:1	Counter Top Receptacles	1/2"C,1#12,#12N,#12G	20	GA	4.5 A	21....				30	1/2"C,2#10,#10G	Electric Water Heating	2B:2
2B:3	Counter Top/Kitchen Receptacles	1/2"C,1#12,#12N,#12G	20	GA			4.5 A	21....					2B:4
2B:5	Disposal	1/2"C,1#12,#12N,#12G	20	GA	4.2 A	40....			G	60	3/4"C,2#4,#10G	Clothes Dryer	2B:6
2B:7	Dishwasher	1/2"C,1#12,#12N,#12G	20	GA			4.2 A	40....					2B:8
2B:9	Refrigerator	1/2"C,1#12,#12N,#12G	20	GA	1.5 A	40....			G	60	3/4"C,2#4,#10G	Range	2B:10
2B:11	Living Room Receptacles	1/2"C,1#12,#12N,#12G	20	A			7.5 A	40....					2B:12
2B:13	Kitchen/Living Room Lights	1/2"C,1#12,#12N,#12G	20	A	0.9 A	20....				30	1/2"C,2#10,#10G	Blower Coil	2B:14
2B:15	Hood/Microwave	1/2"C,1#12,#12N,#12G	20	GA			2.1 A	20....					2B:16
2B:17	Clothes Washer Receptacle	1/2"C,1#12,#12N,#12G	20	A	1.5 A	11....				20	1/2"C,2#12,#12G	Heat Pump	2B:18
2B:19	Bathroom	1/2"C,1#12,#12N,#12G	20				2.8 A	11....					2B:20
2B:21	Bedroom 1	1/2"C,1#12,#12N,#12G	20	A	4.9 A	--				--	--	Surge Protection	2B:22
2B:23	Bedroom 2	1/2"C,1#12,#12N,#12G	20	A			7.9 A	--		--	--	Surge Protection	2B:24

Designation: 2C

Installed Location: 2 Bedroom Unit (2C)
Voltage: 120/208 1PH 3W-1Ph-3W
Mounting: Flush
Enclosure: NEMA 1

Bus Amps: 100
MCB Amps: MLO
Features & Modifications: PROVIDE SURGE PROTECTION DEVICE

SCCR/AIC: 22.0 kA
Mains FN/Note: -

Ckt	Description	Circuitry	Trip (A)	FN	A		B		FN	Trip (A)	Circuitry	Description	Ckt
2C:1	Counter Top Receptacles	1/2"C,1#12,#12N,#12G	20	GA	3.0 A	21....				30	1/2"C,2#10,#10G	Electric Water Heating	2C:2
2C:3	Counter Top/Kitchen Receptacles	1/2"C,1#12,#12N,#12G	20	GA			3.0 A	21....					2C:4
2C:5	Disposal	1/2"C,1#12,#12N,#12G	20	GA	4.2 A	40....			G	60	3/4"C,2#4,#10G	Clothes Dryer	2C:6
2C:7	Dishwasher	1/2"C,1#12,#12N,#12G	20	GA			4.2 A	40....					2C:8
2C:9	Refrigerator	1/2"C,1#12,#12N,#12G	20	GA	1.5 A	40....			G	60	3/4"C,2#4,#10G	Range	2C:10
2C:11	Living Room Receptacles	1/2"C,1#12,#12N,#12G	20	A			6.0 A	40....					2C:12
2C:13	Kitchen/Living Room Lights	1/2"C,1#12,#12N,#12G	20	A	0.8 A	20....				30	1/2"C,2#10,#10G	Blower Coil	2C:14
2C:15	Hood/Microwave	1/2"C,1#12,#12N,#12G	20	GA			2.1 A	20....					2C:16
2C:17	Clothes Washer Receptacle	1/2"C,1#12,#12N,#12G	20	A	1.5 A	11....				20	1/2"C,2#12,#12G	Heat Pump	2C:18
2C:19	Bathroom	1/2"C,1#12,#12N,#12G	20				2.8 A	11....					2C:20
2C:21	Bedroom 1	1/2"C,1#12,#12N,#12G	20	A	7.9 A	--				--	--	Surge Protection	2C:22
2C:23	Bedroom 2	1/2"C,1#12,#12N,#12G	20	A			7.9 A	--		--	--	Surge Protection	2C:24

Designation: 2D

Installed Location: 2 Bedroom Unit (2D)
Voltage: 120/208 1PH 3W-1Ph-3W
Mounting: Flush
Enclosure: NEMA 1

Bus Amps: 100
MCB Amps: MLO
Features & Modifications: PROVIDE SURGE PROTECTION DEVICE

SCCR/AIC: 22.0 kA
Mains FN/Note: -

Ckt	Description	Circuitry	Trip (A)	FN	A		B		FN	Trip (A)	Circuitry	Description	Ckt
2D:1	Counter Top Receptacles	1/2"C,1#12,#12N,#12G	20	GA	4.5 A	21....				30	1/2"C,2#10,#10G	Electric Water Heating	2D:2
2D:3	Counter Top/Kitchen Receptacles	1/2"C,1#12,#12N,#12G	20	GA			4.5 A	21....					2D:4
2D:5	Disposal	1/2"C,1#12,#12N,#12G	20	GA	4.2 A	40....			G	60	3/4"C,2#4,#10G	Clothes Dryer	2D:6
2D:7	Dishwasher	1/2"C,1#12,#12N,#12G	20	GA			4.2 A	40....					2D:8
2D:9	Refrigerator	1/2"C,1#12,#12N,#12G	20	GA	1.5 A	40....			G	60	3/4"C,2#4,#10G	Range	2D:10
2D:11	Living Room Receptacles	1/2"C,1#12,#12N,#12G	20	A			7.5 A	40....					2D:12
2D:13	Kitchen/Living Room Lights	1/2"C,1#12,#12N,#12G	20	A	0.9 A	20....				30	1/2"C,2#10,#10G	Blower Coil	2D:14
2D:15	Hood/Microwave	1/2"C,1#12,#12N,#12G	20	GA			2.1 A	20....					2D:16
2D:17	Clothes Washer Receptacle	1/2"C,1#12,#12N,#12G	20	A	1.5 A	11....				20	1/2"C,2#12,#12G	Heat Pump	2D:18
2D:19	Bathroom	1/2"C,1#12,#12N,#12G	20				2.8 A	11....					2D:20
2D:21	Bedroom 1	1/2"C,1#12,#12N,#12G	20	A	4.9 A	--				--	--	Surge Protection	2D:22
2D:23	Bedroom 2	1/2"C,1#12,#12N,#12G	20	A			7.9 A	--		--	--	Surge Protection	2D:24

Breaker Function Schedule

A	Arc-Fault Interrupter (AFCI) Protection
AG	Combination Arc and Ground Fault Circuit Interrupter Protection
G	Ground-Fault Circuit Interrupter (GFCI) Protection (5 mA)
L	Provide breaker with lock-on clip

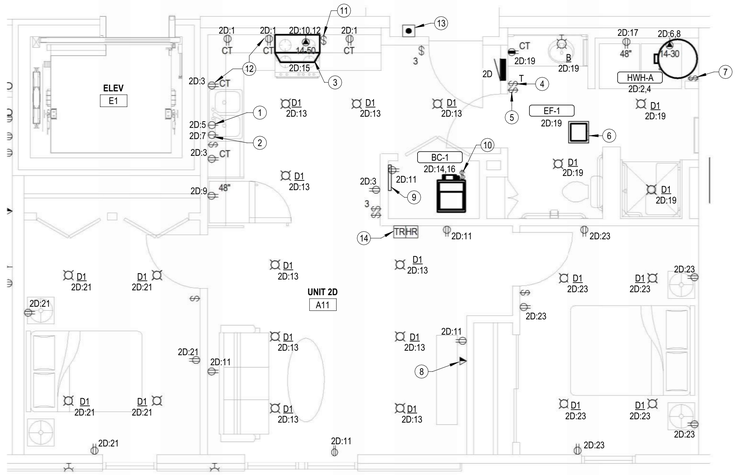

3 E4.2 2 BEDROOM (UNIT 2D) ACCESSIBLE ENLARGED ELECTRICAL PLAN
1/4" = 1'-0"
0 2' 4' 8'

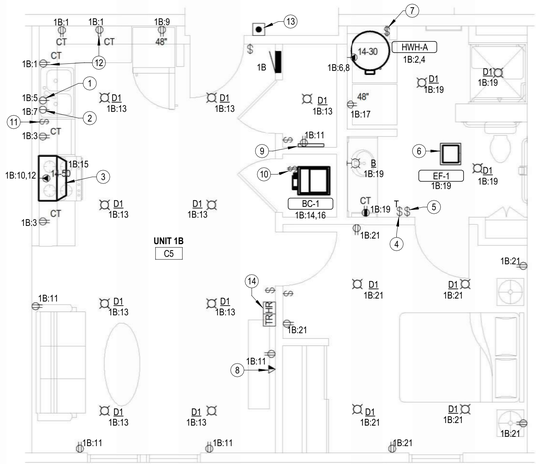

1 E4.2 1 BEDROOM ACCESSIBLE (UNIT 1B) ENLARGED ELECTRICAL PLAN
1/4" = 1'-0"
0 2' 4' 8'

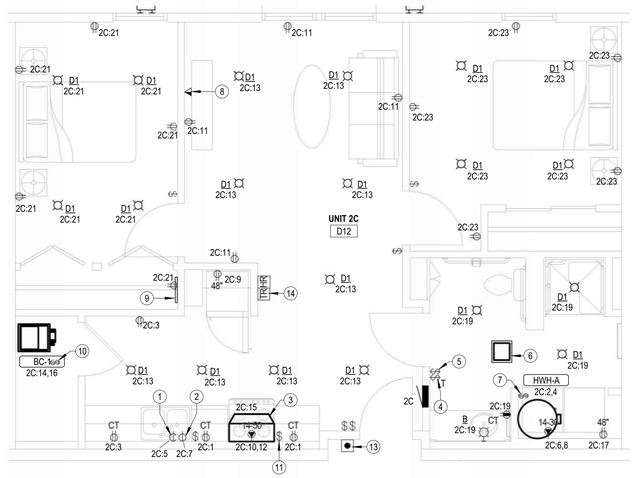

2 E4.2 2 BEDROOM ACCESSIBLE (UNIT 2C) ENLARGED ELECTRICAL PLAN
1/4" = 1'-0"
0 2' 4' 8'

NOTES BY SYMBOL

1. SWITCHED RECEPTACLE BELOW COUNTER FOR GARBAGE DISPOSAL. COORDINATE EXACT LOCATION OF SWITCH WITH ARCHITECT.
2. PROVIDE RECEPTACLE BELOW COUNTER FOR CORD AND PLUG CONNECTION OF DISHWASHER. PROVIDE CORD AND GROUNDING PLUG AS REQUIRED.
3. PROVIDE 120V CONNECTION TO RANGE HOOD/MICROWAVE. STANDARD AND ADAPTABLE UNITS WILL HAVE MICROWAVE ABOVE RANGE. ACCESSIBLE UNITS WILL HAVE RANGE HOOD. COORDINATE EXACT ELECTRICAL ROUGH-IN REQUIREMENTS WITH EQUIPMENT PROVIDED. IF EQUIPMENT IS CORD AND PLUG, PROVIDE RECEPTACLE INSIDE CABINET ABOVE RANGE.
4. PROVIDE TIMER SWITCH EQUAL TO AIR CYCLER 'SMART EXHAUST' FOR CONTROL OF EXHAUST FAN. SET SWITCH PER MANUFACTURER'S INSTRUCTIONS TO OPERATE FAN AS INDICATED BELOW:
   1 BEDROOM: 36 MINUTES PER HOUR
   2 BEDROOM: 54 MINUTES PER HOUR
   NOTE: CONTRACTOR MAY OMIT TIMER SWITCH IN 2 BEDROOM UNITS AND WIRE EXHAUST FAN FOR CONTINUOUS OPERATION.
5. SWITCH CLOSEST TO DOOR SHALL CONTROL ALL LIGHTS IN BATHROOM, AND THE OTHER SWITCH SHALL CONTROL THE EXHAUST FAN.
6. CONNECT EXHAUST FAN/LIGHT PROVIDED BY MECHANICAL CONTRACTOR.
7. PROVIDE 30A/2P SNAP SWITCH AND CONNECT WATER HEATER. INSTALL SWITCH ADJACENT TO WATER HEATER.
8. COORDINATE FINAL LOCATIONS OF ALL CATV AND PHONE OUTLETS WITH OWNER.
9. TELECOM DISTRIBUTION DEVICE APPROXIMATELY 4'-0" AFF. COORDINATE EXACT REQUIREMENTS WITH UTILITY PROVIDER SELECTED BY OWNER.
10. PROVIDE 30A/2P, SINGLE THROW, MANUAL MOTOR CONTROLLER SNAP SWITCH IN NEMA 1 ENCLOSURE. HUBBELL #HBL7832D OR EQUAL. MAKE FINAL FLEXIBLE CONNECTION TO BLOWER COIL/ELECTRIC HEAT.
11. PROVIDE SWITCH IN ACCESSIBLE UNITS FOR CONTROL OF RANGE HOOD
12. IN ACCESSIBLE UNITS, INSTALL COUNTERTOP RECEPTACLES A MINIMUM 36" AWAY FROM CORNER PER FAIR HOUSING ACT DESIGN MANUAL CHAPTER 5 'SIDE REACH OVER AN OBSTRUCTION' REQUIREMENTS. WHERE AN OBSTRUCTION PREVENTS 36" DISTANCE REQUIREMENT, INSTALL RECEPTACLE AS FAR FROM CORNER AS POSSIBLE. PROVIDE ADDITIONAL OUTLETS WITHIN 36" OF CORNER TO ENSURE COMPLIANCE WITH NEC PACING REQUIREMENTS.
13. PROVIDE PUSH BUTTON AT 48" AFF FOR ANNUNCIATOR SYSTEM AT ALL ACCESSIBLE APARTMENTS AND ALSO AT APARTMENTS DESIGNATED FOR HEARING-IMPAIRED. REFER TO ARCH DRAWINGS FOR APPLICABLE ROOMS. REFER TO DETAIL 4, SHEET E6.1.
14. PROVIDE DOOR ANNUNCIATOR SYSTEM A/V HORN/STROBE DEVICE AND LOW VOLTAGE TRANSFORMER AT ALL ACCESSIBLE APARTMENTS AND ALSO AT APARTMENTS DESIGNATED FOR HEARING-IMPAIRED GUESTS. REFER TO ARCH DRAWINGS FOR APPLICABLE ROOMS. INSTALL HORN/STROBE APPLIANCE AT 80" AFF PER ADA. INSTALL TRANSFORMER IN DOUBLE GANG JUNCTION BOX ABOVE HORN/STROBE WITH BLANK COVER LATE AND PROVIDE LOW VOLTAGE CONTROL WIRING. REFER TO DETAIL 4, SHEET E6.1. PROVIDE ENGRAVED SIGN AT THE HORN/STROBE DEVICE TO READ "DOOR".

Wichita-Sedgwick County
Metropolitan Area Building
and Construction Department

REVIEWED FOR CODE COMPLIANCE

CORRECTIONS OR COMMENTS MADE ON THESE DRAWINGS AND THIS DOCUMENT DURING THIS REVIEW DO NOT RELIEVE CONTRACTOR FROM COMPLIANCE WITH ALL REQUIREMENTS OF THE CODE OF THE MABCD, THE CITY OF WICHITA OR SEDGWICK COUNTY. THIS REVIEW IS ONLY FOR GENERAL CONFORMANCE OF THE CODE. THE CONTRACTOR IS RESPONSIBLE FOR CONFORMING AND CORRELATING ALL TECHNIQUES OF CONSTRUCTION. THIS APPROVAL IS SUBJECT TO PROVISIONS OF SECTION 107.4 OF THE 2012 INTERNATIONAL BUILDING CODE.

DATE: 02/19/25 BY: William Jerauld Jr

LST Consulting Engineers, PA
Manhattan, Kansas
785.587.8042
Wichita, Kansas
316.285.0696
www.LSTengineers.com
mail@LSTengineers.com

Project 24061

JonesGillamRenz
730 N. Ninth
Salina, KS 67401
785.827.0386
1881 Main Street, Suite 301
Kansas City, MO 64108
jgr@jgrarchitects.com

THE RESIDENCE AT HERATIGE WEST

NEW SENIOR LIVING FACILITY

ANDOVER, KANSAS

ADAM PATRICK LIPP LICENSED 24155 KANSAS PROFESSIONAL ENGINEER
2025.01.10 16:40:30-06'00'

REVISIONS:

DATE: 01-10-2025
JOB: 24-3379
SHEET NO.:

E4.2

COPYRIGHTED ©

LIGHT FIXTURE SCHEDULE

MARK	MANUFACTURER	MODEL NUMBER	WATTAGE	LUMEN OUTPUT	DRIVER	MOUNTING	FINISH	DESCRIPTION	NOTES
A	---	---			STANDARD	CEILING SURFACE	---	SURFACE MOUNTED DOWNLIGHT SELECTED BY INTERIOR DESIGNER	13
B	SEAGULL	FML-WL-48-35	29 W		STANDARD	SURFACE WALL	WHITE	3 LAMP VANITY LIGHT	--
C	T-BAR LED	TBSL-MN-5-15-B2-B	40 W	2190 lm	0-10V DIMMING TO 10%	CEILING SURFACE	BLACK	5' T-BAR LED WITH BLOCK CLEAR DUFFUSING LENS INTEGRAL TO SUSPENDED CEILING	13
CE	T-BAR LED	TBSL-MN-5-15-B2-B	40 W	2190 lm	0-10V DIMMING TO 10%	CEILING SURFACE	BLACK	5' T-BAR LED WITH BLOCK CLEAR DUFFUSING LENS INTEGRAL TO SUSPENDED CEILING WITH EMERGENCY BATTERY BACKUP OPTION	13
D1	HALO	SMD6R6930WH	10 W	750 lm	0-10V DIMMING TO 10%	CEILING SURFACE	WHITE	6" DIA ROUND SURFACE MOUNT DOWNLIGHT	6
D2	HALO	SMD6R12930WH	15 W	1200 lm	0-10V DIMMING TO 10%	CEILING SURFACE	WHITE	6" DIA ROUND SURFACE MOUNT DOWNLIGHT	--
E1	LITHONIA	ELM6L UVOLT LTP	3 W		--	SURFACE WALL	WHITE	LED DUAL-HEAD EMERGENCY LIGHT	1
E2	LITHONIA	AFB-OEL-DDBTXD-UVOLT-N-WT	3 W		--	SURFACE WALL	WHITE	DIE-CAST ALUMINUM EMERGENCY LIGHT WITH POLYCARBONATE LENS, INTEGRAL BATTER	1,2,3
F1	DAY-BRITE CFI	FSS440L840-UNV-DIM	30 W	4077 lm	0-10V DIMMING TO 10%	CEILING SURFACE	WHITE	4' STANDARD STRIP WITH CURVED FROSTED ACRYLIC LENS	--
F2	DAY-BRITE CFI	FSS220L840-UNV-DIM	17 W	2049 lm	0-10V DIMMING TO 10%	CEILING SURFACE	WHITE	2' STANDARD STRIP WITH CURVED FROSTED ACRYLIC LENS	--
G	LITHOINA	WL4-40L-EZ1-LP830-MSD7-DIM50-E10WLCP	40 W	3927 lm	STANDARD	SURFACE WALL	WHITE	4 FT. WALL MOUNTED STAIRWELL LIGHT WITH EMERGENCY BATTERY BACKUP	8
H	LITHONIA	FMFL-30840-CAML-WH	35 W	2800 lm	STANDARD	SURFACE	WHITE	LED DECORATIVE SURFACE	--
J	---	---			STANDARD	SURFACE WALL	WHITE	VERTICAL VANITY LIGHT SELECTED BY INTERIOR DESIGNER	13
L	LIGHTOLIER	P6RDL15940MCL-Z10UI	12 W	1500 lm	STANDARD	SURFACE	WHITE	6" ROUND SURFACE MOUNTED DOWNLIGHT	1,4
M	GARDCO	GCS-A01-840-T3M-UNV	10 W	1500 lm	STANDARD	SURFACE WALL	WHITE	AREA WALL SCONCE WITH TYPE 3 IES DISTRIBUTION	17
N	GARDCO	GCM-B04-840-PEN-U-STP-UNV-FAWS	16 W	1611 lm	STANDARD	SURFACE WALL	WHITE	UP/DOWN WALL SCONCE WITH SPOT DISTRIBUTION	14,16
O	BOCA	NANO-X-3W-4000K-120V-120-A-H-E-LD-SQ	3 W	573 lm	STANDARD	SURFACE WALL	WHITE	1" LED 120° WALL WASH UP LIGHT	3,15
P	GARDCO	941L-21L-NW-LV-UNV	32 W	466 lm	STANDARD	SURFACE WALL	WHITE	LED STEP LIGHTS	3
R1	COOPER LIGHTING	GALN-SA1C-840-U-T2-HSS	57 W	7154 lm	LED DRIVER	ROUND POLE	BLACK	LED AREA LIGHT, SINGLE HEAD FULL CUT-OFF WITH IES TYPE II DISTRIBUTION AND HOUSE SIDE SHEILD	3,7,10
R2	COOPER LIGHTING	GALN-SA3C-840-U-T3-HSS	160 W	20812 lm	LED DRIVER	ROUND POLE	BLACK	LED AREA LIGHT, SINGLE HEAD FULL CUT-OFF WITH IES TYPE III DISTRIBUTION AND HOUSE SIDE SHEILD	3,7,11
R3	COOPER LIGHTING	GALN-SA3C-840-U-5WQ	160 W	21966 lm	LED DRIVER	ROUND POLE	BLACK	LED AREA LIGHT, SINGLE HEAD FULL CUT-OFF WITH IES TYPE V DISTRIBUTION	3,7,12
S	ACCLAIM	DFB-111-AKEU	50 W	2455 lm	STANDARD	GRADE	BLACK	IP-66 RATED, GRADE MOUNTED LED FLOOR LIGHT	
T	LITHOINA	FEM-L48-4000LM-IMAFL-WD-MVOLT-GZ10-35K-80CRI	24 W	3615 lm	STANDARD	SURFACE WALL	WHITE	4 FT. FULLY ENCLOSED AND GASKETED INDUSTRIAL FIXTURE WITH FROSTED, RIBBED, IMPACT-RESISTANT ACRYLIC LENS	--
X	LIFE SAFETY LIGHTING	LSXS2RWEMSDT			--	CEILING	WHITE	UNIVERSAL SINGLE/DOUBLE FACE POLYCARBONATE EXIT SIGN	
X1	LITHONIA	EDGR 1 R EL			--	CEILING	WHITE	SINGLE FACE LED EXIT SIGN	1,2
X3	LITHONIA	EDG 1 R EL WM			--	WALL	WHITE	SINGLE FACE LED EXIT SIGN	1,2
XE	LITHONIA	LHQM LED R HO			--	WALL	WHITE	COMBO EXIT/EMERGENCY LIGHTING UNIT	1,2

GENERAL:

- ALL LED FIXTURES SHALL ADHERE TO LM79 AND LM80 STANDARDS
- PROVIDE MANUFACTURER'S FLANGE KIT WHERE LAY-IN FIXTURES ARE TO BE INSTALLED IN GYP.
- ALL APARTMENT LIGHT FIXTURES SHALL BE ENERGY STAR CERTIFIED

NOTES:

1. PROVIDE FIXTURE WITH EMERGENCY BATTERY INTEGRAL CHARGER WITH SELF-DIAGNOSTIC/SELF-TESTING ELECTRONICS.
2. FIXTURE SHALL BE CAPABLE OF WALL OR CEILING MOUNT APPLICATIONS AND SHALL HAVE BREAK-OUT DIRECTIONAL CHEVRONS.
3. U.L. LISTED FOR 'WET LOCATION'.
4. U.L LISTED FOR 'DAMP LOCATION'.
5. FIXTURE TO COMPLY WITH NEC 410.16(C)(5).
6. WHERE INSTALLED IN BATHROOMS TO BE 'DAMP LOCATION' U.L. LISTED, WHERE ABOVE SHOWERS TO BE 'WET LOCATION' U.L. LISTED.
7. FIXTURE/POLE ASSEMBLY SHALL BE RATED FOR 100 MPH WIND LOADS. PROVIDE WITH VIBRATION DAMPER PER MANUFACTURER'S RECOMMENDATIONS.
8. PROVIDE FIXTURE WITH INTEGRAL OCCUPANCY SENSOR AND CONTROLS TO DIM FIXTURE TO 50% LIGHT OUTPUT WITH UNOCCUPIED.
9. WHERE INSTALLED IN FIRE RATED ASSEMBLY, PROVIDE FIRE RATED RECSSED LIGHT COVER EQUAL TO TENMAT FF109. VERIFY RATING REQUIREMENTS WITH ARCHITECT.
10. PROVIDE FIXTURE/POLE ASSEMBLY WITH 11' ROUND STRAIGHT STEEL POLE, BLACK TO MATCH FIXTURE. FIXTURE HEIGHT SHALL NOT EXCEED 7'-0".
11. PROVIDE FIXTURE/POLE ASSEMBLY WITH 14' ROUND STRAIGHT STEEL POLE, BLACK TO MATCH FIXTURE. FIXTURE HEIGHT SHALL NOT EXCEED 7'-0".
12. PROVIDE FIXTURE/POLE ASSEMBLY WITH 22' ROUND STRAIGHT STEEL POLE, BLACK TO MATCH FIXTURE. FIXTURE HEIGHT SHALL NOT EXCEED 7'-0".
13. FIXTURE TO BE SELECTED BY INTERIOR DESIGNER, COORDINATE ALL REQUIREMENTS WITH INTERIOR DESIGNER.
14. CONTRACTOR SHALL ADJUST LUMEN OUTPUT AS DIRECTED BY OWNER. COORDINATION SHALL OCCUR AFTER DARK TO ENSURE DESIRED ILLUMINATION.
15. INSTALL FIXTURE 41' ABOVE FIRST FLOOR FINISHED FLOOR.
16. INSTALL FIXTURE 10' ABOVE FINISHED FLOOR.
17. INSTALL FIXTURE 7' ABOVE FINISHED FLOOR.

Wichita-Sedgwick County
Metropolitan Area Building
and Construction Department

REVIEWED FOR CODE COMPLIANCE

CORRECTIONS OR COMMENTS MADE ON THESE DRAWINGS AND THIS DOCUMENT DURING THIS REVIEW DO NOT RELIEVE CONTRACTOR FROM COMPLIANCE WITH ALL REQUIREMENTS OF THE CODE OF THE MABCD, THE CITY OF WICHITA OR SEDGWICK COUNTY. THIS REVIEW IS ONLY FOR GENERAL CONFORMANCE OF THE CODE. THE CONTRACTOR IS RESPONSIBLE FOR CONFORMING AND CORRELATING ALL TECHNIQUES OF CONSTRUCTION. THIS APPROVAL IS SUBJECT TO PROVISIONS OF SECTION 107.4 OF THE 2012 INTERNATIONAL BUILDING CODE.

DATE: 02/19/25 BY: William Jerauld Jr

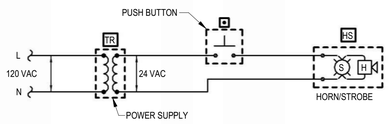

DOOR ALARM BUZZER SYSTEM NOTES

1. PROVIDE DOOR ANNUNCIATOR SYSTEM COMPLETE WITH PUSH BUTTON, HORN/STROBE(S), POWER SUPPLIES AND ALL WIRING REQUIRED. HORN/STROBE SHALL ACTIVATE WHEN PUSH BUTTON IS DEPRESSED.
2. HORN/STROBE SHALL OPERATE AT 24VAC, HAVE A CLEAR LENS WITH 50cd STROBE AND HORN WITH 82dB AT 10', UL 1638 LISTED, EDWARDS #6536-G5. FLUSH MOUNT IN WALL AT 6'-8" AFF.
3. PUSH BUTTON SHALL BE SELECTED BY INTERIOR DESIGNER, MOUNT AT 48" AFF. ENSURE COMPATIBILITY WITH ACCESSIBLE UNIT HORN STROBE.
4. POWER SUPPLY SHALL BE A LOW VOLTAGE CLASS 2 TRANSFORMER COMPATIBLE WITH DOORBELL SELECTED BY INTERIOR DESIGNER. FLUSH MOUNT IN 2-GANG WALL BOX WITH BLANK COVER PLATE, DIRECTLY ABOVE HORN/STROBE.
5. LOW VOLTAGE CLASS 2 CABLING SHALL BE MINIMUM 18 AWG UNSHIELDED.

4 E6.1 ACCESSIBLE APARTMENT DOORBELL WIRING SCHEMATIC
NO SCALE

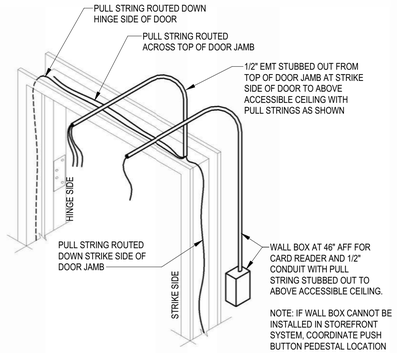

3 E6.1 DOOR ACCESS CONTROL ROUGH-IN DIAGRAM
NO SCALE

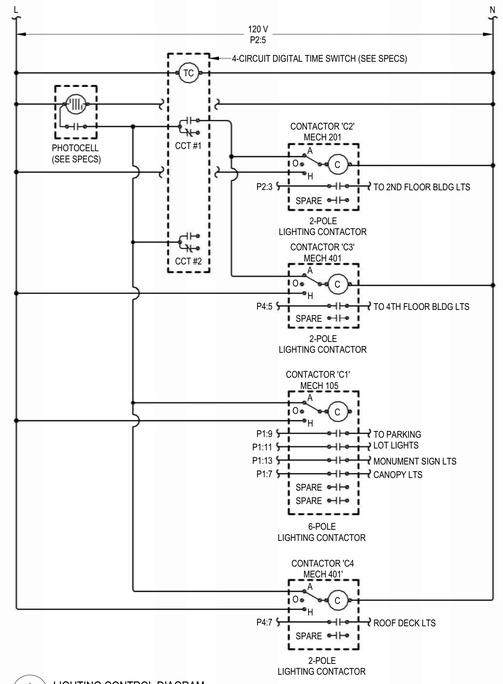

2 E6.1 LIGHTING CONTROL DIAGRAM
NO SCALE

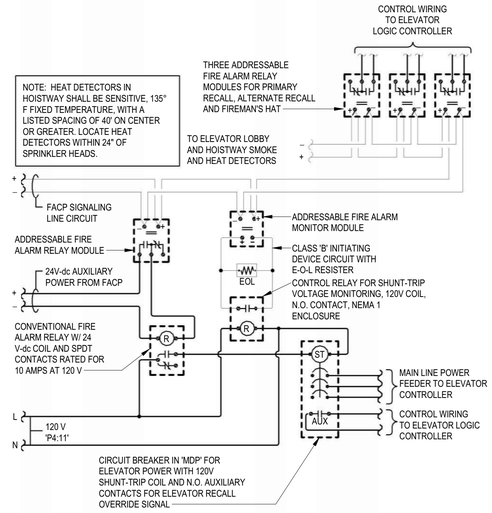

ELEVATOR RECALL AND SHUT-DOWN SEQUENCE OF OPERATION:

1. UPON SENSING SMOKE FROM ONE OR MORE ELEVATOR LOBBY OR HOISTWAY, THE SMOKE DETECTOR SHALL SIGNAL THE FIRE ALARM CONTROL PANEL, WHICH WILL FORWARD THE SIGNAL TO THE ELEVATOR LOGIC CONTROLLER VIA ADDRESSABLE RELAY MODULES TO RECALL ELEVATOR CAB TO THE PRIMARY RECALL FLOOR. IF PRIMARY RECALL FLOOR'S LOBBY SMOKE DETECTOR SENSES SMOKE AT THAT FLOOR, THE ELEVATOR CONTROLLER WILL SEND THE ELEVATOR CAB TO THE NEXT FLOOR CLEAR OF SMOKE. ONCE THE ELEVATOR CAB HAS REACHED THE DESIGNATED FLOOR, THE ELEVATOR CAB DOORS WILL OPEN AND THE CONTROLLER WILL LOCK THE ELEVATOR CAB AT THAT FLOOR, DISABLING THE ELEVATOR CAB CONTROLS, UNLESS A FIREMAN'S KEY IS USED TO OVERRIDE AUTOMATIC CONTROLS.
2. ALL SMOKE DETECTORS ASSOCIATED WITH ELEVATOR RECALL (LOBBY AND HOISTWAY) SHALL TRANSMIT A SEPARATE AND DISTINCT VISIBLE ANNUNCIATION AT THE FIRE ALARM CONTROL PANEL.
3. UPON SENSING A HEAT ALARM CONDITION IN THE ELEVATOR HOISTWAY, THE HEAT DETECTOR SHALL SIGNAL THE FIRE ALARM CONTROL PANEL, WHICH WILL FORWARD THE SIGNAL TO THE ADDRESSABLE RELAY MODULE TO ACTIVATE (VIA A CONVENTIONAL FIRE ALARM RELAY) THE SHUNT-TRIP BREAKER POWERING THE ELEVATOR SO AS TO DISCONNECT POWER TO THAT CIRCUIT. THIS IS TO BE A NON-AUTO RESET SWITCH. WHEN THE SPRINKLER HEAD HAS REACHED ITS CRITICAL TEMPERATURE OF 165° F., THE HEAD WILL BEGIN DISCHARGE OF WATER.

1 E6.1 ELEVATOR RECALL AND SHUT-DOWN WIRING DIAGRAM
NO SCALE

LST Consulting Engineers, PA
Manhattan, Kansas
785.587.8042
Wichita, Kansas
316.285.0696
www.LSTengineers.com
mail@LSTengineers.com

Project 24061

JonesGillamRenz
730 N. Ninth
Salina, KS 67401
785.827.0386
1881 Main Street, Suite 301
Kansas City, MO 64108
jgr@jgrarchitects.com

THE RESIDENCE AT HERATIGE WEST

NEW SENIOR LIVING FACILITY

ANDOVER, KANSAS



REVISIONS:

DATE: 01-10-2025
JOB: 24-3379
SHEET NO.:

E6.1

© COPYRIGHTED

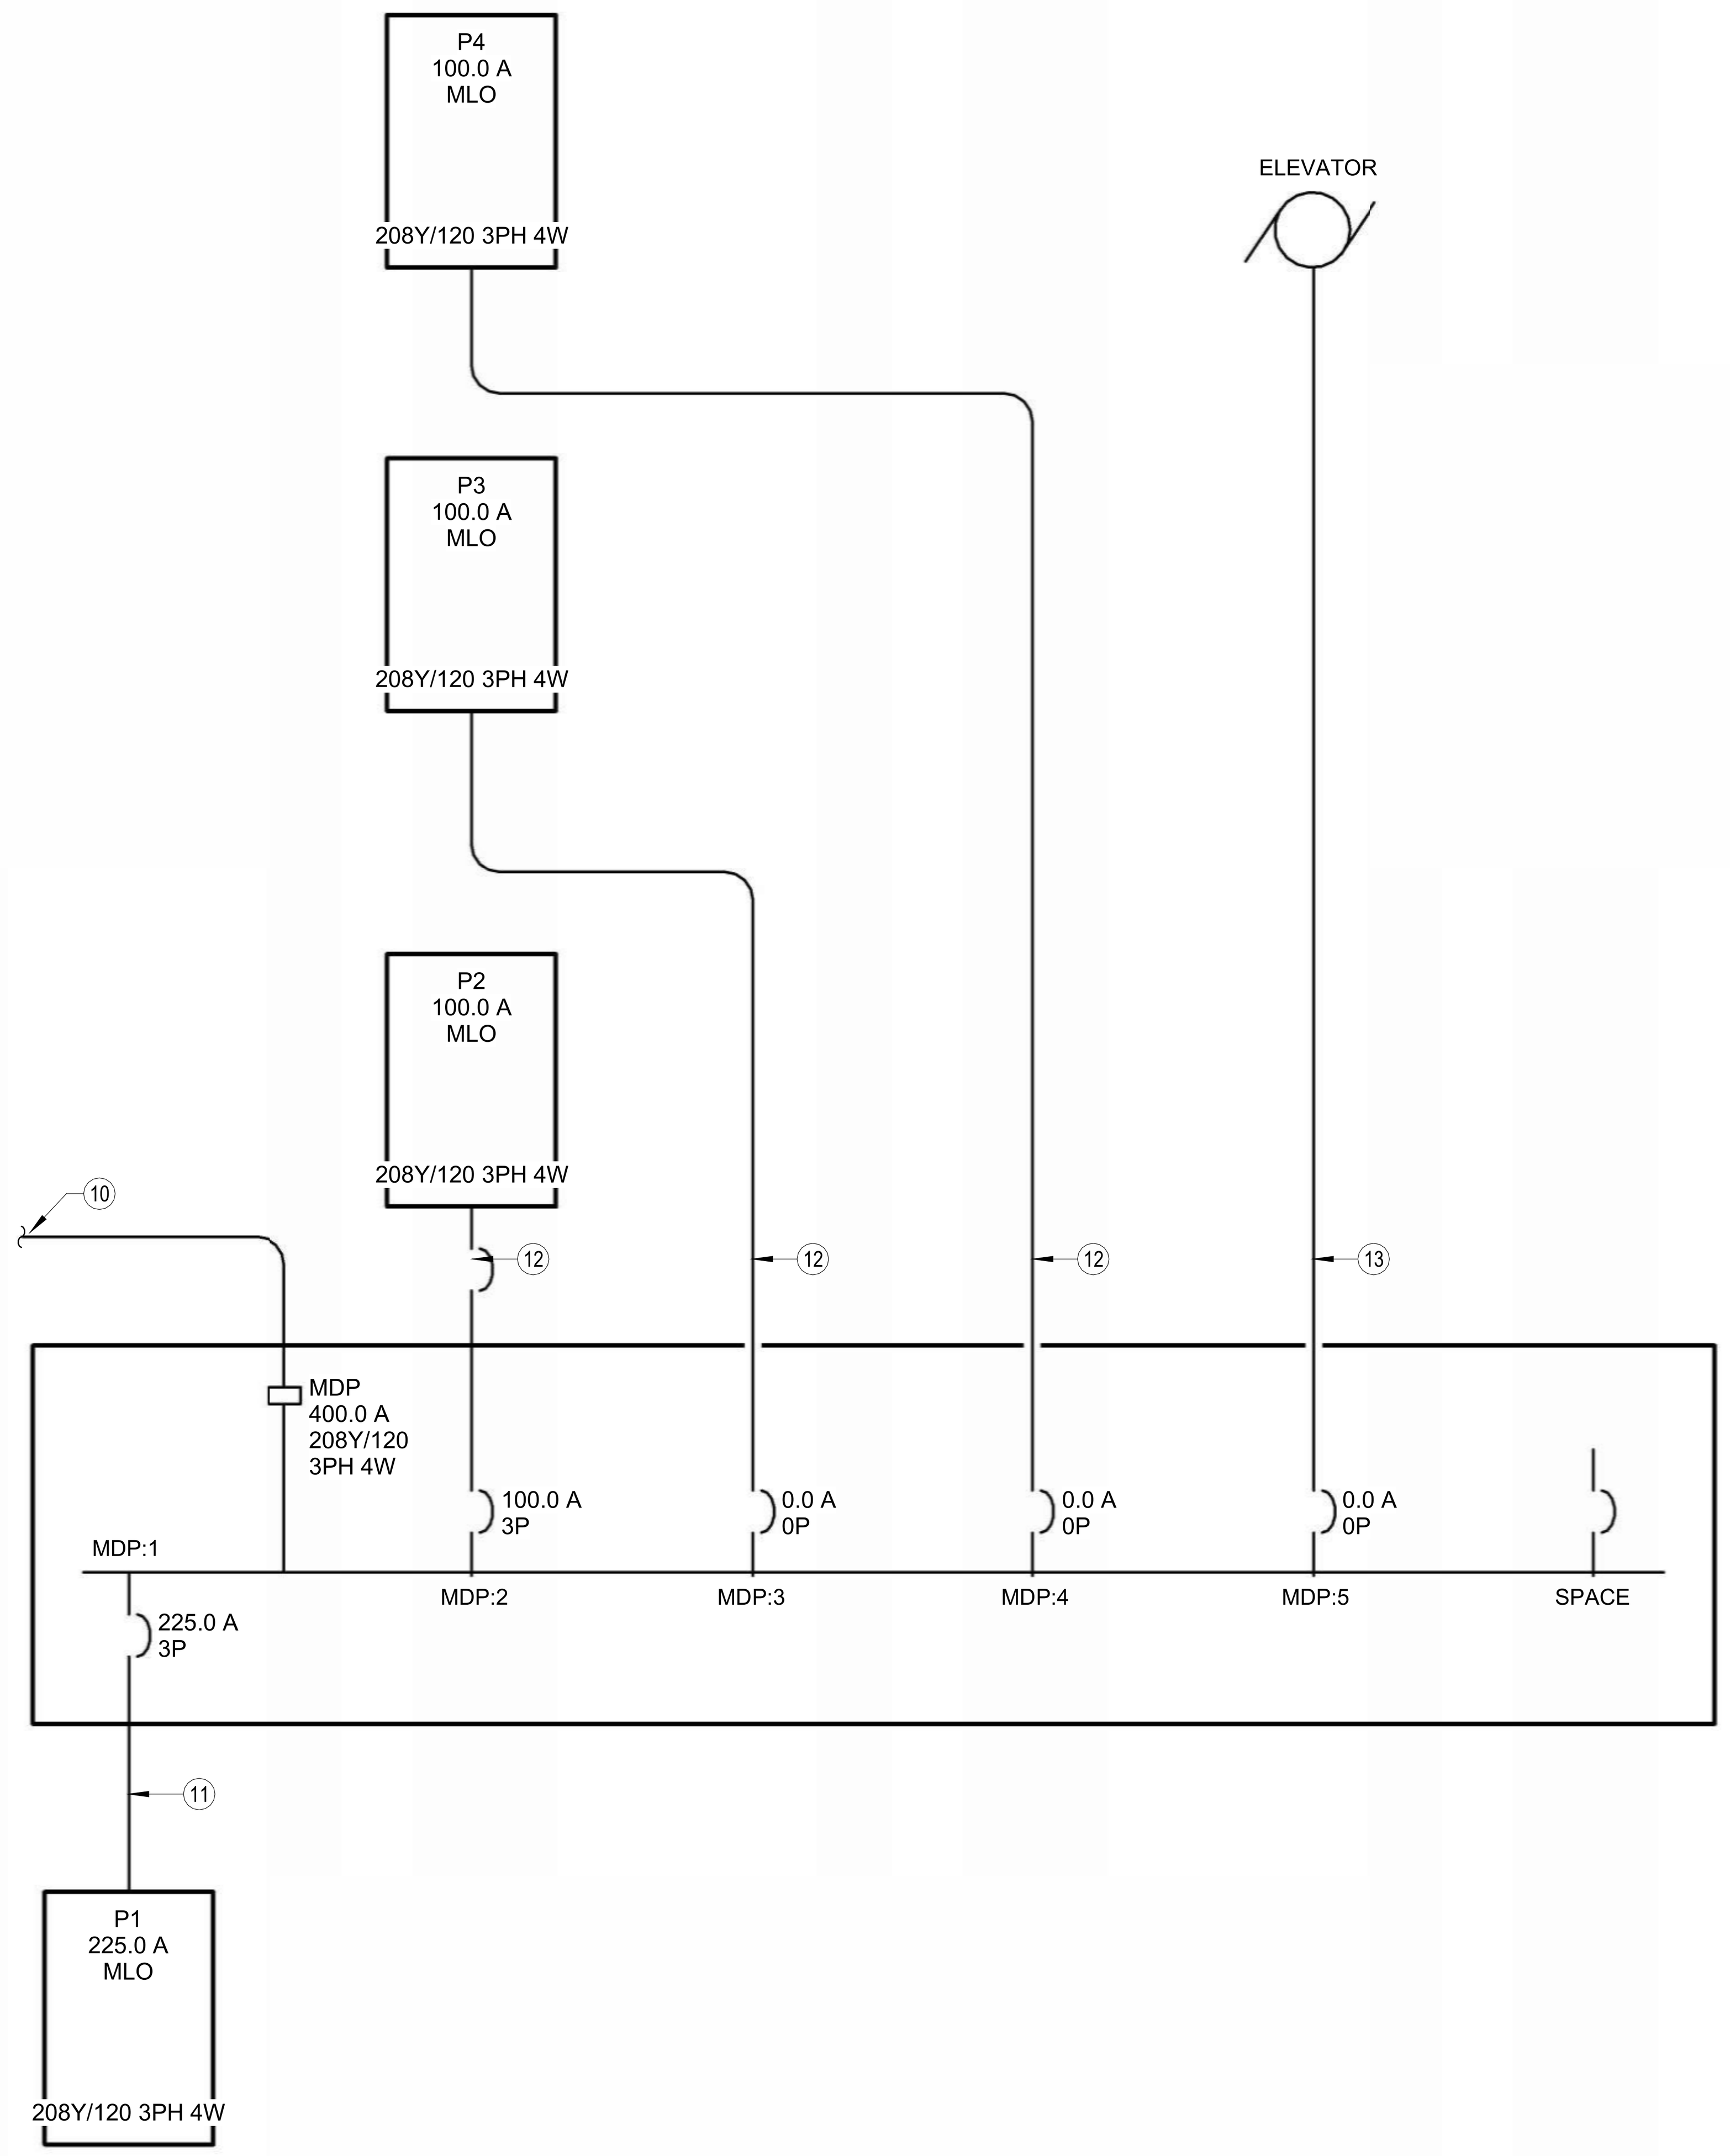

2 / E6.2 HOUSE ELECTRIC SERVICE RISER DIAGRAM
1" = 1'-0"

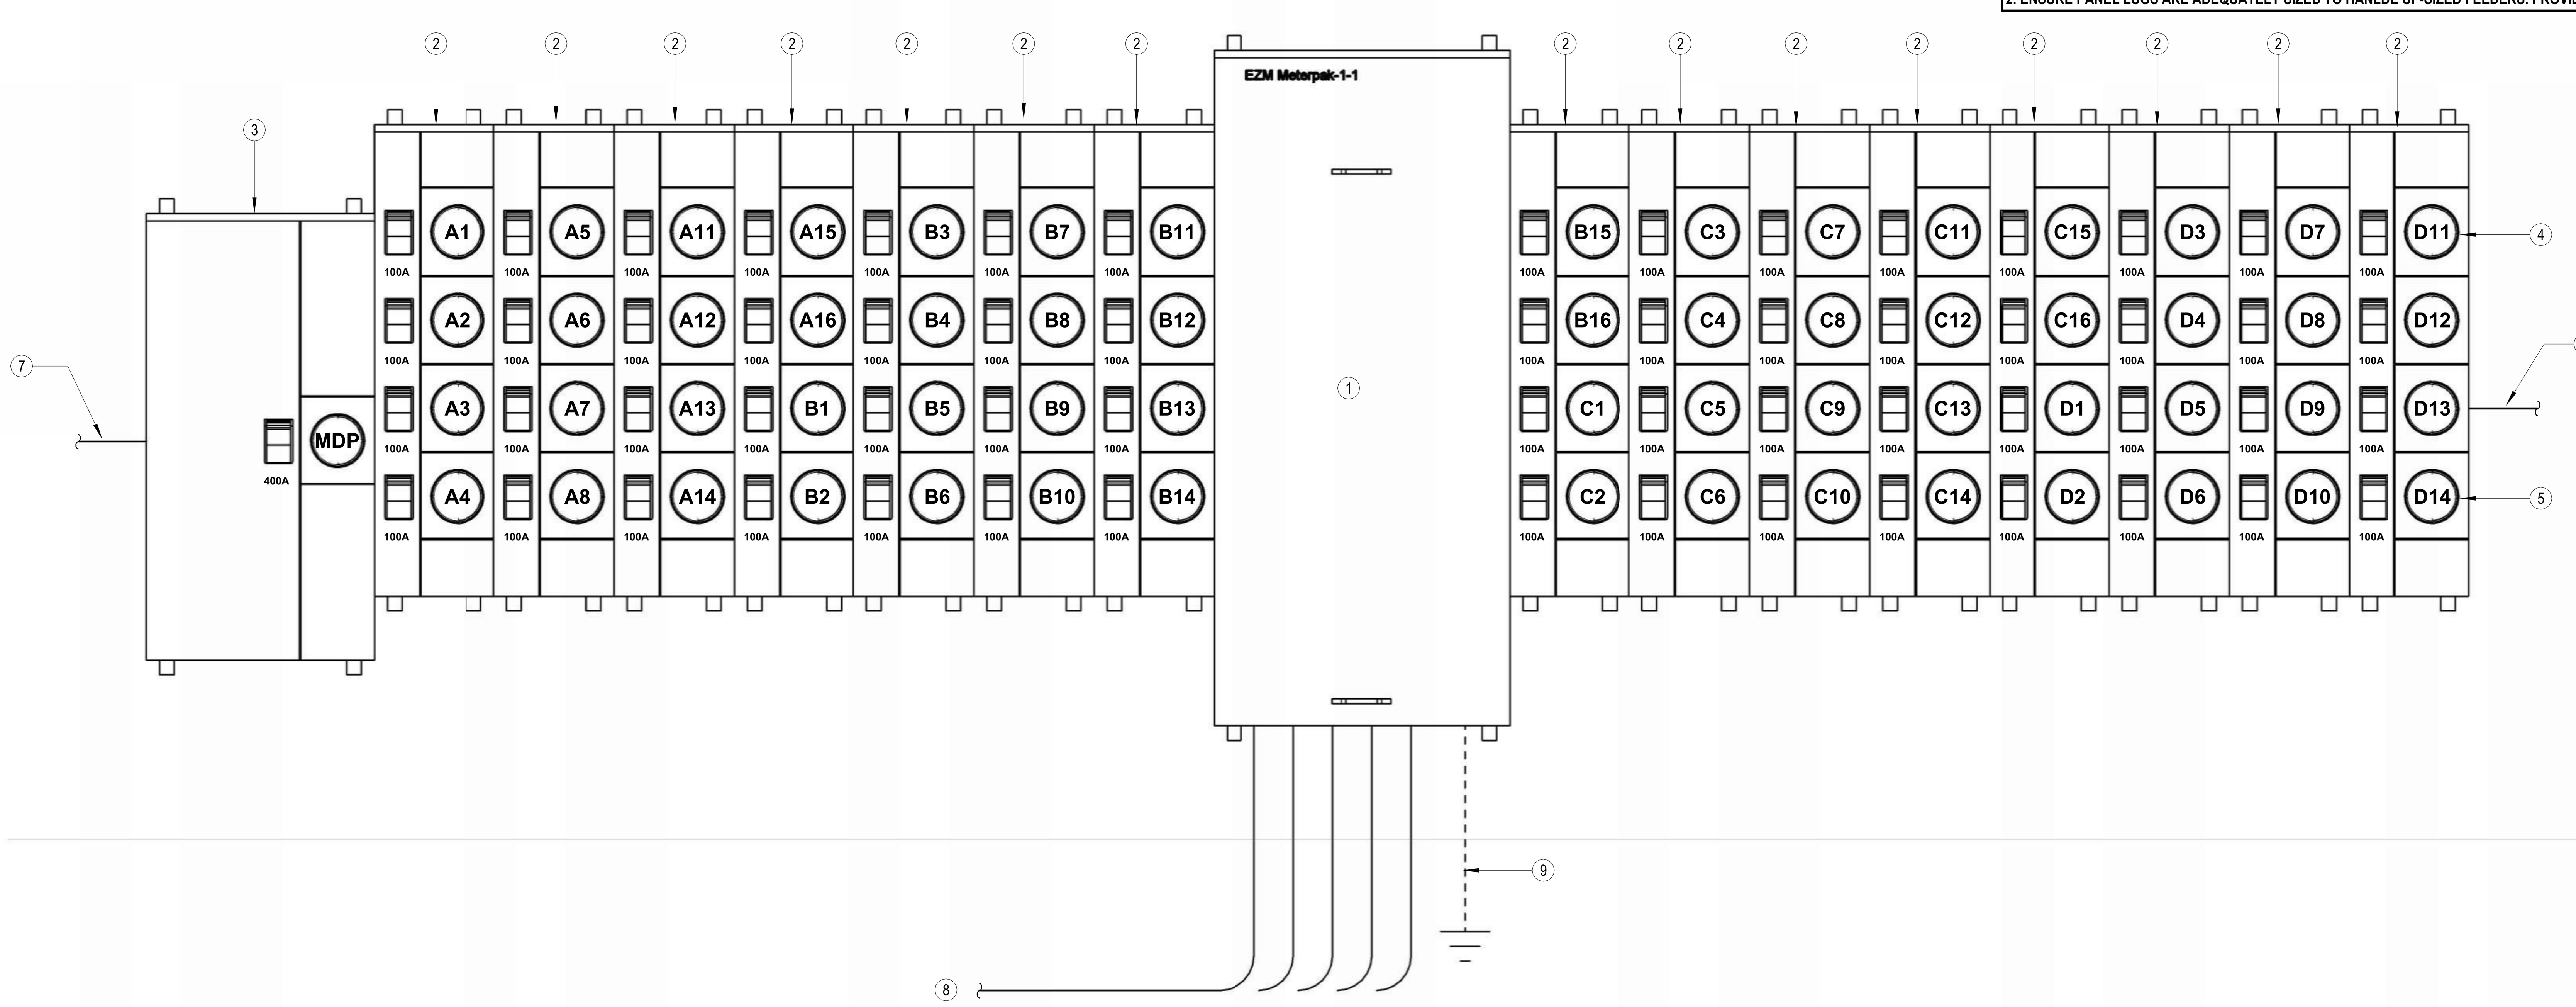

1 / E6.2 ELECTRICAL RISER DIAGRAM
1" = 1'-0"

DWELLING UNIT FEEDER CALCULATION

UNIT TYPE: 2BR

AREA: 800 SF

FEEDER AND SERVICE LOADS PER NEC 220.82 PART IV

				Connected Load (VA)	Demand Load (VA)
(B)	***General Loads***				
(B1)	General Lighting and Receptacles (220.82 (B)(1))				
	a) Lighting and Receptacles	3 VA per Square Foot		2400 VA	
(B2)	Small Appliance & Laundry Branch Circuits (220.82 (B)(2))				
	a) Laundry Circuit	1500 VA per Circuit	1 Circuit	1500 VA	
	b) Kitchen Circuits	1500 VA per Circuit	2 Circuits	3000 VA	
(B3)	Nameplate Ratings of Equipment (220.82 (B)(3))				
	a1) Dishwasher	840 VA each	Qty. 1	840 VA	
	a2) Refrigerator	1000 VA each	Qty. 1	1000 VA	
	a3) Microwave	1000 VA each	Qty. 1	1000 VA	
	a4) Disposal	1175 VA each	Qty. 1	1175 VA	
	b) Electric Range	8000 VA each	Qty. 1	8000 VA	
	c) Clothes Dryer	5000 VA each	Qty. 1	5000 VA	
	d) Water Heater	4500 VA each	Qty. 1	4500 VA	
(B4)	Nameplate Ratings of Motors (220.82 (B)(4))				
	a) HVAC Blower Fan	336 VA each	Qty. 1	336 VA	
	b) Exhaust Fans	21 VA each	Qty. 1	21 VA	
			Part (B) Connect Load Total	28772 VA	
	Part (B) Demand Load Total (100% of 1st 10 KVA + 40% of remainder)				17509 VA
(C)	***Heating and Air Conditioning Load***				
(C1)	100% Namplate Rating of Air Conditioner (220.82 (C)(1))				
	a) A/C Unit #1	0 VA each	Qty. 0	0 VA	
	b) A/C Unit #2	0 VA each	Qty. 0	0 VA	
			Part (C1) Connect Load Total	0 VA	
(C2)	100% Namplate Rating of Heat Pump w/o Supplemental Heat (220.82 (C)(2))				
	a) Heat Pump Unit #1	0 VA each	Qty. 0	0 VA	
	b) Heat Pump Unit #2	0 VA each	Qty. 0	0 VA	
			Part (C2) Connect Load Total	0 VA	
(C3)	100% of Heat Pump & 65% Supplemental Electric Heat (220.82 (C)(3))				
	a1) Heat Pump Unit #1	0 VA each	Qty. 0	0 VA	
	a2) Electric Heat #1	0 VA each	Qty. 0	0 VA	
	b1) Heat Pump Unit #2	0 VA each	Qty. 0	0 VA	
	b2) Electric Heat #2	0 VA each	Qty. 0	0 VA	
			Part (C3) Connect Load Total	0 VA	
(C4)	65% of Total Electric Heat if < 4 Separately Controlled Units (220.82 (C)(4))				
	a) Electric Heat #1	3900 VA each	Qty. 1	2535 VA	
	b) Electric Heat #2	0 VA each	Qty. 0	0 VA	
			Part (C4) Connect Load Total	2535 VA	
(C5)	40% of Total Electric Heat if > 4 Separately Controlled Units (220.82 (C)(5))				
	a) Electric Heat #1	0 VA each	Qty. 0	0 VA	
	b) Electric Heat #2	0 VA each	Qty. 0	0 VA	
			Part (C5) Connect Load Total	0 VA	
			Part (C) Connect Load Total	2535 VA	
			Part (C) Demand Load (Largest of C1 - C5)		2535 VA
			Total Dwelling Unit Demand (VA)		20044 VA
			Total Amps @ 208 V /120V-1Ph-3W		96.4 A

Provide 100A Load Center & Feed with 100A/2P Breaker

DWELLING UNIT FEEDER CALCULATION

UNIT TYPE: 1BR

AREA: 650 SF

FEEDER AND SERVICE LOADS PER NEC 220.82 PART IV

				Connected Load (VA)	Demand Load (VA)
(B)	***General Loads***				
(B1)	General Lighting and Receptacles (220.82 (B)(1))				
	a) Lighting and Receptacles	3 VA per Square Foot		1950 VA	
(B2)	Small Appliance & Laundry Branch Circuits (220.82 (B)(2))				
	a) Laundry Circuit	1500 VA per Circuit	1 Circuit	1500 VA	
	b) Kitchen Circuits	1500 VA per Circuit	2 Circuits	3000 VA	
(B3)	Nameplate Ratings of Equipment (220.82 (B)(3))				
	a1) Dishwasher	840 VA each	Qty. 1	840 VA	
	a2) Refrigerator	1000 VA each	Qty. 1	1000 VA	
	a3) Microwave	1000 VA each	Qty. 1	1000 VA	
	a4) Disposal	1175 VA each	Qty. 1	1175 VA	
	b) Electric Range	8000 VA each	Qty. 1	8000 VA	
	c) Clothes Dryer	5000 VA each	Qty. 1	5000 VA	
	d) Water Heater	4500 VA each	Qty. 1	4500 VA	
(B4)	Nameplate Ratings of Motors (220.82 (B)(4))				
	a) HVAC Blower Fan	336 VA each	Qty. 1	336 VA	
	b) Exhaust Fans	21 VA each	Qty. 1	21 VA	
			Part (B) Connect Load Total	28322 VA	
	Part (B) Demand Load Total (100% of 1st 10 KVA + 40% of remainder)				17329 VA
(C)	***Heating and Air Conditioning Load***				
(C1)	100% Namplate Rating of Air Conditioner (220.82 (C)(1))				
	a) A/C Unit #1	0 VA each	Qty. 0	0 VA	
	b) A/C Unit #2	0 VA each	Qty. 0	0 VA	
			Part (C1) Connect Load Total	0 VA	
(C2)	100% Namplate Rating of Heat Pump w/o Supplemental Heat (220.82 (C)(2))				
	a) Heat Pump Unit #1	0 VA each	Qty. 0	0 VA	
	b) Heat Pump Unit #2	0 VA each	Qty. 0	0 VA	
			Part (C2) Connect Load Total	0 VA	
(C3)	100% of Heat Pump & 65% Supplemental Electric Heat (220.82 (C)(3))				
	a1) Heat Pump Unit #1	0 VA each	Qty. 0	0 VA	
	a2) Electric Heat #1	0 VA each	Qty. 0	0 VA	
	b1) Heat Pump Unit #2	0 VA each	Qty. 0	0 VA	
	b2) Electric Heat #2	0 VA each	Qty. 0	0 VA	
			Part (C3) Connect Load Total	0 VA	
(C4)	65% of Total Electric Heat if < 4 Separately Controlled Units (220.82 (C)(4))				
	a) Electric Heat #1	3900 VA each	Qty. 1	2535 VA	
	b) Electric Heat #2	0 VA each	Qty. 0	0 VA	
			Part (C4) Connect Load Total	2535 VA	
(C5)	40% of Total Electric Heat if > 4 Separately Controlled Units (220.82 (C)(5))				
	a) Electric Heat #1	0 VA each	Qty. 0	0 VA	
	b) Electric Heat #2	0 VA each	Qty. 0	0 VA	
			Part (C5) Connect Load Total	0 VA	
			Part (C) Connect Load Total	2535 VA	
			Part (C) Demand Load (Largest of C1 - C5)		2535 VA
			Total Dwelling Unit Demand (VA)		19864 VA
			Total Amps @ 208 V /120V-1Ph-3W		95.5 A

Provide 100A Load Center & Feed with 100A/2P Breaker

METER CENTER DEMAND CALCULATION

DWELLING UNIT QTY: 60

AREA: 43500 SF

FEEDER AND SERVICE LOADS PER NEC 220.84 PART IV

				Connected Load (VA)	Demand Load (VA)
(C)	***Calculated Loads***				
(C1)	General Lighting and Receptacles (220.84 (C)(1))				
	a) Lighting and Receptacles	3 VA per Square Foot		130500 VA	
(C2)	Required Circuits (220.84 (C)(2))				
	a) Laundry Circuit	1500 VA per Circuit	60 Circuits	90000 VA	
	b) Kitchen Circuits	1500 VA per Circuit	120 Circuits	180000 VA	
(C3)	Nameplate Ratings of Equipment (220.84 (C)(3))				
	a1) Dishwasher	840 VA each	Qty. 60	50400 VA	
	a2) Refrigerator	1000 VA each	Qty. 60	60000 VA	
	a3) Microwave	1000 VA each	Qty. 60	60000 VA	
	a4) Disposal	1175 VA each	Qty. 60	70500 VA	
	b) Electric Range	8000 VA each	Qty. 60	480000 VA	
	c) Clothes Dryer	5000 VA each	Qty. 60	300000 VA	
	d) Water Heater	4500 VA each	Qty. 60	270000 VA	
(C4)	Nameplate Ratings of Motors (220.84 (C)(4))				
	a) HVAC Blower Fan	336 VA each	Qty. 30	10080 VA	
	b) Exhaust Fans	21 VA each	Qty. 30	630 VA	
(C5)	Larger of A/C or Electric Heat (220.84 (C)(5))				
	a) A/C or Heat #1	3900 VA each	Qty. 30	117000 VA	
	b) A/C or Heat #2	0 VA each	Qty. 0	0 VA	
			Connected Load Total	1819110 VA	
			Dwelling Unit Demand Factor from Table 220.84 = 0.24		
			Total Apartment Demand (VA)		436586 VA
			Total House Load Demand (VA)		115000 VA
			Total Building Demand (VA)		551586 VA
			Total Meter Center Demand Load (Amperes) @ 208 V /120V- 3 Ph, 4 W		1531.1 A

Provide 1600A Meter Center

APARTMENT FEEDER SCHEDULE (COPPER)

APARTMENT PANEL NUMBER	FEEDER SIZE
A1, A2, A3, A4, A5, A6, A7, B1, B2, B3, B4, B5, B6, C1, C2, C3, C4, C5, D1, D2, D3, D4, D5,	(3)#1, #8G, 1-1/4"C.
A8, B8, B9, C6, C7, C8, C9, D6, D7	(3)#1/0, #6G, 1-1/2"C.
A11, B10, C10, D8, D9, D10	(3)#2/0, #4G, 2"C.
A12, A13, B11, B12, C11, C12, D11	(3)#3/0, #4G, 2"C.
A14, A15, A16, B13, B14, B15, B16, C13, C14, C15, C16, D12, D13, D14	(3)#4/0, #4G, 2"C.

NOTES:
1. VOLTAGE DROP HAS BEEN ACCOUNTED FOR IN SIZES INDICATED, FURTHER UPSIZING OF FEEDERS IS NOT...
2. ENSURE PANEL LUGS ARE ADEQUATELY SIZED TO HANLDE UP-SIZED FEEDERS. PROVIDE LUG ADAPTER KI...

APARTMENT FEEDER SCHEDULE (ALUMINUM)

APARTMENT PANEL NUMBER	FEEDER SIZE
A1, A2, A3, A4, A5, B1, B2, B3, B4, C1, C2, C3, D1, D2, D3	(3)#1, #8G, 1-1/4"C.
B5, C4, C5, D4	(3)#1/0, #6G, 1-1/2"C.
A6, A7, B6, B7, D5	(3)#2/0, #4G, 2"C.
A8, B8, B9, C6, C7, D6, D7	(3)#3/0, #3G, 2"C.
A11, B10, C8, C9, C10, D8, D9, D10	(3)#4/0, #2G, 2"C.
A12, A13, B11, B12, C11	(3)#250 KCMIL, #1G, 2-1/2"C.
A14, B13, C12, C13, D11, D12	(3)#300 KCMIL, #1/0G, 2-1/2"C.
A15, A16, B14, C14, D13	(3)#350 KCMIL, #2/0G, 2-1/2"C.
B15, B16, C15, C16, D14	(3)#400 KCMIL, #2/0G, 2-1/2"C.

NOTES:
1. VOLTAGE DROP HAS BEEN ACCOUNTED FOR IN SIZES INDICATED, FURTHER UPSIZING OF FEEDERS IS NOT NECESSARY
2. ENSURE PANEL LUGS ARE ADEQUATELY SIZED TO HANLDE UP-SIZED FEEDERS. PROVIDE LUG ADAPTER KITS IF REQUIRED.

NOTES BY SYMBOL

1. METER CENTER MAIN, 3-PH IN; 3-PH OUT, 208/120V-3PH, 4 WIRE WITH 1000A/3P MAIN BREAKER, 65 KAIC RATED, SERVICE ENTRANCE RATED WITH INTEGRAL SURGE PROTECTION DEVICE. SQUARE D 'EZ METER-PAK' #EZM31000CB.
2. 5-SOCKET BRANCH UNITS, 3-PH IN; 1-PH OUT, WITH (5) 100A BRANCH BREAKERS AS INDICATED. METER SOCKETS SHALL BE RINGLESS TYPE, 5-JAW WITH HORN BYPASS SQUARE D 'EZ METER-PAK' #EZMH315125. PROVIDE PERMANENT LABEL ON EACH METER SOCKET BREAKER INDICATING THE APARTMENT BEING SERVED.
3. 1-SOCKET BRANCH UNITS, 3-PH IN; 3-PH OUT, WITH (1) 400A BRANCH BREAKER. METER SOCKETS SHALL BE RINGLESS TYPE, 5-JAW WITH HORN BYPASS SQUARE D 'EZ METER-PAK' #EZMH331400. PROVIDE PERMANENT LABEL ON METER SOCKET BREAKER TO READ 'HOUSE'.
4. MAXIMUM HEIGHT TO CENTERLINE OF TOP METER SOCKET SHALL BE 5'-6" AFG.
5. MINIMUM HEIGHT TO BOTTOM OF METER SOCKET ASSEMBLY SHALL BE 18" AFG.
6. SEE FEEDER SCHEDULE, THIS SHEET FOR SIZES TO APARTMENT UNIT LOAD CENTERS.
7. (2) PARALLEL 2" CONDUITS, EACH WITH (4) #3/0 KCMIL, #3G COPPER, OR (2) PARALLEL 3" CONDUITS, EACH WITH (4)#300KCMIL, #2/0 GROUND ALUMINUM TO PANEL 'MDP'.
8. (5) PARALLEL 4" CONDUITS EACH WITH (4) #400 KCMIL COPPER FROM TRANSFORMER TO METER CENTER.
9. #3/0 CU GROUNDING ELECTRODE CONDUCTOR TO CONCRETE ENCASED ELECTRODE, UNDERGROUND METAL WATER PIPE, AND DRIVEN GROUND ROD. BOND ALL ITEMS IN ACCORDANCE WITH NEC ARTICLE 250.
10. SEE 1:E6.2 FOR CONTINUATION.
11. (4)#3/0, #6G., 2"C.
12. (4)#1, #8G., 1-1/2"C.
13. (4)#4, #10G., 1"C.

NOTES:
- Meter Center main circuit breaker shall be 65 kAIC fully rated. Feeder breakers may be series rated with main breaker for a 42 kAIC rating.
- All conductor sizes are based on copper, U.N.O.
- Entire installation shall comply with NEC.
- Coordinate all responsibilities and requirements with power utility company and pay associated fees.
  Contact Information:
  Evergy
  Abby Brungardt
  TD Design IV
  (785) 508-2715
  Abby.Brungardt@evergy.com
- Coordinate final location of meter assemblies with utility company. Provide shop drawings of proposed equipment whether as specified or substituted to utility company for approval.
- All meter center components shall be NEMA 3R.
- All dimensions based on Square D equipment. It is the contractor's responsibility to verify the dimensions of substitute equipment.
- For each meter, provide a permanent brass, copper or aluminum tag identifying the apartment served. Tags shall be securely fastened to the meter base and be stamped with 1/8" letters, minimum.

Wichita-Sedgwick County
Metropolitan Area Building
and Construction Department

REVIEWED FOR CODE COMPLIANCE

CORRECTIONS OR COMMENTS MADE ON THESE DRAWINGS AND THIS DOCUMENT DURING THIS REVIEW DO NOT RELIEVE CONTRACTOR FROM COMPLIANCE WITH ALL REQUIREMENTS OF THE CODE OF THE MABCD, THE CITY OF WICHITA OR SEDGWICK COUNTY. THIS REVIEW IS ONLY FOR GENERAL CONFORMANCE OF THE CODE. THE CONTRACTOR IS RESPONSIBLE FOR CONFORMING AND CORRELATING ALL TECHNIQUES OF CONSTRUCTION. THIS APPROVAL IS SUBJECT TO PROVISIONS OF SECTION 107.4 OF THE 2012 INTERNATIONAL BUILDING CODE.

DATE: 02/19/25 BY: William Jerauld Jr

LST Consulting Engineers, PA
Manhattan, Kansas
785.587.8042

Wichita, Kansas
316.285.0696

www.LSTengineers.com
mail@LSTengineers.com
Project 24061

JonesGillamRenz
730 N. Ninth
Salina, KS 67401
785.827.0386
1881 Main Street, Suite 301
Kansas City, MO 64108
jgr@jgrarchitects.com

THE RESIDENCE AT HERATIGE WEST
NEW SENIOR LIVING FACILITY
ANDOVER, KANSAS

BRIAN PATRICK LIES
LICENSED
24155
KANSAS
PROFESSIONAL ENGINEER
2025.01.10
16:41:45-06'00'

REVISIONS:

DATE: 01-10-2025
JOB: 24-3379
SHEET NO.:

E6.2

COPYRIGHTED ©

Wichita-Sedgwick County
Metropolitan Area Building
and Construction Department

REVIEWED FOR CODE COMPLIANCE

CORRECTIONS OR COMMENTS MADE ON THESE DRAWINGS AND THIS DOCUMENT DURING THIS REVIEW DO NOT RELIEVE CONTRACTOR FROM COMPLIANCE WITH ALL REQUIREMENTS OF THE CODE OF THE MABCD, THE CITY OF WICHITA OR SEDGWICK COUNTY. THIS REVIEW IS ONLY FOR GENERAL CONFORMANCE OF THE CODE. THE CONTRACTOR IS RESPONSIBLE FOR CONFORMING AND CORRELATING ALL TECHNIQUES OF CONSTRUCTION. THIS APPROVAL IS SUBJECT TO PROVISIONS OF SECTION 107.4 OF THE 2012 INTERNATIONAL BUILDING CODE.

DATE: 02/19/25 BY: William Jerauld Jr

Designation: P2

Installed Location: Mech 201
Voltage: 208Y/120 3PH 4W-3Ph-4W
Mounting: Surface
Enclosure: NEMA 1

Bus Amps: 100
MCB Amps: MLO
Features & Modifications: -

SCCR/AIC: 22.0 kA
Mains FN/Note: -

Ckt	Description	Circuitry	Trip (A)	FN	A	B	C	FN	Trip (A)	Circuitry	Description	Ckt
P2:1	LTG - 2nd Floor Mech, Halls, Stairs	1/2"C,1#12,#12N,#12G	20		67...	54...			20	1/2"C,1#12,#12N,#12G	RCPT - Hall 202	P2:2
P2:3	LTG - Exterior Up/Dn Lights	1/2"C,1#12,#12N,#12G	20			19...	54...		20	1/2"C,1#12,#12N,#12G	RCPT - Hall 203	P2:4
P2:5	Exterior Lighting Controls	1/2"C,1#12,#12N,#12G	20				50...	10...	20	1/2"C,1#12,#12N,#12G	RCPT - Telecomm Backboard	P2:6
P2:7	Elevator Sump Pump Control Panel	1/2"C,1#12,#12N,#12G	20		36...	10...			20	1/2"C,1#12,#12N,#12G	RCPT - Telecomm Backboard	P2:8
P2:9	RCPT - Elevator Sump Pump	1/2"C,1#12,#12N,#12G	20			18...	20...		30	1/2"C,2#10,#10G	Blower Coil 'BC-1' - Second Floor Halls	P2:10
P2:11	Spare	--	20				0 VA	20...				P2:12
P2:13	Spare	--	20		0 VA	40...			50	3/4"C,2#6,#10G	Blower Coil 'BC-3' - First Floor Lobby	P2:14
P2:15	Space	--	--			--	40...					P2:16
P2:17	Space	--	--				--	--	--	--	Space	P2:18
P2:19	Space	--	--		--	--			--	--	Space	P2:20
P2:21	Space	--	--			--	--		--	--	Space	P2:22
P2:23	Space	--	--				--	--	--	--	Space	P2:24
				Connected Load:	6599 VA	7031 VA	3141 VA					
				Connected Amps:	59.4 A	63.0 A	26.2 A					

Designation: P3

Installed Location: Mech 301
Voltage: 208Y/120 3PH 4W-3Ph-4W
Mounting: Surface
Enclosure: NEMA 1

Bus Amps: 100
MCB Amps: MLO
Features & Modifications: -

SCCR/AIC: 22.0 kA
Mains FN/Note: -

Ckt	Description	Circuitry	Trip (A)	FN	A	B	C	FN	Trip (A)	Circuitry	Description	Ckt
P3:1	LTG - 3rd Floor Mech, Halls, Stairs	1/2"C,1#12,#12N,#12G	20		67...	54...			20	1/2"C,1#12,#12N,#12G	RCPT - Hall 302	P3:2
P3:3	Blower Coil 'BC-1' - Third Floor Halls	1/2"C,2#10,#10G	30			20...	54...		20	1/2"C,1#12,#12N,#12G	RCPT - Hall 303	P3:4
P3:5							20...	10...	20	1/2"C,1#12,#12N,#12G	RCPT - Telecomm Backboard	P3:6
P3:7	Spare	--	20		0 VA	10...			20	1/2"C,1#12,#12N,#12G	RCPT - Telecomm Backboard	P3:8
P3:9	Spare	--	20			0 VA	--		--	--	Space	P3:10
P3:11	Space	--	--				--	--	--	--	Space	P3:12
P3:13	Space	--	--		--	--			--	--	Space	P3:14
P3:15	Space	--	--			--	--		--	--	Space	P3:16
P3:17	Space	--	--				--	--	--	--	Space	P3:18
P3:19	Space	--	--		--	--			--	--	Space	P3:20
P3:21	Space	--	--			--	--		--	--	Space	P3:22
P3:23	Space	--	--				--	--	--	--	Space	P3:24
				Connected Load:	2214 VA	2631 VA	3091 VA					
				Connected Amps:	18.5 A	22.5 A	26.3 A					

Designation: P4

Installed Location: Mech 401
Voltage: 208Y/120 3PH 4W-3Ph-4W
Mounting: Surface
Enclosure: NEMA 1

Bus Amps: 100
MCB Amps: MLO
Features & Modifications: -

SCCR/AIC: 22.0 kA
Mains FN/Note: -

Ckt	Description	Circuitry	Trip (A)	FN	A	B	C	FN	Trip (A)	Circuitry	Description	Ckt
P4:1	LTG - 4th Floor Mech, Hall and Stairs	1/2"C,1#12,#12N,#12G	20		64...	18...			20	1/2"C,1#10,#10N,#10G	Electric Wall Heater - Hall 403	P4:2
P4:3	LTG - Elevator Hoistway	1/2"C,1#12,#12N,#12G	20			24...	54...		20	1/2"C,1#12,#12N,#12G	RCPT - Hall 402	P4:4
P4:5	LTG - Exterior Facade Lighting	1/2"C,1#12,#12N,#12G	20				93...	54...	20	1/2"C,1#12,#12N,#12G	RCPT - Hall 403	P4:6
P4:7	LTG - Roof Patio	1/2"C,1#12,#12N,#12G	20		22...	90...			20	1/2"C,1#12,#12N,#12G	RCPT - Rooftop	P4:8
P4:9	RCPT - Elevator Hoistway	1/2"C,1#12,#12N,#12G	20			18...	14...		20	1/2"C,1#10,#10N,#10G	Future Radon Fan	P4:10
P4:11	Other	1/2"C,1#12,#12N,#12G	20				36...	10...	20	1/2"C,1#12,#12N,#12G	Future Radon Fan	P4:12
P4:13	Heat Pump 'HP-2' - Fitness	1/2"C,2#12,#12G	20		12...	20...			30	1/2"C,2#10,#10G	Blower Coil 'BC-1A' - Fourth Floor Hall	P4:14
P4:15						12...	20...					P4:16
P4:17	Heat Pump 'HP-3' - Lobby/Office	1/2"C,2#10,#10G	30				17...	11...	20	1/2"C,2#10,#10G	Heat Pump 'HP-1' - North Stairs	P4:18
P4:19					17...	11...						P4:20
P4:21	Heat Pump 'HP-1' - First Floor Halls	1/2"C,2#12,#12G	20			11...	11...		20	1/2"C,2#12,#12G	Heat Pump 'HP-1' - South Stairs	P4:22
P4:23							11...	11...				P4:24
P4:25	Heat Pump 'HP-1' - Second Floor Halls	1/2"C,2#12,#12G	20		11...	0 VA			20	--	Spare	P4:26
P4:27						11...	0 VA		20	--	Spare	P4:28
P4:29	Heat Pump 'HP-1' - Third Floor Halls	1/2"C,2#12,#12G	20				11...	--	--	--	Space	P4:30
P4:31					11...	--			--	--	Space	P4:32
P4:33	Heat Pump 'HP-1' - Fourth Floor Halls	1/2"C,2#12,#12G	20			11...	--		--	--	Space	P4:34
P4:35							11...	--	--	--	Space	P4:36
P4:37	Space	--	--		--	--			--	--	Space	P4:38
P4:39	Space	--	--			--	--		--	--	Space	P4:40
P4:41	Space	--	--				--	--	--	--	Space	P4:42
				Connected Load:	12219 VA	10280 VA	9790 VA					
				Connected Amps:	102.5 A	86.3 A	81.6 A					

Panelboard: MDP

Location: Mech 201
Supply: Meter Center
Mounting: Surface
Enclosure: NEMA 1
Features & Modifications: -

Voltage: 208 V, 3 Ø, 4 W
Bus Rating: 400 A
Neutral: 100%
Mains Type: MLO
Mains Rating: 400 A
Mains FN/Note: -
SCCR: 22 kA

Ckt	Description	Frame (A)	Trip (A)	Poles	FN/Note	Load
MD...	P1	225	225	3		47172
MD...	P2	100	100	3		16771
MD...	P3	100	100	3		7935
MD...	P4	100	100	3		32289
MD...	Elevator	60	60	3		15500
MD...	100A Bussed Space	--	--	3		--

Load Summary

Load Classification	Connected	Factor	Demand	Panel Totals	
Motor	297 VA	110.00%	327 VA	**Connected Load:**	120 kVA
Other	4680 VA	100.00%	4680 VA	**Connected Current:**	332 A
Lighting - Interior	7247 VA	125.00%	9059 VA	**Demand Load:**	131 kVA
Receptacle - General	15960 VA	81.33%	12980 VA	**Demand Current:**	364 A
Receptacle - Dedicated	5800 VA	100.00%	5800 VA	**Non-Coincident...**	56.3 A
Electric Water Heating	2500 VA	125.00%	3125 VA	**Total Est. Demand - NC**	307.4 A
Electric Heat	47413 VA	125.00%	59266 VA		
Elevator	15500 VA	100.00%	15500 VA		
Cooling	20270 VA	100.00%	20270 VA		

Notes:
Provide with integral surge protection device per specifications.

Designation: P1

Installed Location: Leasing Office 102
Voltage: 208Y/120 3PH 4W-3Ph-4W
Mounting: Surface
Enclosure: NEMA 1

Bus Amps: 225
MCB Amps: MLO
Features & Modifications: -

SCCR/AIC: 22.0 kA
Mains FN/Note: -

Ckt	Description	Circuitry	Trip (A)	FN	A	B	C	FN	Trip (A)	Circuitry	Description	Ckt
P1:1	LTG - Community 101, Fitness 104, Hall 106	1/2"C,1#12,#12N,#12G	20		13...	72...			20	1/2"C,1#12,#12N,#12G	RCPT - Community Room and Hall	P1:2
P1:3	LTG - Hall 107	1/2"C,1#12,#12N,#12G	20			27...	36...		20	1/2"C,1#12,#12N,#12G	RCPT - Community Room 101 Island	P1:4
P1:5	LTG - Hall 108	1/2"C,1#12,#12N,#12G	20				39...	54...	20	1/2"C,1#12,#12N,#12G	RCPT - Community Room Bar	P1:6
P1:7	LTG - Exterior Canopy and Trellis	1/2"C,1#12,#12N,#12G	20		14...	80...			20	1/2"C,1#12,#12N,#12G	RCPT - Community Room Refrigerator	P1:8
P1:9	LTG - Parking Lot	3/4"C,2#8,#8G	20				13...	90...	20	1/2"C,1#12,#12N,#12G	RCPT - Office 102	P1:10
P1:11								13...	72...	20	1/2"C,1#12,#12N,#12G	RCPT - TLT 103, Hall 107	P1:12
P1:13	LTG - Monument Sign	3/4"C,1#10,#10N,#10G	20		22...	36...			20	1/2"C,1#12,#12N,#12G	RCPT - Hall 108	P1:14
P1:15	LTG - Elevator Pit	1/2"C,1#12,#12N,#12G	20			24...	18...		20	1/2"C,1#8,#8N,#8G	Electric Wall Heater 'EWH-1' - Hall 108	P1:16
P1:17	RCPT - Elevator Pit	1/2"C,1#12,#12N,#12G	20				18...	21...	30	1/2"C,2#8,#8G	Electric Wall Heater 'EWH-4' - Mech 109	P1:18
P1:19	RCPT - S. Fitness Equipment	1/2"C,1#12,#12N,#12G	20		10...	21...						P1:20
P1:21	RCPT - S. Fitness Equipment	1/2"C,1#12,#12N,#12G	20			10...						P1:22
P1:23	RCPT - S. Fitness Equipment	1/2"C,1#12,#12N,#12G	20				10...					P1:24
P1:25	RCPT - S. Fitness Equipment	1/2"C,1#12,#12N,#12G	20		10...	11...			20	1/2"C,1#12,#12N,#12G	Hot Water Recirculation Pump 'HWP'	P1:26
P1:27	RCPT - S. Fitness Equipment	1/2"C,1#12,#12N,#12G	20			10...	20...		30	1/2"C,2#10,#10G	Blower Coil 'BC-1' - First Floor Halls	P1:28
P1:29	RCPT - S. Fitness	1/2"C,1#12,#12N,#12G	20				36...	20...				P1:30
P1:31	RCPT - N. Fitness	1/2"C,1#12,#12N,#12G	20		54...	20...			30	1/2"C,2#10,#10G	Blower Coil 'BC-1' - Stairs 1	P1:32
P1:33	Electric Water Cooler - Fitness	1/2"C,1#12,#12N,#12G	20			80...	20...					P1:34
P1:35	Blower Coil 'BC-2' - Fitness	1/2"C,2#8,#10G	40				31...	12...	20	1/2"C,1#10,#10N,#10G	Exterior Receptacles	P1:36
P1:37					31...	72...			20	1/2"C,1#12,#12N,#12G	Mech/Stroage Receptacals	P1:38
P1:39	Blower Coil 'BC-1' - Stairs 2	1/2"C,2#8,#8G	30			20...	36...		L 20	1/2"C,1#12,#12N,#12G	Fire Sprinkler Switch Systems	P1:40
P1:41								20...	0 VA	20	--	Spare	P1:42
P1:43	FACP	1/2"C,1#12,#12N,#12G	20	L	36...	0 VA			20	--	Spare	P1:44
P1:45	Exterior Lighting Inverter	1/2"C,1#12,#12N,#12G	20			55...	0 VA		20	--	Spare	P1:46
P1:47	Door Access Control	1/2"C,1#12,#12N,#12G	20				36...	--	--	--	Space	P1:48
P1:49	Electric Water Heating	1/2"C,1#10,#10N,#10G	30		25...	--			--	--	Space	P1:50
P1:51	Space	--	--			--	--		--	--	Space	P1:52
P1:53	Space	--	--				--	--	--	--	Space	P1:54
				Connected Load:	17255 VA	14233 VA	15685 VA					
				Connected Amps:	145.7 A	118.6 A	132.6 A					

Breaker Function Schedule

A	Arc-Fault Interrupter (AFCI) Protection
AG	Combination Arc and Ground Fault Circuit Interrupter Protection
G	Ground-Fault Circuit Interrupter (GFCI) Protection (5 mA)
L	Provide breaker with lock-on clip

LST Consulting Engineers, PA
Manhattan, Kansas
785.587.8042

Wichita, Kansas
316.285.0696

www.LSTengineers.com
mail@LSTengineers.com
Project 24061

JonesGillamRenz
730 N. Ninth
Salina, KS 67401
785.827.0386
1881 Main Street, Suite 301
Kansas City, MO 64108
jgr@jgrarchitects.com

THE RESIDENCE AT HERATIGE WEST
NEW SENIOR LIVING FACILITY
ANDOVER, KANSAS

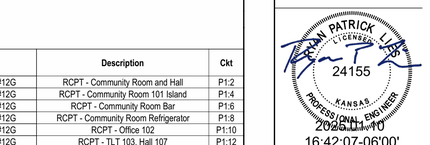

REVISIONS:

DATE: 01-10-2025
JOB: 24-3379
SHEET NO.:

E6.3

COPYRIGHTED ©

General Plan Symbols

- Plan Revision Number
- Detail Number on Sheet / Sheet Number Where Detail is Placed
- Keynote Symbol (#)
- Continuation Symbol
- Point Where New Connects To Existing
- Room 1 — Room Name / Number
- Area Being Demolished
- Area Not In Contract
- Electrical Equipment.
  Do not route HVAC installation above or below equipment.
  Maintain working clearance as indicated by dashed line.

Abbreviations

Ø	ROUND	LVR	LOUVER
ABV	ABOVE	LWT	LEAVING WATER TEMPERATURE
AC	AIR CONDITIONING	M/A	MIXED AIR
AD	AREA DRAIN	MAX	MAXIMUM
ADD	ADDENDUM	MBH	ONE THOUSAND BTU PER HOUR
AFF	ABOVE FINISHED FLOOR	MCF	ONE THOUSAND CUBIC FEET
AFUE	ANNUAL FUEL UTILIZATION EFFICIENCY	MD	MOTORIZED DAMPER
ALT	ALTERNATE	MECH	MECHANICAL
AP	ACCESS PANEL	MFR	MANUFACTURER
ARCH	ARCHITECT/ARCHITECTURAL	MIN	MINIMUM
BFF	BELOW FINISHED FLOOR	MISC	MISCELLANEOUS
BLW	BELOW	MTR	MOTOR
BTU	BRITISH THERMAL UNITS	MU/A	MAKE-UP/AIR
BTUH	BRITISH THERMAL UNITS PER HOUR	NC	NOISE CRITERIA
CAP	CAPACITY	NC	NORMALLY CLOSED
CB	CATCH BASIN	NIC	NOT IN CONTRACT
CFM	CUBIC FEET PER MINUTE	NO	NUMBER
CLG	CEILING	NO	NORMALLY OPEN
CO	CLEAN OUT	NTS	NOT TO SCALE
CW	COLD WATER	O	OXYGEN
D	DEGREE	O/A	OUTSIDE AIR
DB	DRY BULB	ORD	OVERFLOW ROOF DRAIN
DIA	DIAMETER	PD	PRESSURE DROP
DN	DOWN	PIV	POST INDICATOR VALVE
DW	DISTILLED WATER	PLBG	PLUMBING
EA	EACH	PRESS	PRESSURE
EAT	ENTERING AIR TEMPERATURE	PRV	PRESSURE REDUCING VALVE
ELEC	ELECTRICAL	PSI	POUNDS PER SQUARE INCH
EQUIP	EQUIPMENT	PSIG	POUNDS PER SQUARE INCH GAUGE
EWC	ELECTRIC WATER COOLER	PWR	POWER
EWT	ENTERING WATER TEMPERATURE	R	DUCT RISER
E/A	EXHAUST AIR	R/A	RETURN AIR
EXIST	EXISTING	RCP	RADIANT CEILING PANEL
F	DEGREES FAHRENHEIT	RD	ROOF DRAIN
FCO	FLOOR CLEAN OUT	REC	RECESSED
FD	FLOOR DRAIN	RED	REDUCER
FDC	FIRE DEPARTMENT CONNECTION	RH	RELATIVE HUMIDITY
FL	FLOOR	RL/A	RELIEF AIR
FO	FUEL OIL	RM	ROOM
FOV	FUEL OIL VENT	RPM	REVOLUTIONS PER MINUTE
FOR	FUEL OIL RETURN	RW	RAIN WATER
FOS	FUEL OIL SUPPLY	SF	SQUARE FOOT
FPM	FEET PER MINUTE	S/A	SUPPLY AIR
FS	FLOOR SINK	SAN	SANITARY
FT	FOOT/FEET	SF	SQUARE FOOT
FTR	FIN TUBE RADIATION	SD	SMOKE DAMPER
GAL	GALLON	SM	SURFACE MOUNT
GF	GAS-FIRED	SP	STANDPIPE
GC	GENERAL CONTRACTOR	SP	STATIC PRESSURE
GPM	GALLONS PER MINUTE	STM	STEAM
GW	GREASE WASTE	T	THERMOSTAT
HB	HOSE BIB	TD	TEMPERATURE DROP
HP	HORSE POWER	TDR	TRENCH DRAIN
HTG	HEATING	TEMP	TEMPERATURE
HTR	HEATER	TYP	TYPICAL
HW	HOT WATER	UG	UNDERGROUND
HYD	HYDRANT	VAC	VACUUM
ID	INDIRECT	V	VENT
IN	INCH	VAV	VARIABLE AIR VOLUME
INV	INVERT	VENT	VENTILATION
LB	POUND	VTR	VENT THROUGH ROOF
LB/HR	POUNDS PER HOUR	W	WASTE
LAT	LEAVING AIR TEMPERATURE	WB	WET BULB
LP	LOW PRESSURE	WCO	WALL CLEAN OUT
LPG	LIQUEFIED PETROLEUM GAS	WH	WALL HYDRANT

Equipment Abbreviations

AC	AIR CONDITIONING UNIT	ET	EXPANSION TANK
ACCU	AIR COOLING CONDENSING UNIT	EWH	ELECTRIC WATER HEATER
AHU	AIR HANDLING UNIT	FCU	FAN COIL UNIT
AS	AIR SEPARATOR	FP	FIRE PUMP
B	BOILER	GI	GREASE INTERCEPTOR
CH	CHILLER	GRV	GRAVITY ROOF VENTILATOR
CT	COOLING TOWER	HWP	HEATING WATER PUMP
CUH	CABINET UNIT HEATER	HRU	HEAT RECOVERY UNIT
CHWP	CHILLED WATER PUMP	PRV	POWER ROOF VENTILATOR
DBP	DOMESTIC WATER BOOSTER PUMP	RE	RETURN/EXHAUST FAN
DC	DUCT MOUNTED COIL	RTU	ROOFTOP UNIT
DCP	DOMESTIC WATER CIRCULATING PUMP	SP	SUMP PUMP
EF	EXHAUST FAN	UH	UNIT HEATER
EDC	ELECTRIC DUCT COIL	WH	WATER HEATER

* NOTE *
ALL OF GENERAL NOTES ON THIS SHEET ARE TO BE APPLIED TO ALL OTHER DRAWINGS IN THIS SET.THE SYMBOLS AND ABBREVIATIONS SHOWN ON THIS SHEET MAY OR MAY NOT BE USED IN THIS SET OF DRAWINGS.

HVAC Symbols

- 24"/12" — Sq. Duct Size (Width/Height)
- 24"x12"FO — Oval Duct Size (Width x Height)
- 18"Ø — Round Duct Size (Diameter)
- (E) — Existing Duct To Remain
- Duct To Be Demolished
- S/A — Supply Air
- V/A — Ventilation Air
- O/A — Outdoor Air
- R/A — Return Air
- T/A — Transfer Air
- E/A — General Exhaust Air
- KED — Kitchen Exhaust Duct
- FLUE — Flue Gas Vent
- C/A — Combustion Air
- Rect. Supply Duct Rise / Drop
- Round Supply Duct Rise / Drop
- Rect. Return Duct Rise / Drop
- Round Return Duct Rise / Drop
- Rect. Exhaust Duct Rise / Drop
- Round Exhaust Duct Rise / Drop

Grille, Register, Diffusers

- Square Ceiling Diffuser: CD- 500 / 10"Ø/24x24 — Type (See Schedule); Airflow; Neck Size / Module Size
- Round Ceiling Diffuser: CD11 100 / 6"Ø / TYP. X 4 — Type (See Schedule); Airflow; Neck Size; Type Count for Space
- Sidewall Supply Grille: SG5 300 / 18"/6" / AFF:0" — Type (See Schedule); Airflow; Nominal Duct Size; Mounting Elevation (Centerline)
- Linear Diffuser: SD- 200 / 8"Ø/2s/4'-0"L — Type (See Schedule); Airflow; Neck Size/ Slot(s)/ Active Length
- Sidewall Return Grille: RG6 200 / 12"/6"/--- / AFF:0" — Type (See Schedule); Airflow; Nominal Duct Size; Mounting Elevation (Centerline)
- Ceiling Return: CR2 200 / 8"Ø/24x24 — Type (See Schedule); Airflow; Neck Size / Module Size

Mechanical Equipment

- RTU-1 — Unit Identity
- (E)AHU-2 — Existing to Remain Equipment
- (R)AHU-3 — Existing Relocated Equipment
- Equipment By Others (Refer To Other Disciplines)

Mechanical Control Devices

- (T) Thermostat
- (H) Humidistat
- (TS) Temperature Sensor
- (HS) Humidity Sensor
- CO2 Carbon Dioxide Detector
- HZG Hazardous Gas Detector

Damper Types

- (B) Manual Damper
- (M) Motorized Damper
- Backdraft Damper
- Smoke Damper
- Fire Damper
- Comb. Fire/ Smoke Damper

HVAC SHEET INDEX

M1.1	HVAC PLANS
M1.2	HVAC PLANS
M4.1	ENLARGED HVAC PLANS
M4.2	ENLARGED HVAC PLANS
M6.1	HVAC SCHEDULES AND DETAILS
M0.1	HVAC TITLE SHEET

GENERAL HVAC NOTES

A. CONTRACTOR SHALL LOCATE THERMOSTATS AND HUMIDISTATS AT 4'-0" AFF UNLESS NOTED OTHERWISE. MAINTAIN A MINIMUM HORIZONTAL SEPARATION OF 8" FROM LIGHT SWITCHES.
B. CONDENSATE DRAINS SHALL BE SUPPLIED FOR ALL COOLING EQUIPMENT. CONTRACTOR SHALL ENSURE PROPER INSTALLATION AND DRAINAGE AS REQUIRED BY FEDERAL, STATE, AND LOCAL CODES. CONDENSATE PIPING SHALL BE TYPE "L" COPPER. WHERE INSTALLED ABOVE CEILINGS, CONDENSATE DRAIN PIPING SHALL BE INSULATED WITH MINIMUM 1/2" FIBERGLASS PIPE INSULATION WITH ALL SERVICE JACKET.
C. ALL SUPPLY, RETURN, AND EXHAUST DUCTWORK SHALL BE RATED FOR PRESSURE CLASS OF 2" W.G. UNLESS NOTED OTHERWISE.
D. COORDINATE THE EXACT LOCATION OF ALL CEILING DIFFUSERS, REGISTERS, AND GRILLES WITH LIGHTING.
E. PROVIDE DIFFUSERS AND REGISTERS WITH 4-WAY BLOW PATTERN UNLESS OTHERWISE NOTED.
F. HVAC EQUIPMENT SHALL NOT BE UTILIZED UNTIL ALL DUCT PRODUCING CONSTRUCTION ACTIVITY HAS BEEN COMPLETED. CONTRACTOR SHALL BE REQUIRED TO OBTAIN APPROVAL FROM OWNER PRIOR TO EQUIPMENT STARTUP, AND TO REPLACE FILTERS ON HVAC EQUIPMENT UPON FINAL COMPLETION.
G. LOCATIONS OF PIPING, DUCTWORK AND EQUIPMENT AS INDICATED ON THE DRAWINGS ARE APPROXIMATE AND SUBJECT TO MINOR ADJUSTMENTS IN THE FIELD. WORK SHALL BE COORDINATED WITH ALL OTHER TRADES TO AVOID INTERFERENCE IN THE FIELD.
H. FINAL PRODUCT SHALL BE A COMPLETE AND FUNCTIONING SYSTEM, AND SHALL CONFORM TO ALL REQUIREMENTS OF APPLICABLE FEDERAL, STATE, AND LOCAL CODES, INCLUDING BUT NOT LIMITED TO THE INTERNATIONAL BUILDING CODE AND INTERNATIONAL MECHANICAL CODE.
I. LOCATE EQUIPMENT REQUIRING ACCESS 2'-0" MAXIMUM ABOVE CEILING.
J. ALL ROOF MOUNTED EQUIPMENT SHALL BE A MINIMUM 10'-0" FROM EDGE OF ROOFS WITHOUT A 42" HIGH PARAPET OR GUARD RAIL. WHERE PROVIDING 10'-0" SEPARATION FROM ROOF EDGE IS NOT POSSIBLE, PROVIDE PERMANENT FALL ARREST ANCHORS COMPLIANT WITH ANSI/ASSP Z359.1. COORDINATE WITH GENERAL CONTRACTOR.
K. LOCATE DUCTWORK, PIPING AND MECHANICAL EQUIPMENT OUTSIDE OF THE NEC REQUIRED CLEAR SPACE ABOVE AND AROUND ELECTRICAL PANELS, TRANSFORMERS AND OTHER ELECTRICAL EQUIPMENT. COORDINATE WITH ELECTRICAL CONTRACTOR.
L. PENETRATIONS OF RATED ASSEMBLIES SHALL BE FIRE STOPPED. FIRE STOPPING SHALL BE U.L. LISTED. SEE ARCHITECTURAL DRAWINGS FOR LOCATIONS OF RATED ASSEMBLIES.
M. PROVIDE SLEEVES AND/OR OPENINGS TO RUN PIPES AND DUCTS THROUGH FOUNDATIONS, FLOORS, WALLS, AND ROOF.
N. MAINTAIN CLEAR ACCESS TO SERVICE EQUIPMENT AND OTHER ACCESSORIES REQUIRING SERVICE, VISUAL INSPECTION OR HAND OPERATION. WHERE INDICATED OR REQUIRED, PROVIDE ACCESS PANELS OF THE TYPE SELECTED TO SUIT MATERIALS IN WHICH INSTALLED.
O. TRANSITION FROM PIPING AND DUCTWORK SIZES SHOWN TO PROPERLY CONNECT TO MECHANICAL EQUIPMENT.
P. PIPE SIZES SHOWN SHALL BE CONTINUED IN THE DIRECTION OF FLOW UNTIL ANOTHER SIZE IS SHOWN.
Q. INSTALL ALL EQUIPMENT IN ACCORDANCE WITH THE RESPECTIVE MANUFACTURER'S WRITTEN INSTALLATION INSTRUCTIONS, AT A LEVEL OF QUALITY AND WORKMANSHIP CONSISTENT WITH THE SPECIFICATIONS.
R. INSTALL EXPOSED PIPING AND DUCTWORK AS HIGH AS PRACTICAL IN ROOMS WITHOUT CEILINGS.
S. PRIOR TO STARTING WORK, SUBMIT SHOP DRAWINGS FOR ALL MECHANICAL EQUIPMENT AND MATERIALS. SUBSTITUTE EQUIPMENT INSTALLED WITHOUT PRIOR APPROVAL SHALL BE SUBJECT TO REPLACEMENT AT CONTRACTOR'S EXPENSE.
T. CONTRACTOR SHALL OBTAIN AND PAY FOR ALL NECESSARY PERMITS AND SHALL ARRANGE FOR ALL INSPECTIONS AS REQUIRED.
U. PROVIDE ONE YEAR WARRANTY FOR ALL WORKMANSHIP AND MATERIALS AFTER THE DATE OF FINAL ACCEPTANCE.

Wichita-Sedgwick County
Metropolitan Area Building
and Construction Department

REVIEWED FOR CODE COMPLIANCE

CORRECTIONS OR COMMENTS MADE ON THESE DRAWINGS AND THIS DOCUMENT DURING THIS REVIEW DO NOT RELIEVE CONTRACTOR FROM COMPLIANCE WITH ALL REQUIREMENTS OF THE CODE OF THE MABCD, THE CITY OF WICHITA OR SEDGWICK COUNTY. THIS REVIEW IS ONLY FOR GENERAL CONFORMANCE OF THE CODE. THE CONTRACTOR IS RESPONSIBLE FOR CONFORMING AND CORRELATING ALL TECHNIQUES OF CONSTRUCTION. THIS APPROVAL IS SUBJECT TO PROVISIONS OF SECTION 107.4 OF THE 2012 INTERNATIONAL BUILDING CODE.

DATE: 02/19/25 BY: William Jerauld Jr

LST Consulting Engineers, PA
Manhattan, Kansas
785.587.8042

Wichita, Kansas
316.285.0696

www.LSTengineers.com
mail@LSTengineers.com

Project 24061

JonesGillamRenz
730 N. Ninth
Salina, KS 67401
785.827.0386
1881 Main Street, Suite 301
Kansas City, MO 64108
jgr@jgrarchitects.com

THE RESIDENCE AT HERATIGE WEST
NEW SENIOR LIVING FACILITY
ANDOVER, KANSAS

RYAN PATRICK LIES
LICENSED
24155
KANSAS
PROFESSIONAL ENGINEER
2025.01.10
16:42:22-06'00'

REVISIONS:

DATE: 01-10-2025
JOB: 24-3379
SHEET NO.:

M0.1

COPYRIGHTED ©

PROJECT SHALL COMPLY WITH ALL REQUIREMENTS OF THE 2018 IECC. REFERENCE SPECIFICATIONS FOR COMMISSIONING REQUIREMENTS

Wichita-Sedgwick County
Metropolitan Area Building
and Construction Department

REVIEWED FOR CODE COMPLIANCE

CORRECTIONS OR COMMENTS MADE ON THESE DRAWINGS AND THIS DOCUMENT DURING THIS REVIEW DO NOT RELIEVE CONTRACTOR FROM COMPLIANCE WITH ALL REQUIREMENTS OF THE CODE OF THE MABCD, THE CITY OF WICHITA OR SEDGWICK COUNTY. THIS REVIEW IS ONLY FOR GENERAL CONFORMANCE OF THE CODE. THE CONTRACTOR IS RESPONSIBLE FOR CONFORMING AND CORRELATING ALL TECHNIQUES OF CONSTRUCTION. THIS APPROVAL IS SUBJECT TO PROVISIONS OF SECTION 107.4 OF THE 2012 INTERNATIONAL BUILDING CODE.

DATE: 02/19/25 BY: William Jerauld Jr

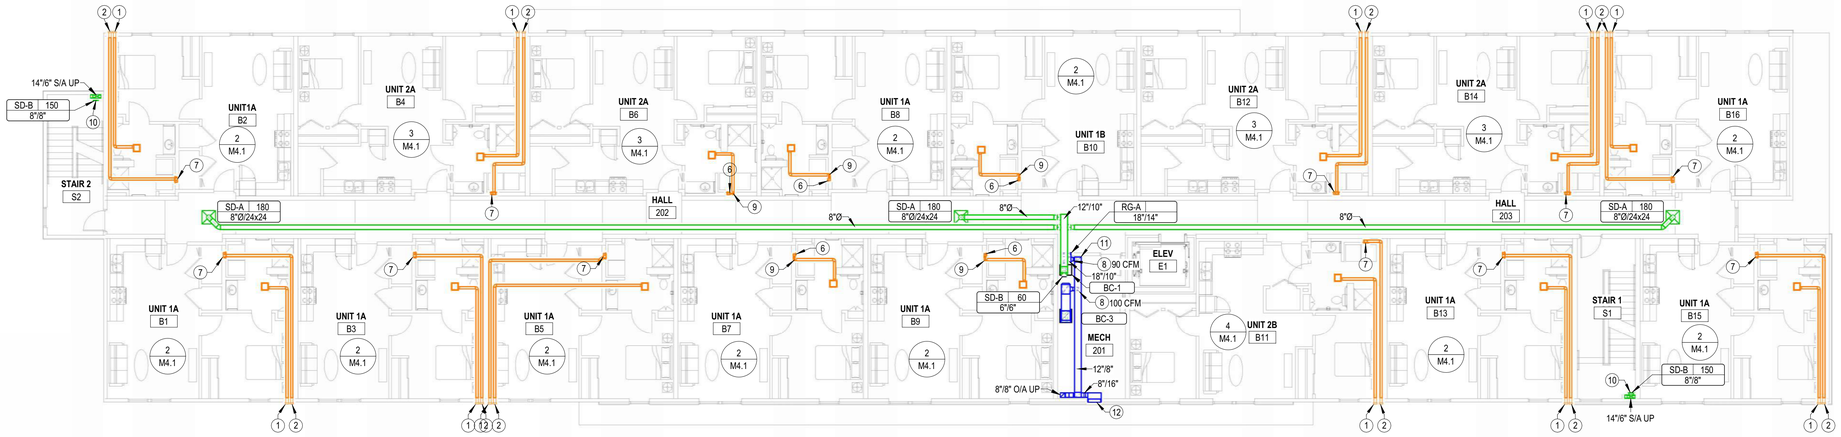

2 M1.1 SECOND FLOOR HVAC PLAN
3/32" = 1'-0"
0 8' 16' 24'

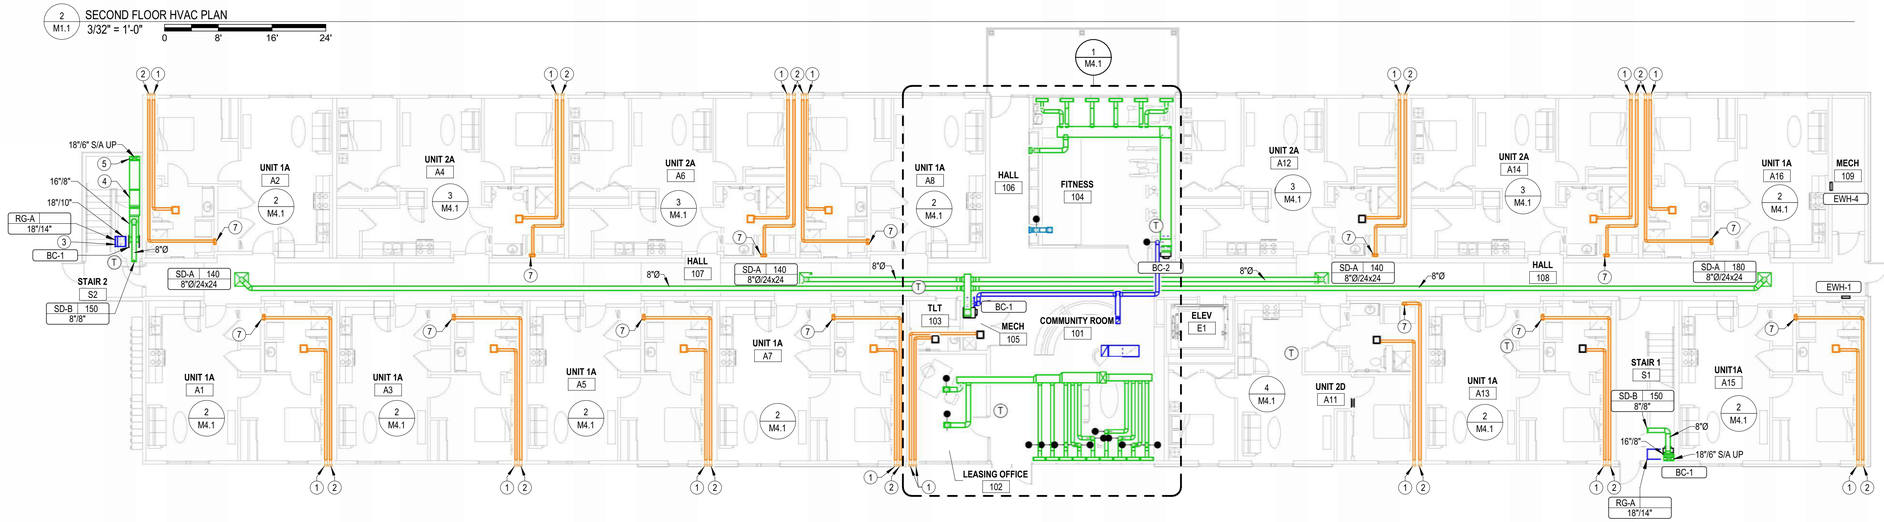

1 M1.1 FIRST FLOOR HVAC PLAN
3/32" = 1'-0"
0 8' 16' 24'

NOTES BY SYMBOL

1. ROUTE 4"Ø EXHAUST DUCT TO MANUFACTURER'S WALL CAP WITH BACKDRAFT DAMPER AND BIRD SCREEN, COORDINATE FINAL LOCATION WITH ARCHITECT.
2. 4"Ø DRYER DUCT. SEE ENLARGED PLANS FOR MORE INFORMATION. COORDINATE FINAL LOCATION OF WALL CAP WITH ARCHITECT.
3. MOUNT RETURN GRILLE HIGH IN WALL, TRANSITION DOWN TO CONNECT TO BOTTOM OF BLOWER COIL.
4. TRANSITION DUCT DOWN AS REQUIRED TO ROUTE BELOW STAIR LANDING.
5. ROUTE DUCT UP THROUGH STAIR LANDING IN CHASE, COORDINATE WITH ARCHITECT.
6. PROVIDE UL LISTED DRYER BOX EQUAL TO IN-O-VATE TECHNOLOGIES IN WALL INSTALLED IN ACCORDANCE WITH MANUFACTURER'S RECOMMENDATIONS, AND ROUTE 4"Ø DRYER EXHAUST DUCT TO ROOF JACK WITH BACKDRAFT DAMPER. SEE OVERALL MECHANICAL PLANS FOR UNIT SPECIFIC ROUTING. MAXIMUM ALLOWABLE EQUIVALENT DUCT LENGTH = 35'. UTILIZE LONG RADIUS SMOOTH ELBOWS WHERE REQUIRED. MAXIMUM EQUIVALENT DUCT LENGTH MAY BE INCREASED WHERE DRYER MANUFACTURER'S INSTALLATION INSTRUCTIONS ALLOW, AND DOCUMENTATION IS PROVIDED TO CODE OFFICIAL PRIOR TO CONCEALMENT INSPECTION. COORDINATE EXACT REQUIREMENTS WITH EQUIPMENT PROVIDED. PROVIDE PERMANENT LABEL IDENTIFYING EQUIVALENT LENGTH OF DRYER DUCT INSTALLED PER IMC 504.

   NOTE: ANNULAR SPACE AROUND DUCT IS TO BE SEALED AT ALL PENETRATIONS OF FLOORS AND CEILINGS WITH U.L. LISTED FIRE STOPPING SYSTEM.
7. PROVIDE UL LISTED DRYER BOX EQUAL TO IN-O-VATE TECHNOLOGIES IN WALL INSTALLED IN ACCORDANCE WITH MANUFACTURER'S RECOMMENDATIONS, AND ROUTE 4"Ø DRYER EXHAUST DUCT TO WALL CAP WITH BACKDRAFT DAMPER. SEE OVERALL MECHANICAL PLANS FOR UNIT SPECIFIC ROUTING. MAXIMUM ALLOWABLE EQUIVALENT DUCT LENGTH = 35'. UTILIZE LONG RADIUS SMOOTH ELBOWS WHERE REQUIRED. MAXIMUM EQUIVALENT DUCT LENGTH MAY BE INCREASED WHERE DRYER MANUFACTURER'S INSTALLATION INSTRUCTIONS ALLOW, AND DOCUMENTATION IS PROVIDED TO CODE OFFICIAL PRIOR TO CONCEALMENT INSPECTION. COORDINATE EXACT REQUIREMENTS WITH EQUIPMENT PROVIDED. PROVIDE PERMANENT LABEL IDENTIFYING EQUIVALENT LENGTH OF DRYER DUCT INSTALLED PER IMC 504.

   NOTE: ANNULAR SPACE AROUND DUCT IS TO BE SEALED AT ALL PENETRATIONS OF FLOORS AND CEILINGS WITH U.L. LISTED FIRE STOPPING SYSTEM.
8. PROVIDE BALANCING DAMPER AND CONNECT OUTDOOR AIR DUCT TO RETURN DUCTWORK AT BLOWER COIL AND BALANCE TO AIRFLOW LISTED ON PLANS.
9. ROUTE 4" EXHAUST UP IN WALL TO ROOF. DUCTS SHALL BE RUN IN WALLS CONTINUOUS FROM EXHAUST FAN TO EXTERIOR OF BUILDING WITHOUT BEING COMBINED. COORDINATE EXACT ROUTING AND WALL LOCATIONS WITH G.C.
10. MOUNT SUPPLY DIFFUSER 7'-0" ABOVE LANDING.
11. TRANSITION OUTDOOR AIR DUCT TO 8"x8" AFTER 'BC-1' TAP. ROUTE DUCT DOWN TO ABOVE FIRST FLOOR CEILING, SEE 1:M4.1 FOR CONTINUATION.
12. PROVIDE 24"x18" OUTDOOR AIR WALL LOUVER EQUAL TO GREENHECK ESJ-602 WITH BIRD SCREEN AND BACKDRAFT DAMPER. PROVIDE FULL SIZE CONNECTION AND TRANSITION TO DUCT AS SHOWN ON PLANS. INSTALL TOP OF LOUVER INLINE WITH ADJACENT WINDOWS. COORDINATE LOUVER FINISH WITH ARCHITECT.

LST Consulting Engineers, PA
Manhattan, Kansas
785.587.8042

Wichita, Kansas
316.285.0696

www.LSTengineers.com
mail@LSTengineers.com

Project 24061

JonesGillamRenz
730 N. Ninth 1881 Main Street, Suite 301
Salina, KS 67401 Kansas City, MO 64108
785.827.0386 jgr@jgrarchitects.com

THE RESIDENCE AT HERATIGE WEST

NEW SENIOR LIVING FACILITY

ANDOVER, KANSAS

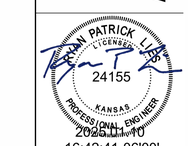

REVISIONS:

DATE: 01-10-2025
JOB: 24-3379
SHEET NO.:

M1.1

© COPYRIGHTED

PROJECT SHALL COMPLY WITH ALL REQUIREMENTS OF THE 2018 IECC. REFERENCE SPECIFICATIONS FOR COMMISSIONING REQUIREMENTS

Wichita-Sedgwick County
Metropolitan Area Building
and Construction Department

REVIEWED FOR CODE COMPLIANCE

CORRECTIONS OR COMMENTS MADE ON THESE DRAWINGS AND THIS DOCUMENT DURING THIS REVIEW DO NOT RELIEVE CONTRACTOR FROM COMPLIANCE WITH ALL REQUIREMENTS OF THE CODE OF THE MABCD, THE CITY OF WICHITA OR SEDGWICK COUNTY. THIS REVIEW IS ONLY FOR GENERAL CONFORMANCE OF THE CODE. THE CONTRACTOR IS RESPONSIBLE FOR CONFORMING AND CORRELATING ALL TECHNIQUES OF CONSTRUCTION. THIS APPROVAL IS SUBJECT TO PROVISIONS OF SECTION 107.4 OF THE 2012 INTERNATIONAL BUILDING CODE.

DATE: 02/19/25 BY: William Jerauld Jr

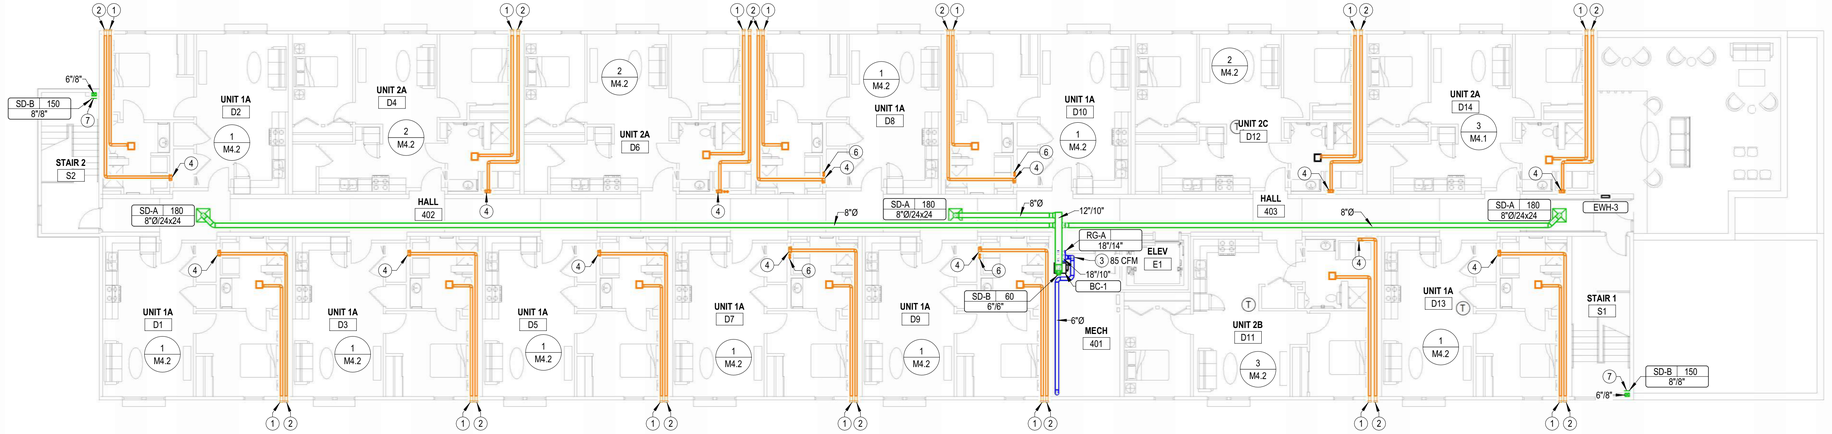

2 M1.2 FOURTH FLOOR HVAC PLAN
3/32" = 1'-0"
0 8' 16' 24'

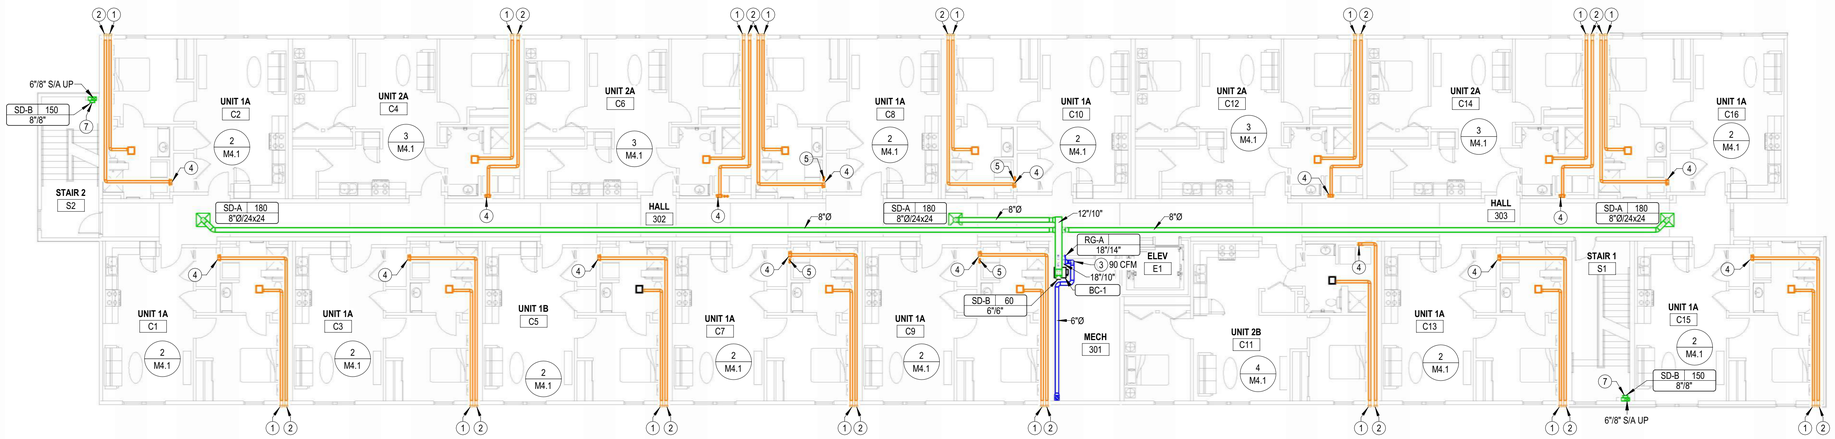

1 M1.2 THIRD FLOOR HVAC PLAN
3/32" = 1'-0"
0 8' 16' 24'

NOTES BY SYMBOL

1. ROUTE 4"Ø EXHAUST DUCT TO MANUFACTURER'S WALL CAP WITH BACKDRAFT DAMPER AND BIRD SCREEN, COORDINATE FINAL LOCATION WITH ARCHITECT.
2. 4"Ø DRYER DUCT. SEE ENLARGED PLANS FOR MORE INFORMATION. COORDINATE FINAL LOCATION OF WALL CAP WITH ARCHITECT.
3. PROVIDE BALANCING DAMPER AND CONNECT OUTDOOR AIR DUCT TO RETURN DUCTWORK AT BLOWER COIL AND BALANCE TO AIRFLOW LISTED ON PLANS.
4. PROVIDE UL LISTED DRYER BOX EQUAL TO IN-O-VATE TECHNOLOGIES IN WALL INSTALLED IN ACCORDANCE WITH MANUFACTURER'S RECOMMENDATIONS, AND ROUTE 4"Ø DRYER EXHAUST DUCT TO WALL CAP WITH BACKDRAFT DAMPER. SEE OVERALL MECHANICAL PLANS FOR UNIT SPECIFIC ROUTING. MAXIMUM ALLOWABLE EQUIVALENT DUCT LENGTH = 35'. UTILIZE LONG RADIUS SMOOTH ELBOWS WHERE REQUIRED. MAXIMUM EQUIVALENT DUCT LENGTH MAY BE INCREASED WHERE DRYER MANUFACTURER'S INSTALLATION INSTRUCTIONS ALLOW, AND DOCUMENTATION IS PROVIDED TO CODE OFFICIAL PRIOR TO CONCEALMENT INSPECTION. COORDINATE EXACT REQUIREMENTS WITH EQUIPMENT PROVIDED. PROVIDE PERMANENT LABEL IDENTIFYING EQUIVALENT LENGTH OF DRYER DUCT INSTALLED PER IMC 504.

   NOTE: ANNULAR SPACE AROUND DUCT IS TO BE SEALED AT ALL PENETRATIONS OF FLOORS AND CEILINGS WITH U.L. LISTED FIRE STOPPING SYSTEM.
5. EXHAUST DUCT UP FROM SECOND FLOOR TO ROOF. SEE 2/M1.2 FOR CONTINUATION.
6. SEE M/E1.2 FOR CONTINUATION.
7. MOUNT SUPPLY DIFFUSER 7'-0" ABOVE LANDING.

LST Consulting Engineers, PA
Manhattan, Kansas
785.587.8042

Wichita, Kansas
316.285.0696

www.LSTengineers.com
mail@LSTengineers.com
Project 24061

JonesGillamRenz
730 N. Ninth 1881 Main Street, Suite 301
Salina, KS 67401 Kansas City, MO 64108
785.827.0386 jgr@jgrarchitects.com

THE RESIDENCE AT HERATIGE WEST

NEW SENIOR LIVING FACILITY

ANDOVER, KANSAS

RYAN PATRICK LIPP LICENSED 24155 KANSAS PROFESSIONAL ENGINEER
2025.01.10 16:42:58-06'00'

REVISIONS:

DATE: 01-10-2025
JOB: 24-3379
SHEET NO.:

M1.2

COPYRIGHTED ©

PROJECT SHALL COMPLY WITH ALL REQUIREMENTS OF THE 2018 IECC. REFERENCE SPECIFICATIONS FOR COMMISSIONING REQUIREMENTS

Wichita-Sedgwick County
Metropolitan Area Building
and Construction Department

REVIEWED FOR CODE COMPLIANCE

CORRECTIONS OR COMMENTS MADE ON THESE DRAWINGS AND THIS DOCUMENT DURING THIS REVIEW DO NOT RELIEVE CONTRACTOR FROM COMPLIANCE WITH ALL REQUIREMENTS OF THE CODE OF THE MABCD, THE CITY OF WICHITA OR SEDGWICK COUNTY. THIS REVIEW IS ONLY FOR GENERAL CONFORMANCE OF THE CODE. THE CONTRACTOR IS RESPONSIBLE FOR CONFORMING AND CORRELATING ALL TECHNIQUES OF CONSTRUCTION. THIS APPROVAL IS SUBJECT TO PROVISIONS OF SECTION 107.4 OF THE 2012 INTERNATIONAL BUILDING CODE.

DATE: 02/19/25 BY: William Jerauld Jr

NOTES BY SYMBOL

1	ROUTE REFRIGERANT PIPING FROM BLOWER COIL TO HEAT PUMP. CONCEAL PIPING IN WALLS AND ABOVE CEILINGS. SEE ME1.2 FOR HEAT PUMP LOCATIONS.
2	SEE M1.1 AND M1.2 FOR DRYER EXHAUST DUCT ROUTING.
3	PROVIDE AUXILIARY DRAIN PAN BELOW BLOWER COIL, AND PIPE OVERFLOW DRAIN TO FLOOR DRAIN.
4	SEE M1.1 AND M1.2 FOR BATHROOM EXHAUST DUCT ROUTING.
5	PROVIDE ALL SUPPLY AIR PENETRATIONS OF CEILING WITH U.L. LISTED RADIATION DAMPER, GREENHECK CRD OR EQUIVALENT.
6	MOUNT TRANSFER GRILLE IN BEDROOM 6" BELOW CEILING AND MOUNT TRANSFER GRILLE ON OPPOSITE SIDE OF WALL 6" ABOVE FINISHED FLOOR. LINE STUD CAVITY WITH SHEET METAL.
7	RECIRCULATING RANGE HOOD BY OTHERS.
8	ROUTE 4"Ø EXHAUST DUCT TO MANUFACTURER'S WALL CAP WITH BACKDRAFT DAMPER AND BIRD SCREEN, COORDINATE FINAL LOCATION WITH ARCHITECT.
9	PROVIDE BALANCING DAMPER AND CONNECT OUTDOOR AIR DUCT TO RETURN DUCTWORK AT BLOWER COIL AND BALANCE TO AIRFLOW LISTED ON PLANS.
10	SEE ME1.2 FOR CONTINUATION.
11	TRANSITION FROM BLOWER COIL TO 20"x8" SUPPLY DUCT. PROVIDE MITERED ELBOW AND TRANSITION TO FLAT OVAL PRIOR TO ENTERING FITNESS ROOM. ROUTE DUCT BETWEEN CEILING AND SUSPENDED CLOUD, COORDINATE WITH EXACT REQUIREMENTS WITH ARCHITECT AND G.C.
12	PROVIDE THERMOSTAT WITH HUMIDITY CONTROL.
13	SET EXHAUST FAN TO 30 CFM.

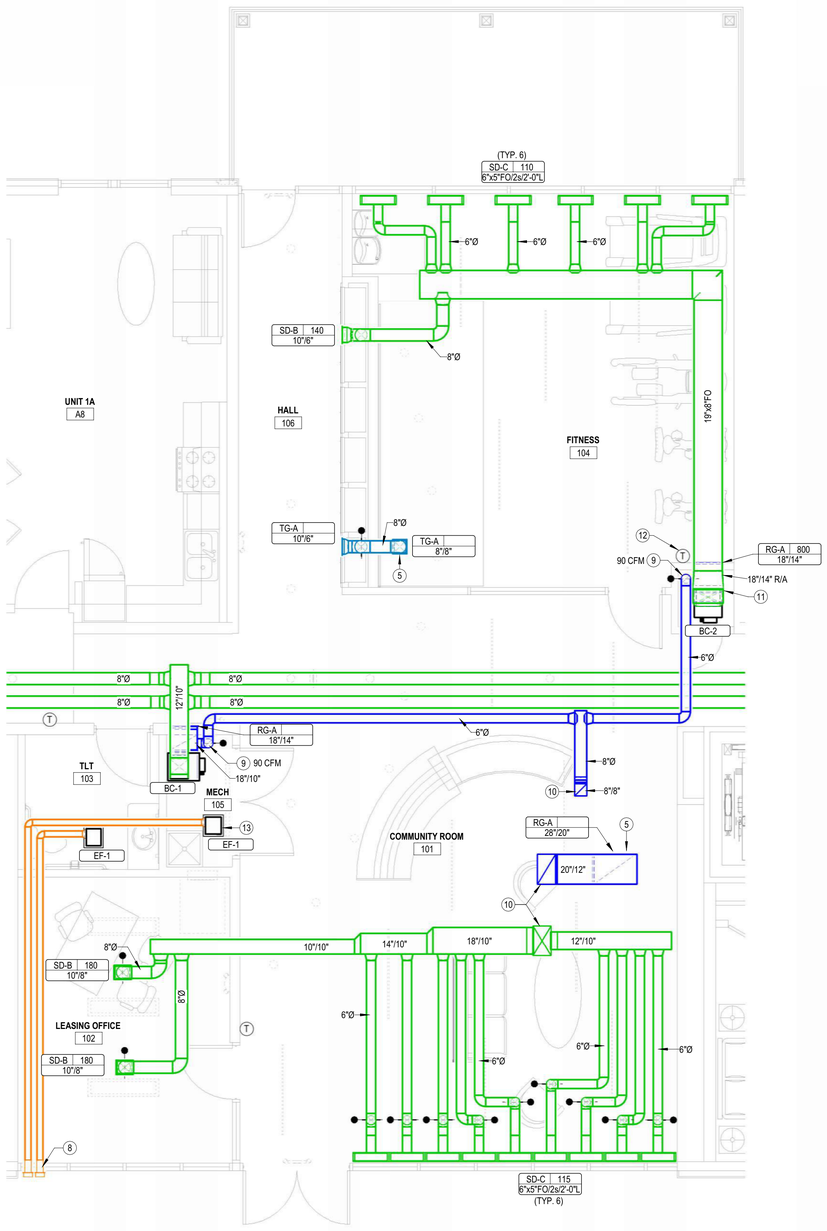

1 M4.1 COMMON SPACE ENLARGED HVAC PLAN
1/4" = 1'-0"
0 2' 4' 8'

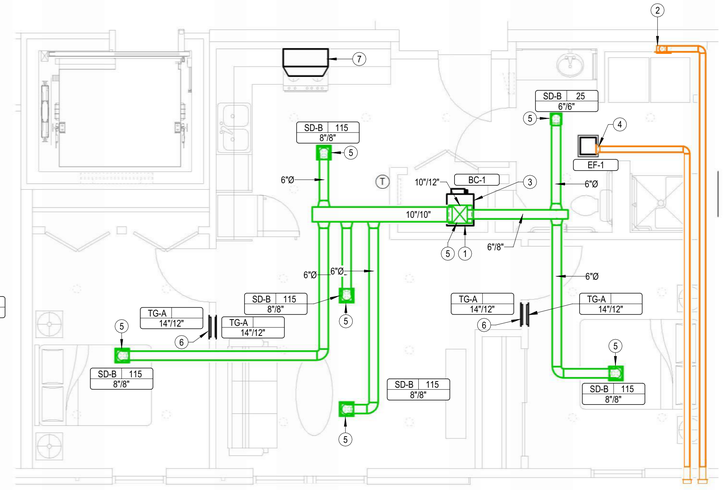

4 M4.1 2 BEDROOM (UNITS 2B/2D) ENLARGED HVAC PLAN
1/4" = 1'-0"
0 2' 4' 8'

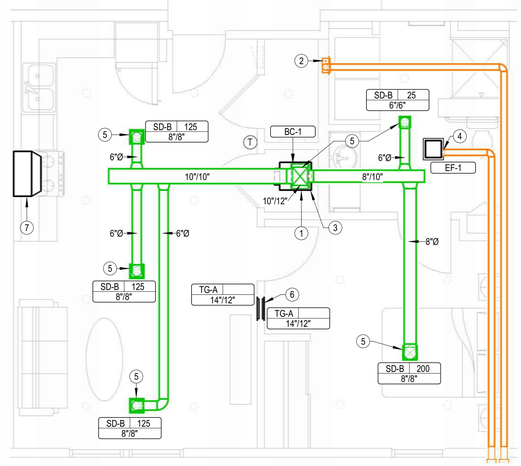

2 M4.1 1 BEDROOM (UNITS 1A/1B) ENLARGED HVAC PLAN
1/4" = 1'-0"
0 2' 4' 8'

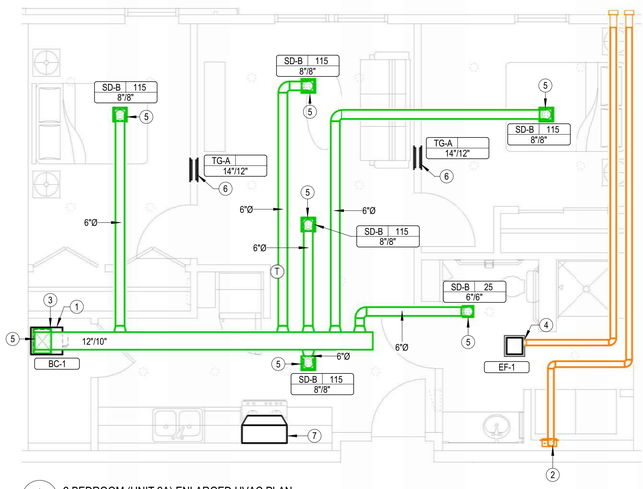

3 M4.1 2 BEDROOM (UNIT 2A) ENLARGED HVAC PLAN
1/4" = 1'-0"
0 2' 4' 8'

LST Consulting Engineers, PA
Manhattan, Kansas
785.587.8042

Wichita, Kansas
316.285.0696

www.LSTengineers.com
mail@LSTengineers.com
Project 24061

JonesGillamRenz
730 N. Ninth
Salina, KS 67401
1881 Main Street, Suite 301
Kansas City, MO 64108
785.827.0386
jgr@jgrarchitects.com

THE RESIDENCE AT HERATIGE WEST

NEW SENIOR LIVING FACILITY

ANDOVER, KANSAS

BRIAN PATRICK LIEB
LICENSED
24155
KANSAS
PROFESSIONAL ENGINEER
2025.01.10 16:43:16-06'00'

REVISIONS:

DATE: 01-10-2025
JOB: 24-3379
SHEET NO.:

M4.1

© COPYRIGHTED

PROJECT SHALL COMPLY WITH ALL REQUIREMENTS OF THE 2018 IECC. REFERENCE SPECIFICATIONS FOR COMMISSIONING REQUIREMENTS

Wichita-Sedgwick County
Metropolitan Area Building
and Construction Department

REVIEWED FOR CODE COMPLIANCE

CORRECTIONS OR COMMENTS MADE ON THESE DRAWINGS AND THIS DOCUMENT DURING THIS REVIEW DO NOT RELIEVE CONTRACTOR FROM COMPLIANCE WITH ALL REQUIREMENTS OF THE CODE OF THE MABCD, THE CITY OF WICHITA OR SEDGWICK COUNTY. THIS REVIEW IS ONLY FOR GENERAL CONFORMANCE OF THE CODE. THE CONTRACTOR IS RESPONSIBLE FOR CONFORMING AND CORRELATING ALL TECHNIQUES OF CONSTRUCTION. THIS APPROVAL IS SUBJECT TO PROVISIONS OF SECTION 107.4 OF THE 2012 INTERNATIONAL BUILDING CODE.

DATE: 02/19/25 BY: William Jerauld Jr

NOTES BY SYMBOL

1. ROUTE REFRIGERANT PIPING FROM BLOWER COIL TO HEAT PUMP. CONCEAL PIPING IN WALLS AND ABOVE CEILINGS. SEE ME1.2 FOR HEAT PUMP LOCATIONS.
2. SEE M1.1 AND M1.2 FOR DRYER EXHAUST DUCT ROUTING.
3. PROVIDE AUXILIARY DRAIN PAN BELOW BLOWER COIL, AND PIPE OVERFLOW DRAIN TO FLOOR DRAIN.
4. SEE M1.1 AND M1.2 FOR BATHROOM EXHAUST DUCT ROUTING.
5. PROVIDE ALL SUPPLY AIR PENETRATIONS OF CEILING WITH U.L. LISTED RADIATION DAMPER, GREENHECK CRD OR EQUIVALENT.
6. MOUNT TRANSFER GRILLE IN BEDROOM 6" BELOW CEILING AND MOUNT TRANSFER GRILLE ON OPPOSITE SIDE OF WALL 6" ABOVE FINISHED FLOOR. LINE STUD CAVITY WITH SHEET METAL.
7. RECIRCULATING RANGE HOOD BY OTHERS.

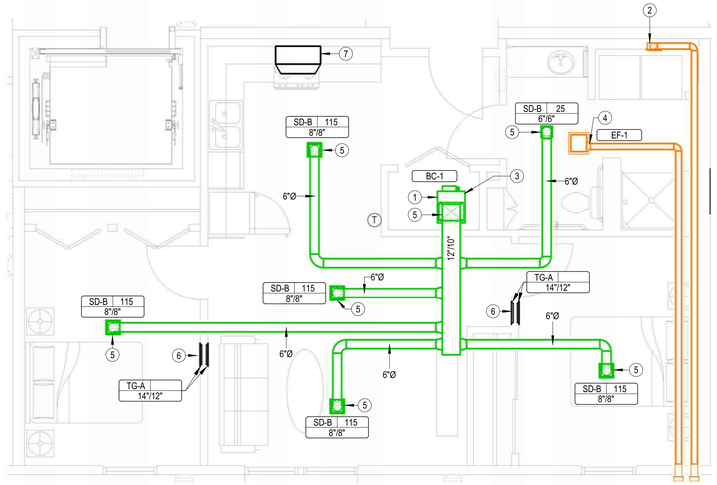

3 M4.2 2 BEDROOM (UNIT 2B) ENLARGED HVAC PLAN - FOURTH FLOOR
1/4" = 1'-0"
0 2' 4' 8'

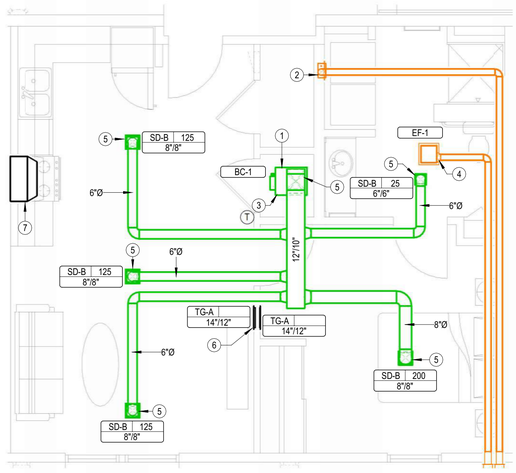

1 M4.2 1 BEDROOM (UNIT 1A) ENLARGED HVAC PLAN - FOURTH FLOOR
1/4" = 1'-0"
0 2' 4' 8'

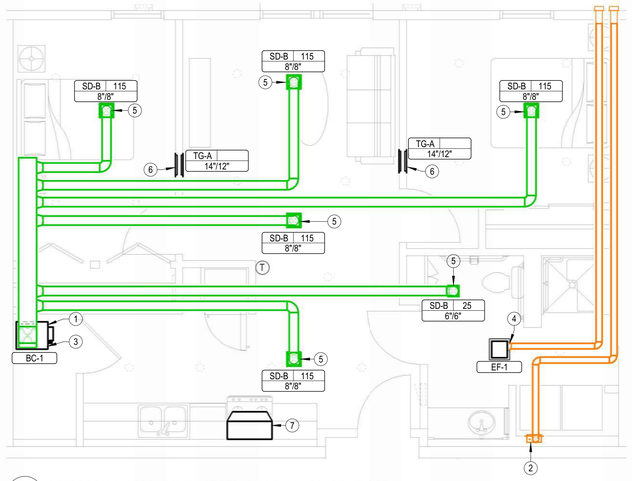

2 M4.2 2 BEDROOM (UNITS 2A/2C) ENLARGED HVAC PLAN - FOURTH FLOOR
1/4" = 1'-0"
0 2' 4' 8'

LST Consulting Engineers, PA
Manhattan, Kansas
785.587.8042

Wichita, Kansas
316.285.0696

www.LSTengineers.com
mail@LSTengineers.com
Project 24061

JonesGillamRenz
730 N. Ninth
Salina, KS 67401
1881 Main Street, Suite 301
Kansas City, MO 64108
785.827.0386
jgr@jgrarchitects.com

THE RESIDENCE AT HERATIGE WEST

NEW SENIOR LIVING FACILITY

ANDOVER, KANSAS

RYAN PATRICK LIEB LICENSED 24155 KANSAS PROFESSIONAL ENGINEER
2025.01.10 16:43:34-06'00'

REVISIONS:

DATE: 01-10-2025
JOB: 24-3379
SHEET NO.:

M4.2

COPYRIGHTED ©

Wichita-Sedgwick County
Metropolitan Area Building
and Construction Department

REVIEWED FOR CODE COMPLIANCE

CORRECTIONS OR COMMENTS MADE ON THESE DRAWINGS AND THIS DOCUMENT DURING THIS REVIEW DO NOT RELIEVE CONTRACTOR FROM COMPLIANCE WITH ALL REQUIREMENTS OF THE CODE OF THE MARCH, THE CITY OF WICHITA OR SEDGWICK COUNTY. THIS REVIEW IS ONLY FOR GENERAL CONFORMANCE OF THE CODE. THE CONTRACTOR IS RESPONSIBLE FOR CONFORMING AND CORRELATING ALL TECHNIQUES OF CONSTRUCTION. THIS APPROVAL IS SUBJECT TO PROVISIONS OF SECTION 107.4 OF THE 2012 INTERNATIONAL BUILDING CODE.

DATE: 02/19/25 BY: William Jerauld Jr

Grilles, Registers & Diffusers Schedule

ID Type	Manufacturer	Model	Application				Mounting	Include Damper	Product Specification
			Supply	Return	Exhaust	Transfer			
RG-A	Titus	355RL		■			Surface Mount	No	Steel louvered return grille
SD-A	Titus	TMS	■				Lay-In Full Face	No	24"x24" steel square louvered diffuser, neck size as indicated on drawings
SD-B	Titus	300R	■				Surface Mount	Yes	Steel double deflection supply grille with front blades parallel to long dimension
SD-C	Titus	TBD-10	■				Lay-In Full Face	No	2' Low profile slot diffuser with (2) 1.5" slots
TG-A	Titus	355RL				■	Surface Mount	No	Steel louvered return grille

NOTES:
- Maximum noise criteria shall be 25.
- Runouts to diffusers shall be same size as neck, U.N.O.
- Paint objects visible through grilles with flat black paint.
- Provide mounting frame as required for ceiling type. Coordinate with Architect.
- Verify finish with Architect.
- Provide devices with radiation dampers as required in rated ceilings. Coordinate with Architect.

Heat Pump Schedule

Identity	Manufacturer	Model	Nominal Capacity	Cooling Capacity						Heating Capacity				Electrical			
				EDB	EDB	EWB	Net Sensible Capacity	Rated Cooling Capacity	SEER2 Rating	OA EDB	EDB	Rated Heating Capacity	HSPF2 Rating	Phase	MCA	MOCP	Voltage
HP-1	Trane	4TWR4018	1.5 ton	105 °F	78 °F	67 °F	13,300 Btu/h	17,800 Btu/h	14.3	47 °F	70 °F	16,500 Btu/h	7.5	1	15.0 A	25.0 A	208 V
HP-2	Trane	4TWR4024	2.0 ton	105 °F	78 °F	67 °F	15,700 Btu/h	22,200 Btu/h	14.3	47 °F	70 °F	22,800 Btu/h	7.5	1	15.0 A	25.0 A	208 V
HP-3	Trane	4TWR4042	3.5 ton	105 °F	78 °F	67 °F	27,100 Btu/h	37,100 Btu/h	14.3	47 °F	70 °F	40,000 Btu/h	7.5	1	24.0 A	40.0 A	208 V

NOTES:
1. Refrigerant lines shall be field fabricated. Coordinate line sizing requirements with equipment manufacturer for length.
2. Provide 7-day programmable thermostat.

Blower Coil Schedule

Identity	Manufacturer	Model	Fan			Heating	Electrical		MCA	MOCP
			Airflow	ESP	Speed		Voltage	Phase		
BC-1	Trane	TEM4A0B31	600 CFM	0.50 in-wg	LOW	3.6 kW	208 V	1	25.1 A	25.0 A
BC-2	Trane	TEM4A0B31	800 CFM	0.50 in-wg	MEDIUM	5.8 kW	208 V	1	38.1 A	40.0 A
BC-3	Trane	TEM4A0C43	1,220 CFM	0.50 in-wg	MED-HIGH	7.2 kW	208 V	1	48.4 A	50.0 A

NOTES:
1. Single point connection required, coordinate the exact electrical requirements of equipment provided with E.C.
2. Electrical heater shall not operate simultaneously with heat pump. Electric heater shall be used as back-up heat only.
3. Povide downflow units with condensate overflow switch.

Electric Cabinet Heater Schedule

Mark	Manufacturer	Model	Mounting	Watts	Voltage	Phase	Description	Notes
EWH-1	Berko	FRC	Wall	1.5 kW	120 V	1	Architectural fan forced wall heater.	1,2,3
EWH-3	Berko	FRC	Wall	1.5 kW	120 V	1	Architectural fan forced wall heater.	1,2,3
EWH-4	Berko	FRC	Wall	4.0 kW	208 V	1	Architectural fan forced wall heater.	1,2,3

NOTES:
1. Provide with high temperature thermal cutout and fan delay.
2. Provide with integral thermostat and unit mounted disconnect switch.
3. Provide with manufacturer's surface mounting adapter sleeve. Coordinate exact mounting requirements and locations with Architect and rated construction.

Exhaust Fan Schedule

Mark	Manufacturer	Model	CFM	ESP	Power	Electrical		Notes
						Voltage	Phase	
EF-1	Panasonic	FV-0810VSS1	50 CFM	0.45 in-wg	21 W	120 V	1	1,2,3,4,5,6

NOTES:
1. Fixture shall be Energy Star listed.
2. Fixture shall operate at < 1 SONE.
3. Provide with EC motor with integral disconnect.
4. Provide manufacturer's wall cap or roof jack, see plans.
5. Provide integral backdraft damper.
6. Provide with manufacturer's ceiling radiation damper. Omit radiation dampers where rated ceilings are not present, coordinate with Architect.

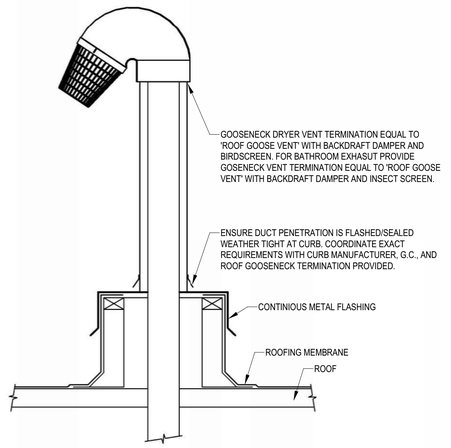

4 M6.1 GOOSENECK DUCT THROUGH ROOF DETAIL
NO SCALE

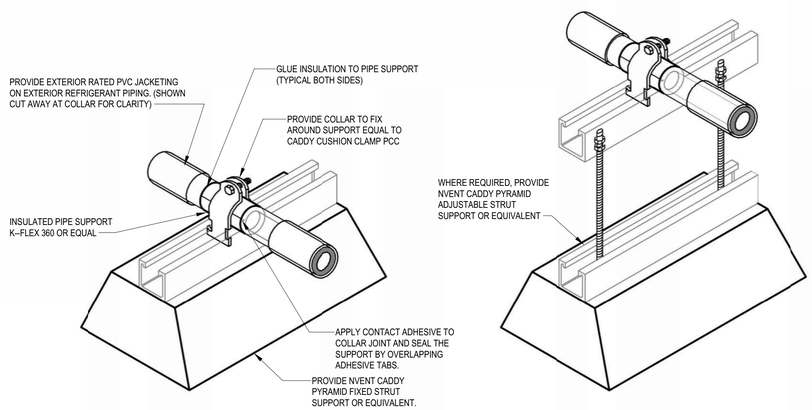

3 M6.1 REFRIGERANT ROOF AND EXTERIOR SUPPORT DETAIL
NO SCALE

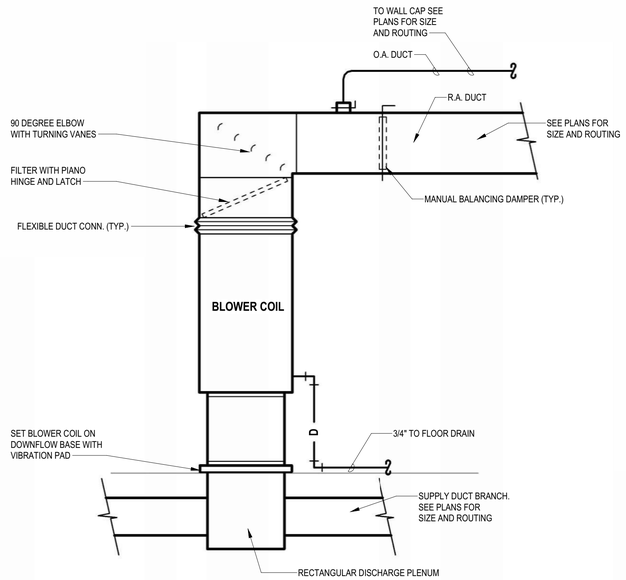

2 M6.1 DOWNFLOW BLOWER COIL DETAIL
NO SCALE

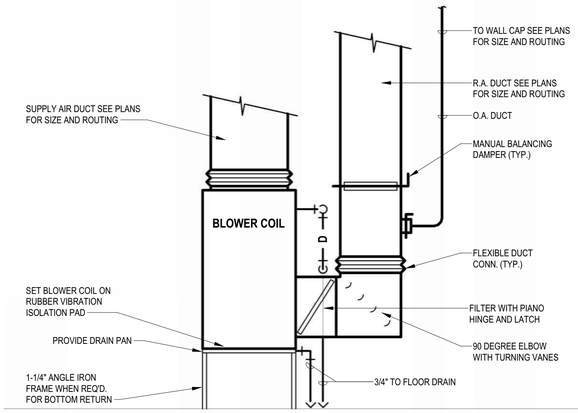

1 M6.1 UP FLOW BLOWER COIL DETAIL
NO SCALE

LST Consulting Engineers, PA
Manhattan, Kansas
785.587.8042

Wichita, Kansas
316.285.0696

www.LSTengineers.com
mail@LSTengineers.com

Project 24061

JonesGillamRenz
730 N. Ninth
Salina, KS 67401
785.827.0386
1881 Main Street, Suite 301
Kansas City, MO 64108
jgr@jgrarchitects.com

THE RESIDENCE AT HERATIGE WEST

NEW SENIOR LIVING FACILITY

ANDOVER, KANSAS

RYAN PATRICK LIPP LICENSED 24155 KANSAS PROFESSIONAL ENGINEER
2025.01.10 16:43:52-06'00'

REVISIONS:

DATE: 01-10-2025
JOB: 24-3379
SHEET NO.:

M6.1

COPYRIGHTED ©

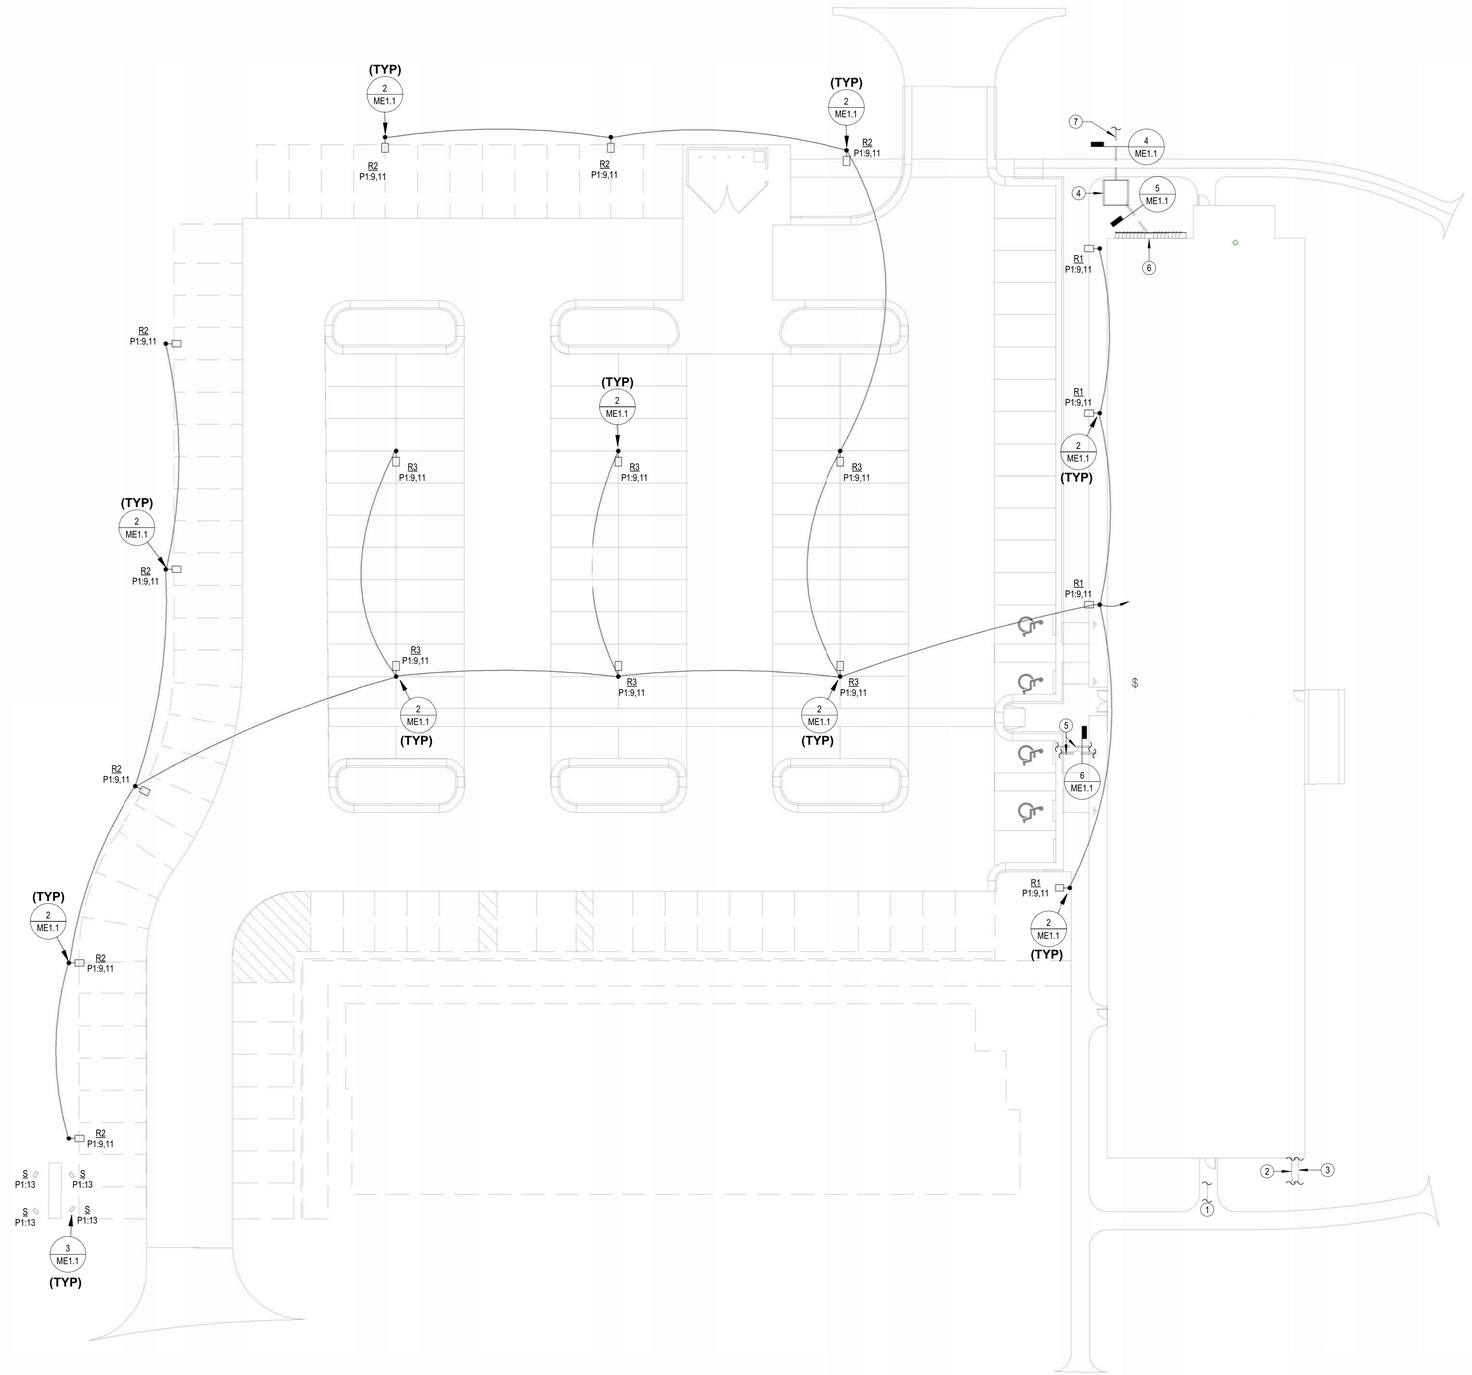

1 ME1.1 MECHANICAL AND ELECTRICAL SITE PLAN
1" = 20'-0"
0 10' 20' 40'

Wichita-Sedgwick County
Metropolitan Area Building
and Construction Department

REVIEWED FOR CODE COMPLIANCE

CORRECTIONS OR COMMENTS MADE ON THESE DRAWINGS AND THIS DOCUMENT DURING THIS REVIEW DO NOT RELIEVE CONTRACTOR FROM COMPLIANCE WITH ALL REQUIREMENTS OF THE CODE OF THE MABCD, THE CITY OF WICHITA OR SEDGWICK COUNTY. THIS REVIEW IS ONLY FOR GENERAL CONFORMANCE OF THE CODE. THE CONTRACTOR IS RESPONSIBLE FOR CONFORMING AND CORRELATING ALL TECHNIQUES OF CONSTRUCTION. THIS APPROVAL IS SUBJECT TO PROVISIONS OF SECTION 107.4 OF THE 2012 INTERNATIONAL BUILDING CODE.

DATE: 02/19/25 BY: William Jerauld Jr

NOTES BY SYMBOL

1. SANITARY SEWER, SEE CIVIL DRAWINGS FOR CONTINUATION.
2. DOMESTIC WATER SERVICE, SEE CIVIL DRAWINGS FOR CONTINUATION.
3. FIRE SUPPRESSION SERVICE, SEE CIVIL DRAWINGS FOR CONTINUATION.
4. POWER COMPANY PAD MOUNT TRANSFORMER. PROVIDE CONCRETE PAD PER EVERGY SERVICE STANDARDS. COORDINATE EXACT LOCATION AND REQUIREMENTS WITH EVERGY PRIOR TO STARTING WORK.
5. PROVIDE (2) 4" CONDUITS FOR COMMUNICATIONS SERVICES. PROVIDE PULL STRING IN EACH RACEWAY. VERIFY TERMINATION POINTS AT PROPERTY LINE WITH LOCAL COMMUNICATIONS SERVICE PROVIDERS.
6. ELECTRIC SERVICE EQUIPMENT, SEE RISER DIAGRAM ON SHEET E6.2.
7. UTILIZE EVERGY APPROVED TRENCHING CONTRACTOR TO ALLOW CONDUCTOR IN DUCT FOR PRIMARY CABLING. COORDINATE REQUIREMENTS WITH UTILITY.

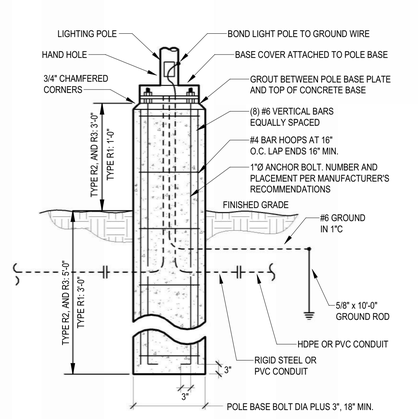

2 ME1.1 LIGHT POLE BASE DETAIL
NO SCALE

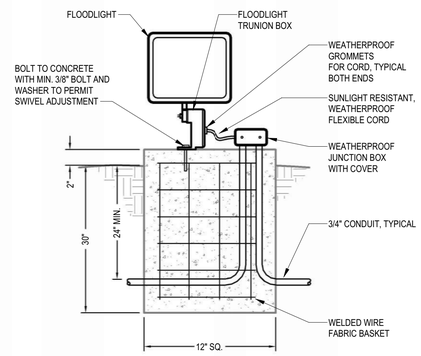

3 ME1.1 GROUND LIGHT DETAIL
NO SCALE

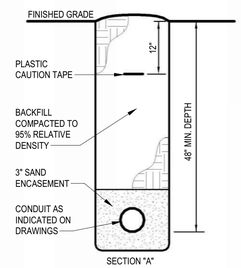

4 ME1.1 PRIMARY CONDUIT SECTION
NO SCALE

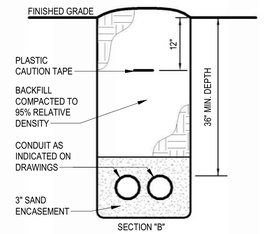

5 ME1.1 SERVICE LATERAL CONDUIT SECTION
NO SCALE

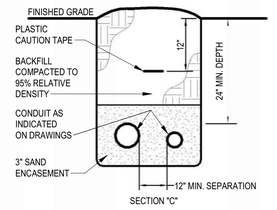

6 ME1.1 TELECOM CONDUIT SECTION
NO SCALE

LST Consulting Engineers, PA
Manhattan, Kansas
785.587.8042

Wichita, Kansas
316.285.0696

www.LSTengineers.com
mail@LSTengineers.com
Project 24061

JonesGillamRenz
730 N. Ninth
Salina, KS 67401
785.827.0386
1881 Main Street, Suite 301
Kansas City, MO 64108
jgr@jgrarchitects.com

THE RESIDENCE AT HERATIGE WEST
NEW SENIOR LIVING FACILITY
ANDOVER, KANSAS

JONATHAN PATRICK LYNCH
LICENSED
24155
KANSAS
PROFESSIONAL ENGINEER
2025.01.10 16:44:07-06'00'

REVISIONS:

DATE: 01-10-2025
JOB: 24-3379
SHEET NO.:

ME1.1

© COPYRIGHTED

Wichita-Sedgwick County
Metropolitan Area Building
and Construction Department

REVIEWED FOR CODE COMPLIANCE

CORRECTIONS OR COMMENTS MADE ON THESE DRAWINGS AND THIS DOCUMENT DURING THIS REVIEW DO NOT RELIEVE CONTRACTOR FROM COMPLIANCE WITH ALL REQUIREMENTS OF THE CODE OF THE MABCD, THE CITY OF WICHITA OR SEDGWICK COUNTY. THIS REVIEW IS ONLY FOR GENERAL CONFORMANCE OF THE CODE. THE CONTRACTOR IS RESPONSIBLE FOR CONFORMING AND CORRELATING ALL TECHNIQUES OF CONSTRUCTION. THIS APPROVAL IS SUBJECT TO PROVISIONS OF SECTION 107.4 OF THE 2012 INTERNATIONAL BUILDING CODE.

DATE: 02/19/25 BY: William Jerauld Jr

NOTES BY SYMBOL

1. ALL HEAT PUMPS, UNLESS NOTED OTHERWISE, ARE "HP-1" AND CORRESPOND TO MATCHING BLOWER COIL FOR UNIT AS TAGGED. TYPICAL
2. MOUNT HEAT PUMP TO UNISTRUT FRAME SUPPORTED ON NVENT CADDY PYRAMID ROOF SUPPORTS. PROVIDE VIBRATION ISOLATOR BETWEEN ROOF SUPPORTS AND UNISTRUT FRAME. COORDINATE INSTALLATION WITH ROOFING CONTRACTOR. TYPICAL.
3. 3" PLUMBING VENT THROUGH ROOF.
4. UNLESS NOTED OTHERWISE, PROVIDE 30A/2-POLE, NON-FUSED DISCONNECT SWITCH IN NEMA 3R ENCLOSURE AND MAKE FINAL CONNECTION TO EQUIPMENT IN LFMC RACEWAY. MOUNT TO UNISTRUT FRAME SUPPORTED FROM EQUIPMENT SUPPORT RAILS. TAG SHOWN INDICATES PANEL OF ORIGIN FOR UNIT BEING SERVED.
5. PROVIDE 60A/2-POLE, NON-FUSED DISCONNECT SWITCH IN NEMA 3R ENCLOSURE AND MAKE FINAL CONNECTION TO EQUIPMENT IN LFMC RACEWAY. MOUNT TO UNISTRUT FRAME SUPPORTED FROM EQUIPMENT SUPPORT RAILS.
6. ROUTE REFRIGERANT PIPING DOWN THROUGH ROOF TO MATCHING BLOWER COIL. PROVIDE PIPING PENETRATION ASSEMBLY EQUAL TO RPH AW SERIES ROOF VAULT WITH EXIT SEALS FOR REFRIGERANT PIPING AND ELECTRICAL CONDUIT AND TWO ADDITIONAL SPARE EXIT SEALS. SUBMIT PRODUCT DATA FOR REVIEW PRIOR TO INSTALLATION.
7. INSTALL WEATHERPROOF JUNCTION BOX ON ROOF FOR FUTURE RADON FAN. PROVIDE ADEQUATE LENGTH OF CONDUCTOR FOR CONNECTION TO FUTURE RECEPTACLE.
8. MOUNT RECEPTACLE TO UNISTRUT FRAME SUPPORTED FROM CONDENSING UNIT UNISTRUT FRAME.
9. PROVIDE PIPE CURB EQUAL TO PATE AT DUCT PENETRATIONS OF ROOF. COORDINATE REQUIREMENTS WITH G.C. DO NOT USE PITCH POCKETS. TERMINATE WITH GOOSENECK, SEE DETAIL X.M6.X FOR MORE INFORMATION.

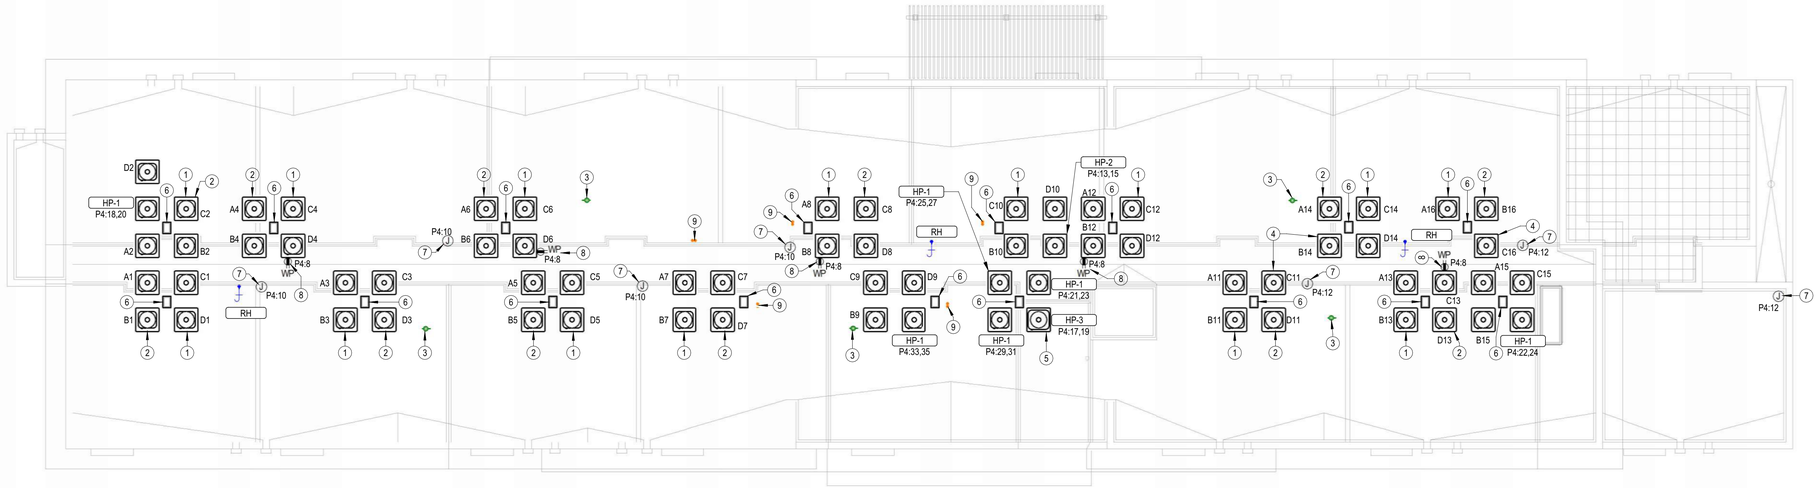

1 / ME1.2 HVAC Plan - R
3/32" = 1'-0"
0 8' 16' 24'

LST Consulting Engineers, PA
Manhattan, Kansas
785.587.8042

Wichita, Kansas
316.285.0696

www.LSTengineers.com
mail@LSTengineers.com
Project 24061

JonesGillamRenz
730 N. Ninth 1881 Main Street, Suite 301
Salina, KS 67401 Kansas City, MO 64108
785.827.0386 jgr@jgrarchitects.com

THE RESIDENCE AT HERATIGE WEST

NEW SENIOR LIVING FACILITY

ANDOVER, KANSAS

RYAN PATRICK LIEB
LICENSED
24155
KANSAS
PROFESSIONAL ENGINEER
2025.01.10 16:44:28-06'00'

REVISIONS:

DATE: 01-10-2025
JOB: 24-3379
SHEET NO.:

ME1.2

© COPYRIGHTED

General Plan Symbols

- Plan Revision Number
- Detail Number on Sheet / Sheet Number Where Detail is Placed
- Keynote Symbol
- Continuation Symbol
- Point Where New Connects To Existing
- Room Name / Number (Room 1)
- Area Being Demolished
- Area Not In Contract
- Electrical Equipment. Do not route HVAC installation above or below equipment. Maintain working clearance as indicated by dashed line.

Abbreviations

Ø	ROUND	LVR	LOUVER
ABV	ABOVE	LWT	LEAVING WATER TEMPERATURE
AC	AIR CONDITIONING	M/A	MIXED AIR
AD	AREA DRAIN	MAX	MAXIMUM
ADD	ADDENDUM	MBH	ONE THOUSAND BTU PER HOUR
AFF	ABOVE FINISHED FLOOR	MCF	ONE THOUSAND CUBIC FEET
AFUE	ANNUAL FUEL UTILIZATION EFFICIENCY	MD	MOTORIZED DAMPER
ALT	ALTERNATE	MECH	MECHANICAL
AP	ACCESS PANEL	MFR	MANUFACTURER
ARCH	ARCHITECT/ARCHITECTURAL	MIN	MINIMUM
BFF	BELOW FINISHED FLOOR	MISC	MISCELLANEOUS
BLW	BELOW	MTR	MOTOR
BTU	BRITISH THERMAL UNITS	MU/A	MAKE-UP/AIR
BTUH	BRITISH THERMAL UNITS PER HOUR	NC	NOISE CRITERIA
CAP	CAPACITY	NC	NORMALLY CLOSED
CB	CATCH BASIN	NIC	NOT IN CONTRACT
CFM	CUBIC FEET PER MINUTE	NO	NUMBER
CLG	CEILING	NO	NORMALLY OPEN
CO	CLEAN OUT	NTS	NOT TO SCALE
CW	COLD WATER	O	OXYGEN
D	DEGREE	O/A	OUTSIDE AIR
DB	DRY BULB	ORD	OVERFLOW ROOF DRAIN
DIA	DIAMETER	PD	PRESSURE DROP
DN	DOWN	PIV	POST INDICATOR VALVE
DW	DISTILLED WATER	PLBG	PLUMBING
EA	EACH	PRESS	PRESSURE
EAT	ENTERING AIR TEMPERATURE	PRV	PRESSURE REDUCING VALVE
ELEC	ELECTRICAL	PSI	POUNDS PER SQUARE INCH
EQUIP	EQUIPMENT	PSIG	POUNDS PER SQUARE INCH GAUGE
EWC	ELECTRIC WATER COOLER	PWR	POWER
EWT	ENTERING WATER TEMPERATURE	R	DUCT RISER
E/A	EXHAUST AIR	R/A	RETURN AIR
EXIST	EXISTING	RCP	RADIANT CEILING PANEL
F	DEGREES FAHRENHEIT	RD	ROOF DRAIN
FCO	FLOOR CLEAN OUT	REC	RECESSED
FD	FLOOR DRAIN	RED	REDUCER
FDC	FIRE DEPARTMENT CONNECTION	RH	RELATIVE HUMIDITY
FL	FLOOR	RL/A	RELIEF AIR
FO	FUEL OIL	RM	ROOM
FOV	FUEL OIL VENT	RPM	REVOLUTIONS PER MINUTE
FOR	FUEL OIL RETURN	RW	RAIN WATER
FOS	FUEL OIL SUPPLY	SF	SQUARE FOOT
FPM	FEET PER MINUTE	S/A	SUPPLY AIR
FS	FLOOR SINK	SAN	SANITARY
FT	FOOT/FEET	SF	SQUARE FOOT
FTR	FIN TUBE RADIATION	SD	SMOKE DAMPER
GAL	GALLON	SM	SURFACE MOUNT
GF	GAS-FIRED	SP	STANDPIPE
GC	GENERAL CONTRACTOR	SP	STATIC PRESSURE
GPM	GALLONS PER MINUTE	STM	STEAM
GW	GREASE WASTE	T	THERMOSTAT
HB	HOSE BIB	TD	TEMPERATURE DROP
HP	HORSE POWER	TDR	TRENCH DRAIN
HTG	HEATING	TEMP	TEMPERATURE
HTR	HEATER	TYP	TYPICAL
HW	HOT WATER	UG	UNDERGROUND
HYD	HYDRANT	VAC	VACUUM
ID	INDIRECT	V	VENT
IN	INCH	VAV	VARIABLE AIR VOLUME
INV	INVERT	VENT	VENTILATION
LB	POUND	VTR	VENT THROUGH ROOF
LB/HR	POUNDS PER HOUR	W	WASTE
LAT	LEAVING AIR TEMPERATURE	WB	WET BULB
LP	LOW PRESSURE	WCO	WALL CLEAN OUT
LPG	LIQUEFIED PETROLEUM GAS	WH	WALL HYDRANT

Equipment Abbreviations

AC	AIR CONDITIONING UNIT	ET	EXPANSION TANK
ACCU	AIR COOLING CONDENSING UNIT	EWH	ELECTRIC WATER HEATER
AHU	AIR HANDLING UNIT	FCU	FAN COIL UNIT
AS	AIR SEPARATOR	FP	FIRE PUMP
B	BOILER	GI	GREASE INTERCEPTOR
CH	CHILLER	GRV	GRAVITY ROOF VENTILATOR
CT	COOLING TOWER	HWP	HEATING WATER PUMP
CUH	CABINET UNIT HEATER	HRU	HEAT RECOVERY UNIT
CHWP	CHILLED WATER PUMP	PRV	POWER ROOF VENTILATOR
DBP	DOMESTIC WATER BOOSTER PUMP	RE	RETURN/EXHAUST FAN
DC	DUCT MOUNTED COIL	RTU	ROOFTOP UNIT
DCP	DOMESTIC WATER CIRCULATING PUMP	SP	SUMP PUMP
EF	EXHAUST FAN	UH	UNIT HEATER
EDC	ELECTRIC DUCT COIL	WH	WATER HEATER

*** NOTE ***

ALL OF GENERAL NOTES ON THIS SHEET ARE TO BE APPLIED TO ALL OTHER DRAWINGS IN THIS SET.THE SYMBOLS AND ABBREVIATIONS SHOWN ON THIS SHEET MAY OR MAY NOT BE USED IN THIS SET OF DRAWINGS.

Plumbing Symbols

- 2" — Nominal Pipe Size
- Above Ground Piping
- Below Ground Piping
- 1/8" / 12" SLOPE — Pipe Slope (When Applicable)
- (E) — Existing Pipe To Remain
- Pipe To Be Demolished
- CW — Domestic Cold-Water
- NPW — Non-Potable Water
- S-CW — Soft Cold-Water
- F-CW — Filtered Cold-Water
- RO — Reverse Osmosis Water
- HW — Domestic Hot-Water
- HW 140° — Domestic Hot-Water 140°
- HW-R — Hot-Water Recirculation
- HW-R 140° — Hot-Water Recirculation 140°
- SS — Sanitary Drain
- V — Sanitary Vent
- WV — Sanitary Wet Vent
- CWV — Combination DWV
- CD — Condensate Drain
- ID — Indirect Drain
- GW — Grease Waste
- GV — Grease Vent
- PD — Pump Discharge
- SD — Storm Drain
- OSD — Storm Overflow
- CA — Compressed Air
- G — Natural Gas
- LP — Liquid Propane
- Pipe Rise / Drop
- RD — Radon Mitigation

Pipe Accessory Notes

- 4" FCO — Cleanout
- 2" CHECK — Check Valve
- 2" BALANCE — Balancing Valve
- 2" CIRC — Circuit Setter
- 2" GATE — Gate Valve
- 2" S/O — Ball Valve
- 2" STRAIN — Fluid Strainer
- S — 1" GAS-CNTRL — Emergency Gas Shutoff
- 1" PLUG — Plug Valve
- 1" GAS COCK — Gas Shutoff Cock
- 1" REG — Gas Regulator
- TP — 1" T/V — Thermostatic Valve
- TMV-XT/P — Mixing Valve
- EW — TMVEM — Emergency Mixer
- 2" PRV — Pressure Reducing Valve
- W — 2" METER — Water Meter
- Double Check Valve
- Reduced Pressure Zone

Plumbing Fixture Notes

- Floor Drain
- 2" FD / 2 DFU — Design Size; Identity Type; Drainage Fixture Units
- 2" FD-3 — Floor Drain w/ Deep Seal Trap
- 2" FD-3P — Floor Drain w/ Trap Primer "P" Indicates Primer Connection
- 2" FD-7 — Floor Drain w/ Integral Cleanout
- 3" AD-1 — Area Drain (No Trap)
- 6" DD-1 — Deck Drain
- 3" HD-1 — Hub Drain (Funnel Type)
- 3" FS — Floor Sink
- 8" SD-12 — Roof Drain
- 6" SD-1 / 2000 SF — Combination Drain; Rainfall Surface Area

Wichita-Sedgwick County
Metropolitan Area Building
and Construction Department

REVIEWED FOR CODE COMPLIANCE

CORRECTIONS OR COMMENTS MADE ON THESE DRAWINGS AND THIS DOCUMENT DURING THIS REVIEW DO NOT RELIEVE CONTRACTOR FROM COMPLIANCE WITH ALL REQUIREMENTS OF THE CODE OF THE MABCD, THE CITY OF WICHITA OR SEDGWICK COUNTY. THIS REVIEW IS ONLY FOR GENERAL CONFORMANCE OF THE CODE. THE CONTRACTOR IS RESPONSIBLE FOR CONFORMING AND CORRELATING ALL TECHNIQUES OF CONSTRUCTION. THIS APPROVAL IS SUBJECT TO PROVISIONS OF SECTION 107.4 OF THE 2012 INTERNATIONAL BUILDING CODE.

DATE: 02/19/25 BY: William Jerauld Jr

Plumbing Sheet Index

P1.1	DWV UNDER FLOOR PLAN
P1.2	DWV 1ST AND 2ND PLANS
P1.3	DWV 3RD AND 4TH PLANS
P1.4	DOMESTIC WATER 1ST & 2ND PLANS
P1.5	DOMESTIC WATER 3RD AND 4TH PLANS
P4.1	ENLARGED DOMESTIC WATER PLANS
P9.1	PLUMBING RISERS
P9.2	PLUMBING RISERS
P0.1	PLUMBING TITLE SHEET
P6.1	PLUMBING SCHEDULES

GENERAL PLUMBING NOTES

A. FIELD VERIFY ALL NEW WATER, WASTE, AND VENT PIPING CONNECTIONS AND PROVIDE NEW CONNECTIONS AS REQUIRED FOR PROPERLY OPERATING SYSTEMS.
B. PITCH UNDERFLOOR SANITARY WASTE PIPING OVER 2" AT 1/8" PER FOOT, 2" AND SMALLER AT 1/4" PER FOOT.
C. FIELD VERIFY LOCATION AND INVERTS OF SITE UTILITIES PRIOR TO INSTALLATION.
D. ROUTE DOMESTIC WATER, AND SANITARY SEWER SERVICES TO SITE UTILITIES 5'-0" FROM BUILDING UNLESS NOTED OTHERWISE. REFER TO CIVIL PLANS.
E. WASTE AND VENT PIPING BELOW FLOOR AND THROUGH FLOOR SHALL BE 2" MINIMUM.
F. LOCATIONS OF PIPING AND EQUIPMENT AS INDICATED ON THE DRAWINGS ARE APPROXIMATE AND SUBJECT TO MINOR ADJUSTMENTS IN THE FIELD. WORK SHALL BE COORDINATED WITH ALL OTHER TRADES TO AVOID INTERFERENCE IN THE FIELD.
G. FINAL PRODUCT SHALL BE A COMPLETE AND FUNCTIONING SYSTEM, AND SHALL CONFORM TO ALL REQUIREMENTS OF APPLICABLE FEDERAL, STATE, AND LOCAL CODES, INCLUDING BUT NOT LIMITED TO THE INTERNATIONAL (OR UNIFORM, DEPENDING ON JURISDICTION) PLUMBING CODE AND INTERNATIONAL MECHANICAL CODE.
H. LOCATE EQUIPMENT REQUIRING ACCESS 2'-0" MAXIMUM ABOVE CEILING.
I. LOCATE PIPING AND EQUIPMENT OUTSIDE OF THE NEC REQUIRED CLEAR SPACE ABOVE AND AROUND ELECTRICAL PANELS, TRANSFORMERS AND OTHER ELECTRICAL EQUIPMENT. COORDINATE WITH ELECTRICAL CONTRACTOR.
J. PENETRATIONS OF RATED ASSEMBLIES SHALL BE FIRE STOPPED. FIRE STOPPING SHALL BE U.L. LISTED. SEE ARCHITECTURAL DRAWINGS FOR LOCATIONS OF RATED ASSEMBLIES.
K. PROVIDE SLEEVES AND/OR OPENINGS TO RUN PIPES THROUGH FOUNDATIONS, FLOORS, WALLS, AND ROOF.
L. MAINTAIN CLEAR ACCESS TO SERVICE EQUIPMENT AND OTHER ACCESSORIES REQUIRING SERVICE, VISUAL INSPECTION OR HAND OPERATION. WHERE INDICATED OR REQUIRED, PROVIDE ACCESS PANELS OF THE TYPE SELECTED TO SUIT MATERIALS IN WHICH INSTALLED.
M. TRANSITION FROM PIPING SIZES SHOWN TO PROPERLY CONNECT TO EQUIPMENT.
N. PIPE SIZES SHOWN SHALL BE CONTINUED IN THE DIRECTION OF FLOW UNTIL ANOTHER SIZE IS SHOWN.
O. INSTALL ALL EQUIPMENT IN ACCORDANCE WITH THE RESPECTIVE MANUFACTURER'S WRITTEN INSTALLATION INSTRUCTIONS, AT A LEVEL OF QUALITY AND WORKMANSHIP CONSISTENT WITH THE SPECIFICATIONS.
P. INSTALL EXPOSED PIPING AS HIGH AS PRACTICAL IN ROOMS WITHOUT CEILINGS.
Q. PRIOR TO STARTING WORK, SUBMIT SHOP DRAWINGS FOR ALL PLUMBING EQUIPMENT AND MATERIALS. SUBSTITUTE EQUIPMENT AND MATERIALS INSTALLED WITHOUT PRIOR APPROVAL SHALL BE SUBJECT TO REPLACEMENT AT CONTRACTOR'S EXPENSE.
R. CONTRACTOR SHALL OBTAIN AND PAY FOR ALL NECESSARY PERMITS AND SHALL ARRANGE FOR ALL INSPECTIONS AS REQUIRED.
S. PROVIDE ONE YEAR WARRANTY FOR ALL WORKMANSHIP AND MATERIALS AFTER THE DATE OF FINAL ACCEPTANCE.

GENERAL PLUMBING DEMOLITION NOTES

A. ALL PIPING TAKEN OUT OF SERVICE SHALL BE REMOVED. WHERE PIPING IS TO BE REMOVED IS CONNECTED TO EXISTING PIPING TO REMAIN, PIPING SHALL BE REMOVED BACK TO MAIN AND CAPPED, UNLESS INDICATED OTHERWISE. CONTRACTOR SHALL DISPOSE OF PIPING OR DELIVER TO OWNER, AS DIRECTED BY OWNER.
B. WHERE PIPING TAKEN OUT OF SERVICE IS LOCATED BELOW SLAB AND IS UNABLE TO BE REMOVED, CAP BELOW SLAB.
C. COORDINATE CUTTING, PATCHING OF EXISTING WALLS, CEILINGS, ROOF AND FLOORS AFFECTED BY MECHANICAL DEMOLITION WITH G.C.
D. ALL EQUIPMENT TAKEN OUT OF SERVICE SHALL BE REMOVED. EQUIPMENT SHALL BE DELIVERED TO OWNER OR DISPOSED OF AS DIRECTED BY OWNER.
E. REMOVE ALL PLUMBING INSTALLATION FROM PROJECT AREA, UNLESS REQUIRED FOR NEW WORK OR EXISTING INSTALLATION NOT AFFECTED BY REMODEL. COORDINATE WITH OWNER AND G.C.
F. SERVICES TO ITEMS NOT REMOVED AS PART OF THIS WORK SHALL BE RESTORED UPON COMPLETION OF THIS WORK TO FULLY OPERATIONAL CONDITION.
G. NOT ALL ITEMS REQUIRED TO BE DEMOLISHED MAY BE INDICATED ON DRAWINGS. ALL DEMOLITION OF AFFECTED SPACE SHALL BE PERFORMED AS IF INDICATED.
H. FIELD VERIFY EXACT LOCATION OF ALL EXISTING PLUMBING INSTALLATION INDICATED ON DRAWINGS.
I. ALL ITEMS TO BE RE-USED OR RELOCATED SHALL BE CLEANED, REPAIRED, AND RESTORED TO LIKE NEW CONDITION PRIOR TO RE-USE.

LST Consulting Engineers, PA
Manhattan, Kansas
785.587.8042

Wichita, Kansas
316.285.0696

www.LSTengineers.com
mail@LSTengineers.com

Project 24061

JonesGillamRenz
730 N. Ninth
Salina, KS 67401
1881 Main Street, Suite 301
Kansas City, MO 64108
785.827.0386
jgr@jgrarchitects.com

THE RESIDENCE AT HERATIGE WEST

NEW SENIOR LIVING FACILITY

ANDOVER, KANSAS

BRIAN PATRICK LIPS — LICENSED — 24155 — KANSAS — PROFESSIONAL ENGINEER
2025.01.10 16:44:55-06'00'

REVISIONS:

DATE: 01-10-2025
JOB: 24-3379
SHEET NO.:

P0.1

© COPYRIGHTED

Wichita-Sedgwick County
Metropolitan Area Building
and Construction Department

REVIEWED FOR CODE COMPLIANCE

CORRECTIONS OR COMMENTS MADE ON THESE DRAWINGS AND THIS DOCUMENT DURING THIS REVIEW DO NOT RELIEVE CONTRACTOR FROM COMPLIANCE WITH ALL REQUIREMENTS OF THE CODE OF THE MABCD, THE CITY OF WICHITA OR SEDGWICK COUNTY. THIS REVIEW IS ONLY FOR GENERAL CONFORMANCE OF THE CODE. THE CONTRACTOR IS RESPONSIBLE FOR CONFORMING AND CORRELATING ALL TECHNIQUES OF CONSTRUCTION. THIS APPROVAL IS SUBJECT TO PROVISIONS OF SECTION 107.4 OF THE 2012 INTERNATIONAL BUILDING CODE.

DATE: 02/19/25 BY: William Jerauld Jr

PLUMBING SIZING SYMBOLS	
x"	DRAIN (X = SIZE)
x"	VENT (X = SIZE)
x"	WASTE STACK VENT (X = SIZE)

NOTES BY SYMBOL

1. 4" PVC PIPE FOR RADON SYSTEM. COORDINATE EXACT REQUIREMENTS WITH ARCHITECT.
2. ROUTE 2" DISCHARGE FROM SUMP PUMP TO CONNECT TO UNDERGROUND STORM SEWER SEE CIVIL FOR CONTINUATION. COORDINATE WITH G.C.
3. ELEVATOR PIT SUMP PUMP, SEE 3:P6.1 FOR MORE INFORMATION.

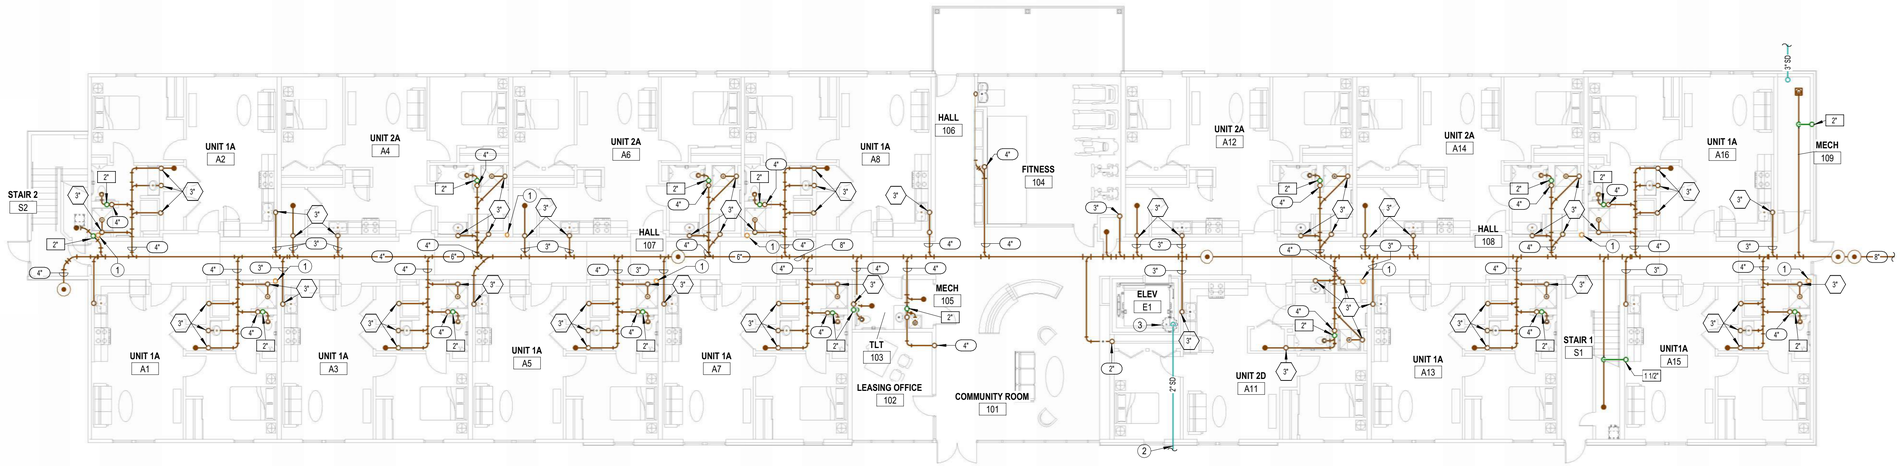

1 P1.1 UNDERFLOOR WASTE AND VENT PLAN
3/32" = 1'-0"
0 8' 16' 24'

LST Consulting Engineers, PA
Manhattan, Kansas
785.587.8042

Wichita, Kansas
316.285.0696

www.LSTengineers.com
mail@LSTengineers.com
Project 24061

JonesGillamRenz
730 N. Ninth
Salina, KS 67401
785.827.0386
1881 Main Street, Suite 301
Kansas City, MO 64108
jgr@jgrarchitects.com

THE RESIDENCE AT HERATIGE WEST

NEW SENIOR LIVING FACILITY

ANDOVER, KANSAS

RYAN PATRICK LIES
LICENSED
24155
KANSAS
PROFESSIONAL ENGINEER
2025.01.10 16:45:14-06'00'

REVISIONS:

DATE: 01-10-2025
JOB: 24-3379
SHEET NO.:

P1.1

COPYRIGHTED ©

Wichita-Sedgwick County
Metropolitan Area Building
and Construction Department

REVIEWED FOR CODE COMPLIANCE

CORRECTIONS OR COMMENTS MADE ON THESE DRAWINGS AND THIS DOCUMENT DURING THIS REVIEW DO NOT RELIEVE CONTRACTOR FROM COMPLIANCE WITH ALL REQUIREMENTS OF THE CODE OF THE MABCD, THE CITY OF WICHITA OR SEDGWICK COUNTY. THIS REVIEW IS ONLY FOR GENERAL CONFORMANCE OF THE CODE. THE CONTRACTOR IS RESPONSIBLE FOR CONFORMING AND CORRELATING ALL TECHNIQUES OF CONSTRUCTION. THIS APPROVAL IS SUBJECT TO PROVISIONS OF SECTION 107.4 OF THE 2012 INTERNATIONAL BUILDING CODE.

DATE: 02/19/25 BY: William Jerauld Jr

PLUMBING SIZING SYMBOLS	
x"	DRAIN (X = SIZE)
x"	VENT (X = SIZE)
x"	WASTE STACK VENT (X = SIZE)

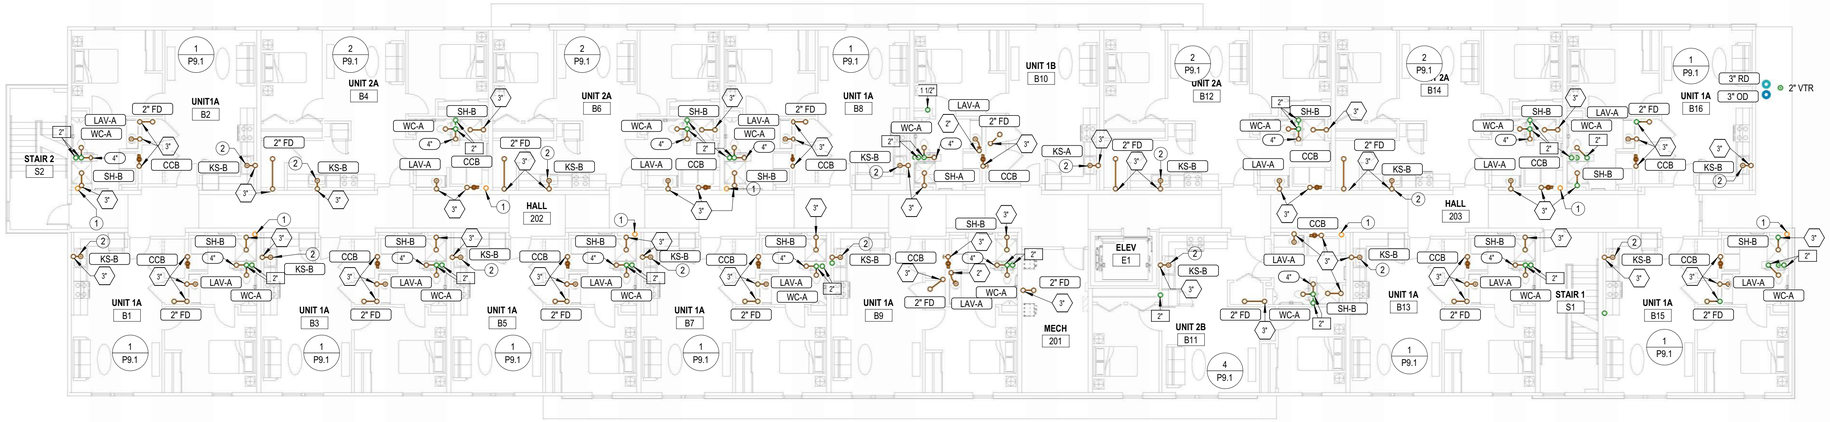

NOTES BY SYMBOL

1. 4" PVC PIPE FOR RADON SYSTEM. COORDINATE EXACT REQUIREMENTS WITH ARCHITECT.
2. PROVIDE INDIRECT CONNECTION AT GARBAGE DISPOSER AND CONNECT DISHWASHER. ROUTE DRAIN FROM DISHWASHER AT BACK OF CABINETRY. COORDINATE EXACT ROUTING WITH G.C.
3. ROUTE ROOF DRAIN PIPING DOWN ALONG WALL AND EXTEND TO UNDERGROUND STORM DRAIN PIPING IN THIS AREA. SEE CIVIL DRAWINGS FOR CONTINUATION.
4. ROUTE ROOF DRAIN PIPING DOWN ALONG WALL AND TERMINATE WITH DOWNSPOUT NOZZLE EQUAL TO ZURN MODEL ZF199 WITH THREADED OUTLET AND FLANGE TO SECURE NOZZLE TO WALL. INSTALL DOWNSPOUT 24" AFG. COORDINATE COLOR WITH ARCHITECT.
5. UP TO WATER CLOSET.
6. UP TO SHOWER.
7. COORDINATE ROUTING OF PIPING IN THIS AREA WITH STRUCTURE. ALL PENETRATIONS OF BEAMS IN THIS AREA MUST BE APPROVED BY STRUCTURAL ENGINEER IN WRITING.
8. UP TO FLOOR DRAIN.

2 P1.2 SECOND FLOOR WASTE AND VENT PLAN
3/32" = 1'-0"
0 8' 16' 24'

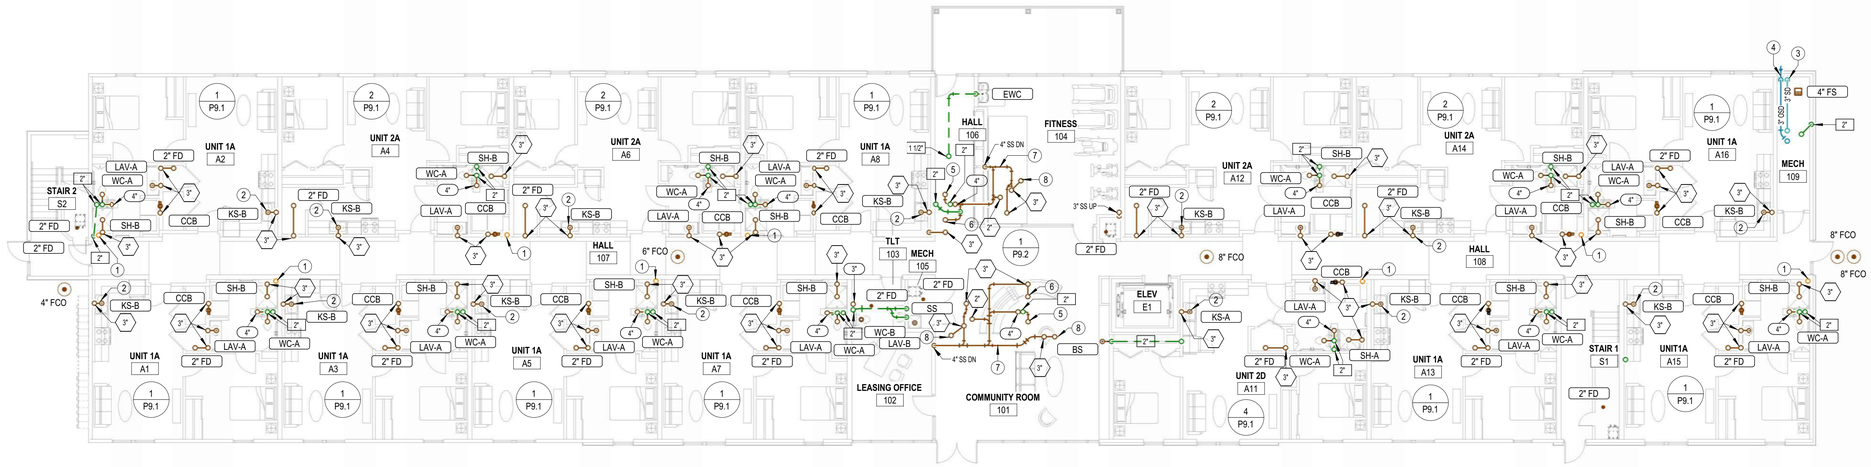

1 P1.2 FIRST FLOOR WASTE AND VENT PLAN
3/32" = 1'-0"
0 8' 16' 24'

LST Consulting Engineers, PA
Manhattan, Kansas
785.587.8042

Wichita, Kansas
316.285.0696

www.LSTengineers.com
mail@LSTengineers.com
Project 24061

JonesGillamRenz
730 N. Ninth
Salina, KS 67401
785.827.0386
1881 Main Street, Suite 301
Kansas City, MO 64108
jgr@jgrarchitects.com

THE RESIDENCE AT HERATIGE WEST

NEW SENIOR LIVING FACILITY

ANDOVER, KANSAS

BRIAN PATRICK LIPS
LICENSED
24155
KANSAS
PROFESSIONAL ENGINEER
2025.01.10
16:45:36-06'00'

REVISIONS:

DATE: 01-10-2025
JOB: 24-3379
SHEET NO.:

P1.2

COPYRIGHTED ©

Wichita-Sedgwick County
Metropolitan Area Building
and Construction Department

REVIEWED FOR CODE COMPLIANCE

CORRECTIONS OR COMMENTS MADE ON THESE DRAWINGS AND THIS DOCUMENT DURING THIS REVIEW DO NOT RELIEVE CONTRACTOR FROM COMPLIANCE WITH ALL REQUIREMENTS OF THE CODE OF THE MABCD, THE CITY OF WICHITA OR SEDGWICK COUNTY. THIS REVIEW IS ONLY FOR GENERAL CONFORMANCE OF THE CODE. THE CONTRACTOR IS RESPONSIBLE FOR CONFORMING AND CORRELATING ALL TECHNIQUES OF CONSTRUCTION. THIS APPROVAL IS SUBJECT TO PROVISIONS OF SECTION 107.4 OF THE 2012 INTERNATIONAL BUILDING CODE.

DATE: 02/19/25 BY: William Jerauld Jr

PLUMBING SIZING SYMBOLS	
(X")	DRAIN (X = SIZE)
X"	VENT (X = SIZE)
(X")	WASTE STACK VENT (X = SIZE)

NOTES BY SYMBOL

1. 4" PVC PIPE FOR RADON SYSTEM. COORDINATE EXACT REQUIREMENTS WITH ARCHITECT.
2. PROVIDE INDIRECT CONNECTION AT GARBAGE DISPOSER AND CONNECT DISHWASHER. ROUTE DRAIN FROM DISHWASHER AT BACK OF CABINETRY. COORDINATE EXACT ROUTING WITH G.C.

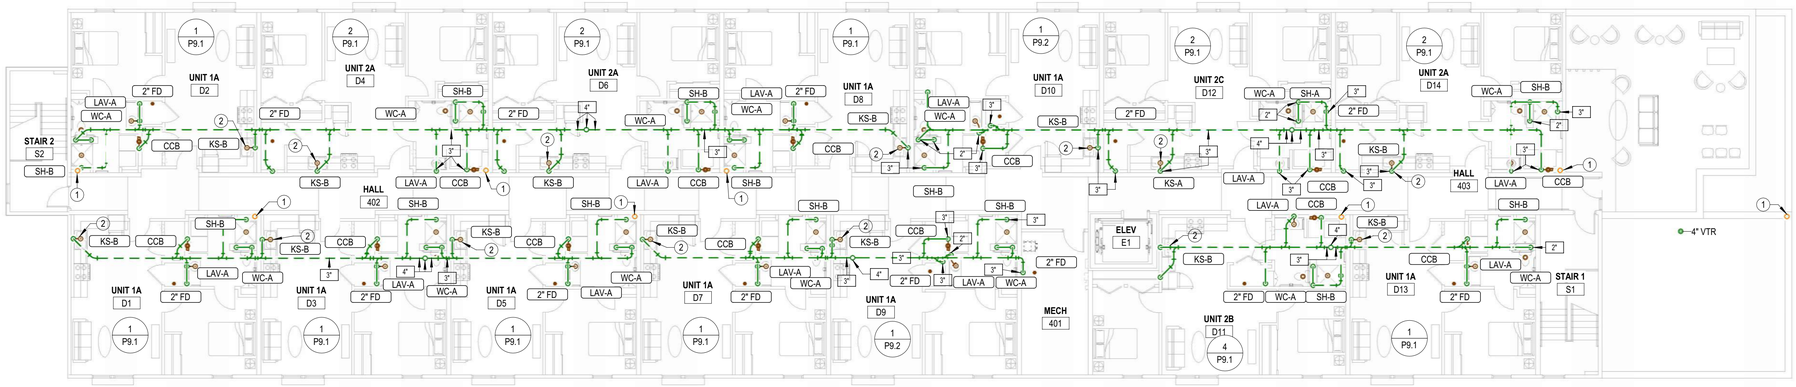

2 P1.3 FOURTH FLOOR WASTE AND VENT PLAN
3/32" = 1'-0"
0 8' 16' 24'

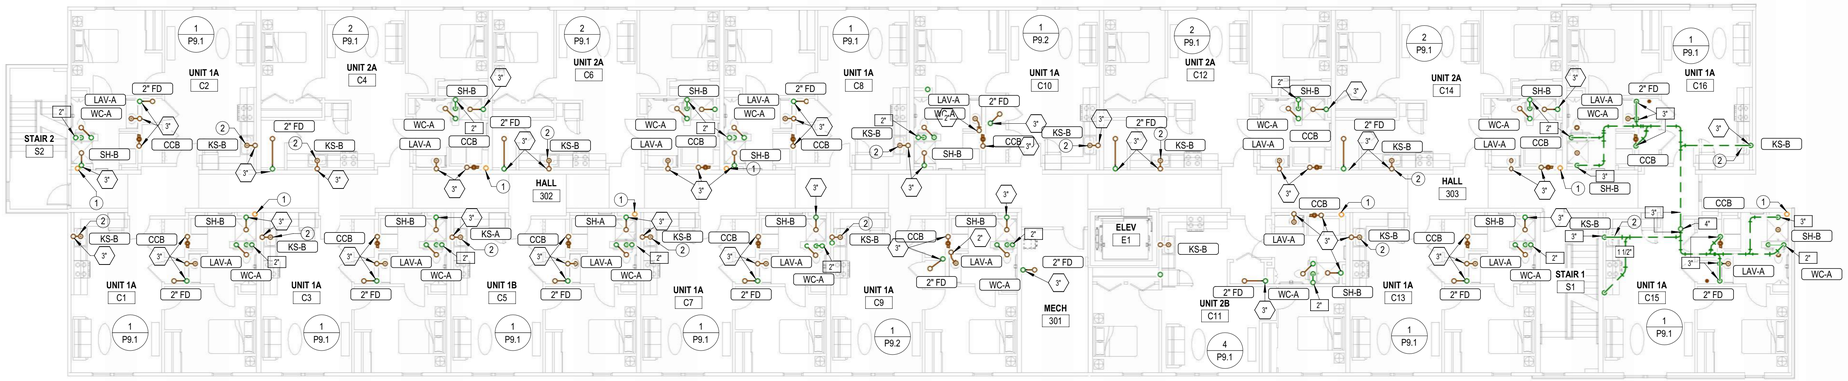

1 P1.3 THIRD FLOOR WASTE AND VENT PLAN
3/32" = 1'-0"
0 8' 16' 24'

LST Consulting Engineers, PA
Manhattan, Kansas
785.587.8042

Wichita, Kansas
316.285.0696

www.LSTengineers.com
mail@LSTengineers.com
Project 24061

JonesGillamRenz
730 N. Ninth
Salina, KS 67401
1881 Main Street, Suite 301
Kansas City, MO 64108
jgr@jgrarchitects.com
785.827.0386

THE RESIDENCE AT HERATIGE WEST
NEW SENIOR LIVING FACILITY
ANDOVER, KANSAS



REVISIONS:

DATE: 01-10-2025
JOB: 24-3379
SHEET NO.:

P1.3

COPYRIGHTED ©

Wichita-Sedgwick County
Metropolitan Area Building
and Construction Department

REVIEWED FOR CODE COMPLIANCE

CORRECTIONS OR COMMENTS MADE ON THESE DRAWINGS AND THIS DOCUMENT DURING THIS REVIEW DO NOT RELIEVE CONTRACTOR FROM COMPLIANCE WITH ALL REQUIREMENTS OF THE CODE OF THE MABCD, THE CITY OF WICHITA OR SEDGWICK COUNTY. THIS REVIEW IS ONLY FOR GENERAL CONFORMANCE OF THE CODE. THE CONTRACTOR IS RESPONSIBLE FOR CONFORMING AND CORRELATING ALL TECHNIQUES OF CONSTRUCTION. THIS APPROVAL IS SUBJECT TO PROVISIONS OF SECTION 107.4 OF THE 2012 INTERNATIONAL BUILDING CODE.

DATE: 02/19/25 BY: William Jerauld Jr

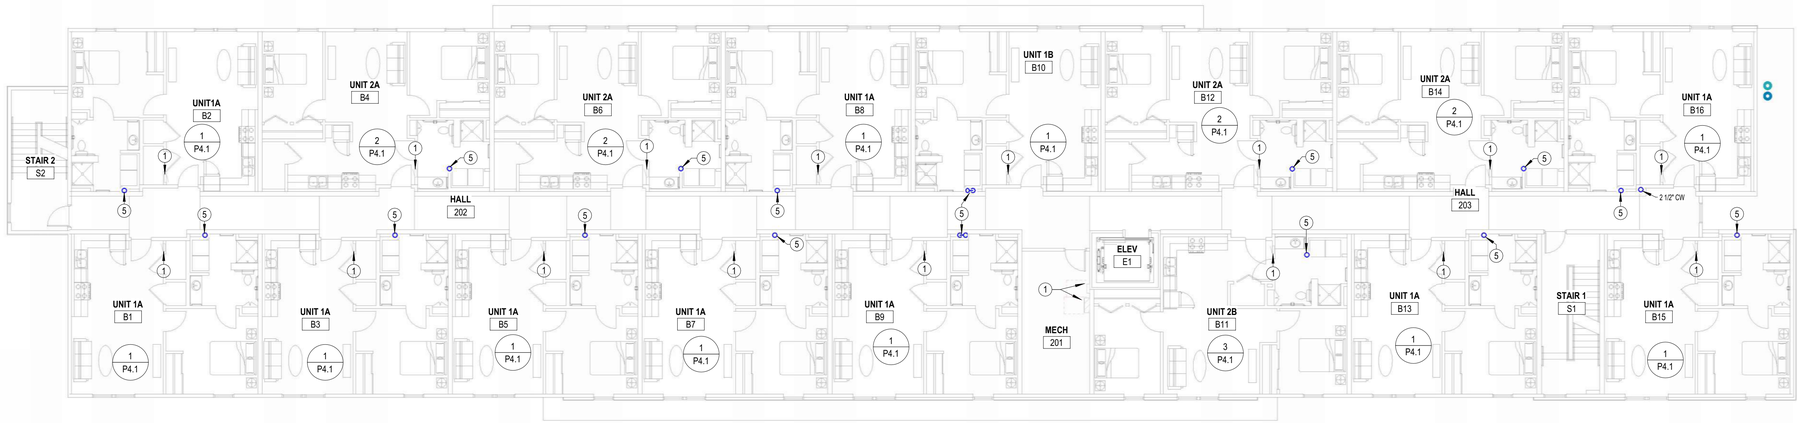

PIPING FOR DWELLING UNITS ON 2ND AND 4TH FLOORS SHALL BE ROUTED BELOW THE FLOOR. DO NOT DOMESTIC WATER PIPING IN THE ATTIC

SEE SHEET P4.1 FOR PLUMBING FIXTURE TAGS

NOTES BY SYMBOL

1. ELECTRICAL EQUIPMENT SHOWN FOR COORDINATION. DO NOT ROUTE PIPING ABOVE OR BELOW EQUIPMENT, AND MAINTAIN WORKING CLEARANCE SHOWN.
2. FIRE PROTECTION SERVICE ENTRANCE. INSTALL IN ACCORDANCE WITH NFPA 13. COORDINATE LOCATION OF ALL VALVES AND APPURTENANCES WITH AHJ. SEE 4:P8.1 FOR MORE INFORMATION.
3. PROVIDE SHUT-OFF VALVE AT WATER SERVICE ENTRANCE WITH PRESSURE REDUCING VALVE SET TO 80 PSI IF REQUIRED. COORDINATE REQUIREMENTS WITH CITY OF ANDOVER.
4. SEE ENLARGED DOMESTIC WATER PLANS FOR CONTINUATION.
5. 1" DOMESTIC WATER FROM FLOOR BELOW, SEE ENLARGED DOMESTIC WATER PLANS FOR MORE INFORMATION.
6. COORDINATE ROUTING OF PIPING IN THIS AREA WITH STRUCTURE. ALL PENETRATIONS OF BEAMS IN THIS AREA MUST BE APPROVED BY STRUCTURAL ENGINEER IN WRITING.

2 P1.4 SECOND FLOOR DOMESTIC WATER PLAN
3/32" = 1'-0"
0 8' 16' 24'

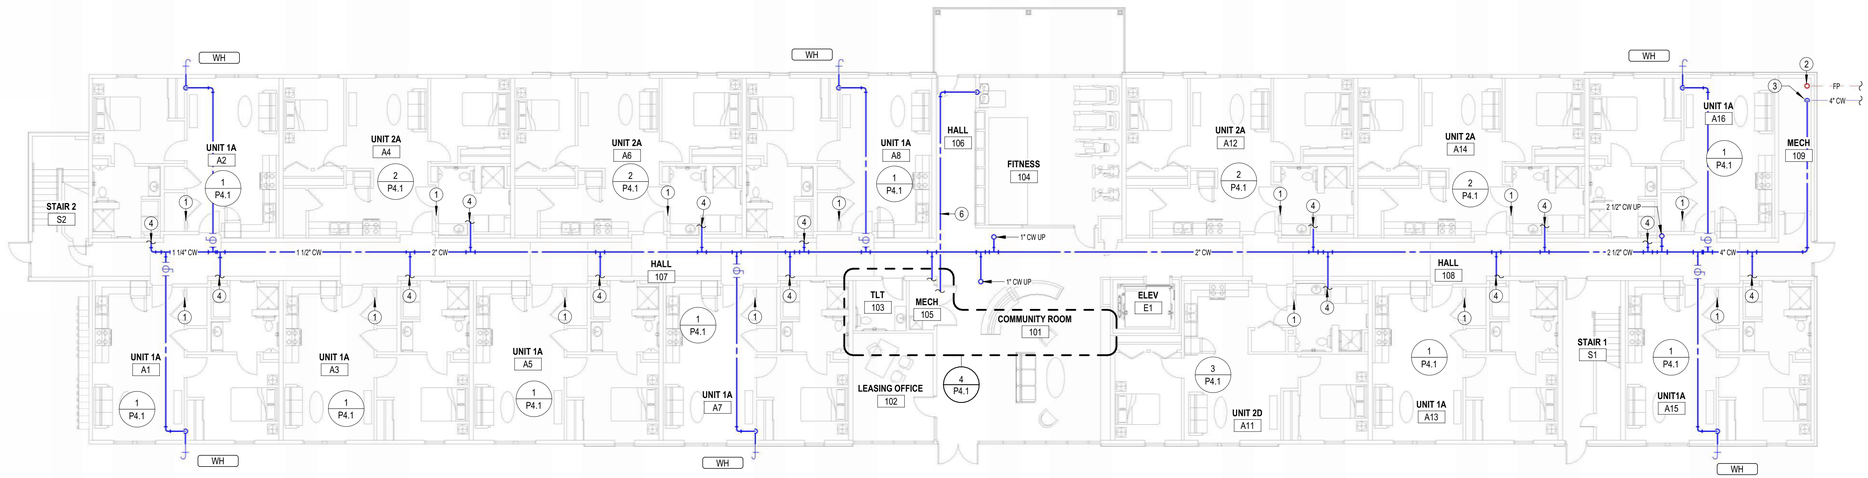

PIPING FOR DWELLING UNITS ON 2ND AND 4TH FLOORS SHALL BE ROUTED BELOW THE FLOOR. DO NOT DOMESTIC WATER PIPING IN THE ATTIC

1 P1.4 FIRST FLOOR DOMESTIC WATER PLAN
3/32" = 1'-0"
0 8' 16' 24'

LST Consulting Engineers, PA
Manhattan, Kansas
785.587.8042

Wichita, Kansas
316.285.0696

www.LSTengineers.com
mail@LSTengineers.com
Project 24061

JonesGillamRenz
730 N. Ninth 1881 Main Street, Suite 301
Salina, KS 67401 Kansas City, MO 64108
785.827.0386 jgr@jgrarchitects.com

THE RESIDENCE AT HERATIGE WEST
NEW SENIOR LIVING FACILITY
ANDOVER, KANSAS

RYAN PATRICK LIEN LICENSED 24155 KANSAS PROFESSIONAL ENGINEER
2025.01.10 16:46:19-06'00'

REVISIONS:

DATE: 01-10-2025
JOB: 24-3379
SHEET NO.:

P1.4

© COPYRIGHTED

Wichita-Sedgwick County
Metropolitan Area Building
and Construction Department

REVIEWED FOR CODE COMPLIANCE

CORRECTIONS OR COMMENTS MADE ON THESE DRAWINGS AND THIS DOCUMENT DURING THIS REVIEW DO NOT RELIEVE CONTRACTOR FROM COMPLIANCE WITH ALL REQUIREMENTS OF THE CODE OF THE MABCD, THE CITY OF WICHITA OR SEDGWICK COUNTY. THIS REVIEW IS ONLY FOR GENERAL CONFORMANCE OF THE CODE. THE CONTRACTOR IS RESPONSIBLE FOR CONFORMING AND CORRELATING ALL TECHNIQUES OF CONSTRUCTION. THIS APPROVAL IS SUBJECT TO PROVISIONS OF SECTION 107.4 OF THE 2012 INTERNATIONAL BUILDING CODE.

DATE: 02/19/25 BY: William Jerauld Jr

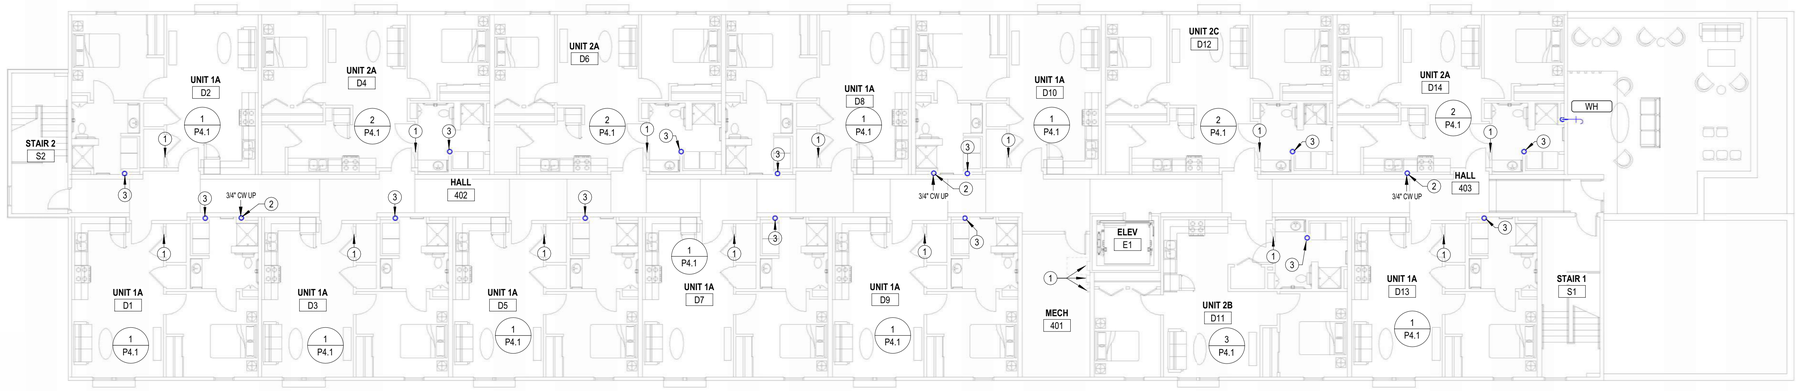

PIPING FOR DWELLING UNITS ON 2ND AND 4TH FLOORS SHALL BE ROUTED BELOW THE FLOOR. DO NOT DOMESTIC WATER PIPING IN THE ATTIC

2 P1.5 FOURTH FLOOR DOMESTIC WATER PLAN
3/32" = 1'-0"
0 8' 16' 24'

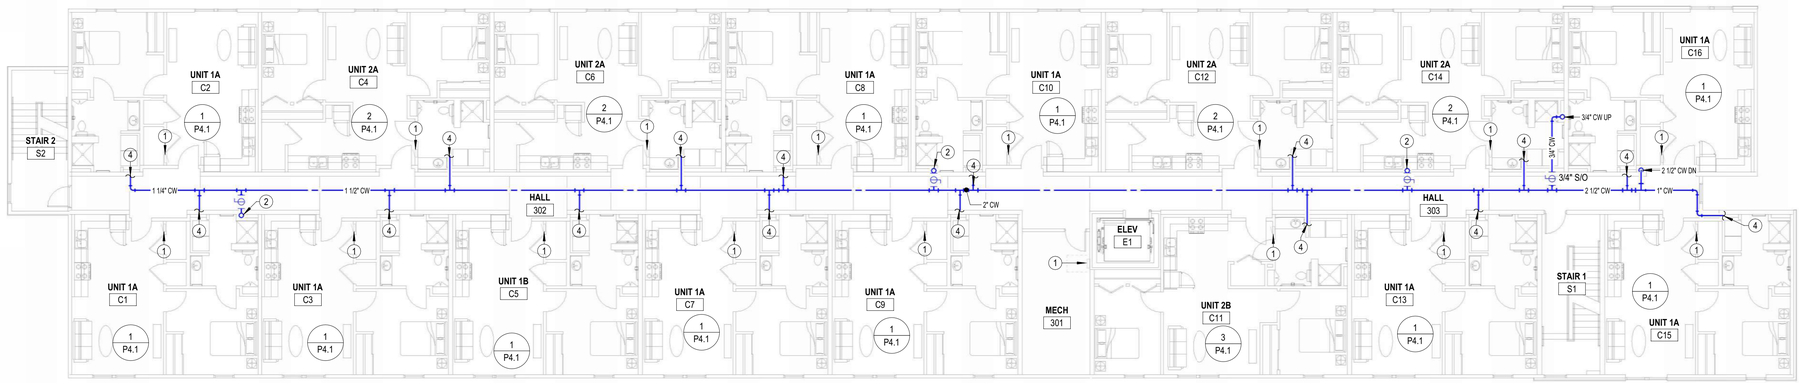

PIPING FOR DWELLING UNITS ON 2ND AND 4TH FLOORS SHALL BE ROUTED BELOW THE FLOOR. DO NOT DOMESTIC WATER PIPING IN THE ATTIC

1 P1.5 THIRD FLOOR DOMESTIC WATER PLAN
3/32" = 1'-0"
0 8' 16' 24'

SEE SHEET P4.1 FOR PLUMBING FIXTURE TAGS

NOTES BY SYMBOL

1. ELECTRICAL EQUIPMENT SHOWN FOR COORDINATION. DO NOT ROUTE PIPING ABOVE OR BELOW EQUIPMENT, AND MAINTAIN WORKING CLEARANCE SHOWN.
2. 3/4" COLD WATER UP TO ROOF HYDRANT.
3. 1" DOMESTIC WATER FROM FLOOR BELOW, SEE ENLARGED DOMESTIC WATER PLANS FOR MORE INFORMATION.
4. SEE ENLARGED DOMESTIC WATER PLANS FOR CONTINUATION.

LST Consulting Engineers, PA
Manhattan, Kansas
785.587.8042

Wichita, Kansas
316.285.0696

www.LSTengineers.com
mail@LSTengineers.com
Project 24061

JonesGillamRenz
730 N. Ninth 1881 Main Street, Suite 301
Salina, KS 67401 Kansas City, MO 64108
785.827.0386 jgr@jgrarchitects.com

THE RESIDENCE AT HERATIGE WEST

NEW SENIOR LIVING FACILITY

ANDOVER, KANSAS

RYAN PATRICK LIES LICENSED 24155 KANSAS PROFESSIONAL ENGINEER 2025.01.10 16:46:35-06'00'

REVISIONS:

DATE: 01-10-2025
JOB: 24-3379
SHEET NO.:

P1.5

COPYRIGHTED ©

Wichita-Sedgwick County
Metropolitan Area Building
and Construction Department

REVIEWED FOR CODE COMPLIANCE

CORRECTIONS OR COMMENTS MADE ON THESE DRAWINGS AND THIS DOCUMENT DURING THIS REVIEW DO NOT RELIEVE CONTRACTOR FROM COMPLIANCE WITH ALL REQUIREMENTS OF THE CODE OF THE MABCD, THE CITY OF WICHITA OR SEDGWICK COUNTY. THIS REVIEW IS ONLY FOR GENERAL CONFORMANCE OF THE CODE. THE CONTRACTOR IS RESPONSIBLE FOR CONFORMING AND CORRELATING ALL TECHNIQUES OF CONSTRUCTION. THIS APPROVAL IS SUBJECT TO PROVISIONS OF SECTION 107.4 OF THE 2012 INTERNATIONAL BUILDING CODE.

DATE: 02/19/25 BY: William Jerauld Jr

PIPING FOR DWELLING UNITS ON 2ND AND 4TH FLOORS SHALL BE ROUTED BELOW THE FLOOR. DO NOT DOMESTIC WATER PIPING IN THE ATTIC

NOTES BY SYMBOL

1. PROVIDE 1/2" VALVED BRANCH BELOW SINK AND CONNECT DISHWASHER. ROUTE PIPING ALONG BACK OF CABINETRY, COORDINATE EXACT ROUTING WITH G.C. COORDINATE EXACT REQUIREMENTS WITH DISHWASHER PROVIDED.
2. SEE OVERALL DOMESTIC WATER PLANS FOR CONTINUATION.
3. PROVIDE 1-1/4" DOMESTIC WATER PIPE TO APARTMENTS, PROVIDE WITH 1" TEE UP TO FLOOR ABOVE AND 1" DOWN TO APARTMENT SHUT-OFF VALVE. SEE TYPICAL RISER DIAGRAM S-P4.1.
4. PROVIDE 1" WATER SERVICE TO APARTMENT WITH SHUT-OFF VALVE CONCEALED IN WALL, PROVIDE ACCESS PANELS ON LAUNDRY SIDE OF WALL.
5. HOT WATER RECIRC LOOP SHALL DROP IN WALL TO LIMIT HOT WATER BRANCH TO PUBLIC LAVATORY TO 2 FT MAX.
6. COORDINATE ROUTING OF PIPING IN THIS AREA WITH STRUCTURE. ALL PENETRATIONS OF BEAMS IN THIS AREA MUST BE APPROVED BY STRUCTURAL ENGINEER IN WRITING.

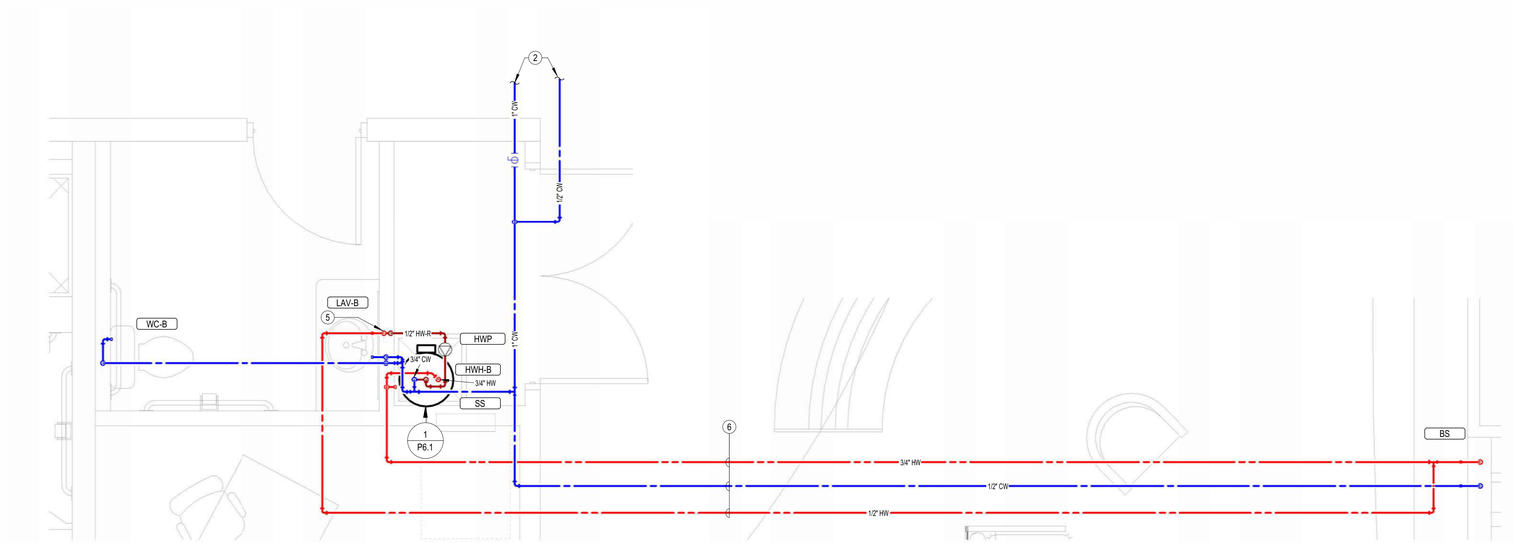

4 P4.1 ENLARGED COMMUNITY ROOM PLUMING
1/2" = 1'-0"
0 1' 2' 4'

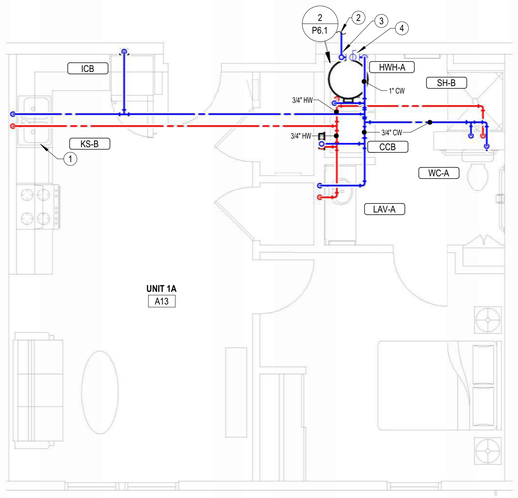

1 P4.1 1 BEDROOM (UNITS 1A/1B) ENLARGED DOMESTIC WATER PLAN
1/4" = 1'-0"
0 2' 4' 8'

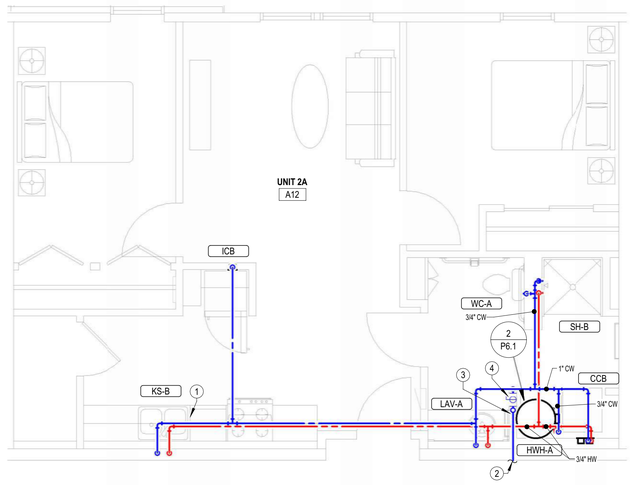

2 P4.1 2 BEDROOM (UNITS 2A/2C) ENLARGED DOMESTIC WATER PLAN
1/4" = 1'-0"
0 2' 4' 8'

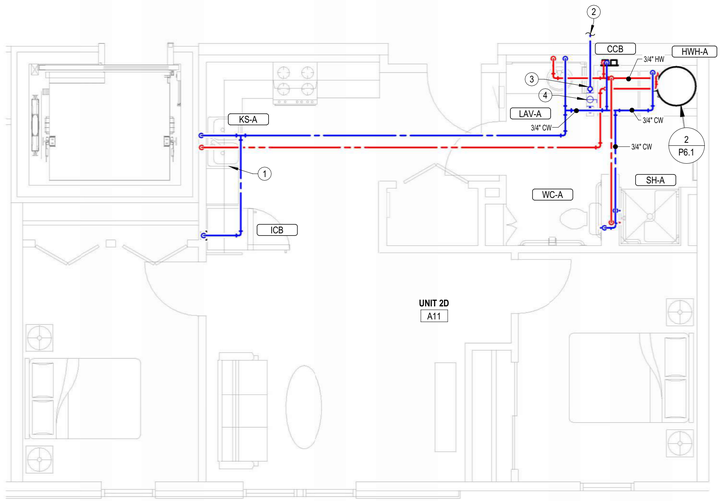

3 P4.1 2 BEDROOM (UNITS 2B/2D) ENLARGED DOMESTIC WATER PLAN
1/4" = 1'-0"
0 2' 4' 8'

LST Consulting Engineers, PA
Manhattan, Kansas
785.587.8042

Wichita, Kansas
316.285.0696

www.LSTengineers.com
mail@LSTengineers.com
Project 24061

JonesGillamRenz
730 N. Ninth 1881 Main Street, Suite 301
Salina, KS 67401 Kansas City, MO 64108
785.827.0386 jgr@jgrarchitects.com

THE RESIDENCE AT HERATIGE WEST
NEW SENIOR LIVING FACILITY
ANDOVER, KANSAS

RYAN PATRICK LIPS
LICENSED
24155
KANSAS
PROFESSIONAL ENGINEER
16:46:59-06'00'

REVISIONS:

DATE: 01-10-2025
JOB: 24-3379
SHEET NO.:

P4.1

COPYRIGHTED ©

Wichita-Sedgwick County
Metropolitan Area Building
and Construction Department

REVIEWED FOR CODE COMPLIANCE

CORRECTIONS OR COMMENTS MADE ON THESE DRAWINGS AND THIS DOCUMENT DURING THIS REVIEW DO NOT RELIEVE CONTRACTOR FROM COMPLIANCE WITH ALL REQUIREMENTS OF THE CODE OF THE MABCD, THE CITY OF WICHITA OR SEDGWICK COUNTY. THIS REVIEW IS ONLY FOR GENERAL CONFORMANCE OF THE CODE. THE CONTRACTOR IS RESPONSIBLE FOR CONFORMING AND CORRELATING ALL TECHNIQUES OF CONSTRUCTION. THIS APPROVAL IS SUBJECT TO PROVISIONS OF SECTION 107.4 OF THE 2012 INTERNATIONAL BUILDING CODE.

DATE: 02/19/25 BY: William Jerauld Jr

Domestic Water Equipment Schedule

Mark	Manufacturer	Model	Specification	Notes
HWH-A	AO Smith	ENJ-40	40 Gallon electric water heater, 0.93 UEF, 4500 watts, 208v heating element, 21 GPH recovery @ 90°F temp rise. Supplied with temperature and pressure relief valve and brass drain valve. Water heater shall have temperature controls set to limit supply temperature to 120°F or less.	1
HWH-B	AO Smith	EJCS-20	20 Gallon electric water heater, 2500 watts, 120v heating element, 11 GPH recovery @ 90°F temp rise. Supplied with temperature and pressure relief valve and brass drain valve. Water heater shall have temperature controls set to limit supply temperature to 120°F or less.	1
HWP	Bell & Gossett	ECOCIRC e3-4V	Circulation pump, bronze body, 10 GPM @ 10' head, 120 VAC. Provide clamp-on aquastat for pump control.	2

GENERAL:
- Provide fixtures with all trim necesary for complete installation.

NOTES:
1. Provide wall hung platform for water heater equal to Holdrite #60SWHP-W. Coordinate exact location and mounting with height with architect.
2. Pump shall have controls to prevent startup within 5 minutes from the end of the previous heating cycle. hot water recirculation system shall meet all requirements of 2018 IECC.

PLUMBING FIXTURE SCHEDULE

MARK	MANUFACTURER	MODEL	PRODUCT DESCRIPTION	TRIM	ROUGH-IN SIZES			COLD	HOT	ADA COMPLIANT	NOTES
					DRAIN	VENT	WATER				
BS	Blanco	524755	17"W x 17" Single compartment, under mount, stainless steel satin polish sink.	Delta / 19802Z-SP-DST / Spot Shield Stainless	2"	1 1/2"	1/2"	Yes	Yes	Yes	1,2,3,5
CCB	IPS Corp.	W4700	Washing machine box with 2" PVC/ABS drain coupling and knockout test cap. Two 1/4 turn adaptor ball valves, sweat connection.		2"	1 1/2"	1/2"	Yes	Yes		
EWC	Elkay	EMABFTLDDWSLK	Dual height, self-contained water cooler with stainless steel basin, front and side push bar actuator, lead-free, 120v. Provide with EZH2O bottle filling station, and model 98313C accessory apron.		2"	1 1/2"	1/2"	Yes	No	Yes	1
FD	Sioux Chief	833	Adjustable floor drain with nickel bronze strainer. Provide Proset Trapgaurd trap protection device.		2"	2"					
FS	Sioux Chief	861	PVC floor sink wiht PVC strainer. Provide Proset Trapgaurd trap protection device.		4"	2"					
ICB	IPS Corp.	FRIB12	Ice maker connection box with 1/4 turn ball valve and 1/2" sweat copper connection.				1/2"	Yes	No		
KS-A	Just	DLADA1829A65-J	Two compartment 20 GA stainless steel sink, self rimming, 14"x16"x"D inside, fully undercoated, faucet holes as required. Single handle kitchen sink facuet with hose spray, and basket strainer. IN-SINKERATOR: "Badger 5" garbage disposal, 1/2hp, 120V cord and plug connected.	Delta / 19802Z-SP-DST / Spot Shield Stainless	2"	1 1/2"	1/2"	Yes	Yes	No	1,2,3,4,5
KS-B	Just	DLADA1829A65-J	Two compartment 20 GA stainless steel sink, self rimming, 14"x16"x8"D inside, fully undercoated, faucet holes as required. Single handle kitchen sink facuet with hose spray, and basket strainer. IN-SINKERATOR: "Badger 5" garbage disposal, 1/2hp, 120V cord and plug connected.	Delta / 19802Z-SP-DST / Spot Shield Stainless	2"	1 1/2"	1/2"	Yes	Yes	No	1,2,3,4,5
LAV-A	American Standard	0610.000.020	20"Wx16" Under mount, vitreous china lavatory. Single handled 1.2 GPM faucet. Provide with pop-drain, and front overflow drain.	Delta / 559HAR-SS-DST / Brilliance Stainless	2"	1 1/2"	1/2"	Yes	Yes	Yes	1,2,3,5
LAV-B	American Standard	0610.000.020	20"Wx16" Under mount, vitreous china lavatory. Single handled 1.2 GPM faucet. Provide with pop-drain, and front overflow drain.	Delta / 559HAR-BL-DST / Matte Black	2"	1 1/2"	1/2"	Yes	Yes	Yes	1,2,3,5
OD	MIFAB	R1200-W	Deep Sump Roof Drain With 15" Diameter Anchor Flange, 2" High Cast Iron External Combined Water Dam And Waterproofing Membrane Clamp Ring, And Standard Self-Locking Dome Strainer With A Free Area Of 125 Square Inches.		3"						
RD	MIFAB	R1200-W	Deep Sump Roof Drain With 15" Diameter Anchor Flange, 2" High Cast Iron External Combined Water Dam And Waterproofing Membrane Clamp Ring, And Standard Self-Locking Dome Strainer With A Free Area Of 125 Square Inches.		3"						
RH	Woodford	RHY2-MS	Frost proof roof hydrant with ASSE 1052 double check backflow preventer that is field testable, integral vent that allows drainage with 1/8" drain hole drilled and tapped in body of hydrant. Provide with manufacturer's roof mounting system consisting of cast iron hydrant support, under deck flange, well seal, EPDM boot, and shims as required. Coordinate installation with G.C.		1/2"		3/4"	Yes	No	No	6
SH-A	Aqua Bath Co.	C4136BF-OT-FUS 3/4"	Center drain option, reinforced fiberglass ADA roll-in shower, 36"Wx36"Dx80"H with integral soap/toiletry shelves and grab bars in accordance with ADA requirements, fold-up seat, right or left hand rough-in as required, white finish. Provide with collapsible dam. Entire assembly shall have nickel finish. Max 2.0 GPM	Kohler / K-8304-KS pressure balancing valve with integral temperature limits and stops / K-TS10583-4 valve trim / K-22173 wall supply elbow / K-9514 60" hose / K-22163 hand shower / K-8524 and K-349 slide bar.	2"	1 1/2"	1/2"	Yes	Yes	Yes	1
SH-B	Aqua Bath Co.	C4136BF-OT-FUS 3/4"	Center drain option, reinforced fiberglass ADA base model shower, 36"Wx36"Dx80"H with integral soap/toiletry shelves in accordance with ADA requirements, right or left hand rough-in as required, white finish. Provide with collapsible dam and blocking for grab bars and seat to be added at tenant's request. Entire assembly shall have nickel finish. Max 2.0 GPM.	Kohler / K-8304-KS pressure balancing valve with integral temperature limits and stops / K-TS10583-4 valve trim	2"	1 1/2"	1/2"	Yes	Yes	No	
SS	Fiat	MSB-2424	One piece molded stone mop basin, 24" square, stainless steel integral drain body with caulk connection, stainless steel wall gaurds. Faucet with hose thread outlet, vacuum breaker, pail hook, wall brace, and metal lever handels.	Delta / 28T9	3"	1 1/2"	3/4"	Yes	Yes	No	4
WC-A	Kohler	5296 Highline	Two piece, 12" rough-in, elongated 16-1/2" high bowl, siphon jet flushing action, actuator located on open side of room. Elongated closed front seat and cover. Provide with 1/4" brass ball valve at wall connection.	Kohler / K-5588	4"	2"	1/2"	Yes	No	No	1
WC-B	Kohler	5296 Highline	Two piece, 12" rough-in, elongated 16-1/2" high bowl, siphon jet flushing action, actuator located on open side of room. Elongated closed front seat. Provide with 1/4" brass ball valve at wall connection.	Kohler / K-5588	4"	2"	1/2"	Yes	No	Yes	1
WH	WOODFORD	B25	Frost proof wall hydrant with anti-siphon vacuum breaker, with metal handle.				3/4"	Yes	No	No	

GENERAL:
- Provide fixtures with all trim necesary for complete installation.
- All toilets, lavatory faucets, showerheads, and kitchen faucets shall have EPA's WaterSense label.

NOTES:
1. In areas open to the public, fixture and installation to meet requirements of Americans with Disabilities Act. In apartments, fixture and installation to meet requirements of the Fair Housing Act.
2. Provide Dearborn supplies with stops and escutcheon plate, 1-1/4" cast brass p-trap.
3. Insulate water and waste piping below sink. Utilize insulation kit equivalent to LavGuard by Truebro. Provide Plumberex model #30711WD-N waste disposal cover.
4. Trim shall be provided with polished chrome finish.
5. Fixture selected by interior designer. Verify finish and selections with interior designer.
6. Transition from 1/8" drain tubing to 1/2" PVC drain and terminate with ar gap at nearest tenant floor drain.

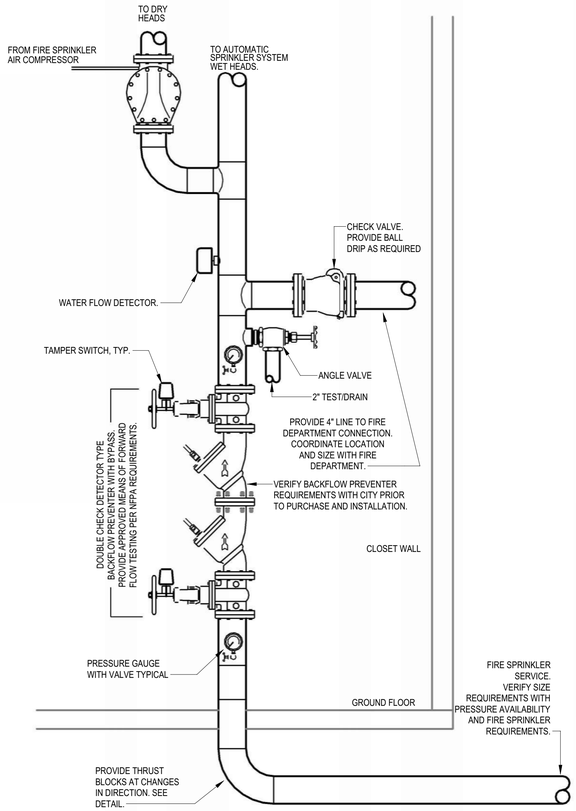

4 P6.1 FIRE PROTECTION RISER DIAGRAM
NO SCALE

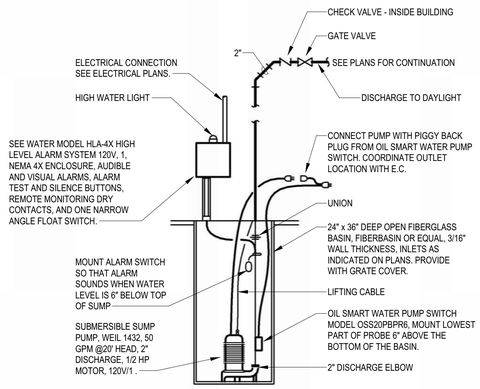

3 P6.1 ELEVATOR SUMP PUMP
NO SCALE

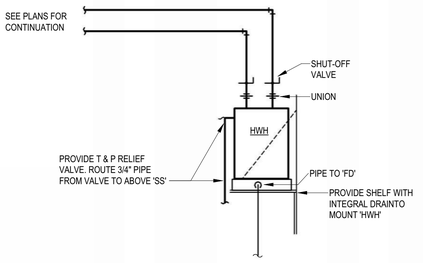

2 P6.1 APPARTMENT WATER HEATER DIAGRAM
NO SCALE

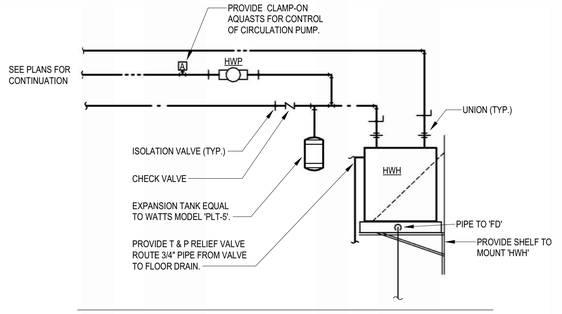

1 P6.1 WATER HEATER ON SHELF PIPING DIAGRAM
NO SCALE

LST Consulting Engineers, PA
Manhattan, Kansas
785.587.8042

Wichita, Kansas
316.285.0696

www.LSTengineers.com
mail@LSTengineers.com
Project 24061

JonesGillamRenz
730 N. Ninth
Salina, KS 67401
785.827.0386
1881 Main Street, Suite 301
Kansas City, MO 64108
jgr@jgrarchitects.com

THE RESIDENCE AT HERATIGE WEST
NEW SENIOR LIVING FACILITY
ANDOVER, KANSAS

RYAN PATRICK LIEB
LICENSED
24155
KANSAS
PROFESSIONAL ENGINEER
2025.01.10 16:47:19-06'00'

REVISIONS:

DATE: 01-10-2025
JOB: 24-3379
SHEET NO.:

P6.1

COPYRIGHTED ©

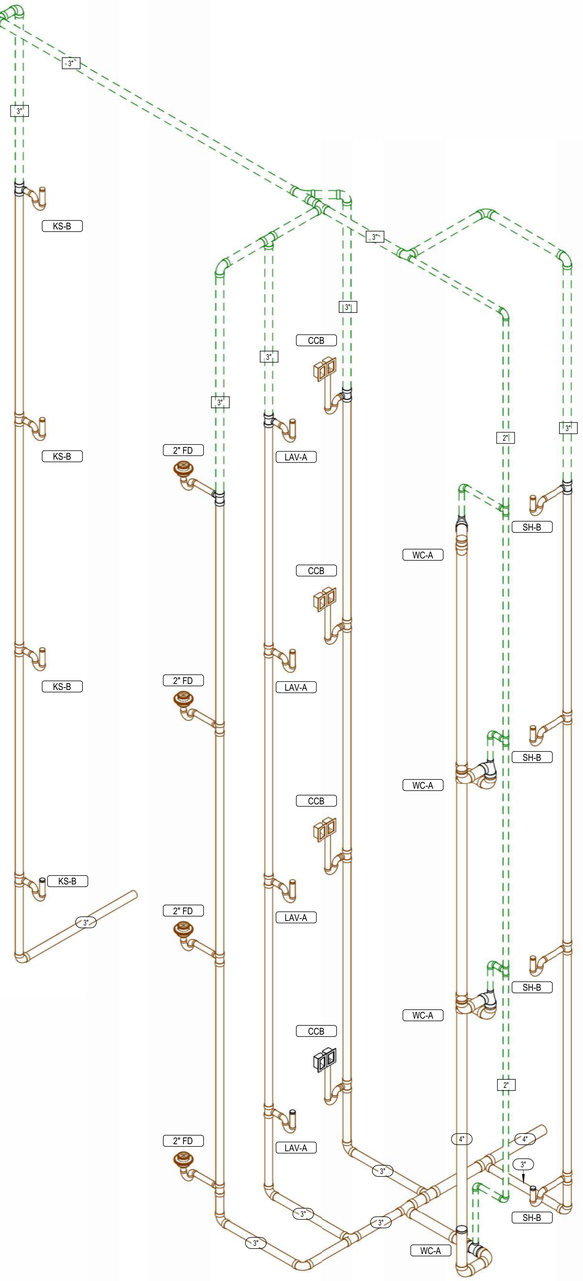

1 P9.1 TYPICAL ONE BEDROOM 1A/1B WASTE AND VENT RISER

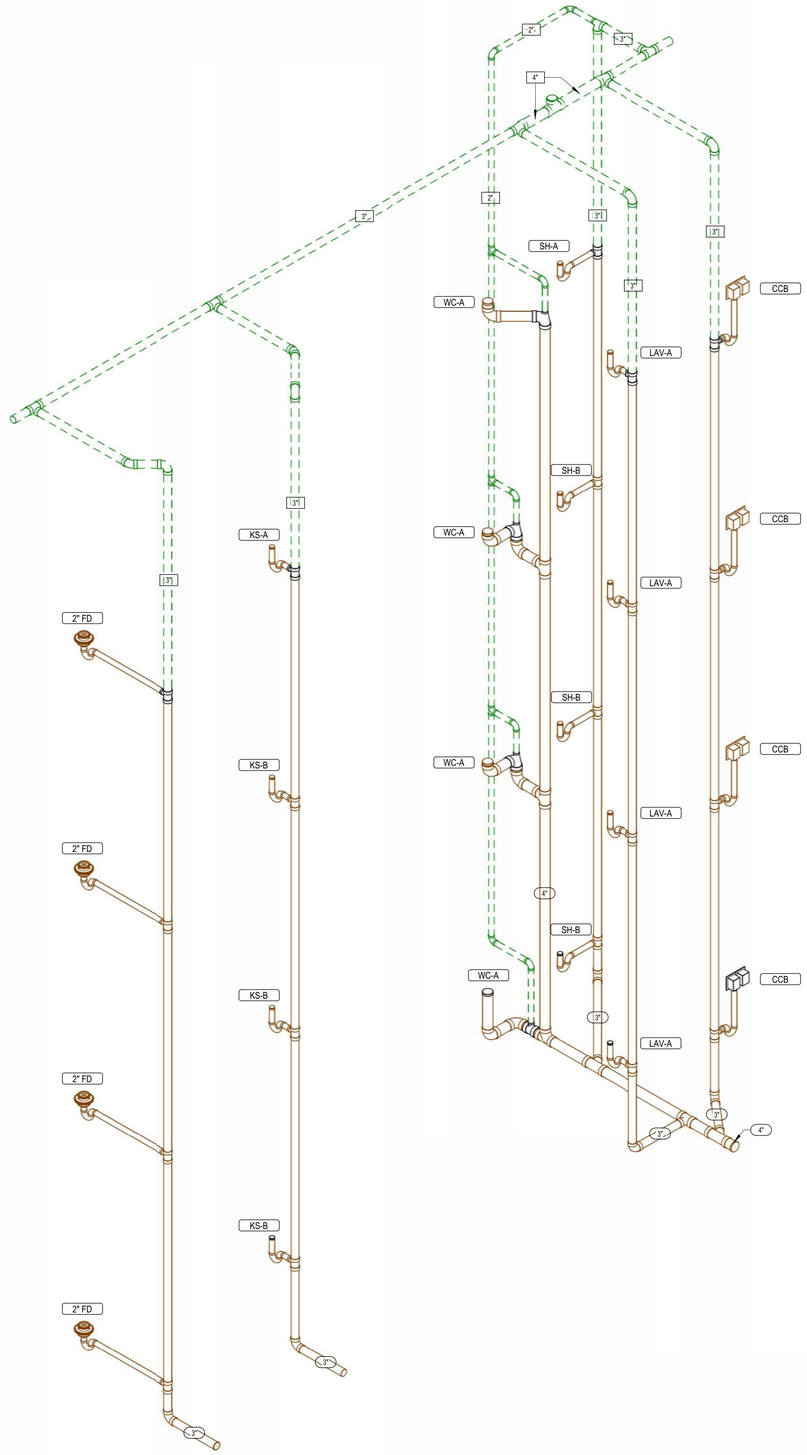

2 P9.1 TYPICAL TWO BEDROOM 2A/2C WASTE AND VENT RISER

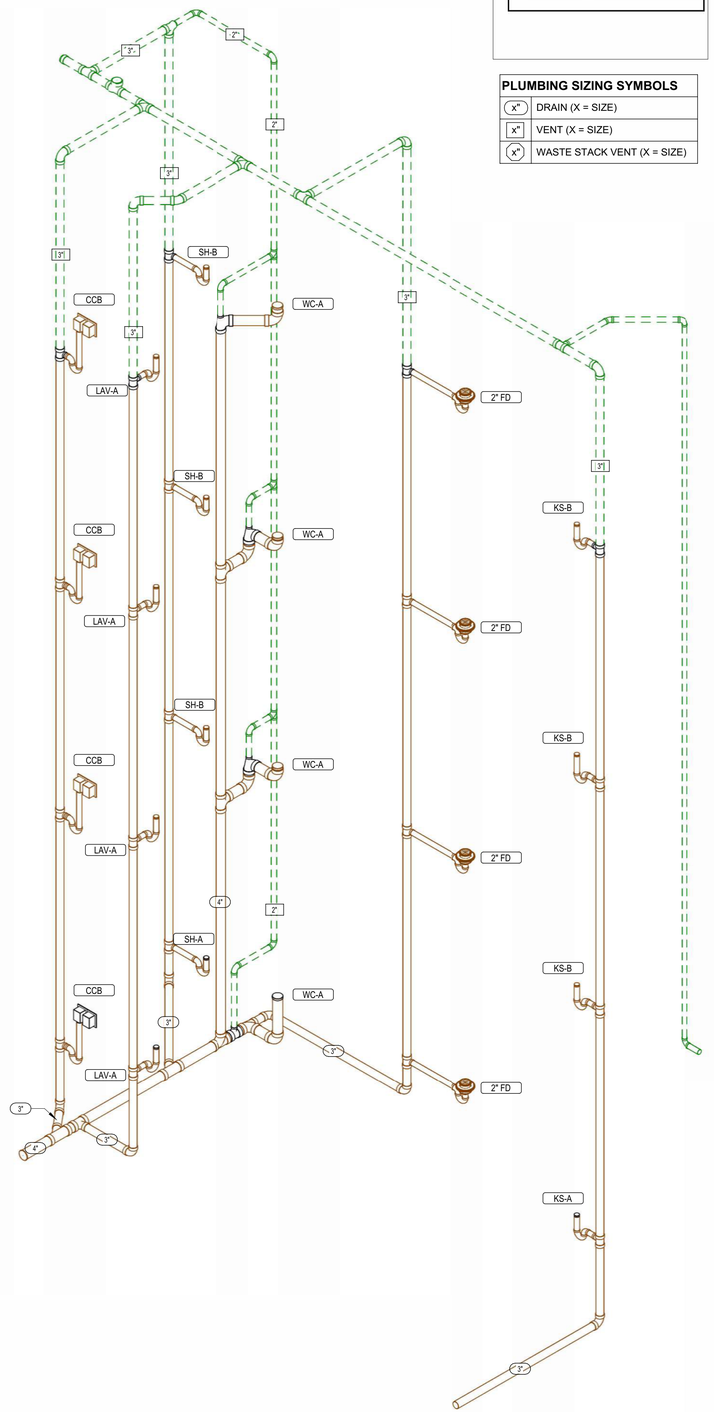

4 P9.1 TYPICAL TWO BEDROOM 2B/2D WASTE AND VENT RISER

Wichita-Sedgwick County
Metropolitan Area Building
and Construction Department

REVIEWED FOR CODE COMPLIANCE

CORRECTIONS OR COMMENTS MADE ON THESE DRAWINGS AND THIS DOCUMENT DURING THIS REVIEW DO NOT RELIEVE CONTRACTOR FROM COMPLIANCE WITH ALL REQUIREMENTS OF THE CODE OF THE MABCD, THE CITY OF WICHITA OR SEDGWICK COUNTY. THIS REVIEW IS ONLY FOR GENERAL CONFORMANCE OF THE CODE. THE CONTRACTOR IS RESPONSIBLE FOR CONFORMING AND CORRELATING ALL TECHNIQUES OF CONSTRUCTION. THIS APPROVAL IS SUBJECT TO PROVISIONS OF SECTION 107.4 OF THE 2012 INTERNATIONAL BUILDING CODE.

DATE: 02/19/25 BY: William Jerauld Jr

PLUMBING SIZING SYMBOLS	
(X")	DRAIN (X = SIZE)
X"	VENT (X = SIZE)
(X")	WASTE STACK VENT (X = SIZE)

LST Consulting Engineers, PA
Manhattan, Kansas
785.587.8042

Wichita, Kansas
316.285.0696

www.LSTengineers.com
mail@LSTengineers.com
Project 24061

JonesGillamRenz
730 N. Ninth
Salina, KS 67401
785.827.0386
1881 Main Street, Suite 301
Kansas City, MO 64108
jgr@jgrarchitects.com

THE RESIDENCE AT HERATIGE WEST

NEW SENIOR LIVING FACILITY

ANDOVER, KANSAS

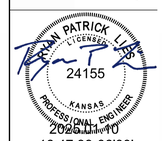

REVISIONS:

DATE: 01-10-2025
JOB: 24-3379
SHEET NO.:

P9.1

© COPYRIGHTED

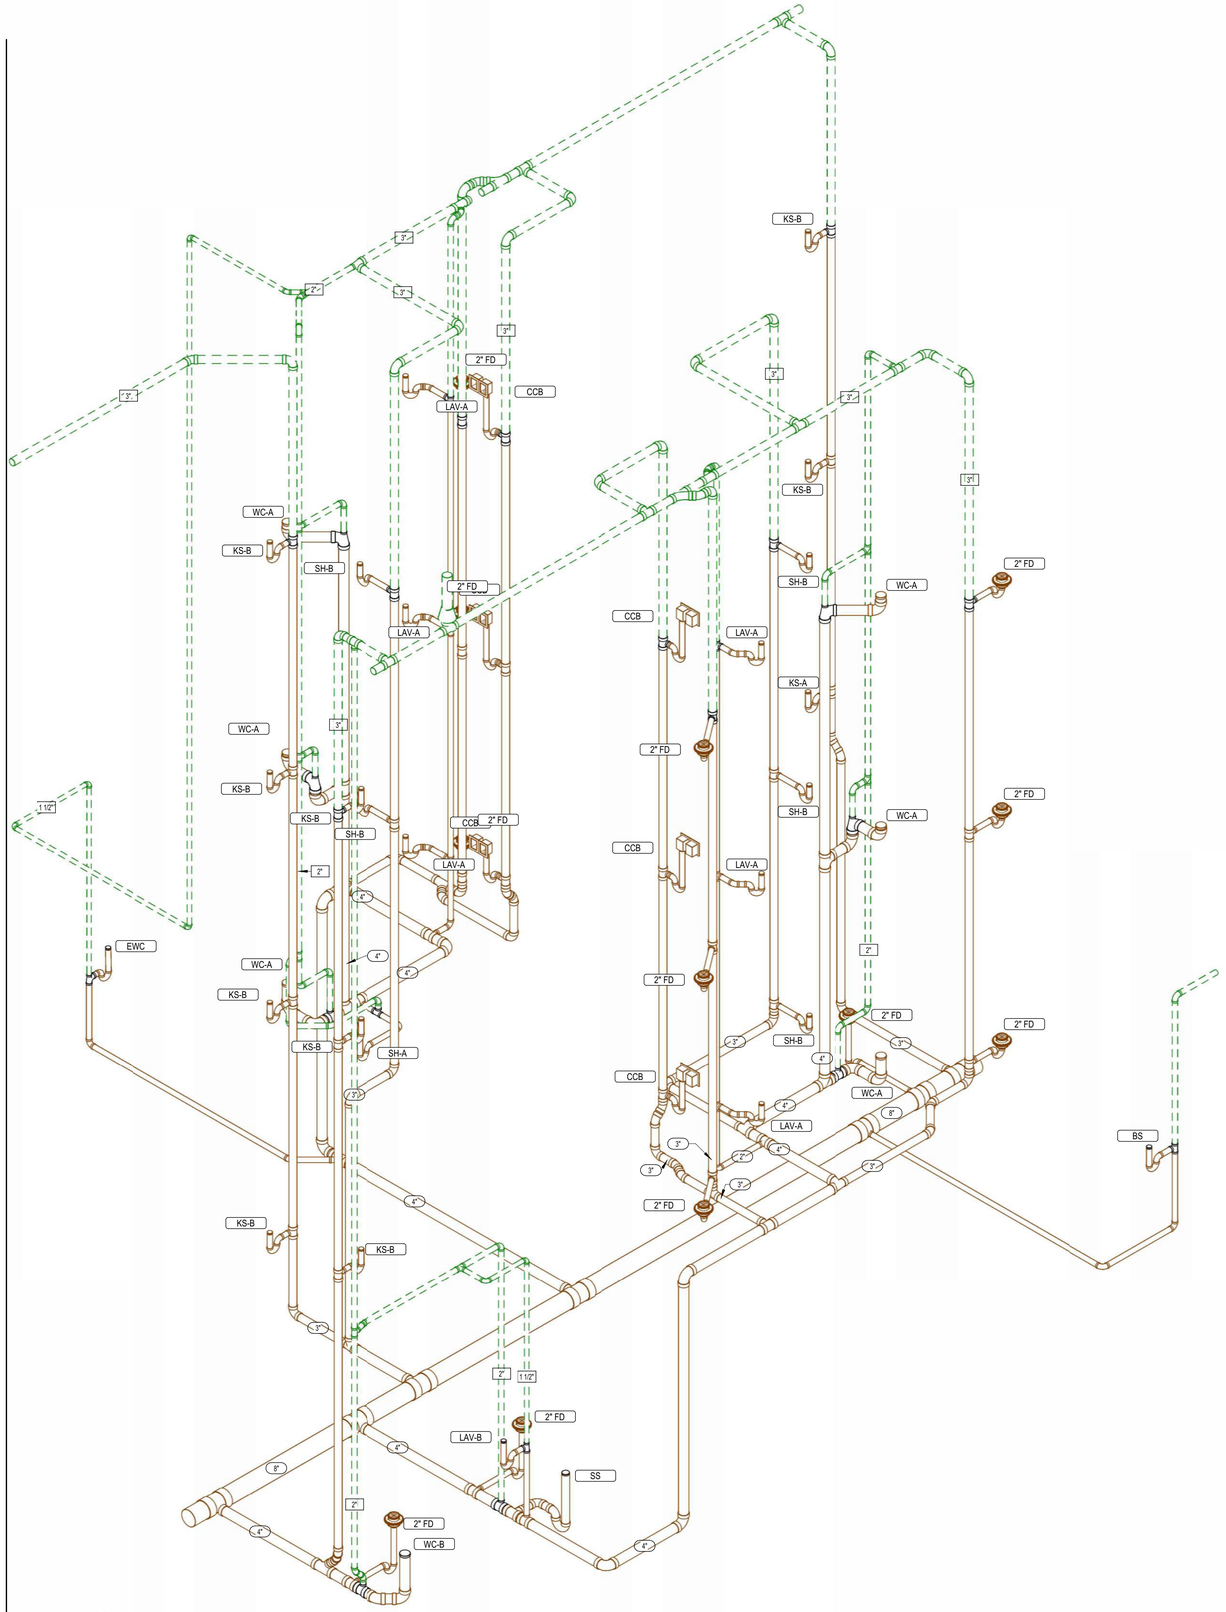

1 P9.2 COMMON AREA WASTE AND VENT RISER

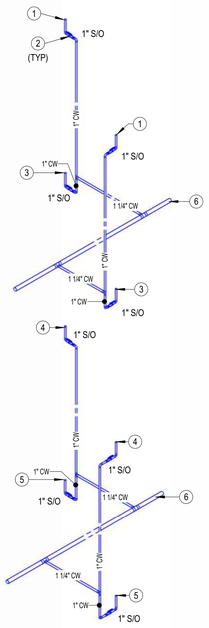

3 P9.2 TYPICAL APARTMENT DOMESTIC WATER SERVICE RISER DIAGRAM

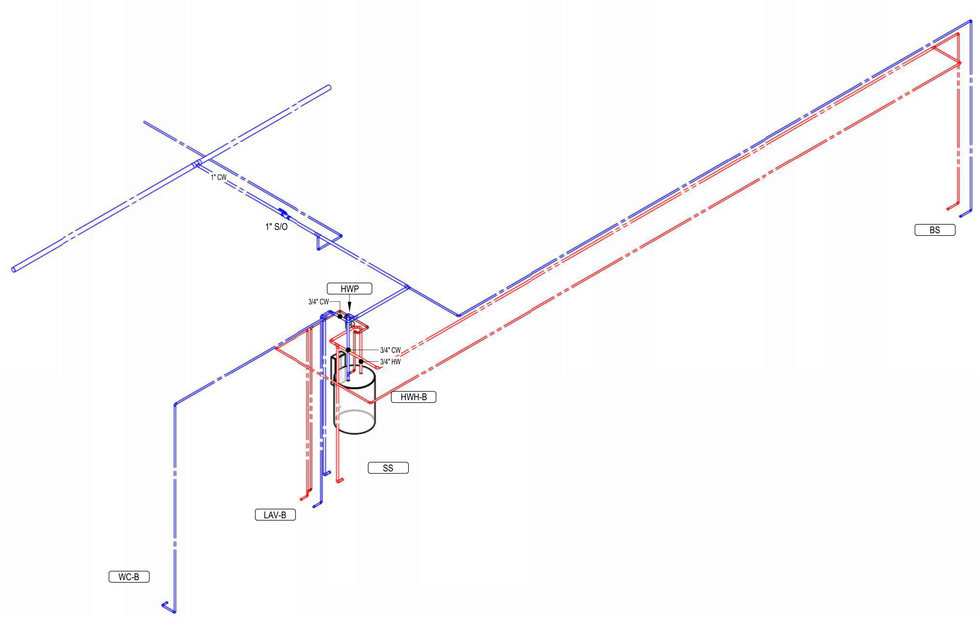

2 P9.2 COMMON AREA DOMESTIC WATER RISER

Wichita-Sedgwick County
Metropolitan Area Building
and Construction Department

REVIEWED FOR CODE COMPLIANCE

CORRECTIONS OR COMMENTS MADE ON THESE DRAWINGS AND THIS DOCUMENT DURING THIS REVIEW DO NOT RELIEVE CONTRACTOR FROM COMPLIANCE WITH ALL REQUIREMENTS OF THE CODE OF THE MABCD, THE CITY OF WICHITA OR SEDGWICK COUNTY. THIS REVIEW IS ONLY FOR GENERAL CONFORMANCE OF THE CODE. THE CONTRACTOR IS RESPONSIBLE FOR CONFORMING AND CORRELATING ALL TECHNIQUES OF CONSTRUCTION. THIS APPROVAL IS SUBJECT TO PROVISIONS OF SECTION 107.4 OF THE 2012 INTERNATIONAL BUILDING CODE.

DATE: 02/19/25 BY: William Jerauld Jr

PLUMBING SIZING SYMBOLS	
x"	DRAIN (X = SIZE)
x"	VENT (X = SIZE)
x"	WASTE STACK VENT (X = SIZE)

NOTES BY SYMBOL

1. DOMESTIC WATER SERVICE TO 4TH FLOOR DWELLING UNIT. SEE P4.1 FOR CONTINUATION.
2. INSTALL SHUT OFF VALVE IN ACCESSIBLE LOCATION. PROVIDE ACCESS PANELS AS REQUIRED.
3. DOMESTIC WATER SERVICE TO 3RD FLOOR DWELLING UNIT. SEE P4.1 FOR CONTINUATION.
4. DOMESTIC WATER SERVICE TO 2ND FLOOR DWELLING UNIT. SEE P4.1 FOR CONTINUATION.
5. DOMESTIC WATER SERVICE TO 1ST FLOOR DWELLING UNIT. SEE P4.1 FOR CONTINUATION.
6. SEE OVERALL PLANS FOR SIZE AND ROUTING OF PLUMBING MAINS.

LST Consulting Engineers, PA
Manhattan, Kansas
785.587.8042

Wichita, Kansas
316.285.0696

www.LSTengineers.com
mail@LSTengineers.com
Project 24061

JonesGillamRenz
730 N. Ninth
Salina, KS 67401
785.827.0386
1881 Main Street, Suite 301
Kansas City, MO 64108
jgr@jgrarchitects.com

THE RESIDENCE AT HERATIGE WEST

NEW SENIOR LIVING FACILITY

ANDOVER, KANSAS

RYAN PATRICK LIPP LICENSED 24155 KANSAS PROFESSIONAL ENGINEER
2025.10.16 16:47:57-06'00'

REVISIONS:

DATE: 01-10-2025
JOB: 24-3379
SHEET NO.:

P9.2

COPYRIGHTED ©